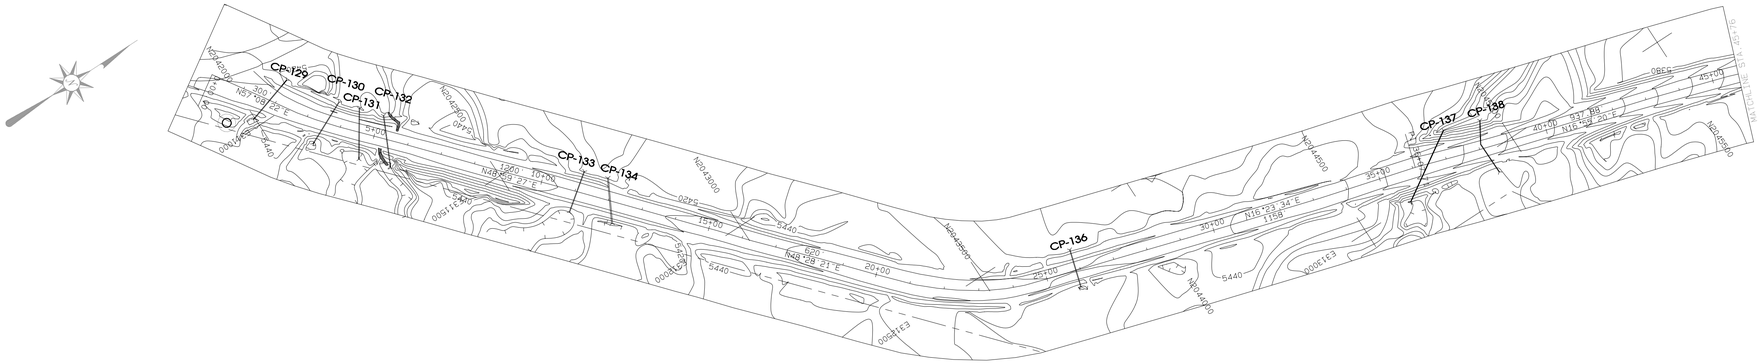

PLAN VIEW
SCALE: 1"=200'

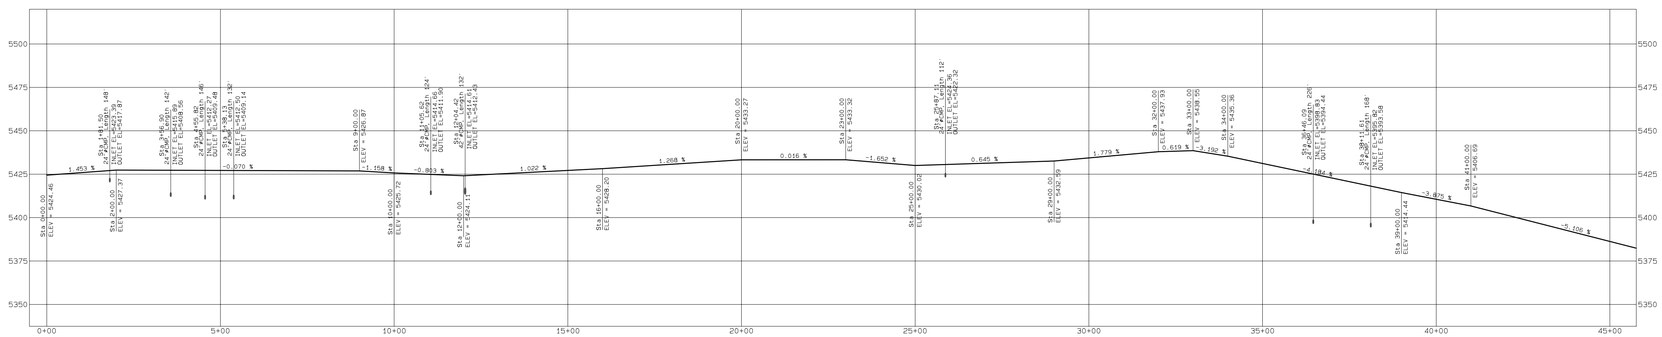

PROFILE VIEW
HORIZONTAL: 1"=200'
VERTICAL: 1"=40'

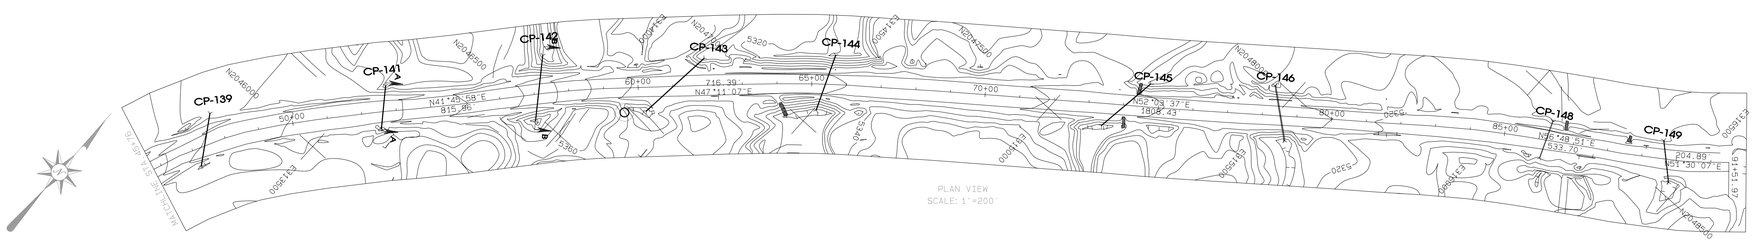

PLAN VIEW
SCALE: 1"=200'

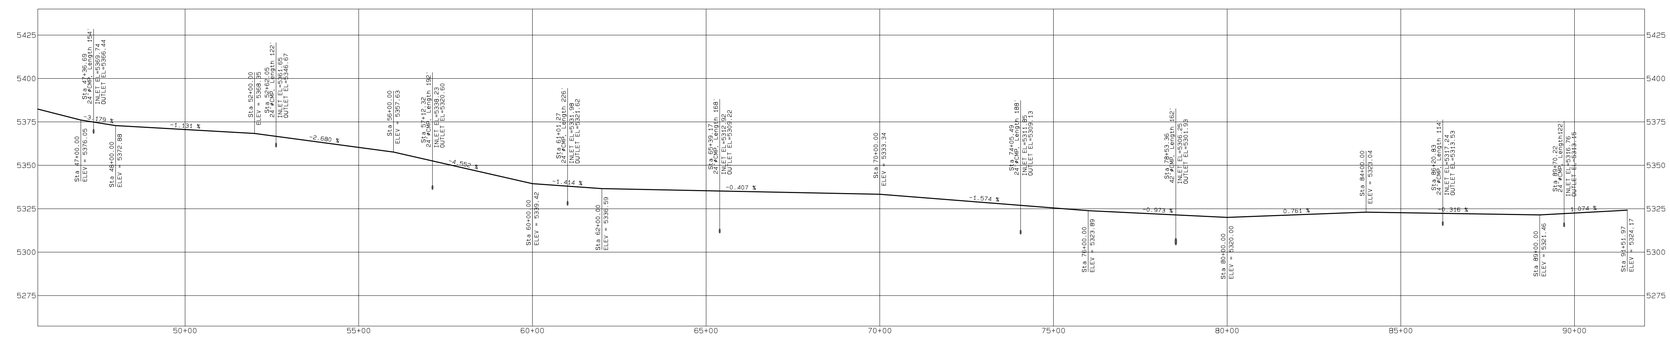

PROFILE VIEW
HORIZONTAL: 1"=200'
VERTICAL: 1"=40'

LEGEND

- ROAD
- TRAIL
- BUILDING
- FENCE
- IRRIGATION LINE
- CULVERT
- DAM
- DRAINAGE
- RAILROAD
- TREES
- POWERLINE
- ×5338.5 SPOT ELEVATION
- 5300 INDEX CONTOUR
- 5298 INTERMEDIATE CONTOUR
- 218 5422.45 CONTROL
- LEASE
- RIPRAP DROP STRUCTURE

NOTES

1. For hydrology and design information refer to Appendix 11-V in the approved PAP.
2. Refer to Exhibit 11-12C and 11-12C-1 for culvert watershed information.

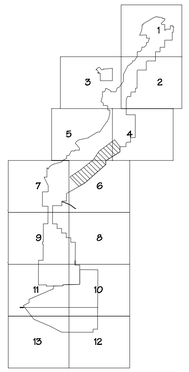

SCALE AS NOTED

CERTIFICATION STATEMENT

I, Leonard Raymond, hereby certify that this road has been constructed in accordance with the approved design plans and that the information shown is complete and accurate to the best of my knowledge, except as noted. See Exhibit 11-141E for notes.

LEONARD RAYMOND
NEW MEXICO
6600
REGISTERED PROFESSIONAL ENGINEER

DATE	REVISION

1 2 3 4 5

PROJECT MANAGER: COREY NELSON
ENGR. of RECORD: LEONARD RAYMOND
REG. NO. 6600
DRWTR of RECORD: REG. NO.

BHP-NAVAJO COAL CO.
PO BOX 155, FRUITLAND, NEW MEXICO, 87416

ACCOUNT: Department No. 2000
DATE: 07/07/2005
DESIGNED BY: BEN HOSKIE
DRAWN BY: RAY YAZZIE
CHECKED BY: LR
APPROVED BY:

PLAN AND PROFILE

EXHIBIT 11-141D
HOSTEEN/YAZZIE ROAD
AS-BUILT

DRAWING

SHEET 2 OF 3

Project Desc: Path: G:\Departments\GDR_DGRW\DGR_PROJ\CH_11_PAP EXHIBITS\11-141-HOSTEEN-YAZZIE HAULROAD\HOSTEEN-YAZZIE ROAD\HOSTEEN-YAZZIE ROAD\11D\HY_Road_AsBuilt.dwg Plot Date: Mon Aug 15 11:31:07 2005