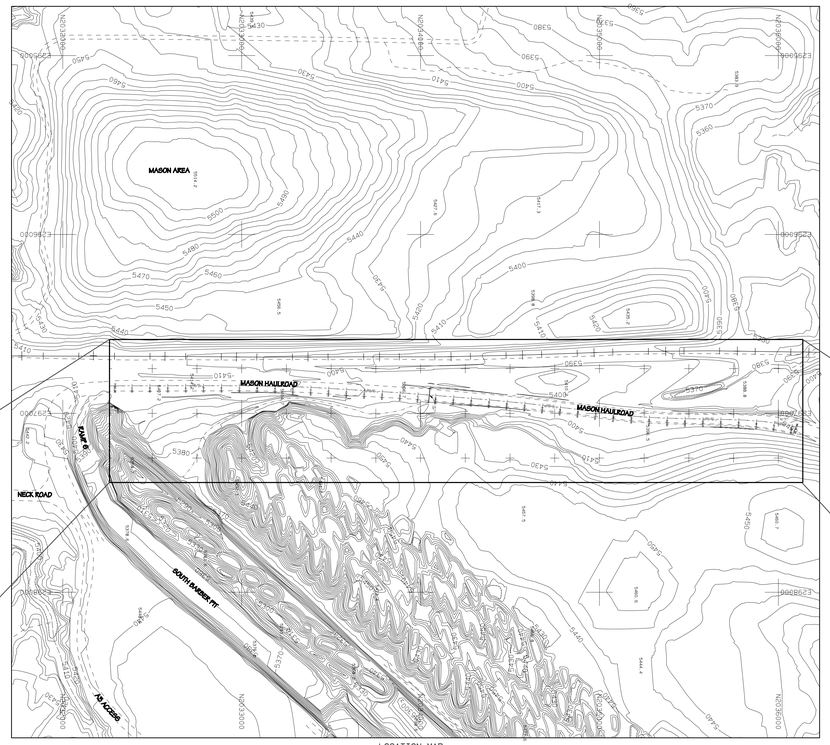

LOCATION MAP
SCALE: 1"=300'

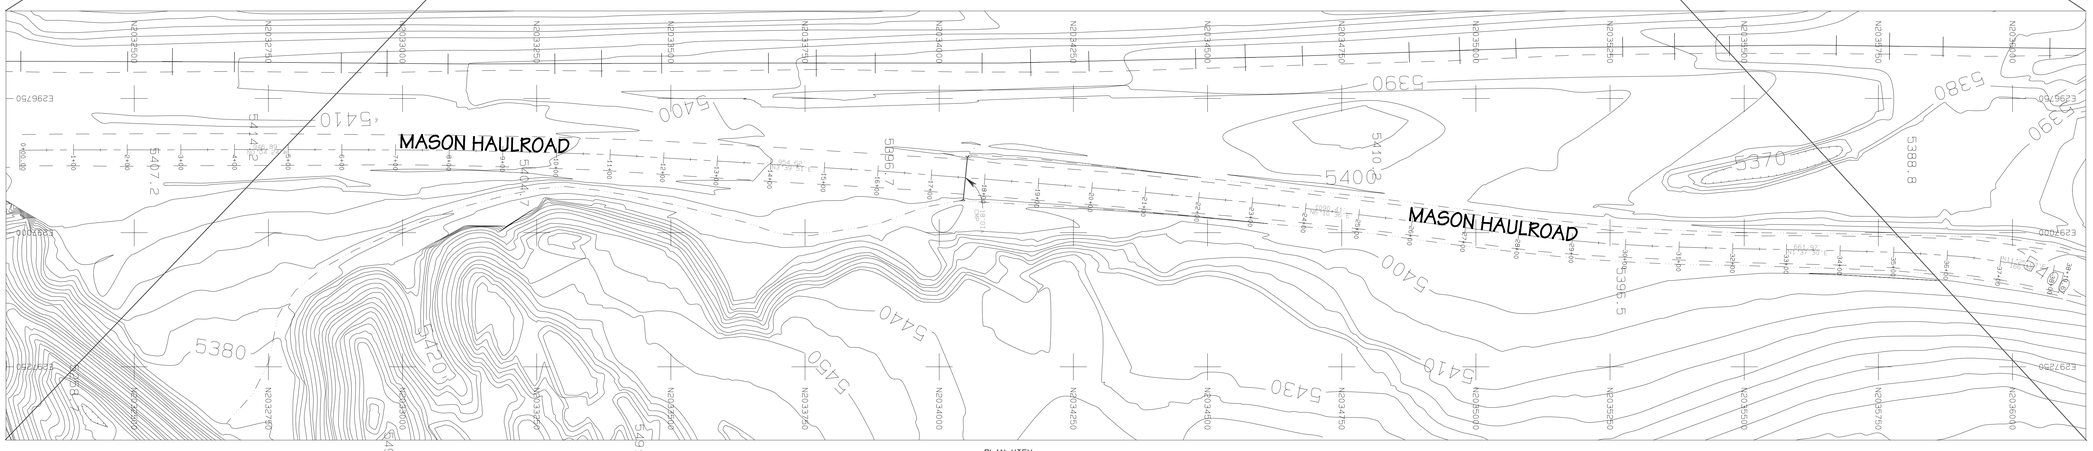

PLAN VIEW
SCALE: 1"=100'

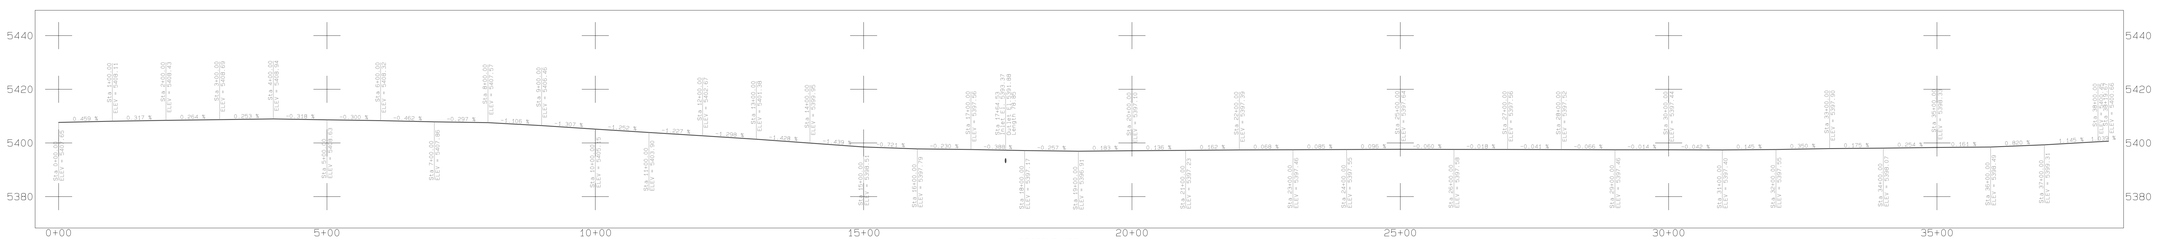

PROFILE VIEW
HORIZONTAL: 1"=100'
VERTICAL: 1"=20'

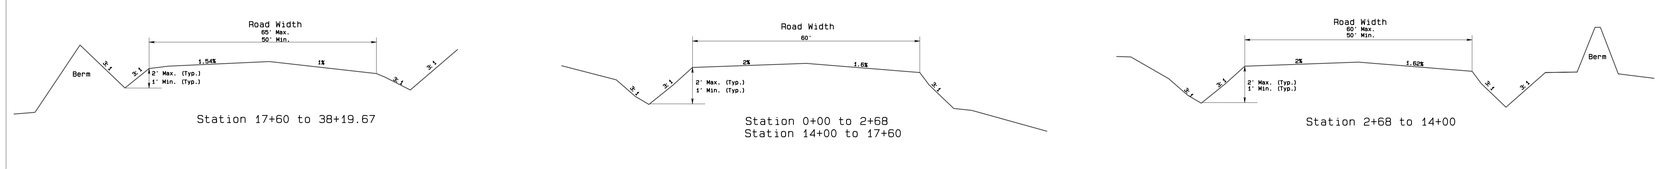

TYPICAL SECTIONS
NTS

LEGEND

- ROAD
- WATERSHED
- BUILDING
- FENCE
- IRRIGATION LINE
- CULVERT
- DAM
- DRAINAGE
- RAILROAD
- TREES
- POWERLINE
- ×5338.5 SPOT ELEVATION
- 5300 INDEX CONTOUR
- 5298 INTERMEDIATE CONTOUR
- 218 5422.45
- L-30 LEASE CORNER

NOTES

1. For hydrology and design information refer to Appendix II-V in the approved PAP.

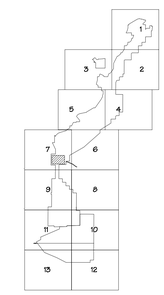

CERTIFICATION STATEMENT

I, Leonard Raymond, hereby certify that this drawing was reviewed by me and that the information shown is complete and accurate to the best of my knowledge.

LEONARD RAYMOND
NEW MEXICO
6600
PROFESSIONAL ENGINEER

REV. NO.	DATE	DRAFT. BY	REVISION DESCRIPTION	ENG	K.G.	P.E.	P.S.	CHIEF ENG.
A	05/15/99	RY	SUBMITTED TO OSM	BH	MC	LR		

APPROVALS

EXHIBIT 11-138

NAVAJO COAL COMPANY

NAVAJO MINE
SAFETY PAYS

P.O. BOX 155 FRUITLAND, NEW MEXICO 87416

MASON HAULROAD
LOCATION MAP, PLAN PROFILE AND SECTIONS
ASBUILT

PREPARED BY RY	DRAWN BY RY	SCALE AS NOTED
APPROVED BY LR	DATE 05/15/99	REF DWG
DWG LOC	G:\Departments\Ds\OSM_SUBMITTER_PROGS\CH_11_PAP EXHIBITS\11-138-MASON HAULRD\Masso	