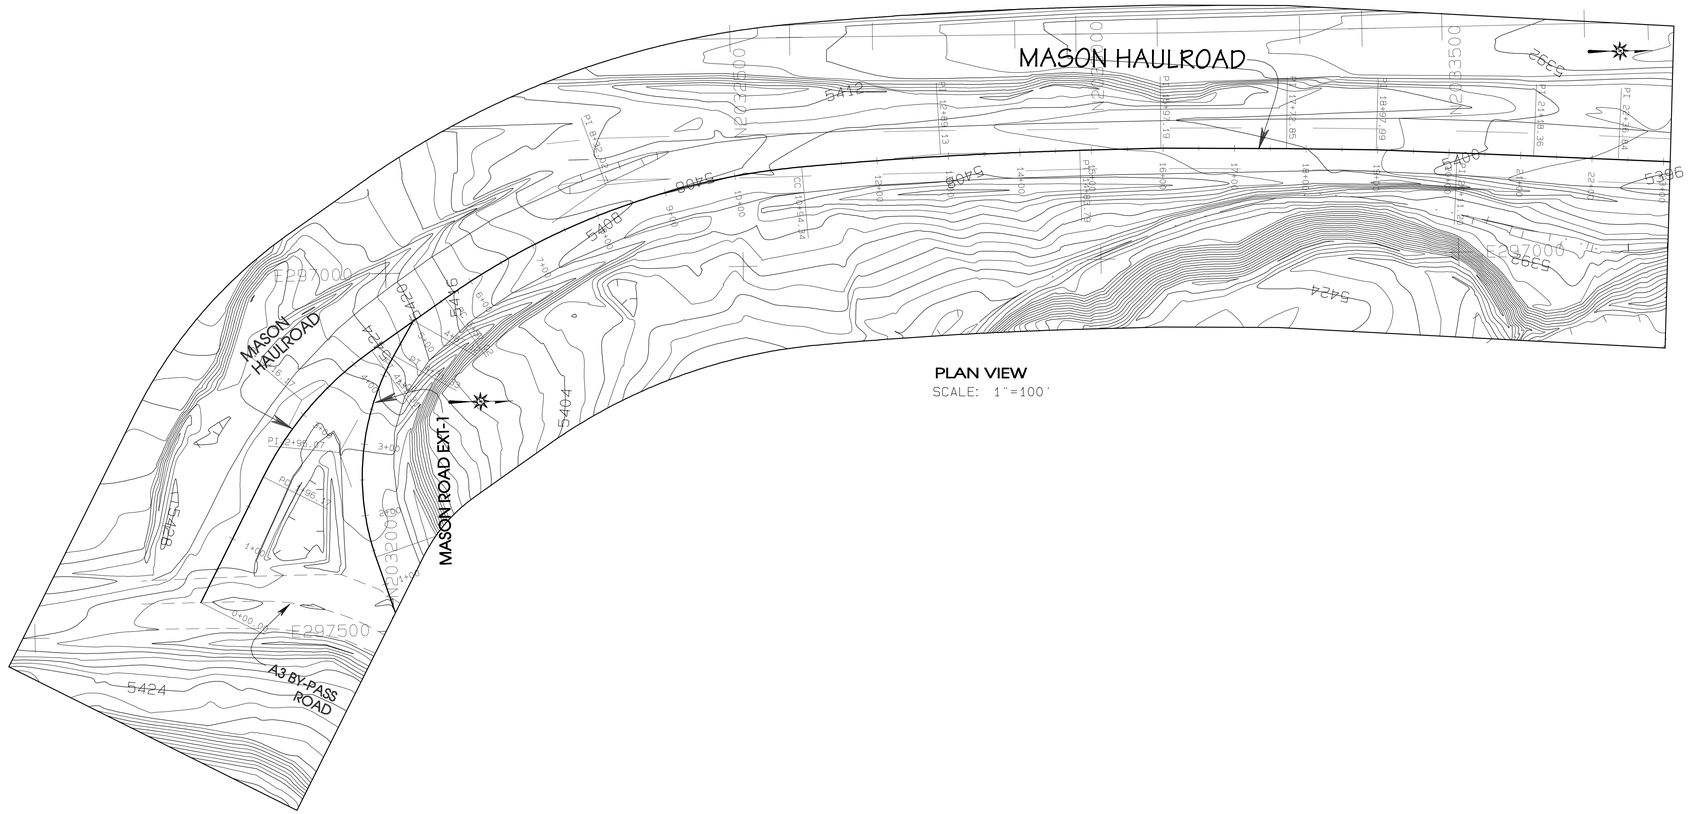

PLAN VIEW
SCALE: 1"=100'

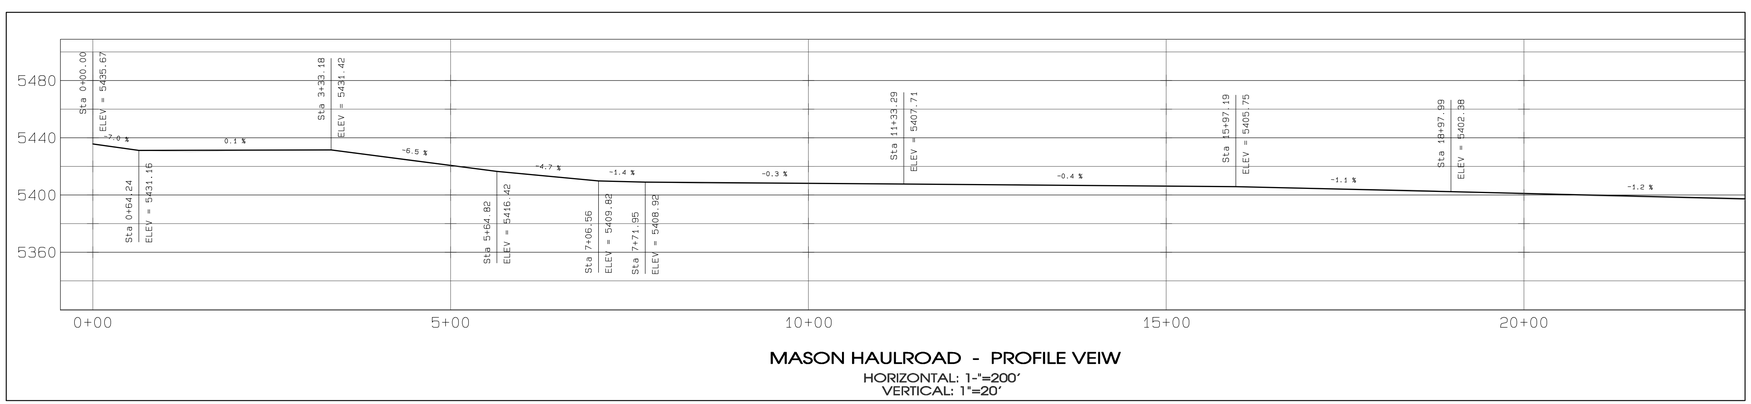

MASON HAULROAD - PROFILE VEIW
HORIZONTAL: 1-"=200'
VERTICAL: 1"=20'

LEGEND

- ROAD
- WATERSHED
- BUILDING
- FENCE
- IRRIGATION LINE
- CULVERT
- DAM
- DRAINAGE
- RAILROAD
- TREES
- POWERLINE
- ×5338.5 — SPOT ELEVATION
- 5300 — INDEX CONTOUR
- 5299 — INTERMEDIATE CONTOUR
- 218 / 5422.45 — LEASE CORNER
- L-30 — LEASE/PERMIT BOUNDARY

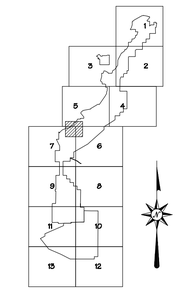

REV. NO.	DATE	DRAFT BY	REVISION DESCRIPTION	ENG.	E.S.	P.K.
				APPROVALS		
CD-4	3-23-09	PJF	REPLACE PREVIOUS AS-BUILT MASON HAULROAD. ALSO ADDED MASON ROAD EXT-1 AND SUBMITTED TO OSM FOR REVIEW.	RCVV	TB	RCVV

CERTIFICATION STATEMENT

I, Ron C. Van Valkenburg, hereby certify that this drawing was reviewed by me and that the information shown is complete and accurate to the best of my knowledge.

RON C. VAN VALKENBURG
NEW MEXICO
9263
LICENSED PROFESSIONAL ENGINEER

EXHIBIT 11-138

NAVAJO COAL COMPANY

bhpbilliton

P.O.BOX 1717 FRUITLAND, NEW MEXICO 87416/PHONE 505-598-4200/FAX 505-598-3361

AREA-II

MASON HAULROAD
PLAN/PROFILE AS-BUILT

PREPARED BY PJF	DRAWN BY PJF	AS NOTED
APPROVED BY RVV	DATE 3-13-09	**Sheet 2 of 3**

Path: \\ENCNMCFMN-SRV02\Data\Departments\Gs\OSM_SUBM\PER_PROG\CH_11_PAP EXHIBITS\11-138-MASON HAULRD\2009 DATA\EXH 11-138_Mason_Haulroad.pro
PJFoster \Plot time: Fr: May 22 12:56:59 2009