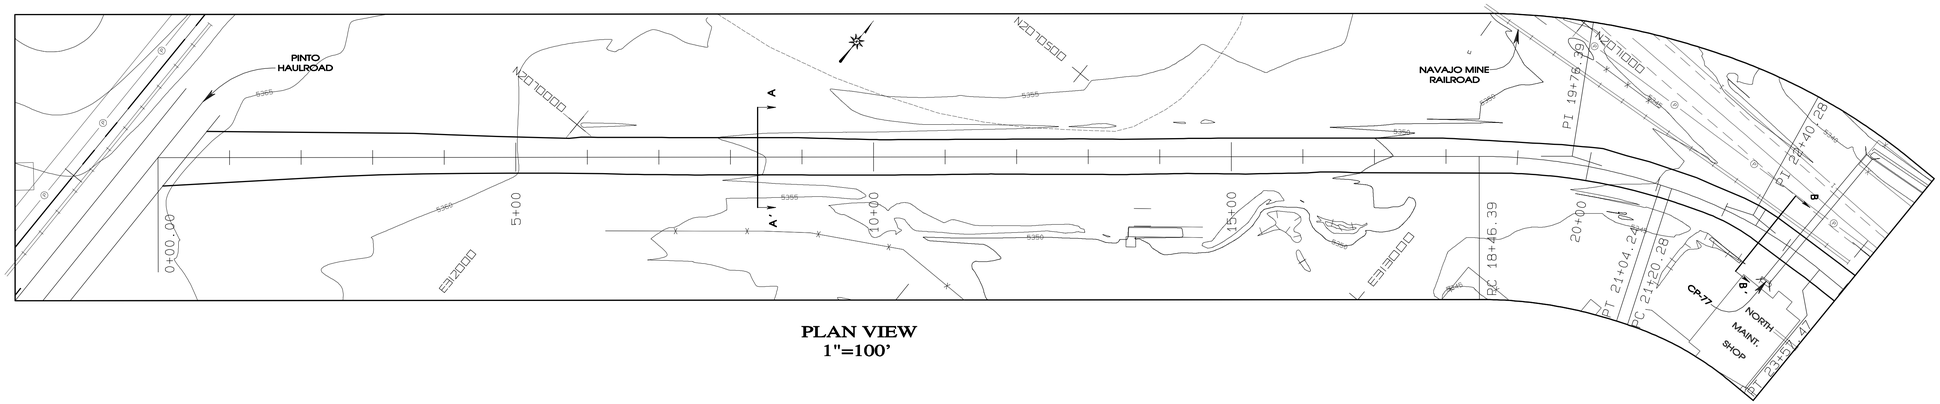

PLAN VIEW
1"=100'

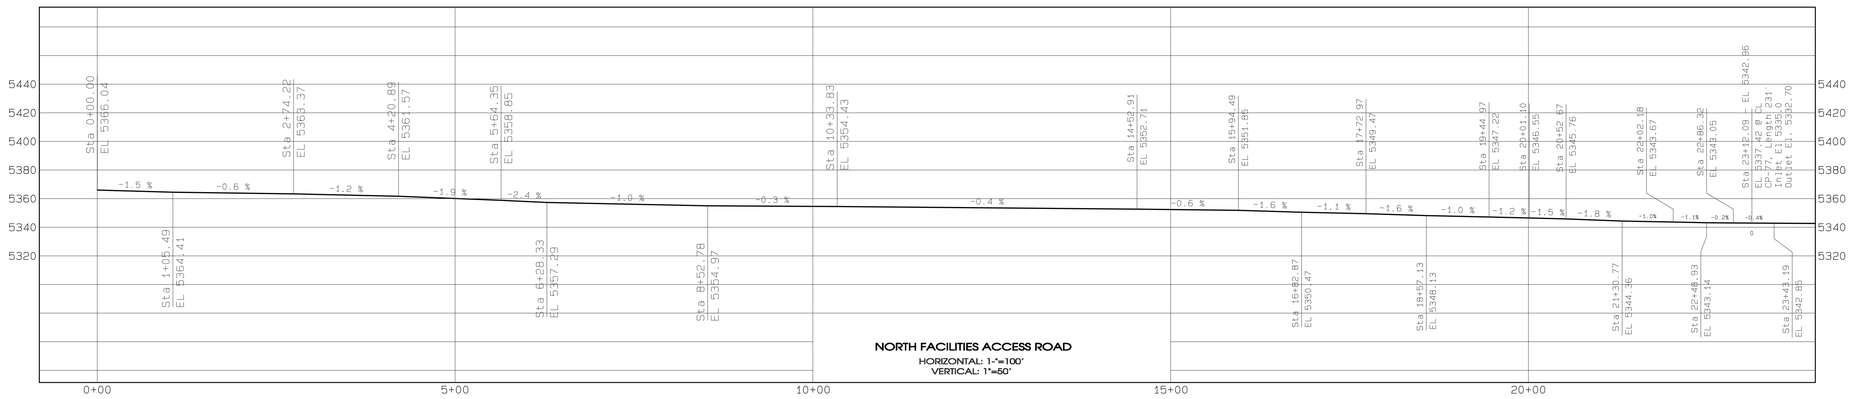

NORTH FACILITIES ACCESS ROAD
HORIZONTAL: 1-"=100'
VERTICAL: 1"=50'

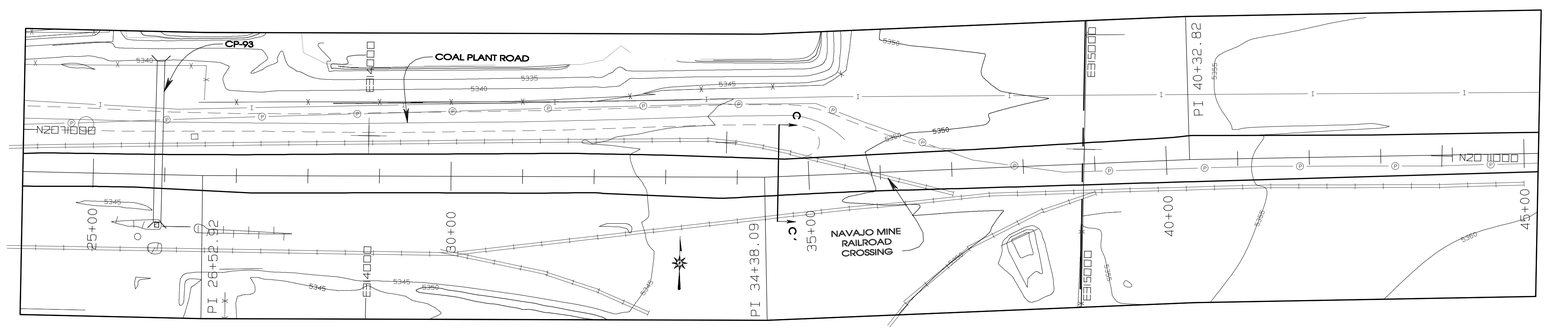

PLAN VIEW
1"=100'

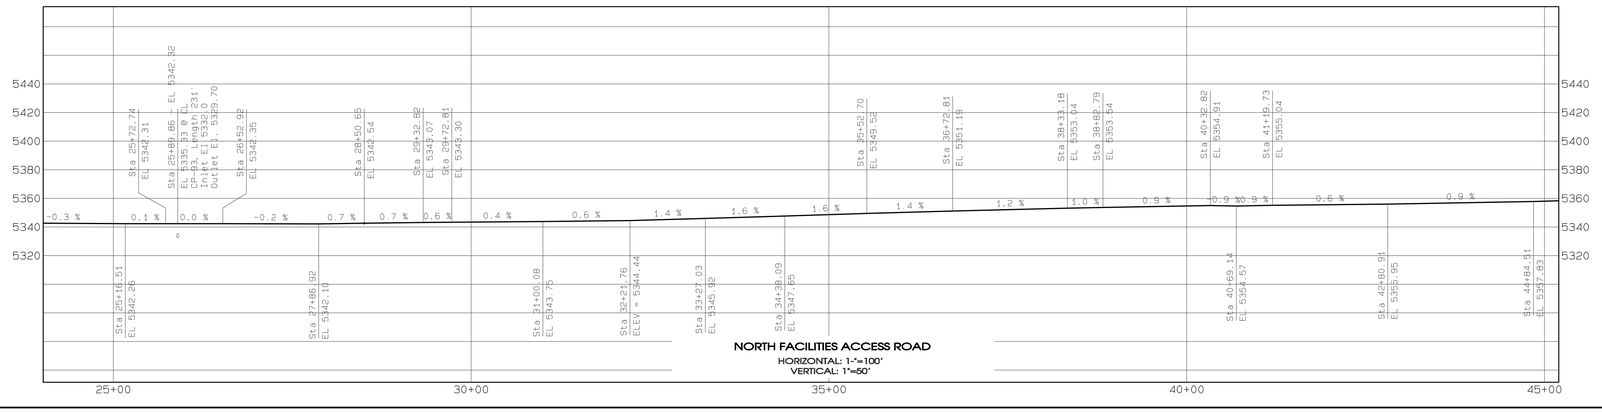

NORTH FACILITIES ACCESS ROAD
HORIZONTAL: 1-"=100'
VERTICAL: 1"=50'

LEGEND

- ROAD
- WATERSHED
- BUILDING
- FENCE
- IRRIGATION LINE
- CULVERT
- DAM
- DRAINAGE
- RAILROAD
- TREES
- POWERLINE
- ×5338.5 SPOT ELEVATION
- 5300 INDEX CONTOUR
- 5298 INTERMEDIATE CONTOUR
- 218 5462.45 LEASE CORNER
- L-30 LEASE CORNER
- LEASE/PERMIT BOUNDARY

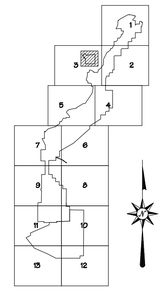

REV. No.	DATE	DRAFT. BY	REVISION DESCRIPTION	ENG.	E.G.	P.E.
DR-A	5-20-09	PJF	CREATED AS-BUILT EXHIBIT FOR NORTH FACILITIES ACCESS ROAD AND SUBMITTED TO OSM FOR REVIEW.	RCVV	YS	RCVV

APPROVALS

CERTIFICATION STATEMENT

I, Ron C. Van Valkenburg, hereby certify that this drawing was reviewed by me and that the information shown is complete and accurate to the best of my knowledge.

RON C. VAN VALKENBURG
NEW MEXICO
9263
LICENSED PROFESSIONAL ENGINEER

EXHIBIT 11-155

NAVAJO COAL COMPANY

bhpbilliton

P.O.BOX 1717 FRUITLAND, NEW MEXICO 87416/PHONE 505-598-4200/FAX 505-598-3361

AREA–I
NORTH FACILITIES
ACCESS ROAD
PLAN/PROFILE AS–BUILT

PREPARED BY PJF	DRAWN BY PJF	AS NOTED
APPROVED BY RVV	DATE 3-20-09	**Sheet 2 of 3**

Path: \\ENGMGTNN-SRV02\Data\Departments\Gis\GIS_SUBMITTER_PROJ\CH_11.APP EXHIBITS\11-155 North Fac Access Road As-Built\Exh 11-155_N FAC AS-BUILT ROAD.prp
PgPlotter \Plot time: Fri May 22 08:48:47 2009