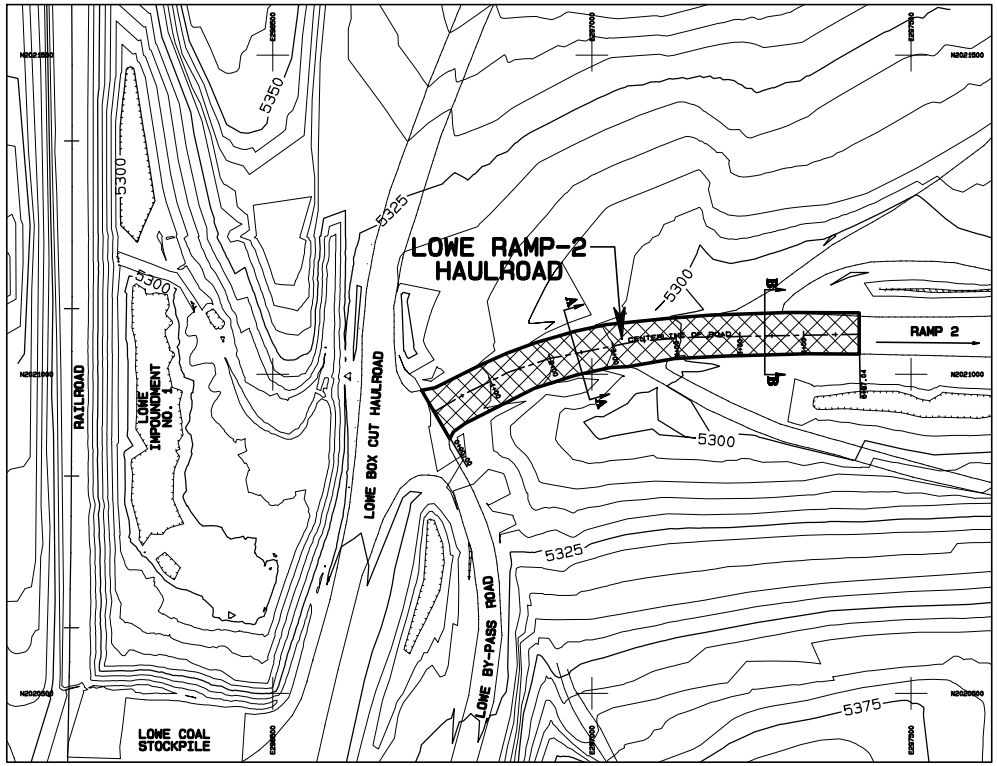

PLAN AND LOCATION MAP
SCALE: 1"=100'

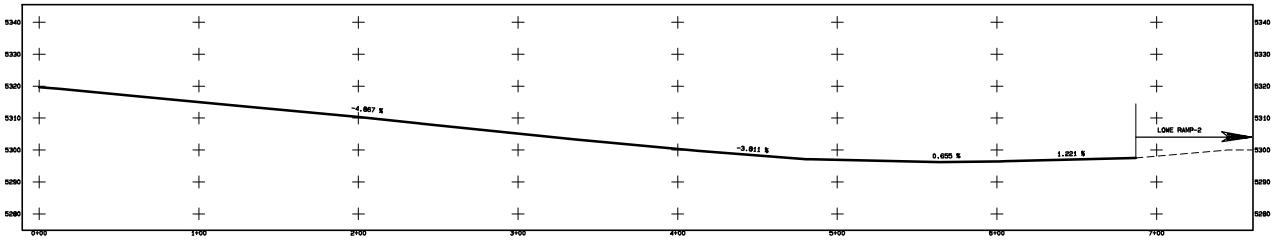

PROFILE (CENTERLINE OF ROAD)
HORZ.: 1"=40'
VERT.: 1"=20'

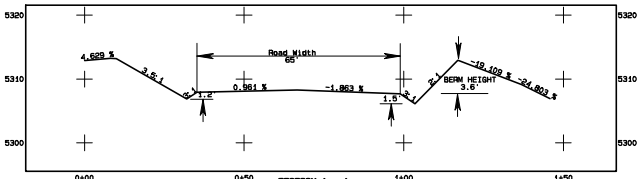

SECTION A - A
HORZ.: 1"=20'
VERT.: 1"=10'

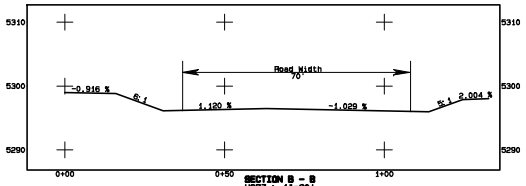

SECTION B - B
HORZ.: 1"=20'
VERT.: 1"=10'

LEGEND

- ROAD
- WATERSHED
- BUILDING
- FENCE
- IRRIGATION LINE
- CULVERT
- DAM
- DRAINAGE
- RAILROAD
- TREES
- POWERLINE
- ×5338.5 SPOT ELEVATION
- 5300 INDEX CONTOUR
- 5298 INTERMEDIATE CONTOUR
- 218 5422.45
- L-30 LEASE CORNER
- PERMIT/LEASE BOUNDARY

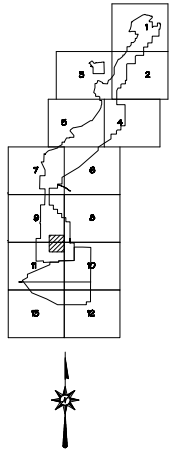

SCALE AS NOTED

CERTIFICATION STATEMENT

I, Kevin A. Bahe, hereby certify that this drawing was reviewed by me and that the information shown is complete and accurate to the best of my knowledge.

KEVIN A. BAHE
NEW MEXICO
17850
LICENSED PROFESSIONAL ENGINEER

REVISION	DATE
SUBMITTED TO OSM FOR REVIEW	09-12-08

Submitted to OSM for Approval
Oct. 21, 08

PROJECT MANAGER: EE
ENGR. of RECORD: RCV
REG. NO. 8063
DRVR of RECORD:
REG. NO.

bhpbilliton
NAVAJO COAL COMPANY
NAVAJO MINE
PO BOX 1717, FRUITLAND, NEW MEXICO 87416 PHONE 505-598-3005/FAX 505-598-3061

PROJECT:
DATE: 09-12-08
DESIGNED BY:
DRAWN BY: RV
CHECKED BY: RCV
APPROVED BY: RCV

PLAN, PROFILE AND SECTION

EXHIBIT 11-153 LOWE RAMP-2 HAULROAD AS-BUILT

DRAWING

SHEET 1 OF 1