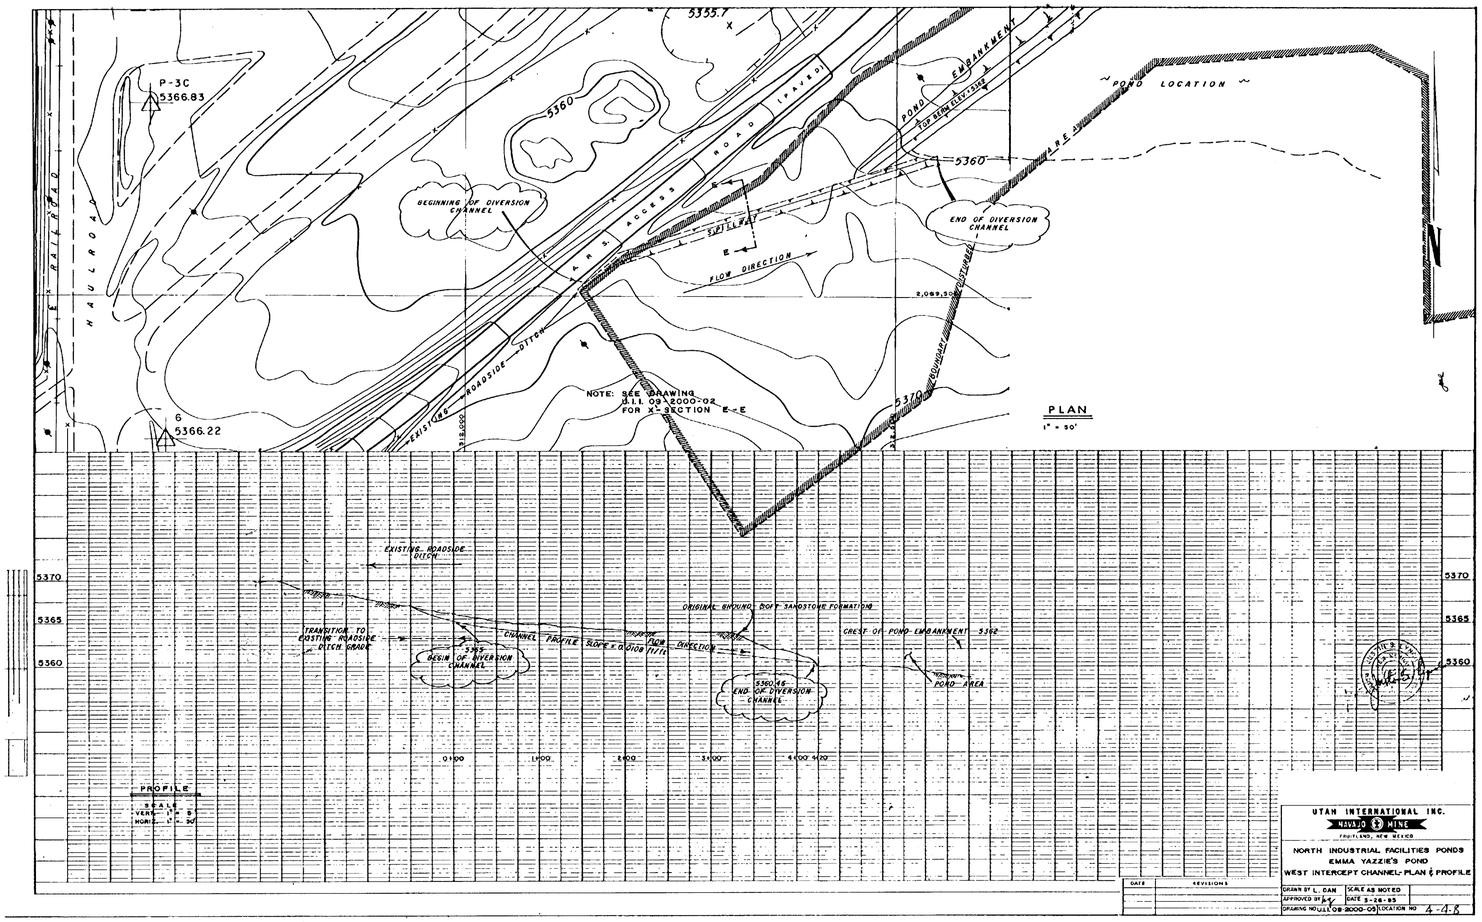

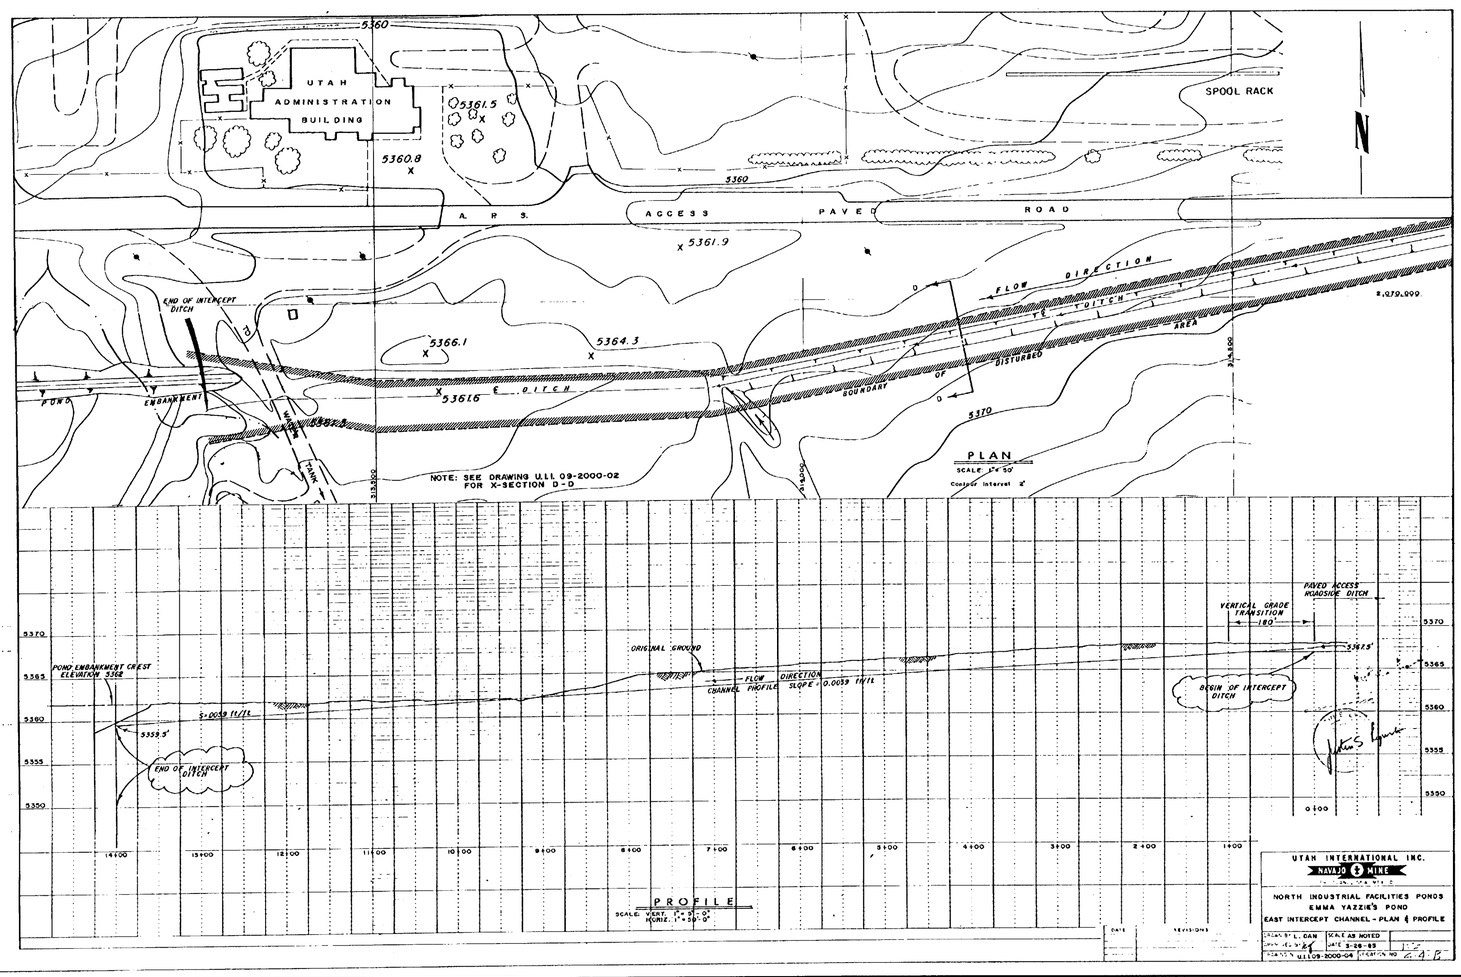

I, Ron Van Valkenburg, hereby certify changes on this drawing since the previous certification are accurate to the best of my knowledge.

RON C. VAN VALKENBURG
NEW MEXICO
PROFESSIONAL ENGINEER
9-9-04

JUSTIN S. LYNCH
NEW MEXICO
REGISTERED PROFESSIONAL ENGINEER

LEONARD RAYMOND
NEW MEXICO
6600
REGISTERED PROFESSIONAL ENGINEER
5-4-04

APPROVED
4 SEP 2004

EXHIBIT 11-31

AS BUILT

REV. NO.	DATE	REVISIONS	APPROVALS			
			DRAFT BY:	ENGR.	CHIEF ENGR.	PROJECT MGR.
1	5/87	Added Revision Block, Darking PE Stamp	GGA			
2	11/87	CHANGED CO. NAME TO BHP - UI	GG			
3	8/24/93	CHG. CO. NAME & CHG. EXH. NO. TO 11-31	JG			
4	4-15-04	UPDATED EXHIBIT AND SUBMITTED TO OSM FOR REVIEW.	PJF	LR		

BHP MINERALS INTERNATIONAL

NAVAJO MINE

FRUITLAND, NEW MEXICO

NORTH INDUSTRIAL FACILITIES PONDS

EMMA YAZZIE 'S POND

SAN JUAN COUNTY, NEW MEXICO

DRAWN BY	AS NOTED	SCALE AS NOTED	
APPROVED BY		DATE	10-17-1985
DRAWING NO.		LOCATION NO.	