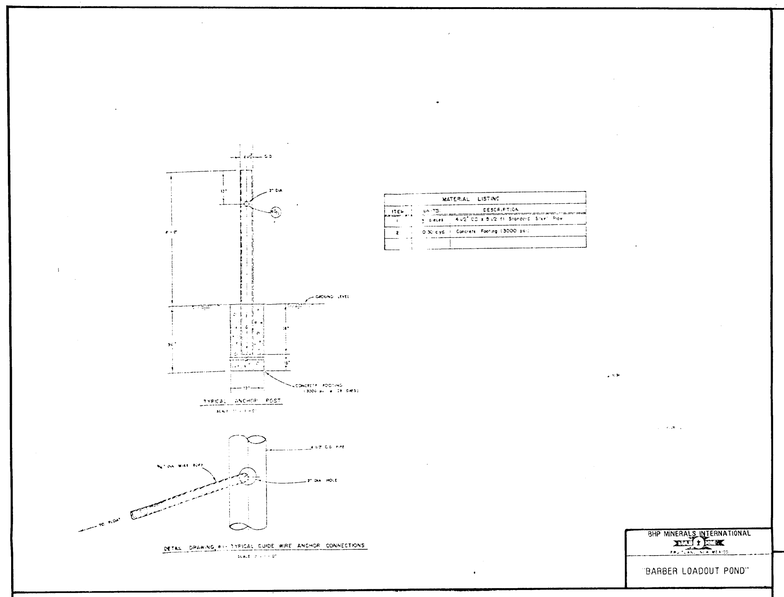

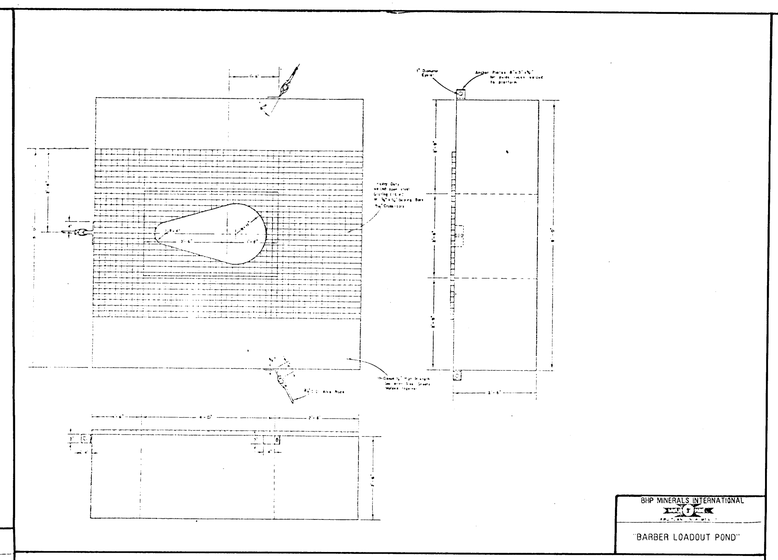

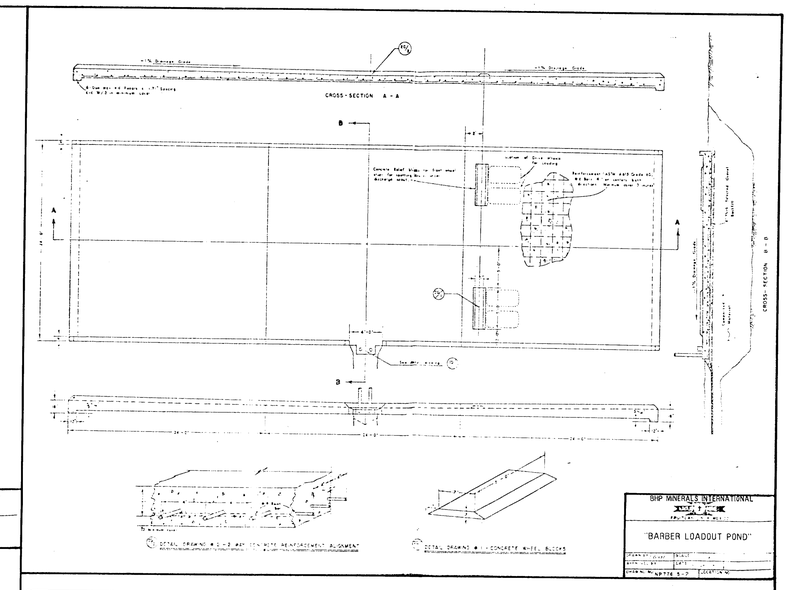

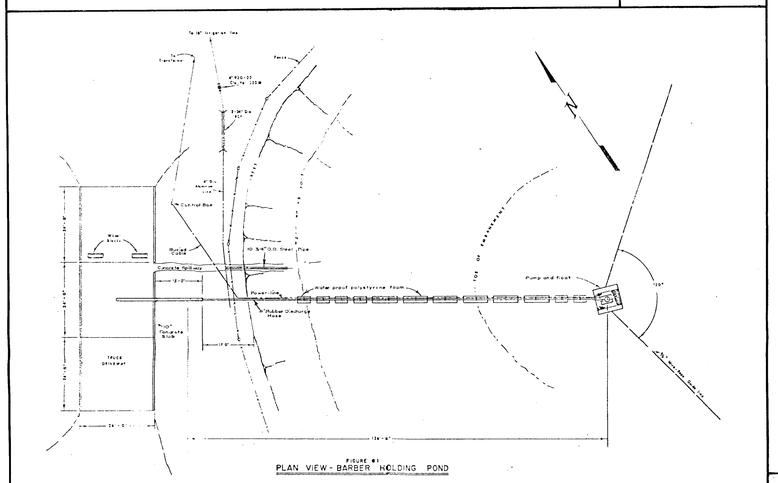

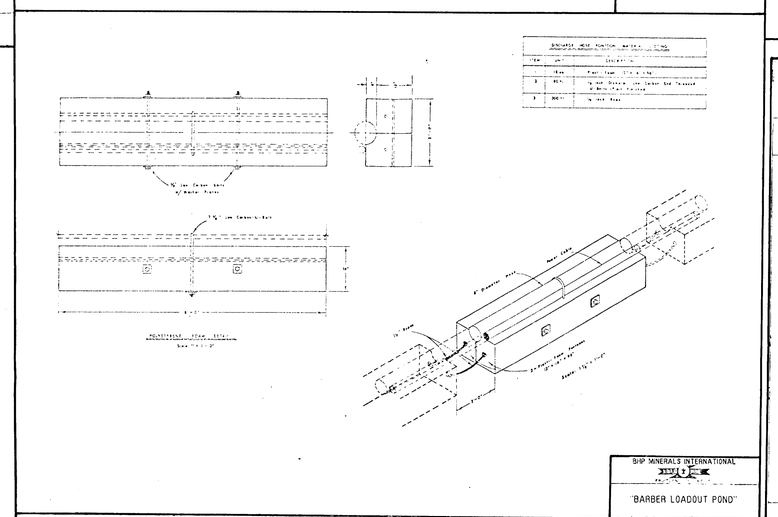

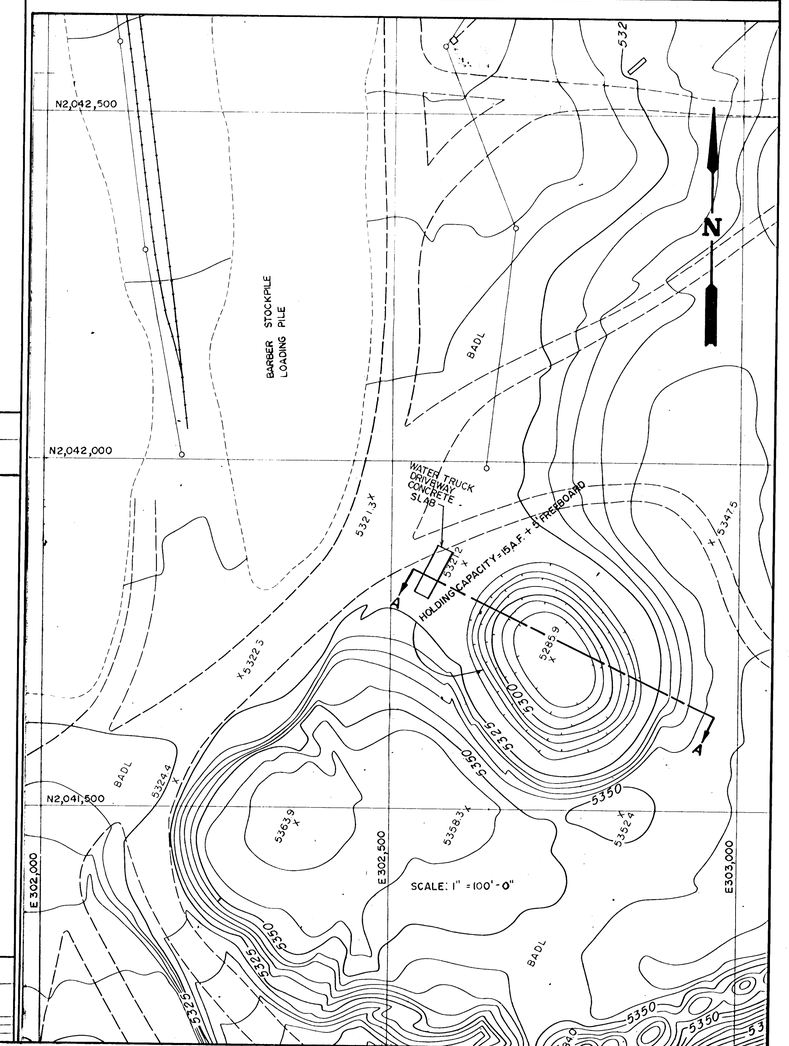

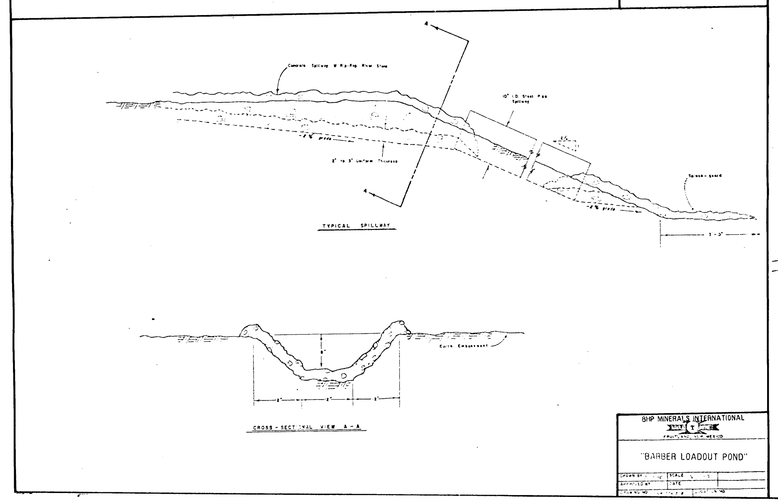

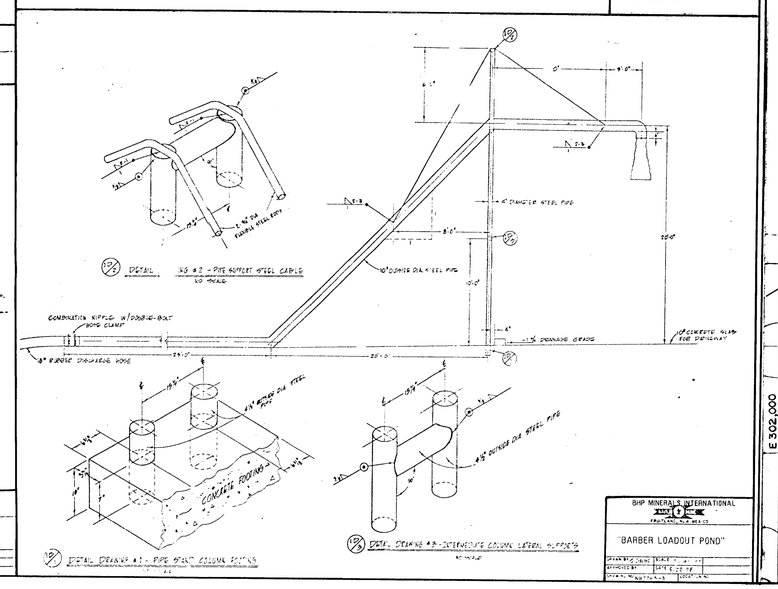

EXHIBIT 11-28

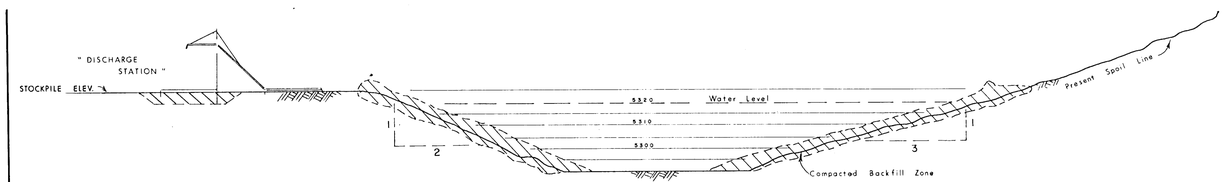

TYPICAL CROSS-SECTIONAL VIEW A-A

Scale: 1" = 30' 0"

BARBER LOADOUT STAGE-AREA-CAPACITY

ELEV (ft.)	COMMENTS	AREA (AC.)	CUM. VOLUME (AC.-ft.)
5285.9	pond bottom	0.00	0.00
5290.0		0.32	0.35
5295.0		0.49	2.35
5300.0		0.67	5.22
5305.0		0.84	8.99
5310.0		0.99	13.58
5315.0	H.W. level.	1.17	18.97
5320.0	pond top	1.42	25.44

I, Ron Van Valkenburg, hereby certify changes on this drawing since the previous certification are accurate to the best of my knowledge.

AS BUILT

REV. NO.	DATE	DESCRIPTION
5	11-27-94	ADDED STAGE AREA CAPACITY TABLE

REV. NO.	DATE	REVISIONS	DRAFT BY	ENGR.	CHIEF ENGR.	PROJECT MGR.
1	5/87	ADD REVISION BLOCK, MOVED P.E. STAMP REMOVED CONFIDENTIAL STATEMENT	J.G			
2	11/87	CHANGED CO. NAME TO BHP-UK CHANGED TITLE TO BARBER LOADOUT POND	CG			
3	11/26/91	REVISED PLAN VIEW - BARBER HOLDING POND DRAWING Figure #1	JG			
A	8/20/93	CHANGED CO. NAME & CHANGED EXHIBIT NO. TO 11-28 SEPARATE PORTION TO BARBER LOADOUT, SEE 93, 1984	JG			

APPROVALS	DRAFT BY	ENG	F.O.	P.E.	CHIEF ENG.
	PJF				

BHP MINERALS INTERNATIONAL
NAVAJO MINE
FRUITLAND, NEW MEXICO

BARBER LOADOUT POND

SAN JUAN COUNTY, NEW MEXICO

DRAWN BY J. SORRELL	SCALE AS NOTED	
APPROVED BY	DATE 10-17-1985	
DRAWING NO.	LOCATION NO. MF-01a	