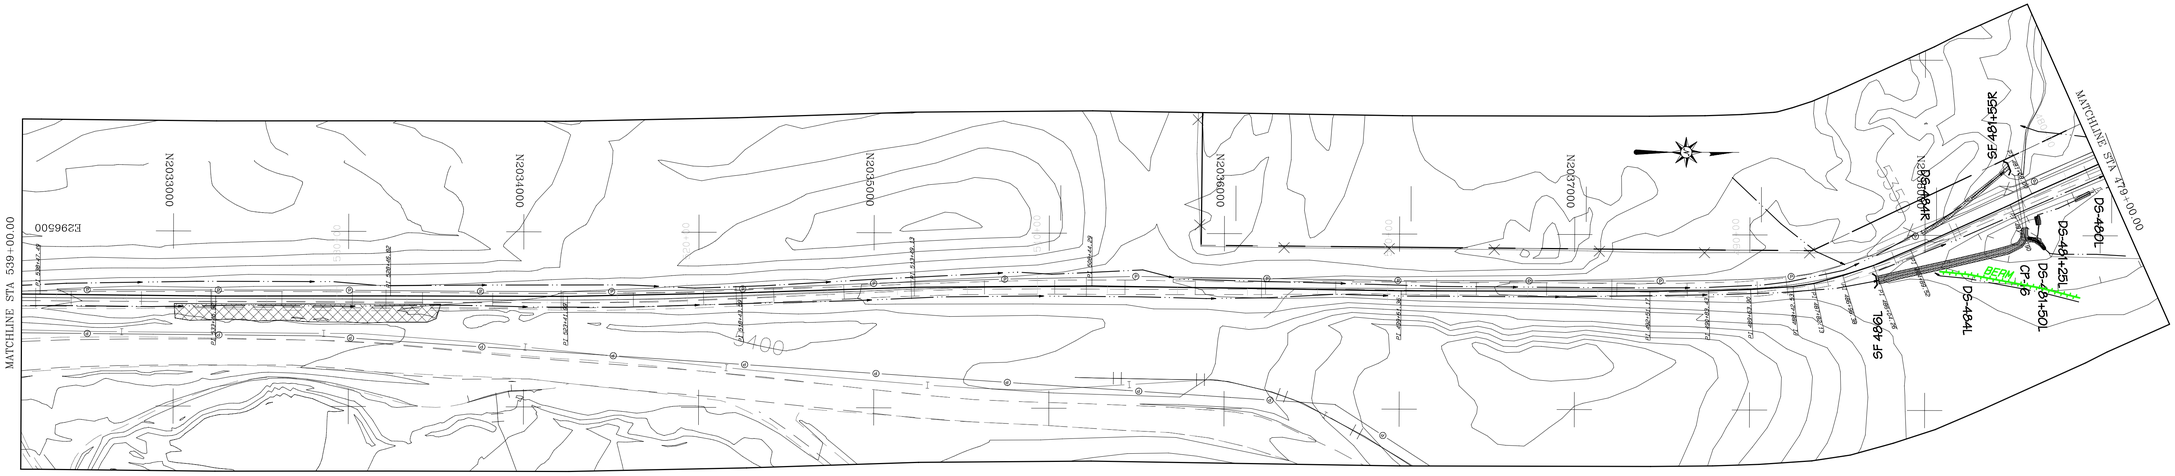

PLAN VIEW

Horiz. Scale: 1" = 300'

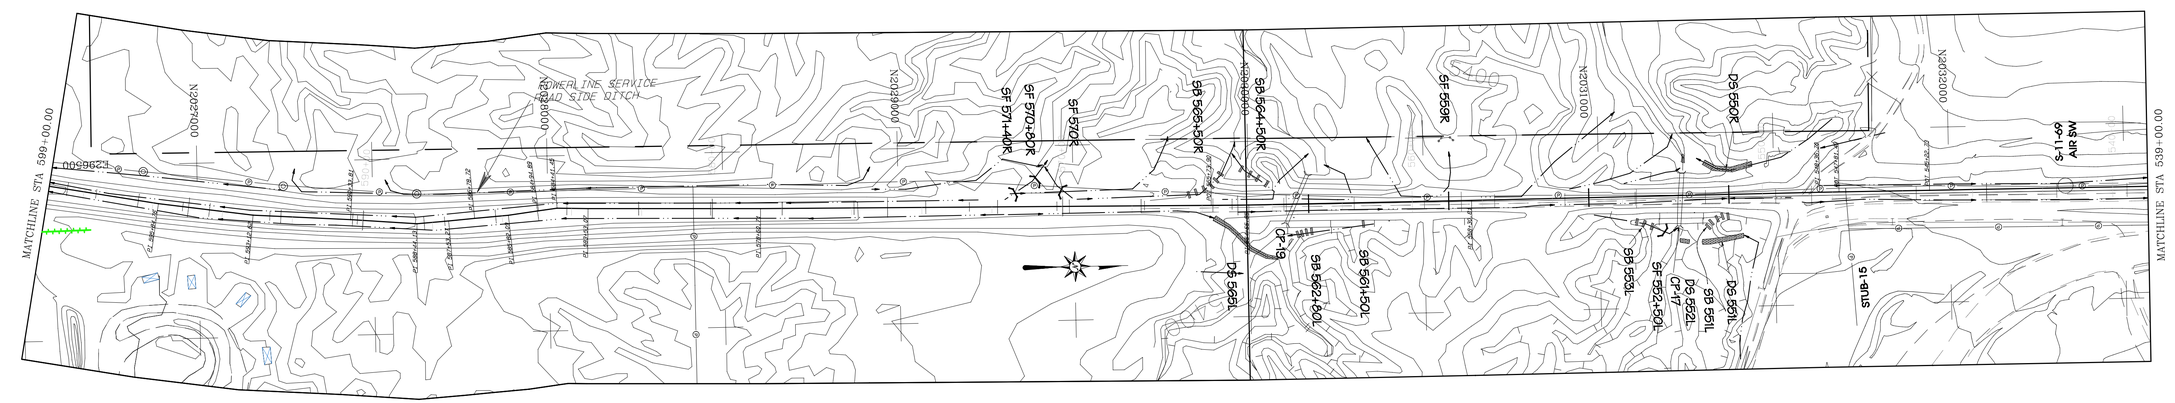

LEGEND

- DD-24 — DOWNDRAIN PIPES WITH DESIGNATION
- CONSTRUCTURED FLOW PATH (SIDE DITCHES, BERM/DITCH COMBINATION CHANNELS, AND RELIEF DITCHES)
- BERM — BERMS
- DS-1446 — DROP STRUCTURE WITH DESIGNATION
- CP-98 — CULVERT WITH DESIGNATION
- RAILROAD
- SB-SHRK — STRAW BALE STRUCTURE WITH DESIGNATION
- SF-SHRK — SILT FENCE STRUCTURE
- RR-SHRK — RIP-RAP STRUCTURE WITH DESIGNATION

NOTES :

1. FOR DESIGN DATA AND WATERSHED AREAS FOR DOWNDRAINS PIPES AND CULVERTS REFER TO APPENDIX 11-V AND EXHIBITS 11-12A THROUGH 11-12E, IN THE MINE PERMIT.
2. FOR DESIGNS DATA FOR DROP STRUCTURES AND DITCHES SEE APPENDIX 11-U IN THE MINE PERMIT.

CERTIFICATION STATEMENT

I, Ron C. Van Valkenburg, hereby certify that the erosion and drainage control structures has been constructed in accordance with the approved design plans, except as noted below.

NOTES:

1. FOR DEVIATIONS FROM THE DESIGN REFER TO THE NOTES BENEATH THE CERTIFICATION STATEMENT AND THE NOTES ADDED TO THE SEDIMENT/DRAINAGE CONTROL STRUCTURE SCHEDULE ON EXHIBIT 11-14T.

RON C. VAN VALKENBURG
NEW MEXICO
9263
LICENSED PROFESSIONAL ENGINEER

REVISION	DATE
1 AS-BUILT	7-27-07
2 Updated Exhibit and submitted to DOM for Review	10-7-08
3 Updated Exhibit and submitted to DOM for Review	9-21-09

PROJECT MANAGER: COREY NELSON
ENGR. of RECORD: LEONARD RAYMOND
REG. NO: 6500
SRVYR of RECORD:
REG. NO:

BHP-NAVAJO COAL CO.

PO BOX 155, FRUITLAND, NEW MEXICO, 87416

ACCOUNT:
DATE: JAN. 01, 2001
DESIGNED BY: PRAZTEK
DRAWN BY: PRAZTEK
CHECKED BY: LEONARD RAYMOND
APPROVED BY: LEONARD RAYMOND

PLAN VIEW

EXHIBIT 11-14P
NAVAJO MINE RAILROAD
EROSION AND DRAINAGE CONTROL STRUCTURES
AS-BUILT

DRAWING P-5

SHEET 5 OF 7 0

Project Desc: RAILROAD REV Path: \\ENGNWSRV-SRV02\Data\Departments\Eng\DGN_SUBWORK_PROJECH_11.PAP EXH(B)TS\11-01AW-RR SEDMT CNTL-DGN\REV-AS-BUILT_2008\EXH-11-14AW_AS-Built.dgn Plot time: Fri Oct 24 14:37:09 2008