11-032 -NORTH INDUSTRIAL FACILITIES PONDS STORM PIPE DRAINAGE - SAN JUAN COUNTY, NEW MEXICO (AS-BUILT)

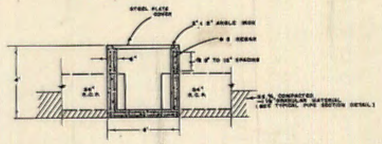

CONNECTOR BOX DETAIL #1

SCALE: 1/2" = 1'-0"

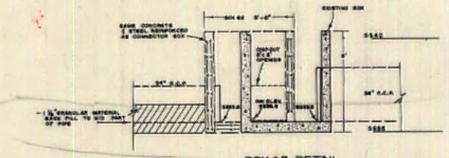

BOX #2 DETAIL

SCALE: 1/2" = 1'-0"

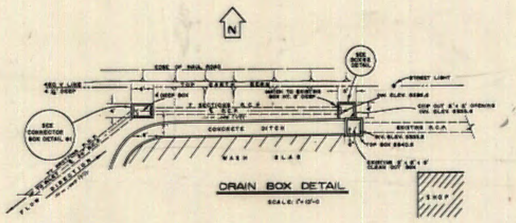

DRAIN BOX DETAIL

SCALE: 1" = 10'-0"

UTAH INTERNATIONAL INC.

FRUITLAND, NEW MEXICO

NORTH INDUSTRIAL FACILITIES PONDS
CONCRETE BOX DETAILS & SECTIONS

DRAWN BY J. GOLAS | SCALE AS NOTED
APPROVED BY | DATE 5-20-89
DRAWING NO. 09-2000-08 | LOCATION NO. 2-4-B

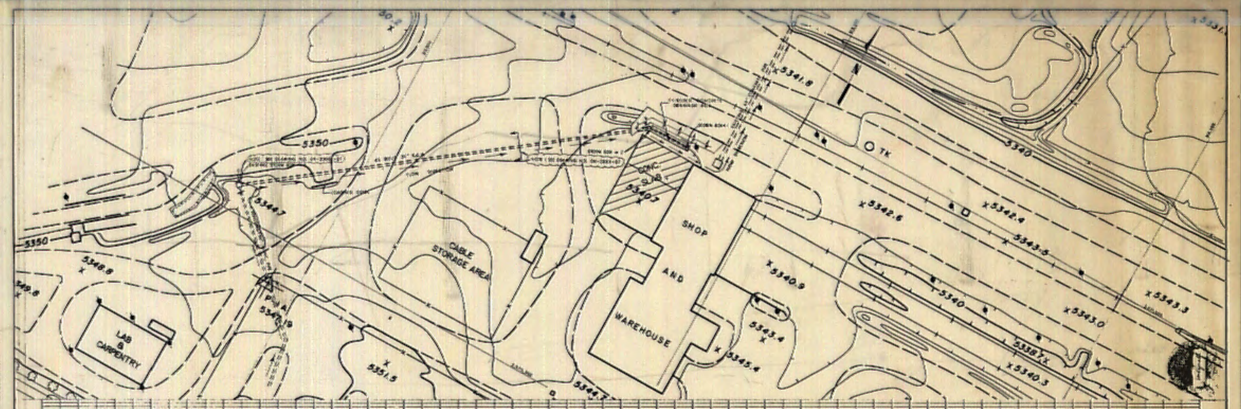

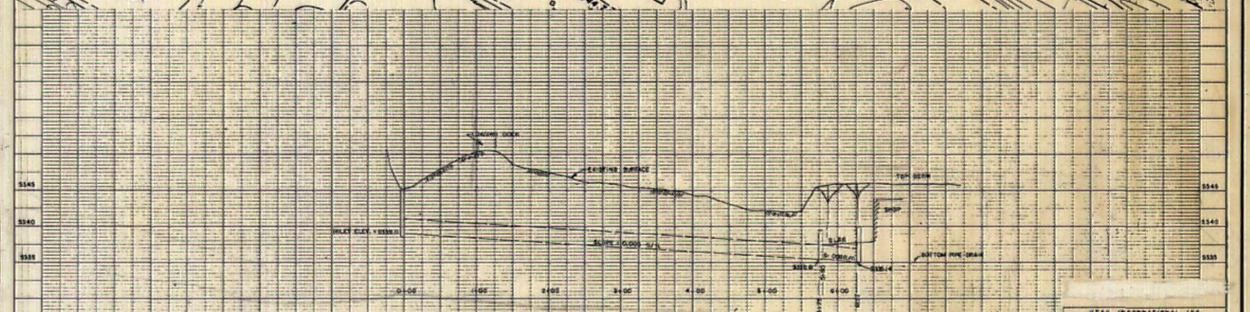

UTAH INTERNATIONAL INC.

FRUITLAND, NEW MEXICO

NORTH INDUSTRIAL FACILITIES PONDS
EMMA YAZZIE'S POND
PLAN & X-SECTION

DRAWN BY J. GOLAS | SCALE AS NOTED
APPROVED BY | DATE 6-17-88
DRAWING NO. 09-2000-07 | LOCATION NO. 2-4-B

TYPICAL PIPE SECTION - CLASS A - TRENCH BEDDING

SCALE: 1" = 2'-0"

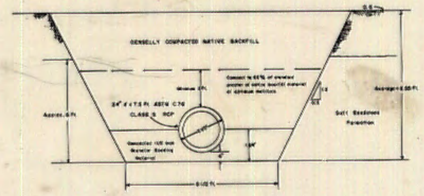

DETAIL OF SPIGOT GROOVE TYPE JOINT OF 24" ø R.C.P.

SCALE: 1" = 2'-0"

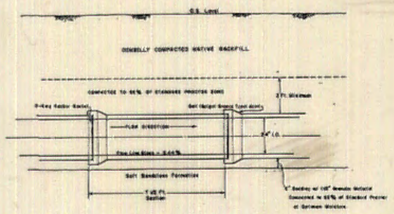

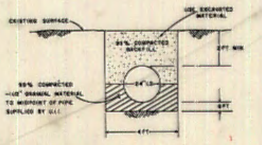

TYPICAL PIPE SECTION

SCALE: 1" = 2'-0"

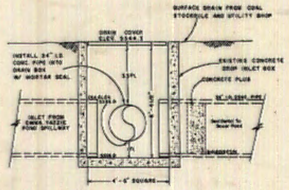

STORM BOX #3
INLET DETAIL

SCALE: 1" = 2'-0"

UTAH INTERNATIONAL INC.

FRUITLAND, NEW MEXICO

NORTH INDUSTRIAL FACILITIES PONDS
EMMA YAZZIE'S POND
PLAN & X-SECTION

DRAWN BY E.D. | SCALE AS NOTED
APPROVED BY | DATE JUNE 8, 1988
DRAWING NO. 09-2000-07 | LOCATION NO. 2-4-B

I, Ron Van Valkenburg, hereby certify changes on this drawing since the previous certification are accurate to the best of my knowledge.

EXHIBIT 11-32

AS BUILT

REV. NO.	DATE	REVISIONS	APPROVALS: DRAFT BY	ENGR.	CHIEF ENGR.	PROJECT MGR.
1	5/87	Added Parallel Stack, Darling PE Stamp	BBA	RBA	JSL	
2	11/87	CHANGED CO. NAME TO BHP - UI	DB	RBA	JSL	
3	8/24/93	CHG. CO. NAME & CHA. CHG NO TO 11-92	JG			

BHP MINERALS INTERNATIONAL

NAVAJO MINE

FRUITLAND, NEW MEXICO

NORTH INDUSTRIAL FACILITIES PONDS

STORM PIPE DRAINAGE

SAN JUAN COUNTY, NEW MEXICO

DRAWN BY AS NOTED | SCALE AS NOTED
APPROVED BY JSL | DATE 10-16-1986
DRAWING NO. | LOCATION NO. NIF-01a