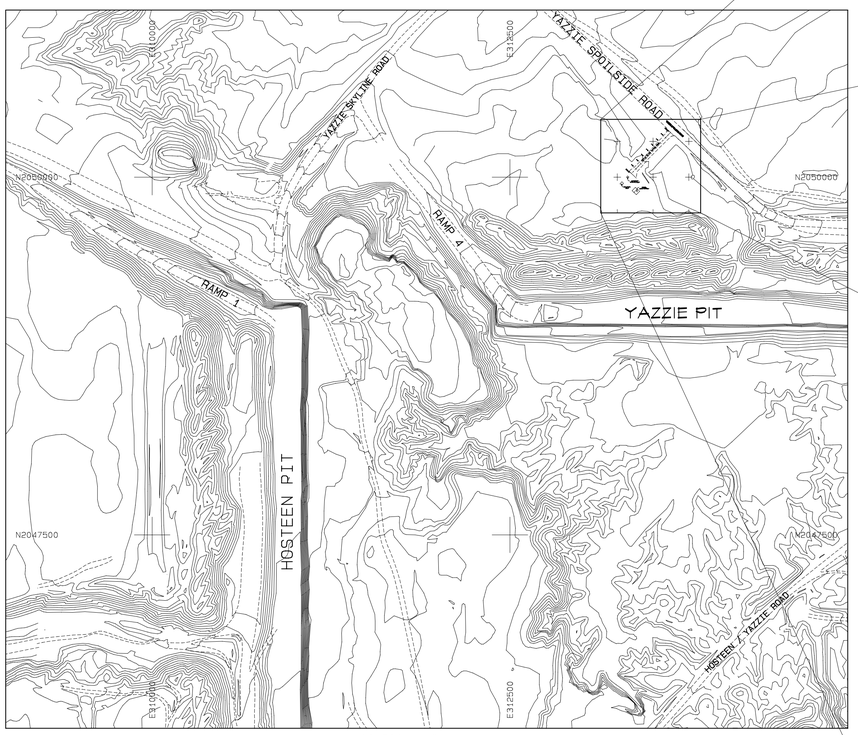

LOCATION MAP
Scale: 1" = 500'

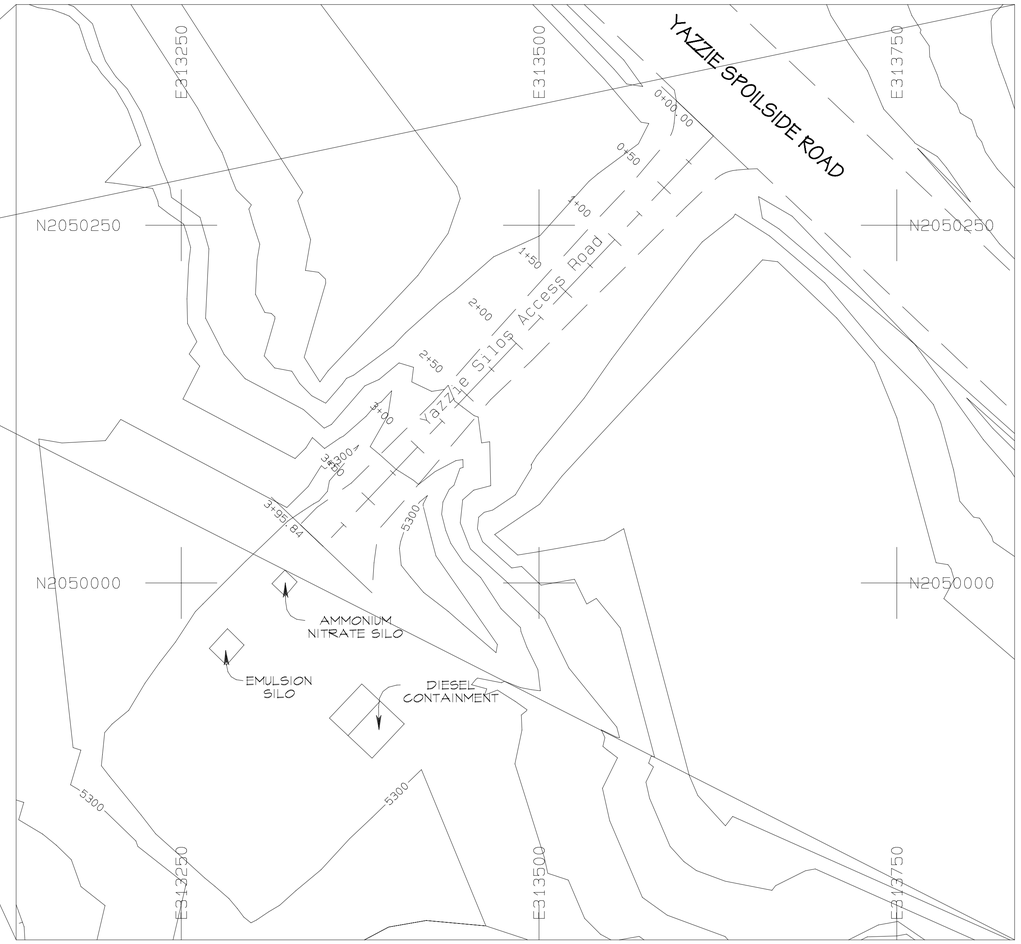

PLAN
Scale: 1" = 50'

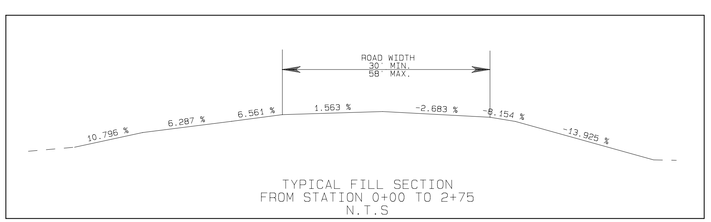

TYPICAL FILL SECTION
FROM STATION 0+00 TO 2+75
N.T.S

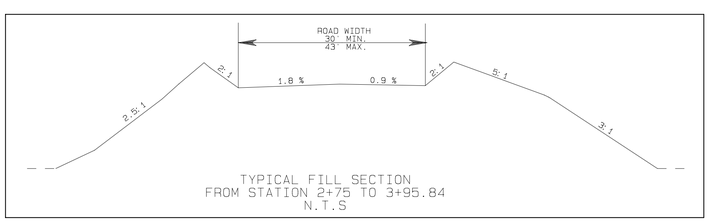

TYPICAL FILL SECTION
FROM STATION 2+75 TO 3+95.84
N.T.S

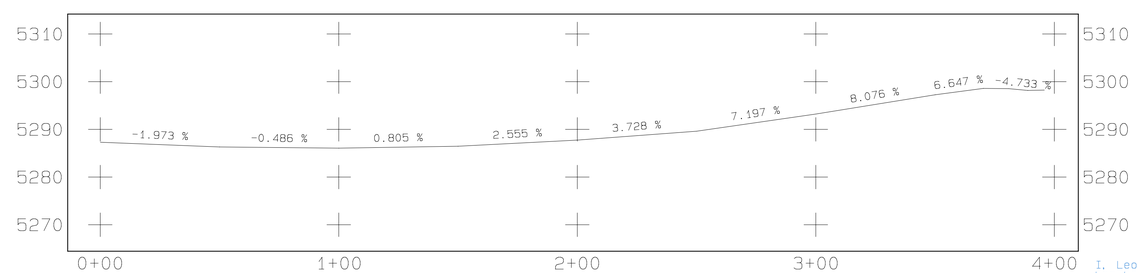

Profile of Centerline Yazzie
Silos Access Road
HORIZONTAL=1"=30'
VERTICAL=1"=15'

LEGEND

- ROAD
- WATERSHED
- BUILDING
- FENCE
- IRRIGATION LINE
- CULVERT
- DAM
- DRAINAGE
- RAILROAD
- TREES
- POWERLINE
- ×5338.5 SPOT ELEVATION
- 5300 INDEX CONTOUR
- 5298 INTERMEDIATE CONTOUR
- 218 5422.45 L-30 LEASE CORNER
- PERMIT/LEASE BOUNDARY

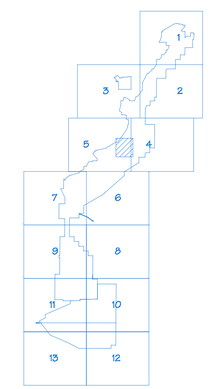

SCALE AS NOTED

CERTIFICATION STATEMENT

I, Leonard Raymond, hereby certify that this access road has been constructed in accordance with the approved design plans and that the information shown is complete and accurate to the best of my knowledge, except as noted below.

LEONARD RAYMOND
NEW MEXICO
6600
REGISTERED PROFESSIONAL ENGINEER

1. The safety berms were not installed in the reach of road where it is not required.

REV NO.	DESCRIPTION	REV BY	DATE
1	SUBMITTED TO DSM FOR REVIEW	RY	08-11-05
2			
3			
4			
5			

PROJECT MANAGER: JR
ENGR. of RECORD: LR
REG. NO: 6600
SRVYR of RECORD:
REG. NO:

BHP NAVAJO COAL CO.
NAVAJO MINE
PO BOX 1717, FRUITLAND, NEW MEXICO, 87416

ACCOUNT:
DATE: 08-11-05
DESIGNED BY: RY
DRAWN BY: RY
CHECKED BY: LR
APPROVED BY: LR

PLAN, PROFILE AND SECTION

EXHIBIT 11-07A
Yazzie Silos Access Road
As-built

DRAWING

SHEET 1
OF 1

Path: \\DENCHENG-SRV01\Data\Departments\Eng\Engineering\Projects\Yazzie Silos Access Road As-built.dwg