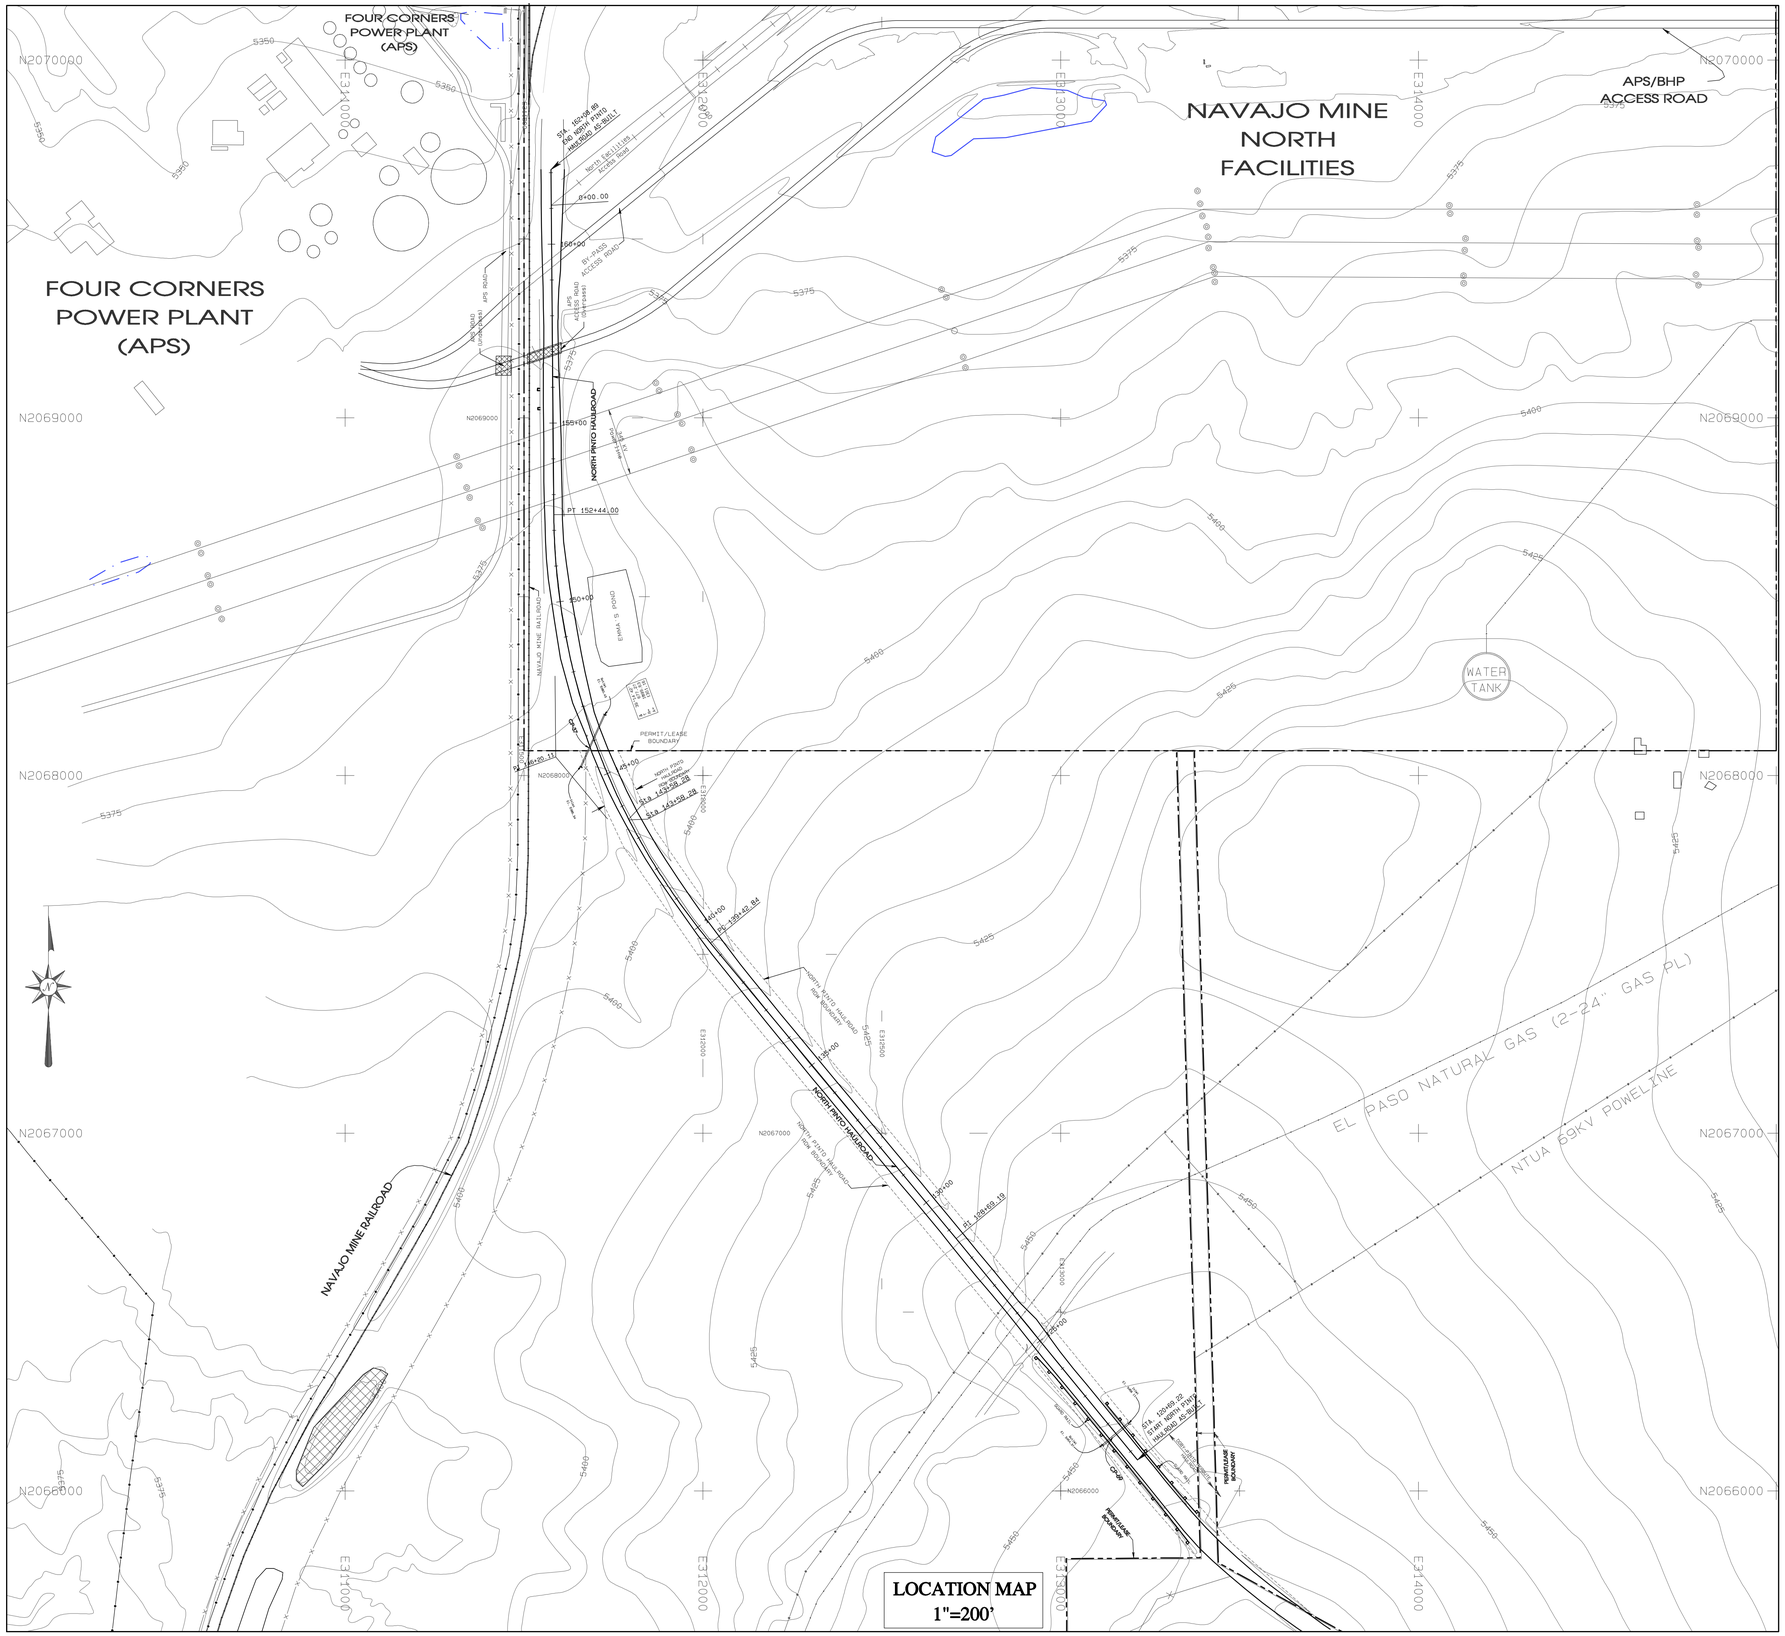

LOCATION MAP
1"=200'

LEGEND

- ROAD
- WATERSHED
- BUILDING
- FENCE
- IRRIGATION LINE
- CULVERT
- DAM
- DRAINAGE
- RAILROAD
- TREES
- POWERLINE
- ×5338.5 SPOT ELEVATION
- 5300 INDEX CONTOUR
- 5299 INTERMEDIATE CONTOUR
- 218 5422.45
- L-30 LEASE CORNER
- LEASE/PERMIT BOUNDARY

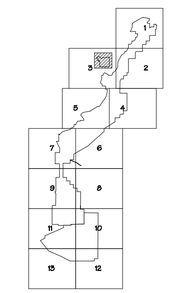

DRAWINGS INDEX
EXH 11-55D-1 OF 2_NORTH PINTO HAULROAD AS-BUILT LOCATION MAP
EXH 11-55D-2 OF 2_NORTH PINTO HAULROAD AS-BUILT PLAN/PROFILE

REV. No.	DATE	DRAFT. BY	REVISION DESCRIPTION	ENG.	E.G.	P.E.	APPROVALS
09-A	11-23-09	PJF	PREPARED AS-BUILT EXHIBIT FOR NORTH PINTO HAULRD AND SUBMITTED TO DSM FOR REVIEW.	RCVV	YS	RCVV	

CERTIFICATION STATEMENT

I, Ron C. Van Valkenburg, hereby certify that this drawing was reviewed by me and that the information shown is complete and accurate to the best of my knowledge.

RON C. VAN VALKENBURG
NEW MEXICO
9263
LICENSED PROFESSIONAL ENGINEER

EXHIBIT 11-55D

NAVAJO COAL COMPANY

bhpbilliton

P.O.BOX 1717 FRUITLAND, NEW MEXICO 87416/PHONE 505-598-4200/FAX 505-598-3361

AREA-I
NORTH PINTO HAULROAD
AS-BUILT
LOCATION MAP

PREPARED BY	PJF	DRAWN BY PJF	AS NOTED
APPROVED BY	RVV	DATE 11-09-09	Sheet 1 of 2

G:\Gis\Permit FCh 11\Exhibit 11-55D\As-Built Data\EXH 11-55D_NORTH PINTO HAULRD AS-BUILT.dwg
Mon Nov 30 12:45:35 2009