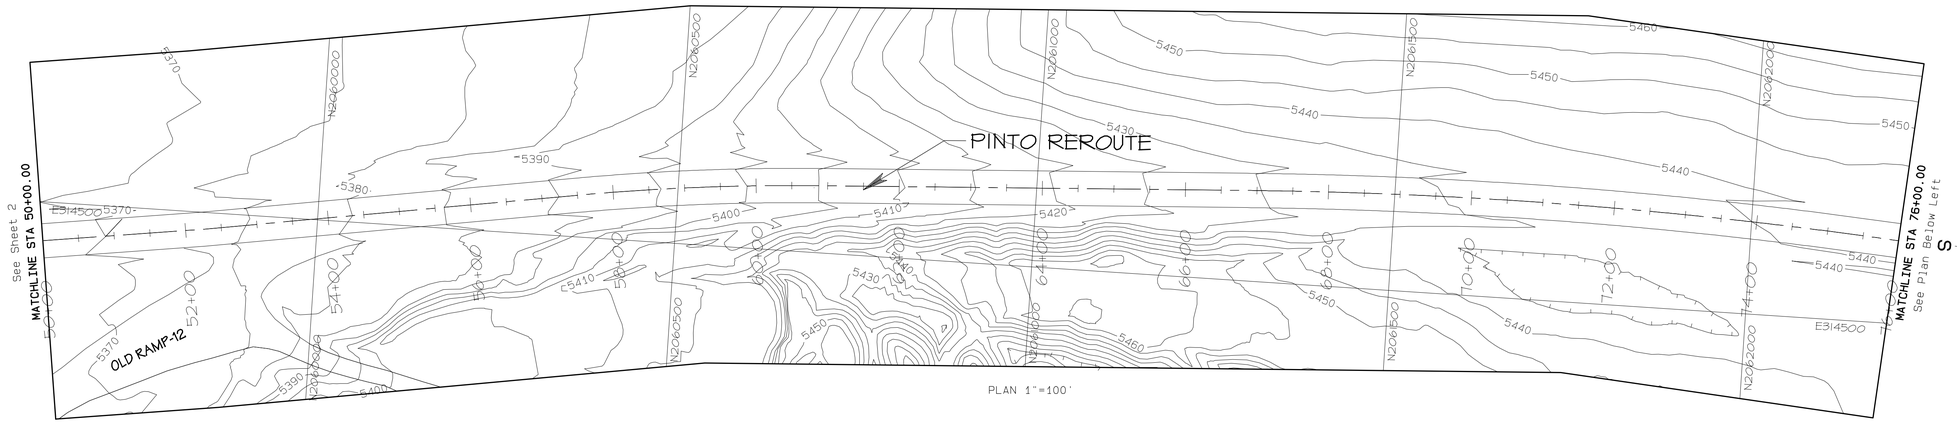

PLAN 1"=100'

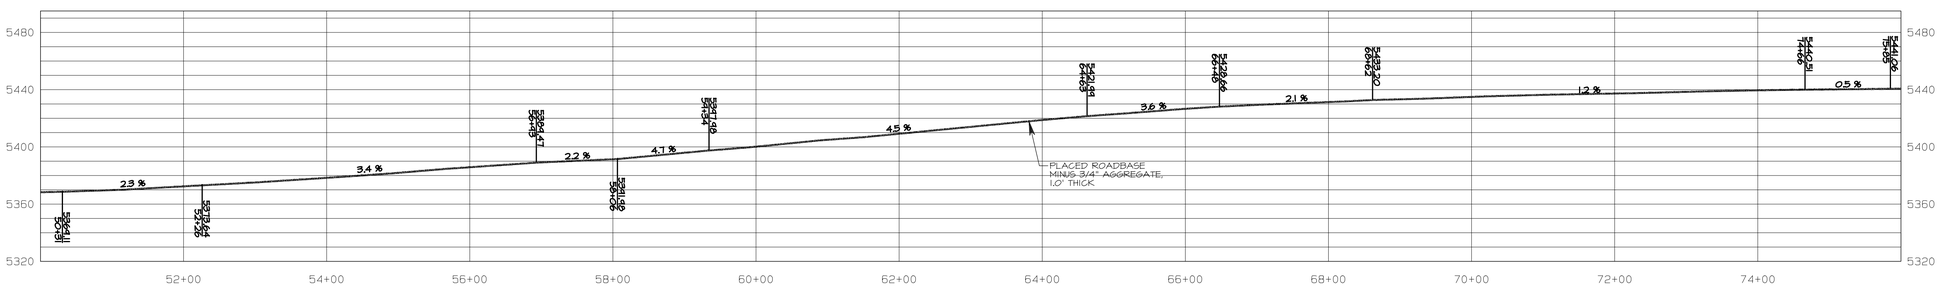

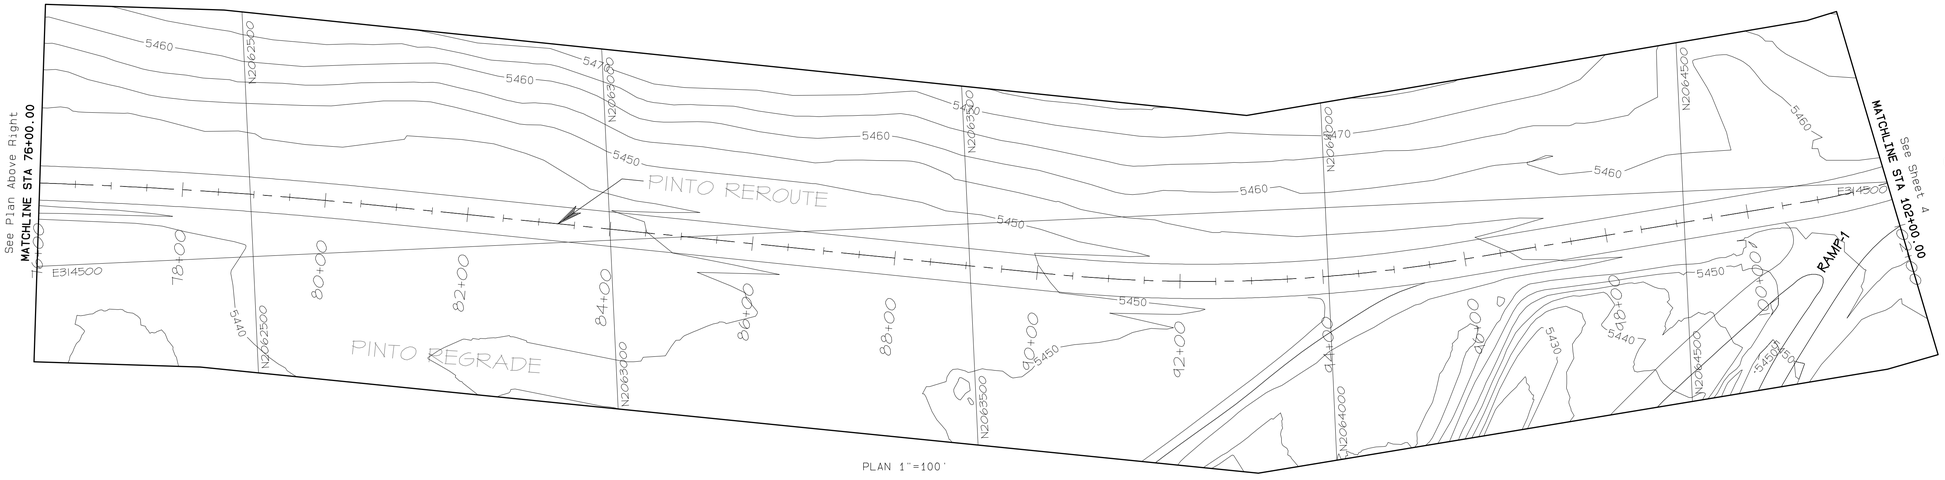

PLAN 1"=100'

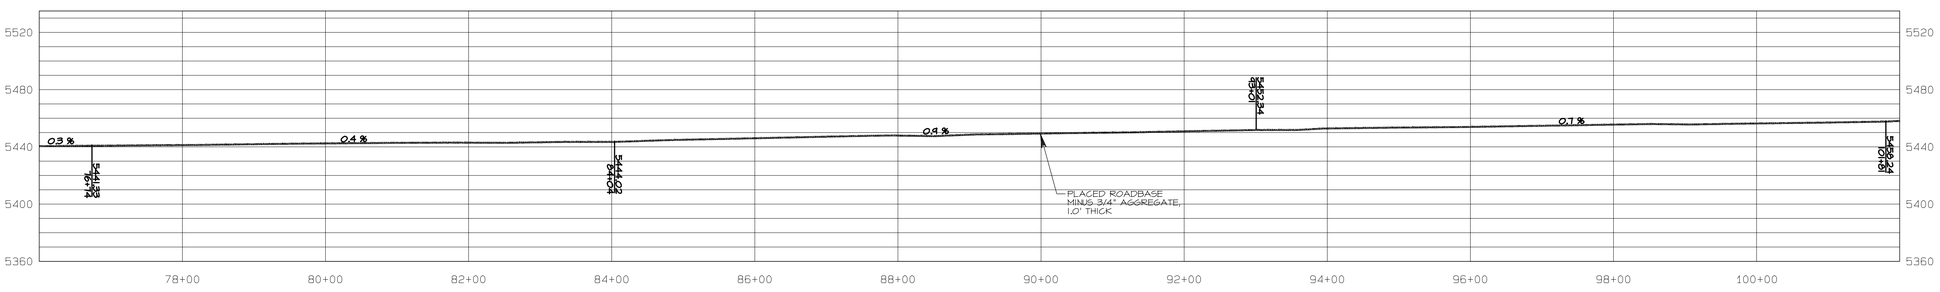

ABOVE PROFILES
HORIZONTAL 1"=100'
VERTICAL 1"=50'

LEGEND

- ROAD
- BUILDING
- FENCE
- CULVERT
- DRAINAGE
- POWERLINE
- 5300 INDEX CONTOUR
- 5298 INTERMEDIATE CONTOUR
- PERMIT/LEASE BOUNDARY

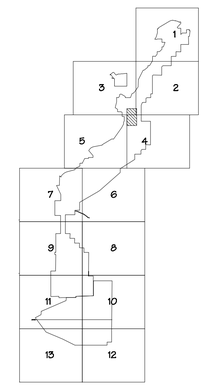

SCALE AS NOTED

CERTIFICATION STATEMENT

I, Ron C. VAN VALKENBURG, hereby certify that this drawing was reviewed by me and that the information shown is complete and accurate to the best of my knowledge.

RON C. VAN VALKENBURG
NEW MEXICO
9263
LICENSED PROFESSIONAL ENGINEER

REV	REVISION	DATE
00-A	Submitted to OSM for Approval	Feb.26.09

PROJECT MANAGER: FG
ENGR. of RECORD: RCV
REG. NO: 9263
SRVYR of RECORD:
REG. NO:

bhpbilliton
BHP NAVAJO COAL CO.
NAVAJO MINE
PO BOX 1717, FRUITLAND, NEW MEXICO, 87416 PHONE 505-598-3200/FAX 505-598-3361

PROJECT: ROAD AS-BUILT
DATE: 2/26/09
DESIGNED BY:
DRAWN BY: RY
CHECKED BY: RCV
APPROVED BY: RCV

PLAN AND PROFILE

EXHIBIT 11-55B
Doby / Pinto Re-route Haulroad
As-built

DRAWING

SHEET 2 OF 3