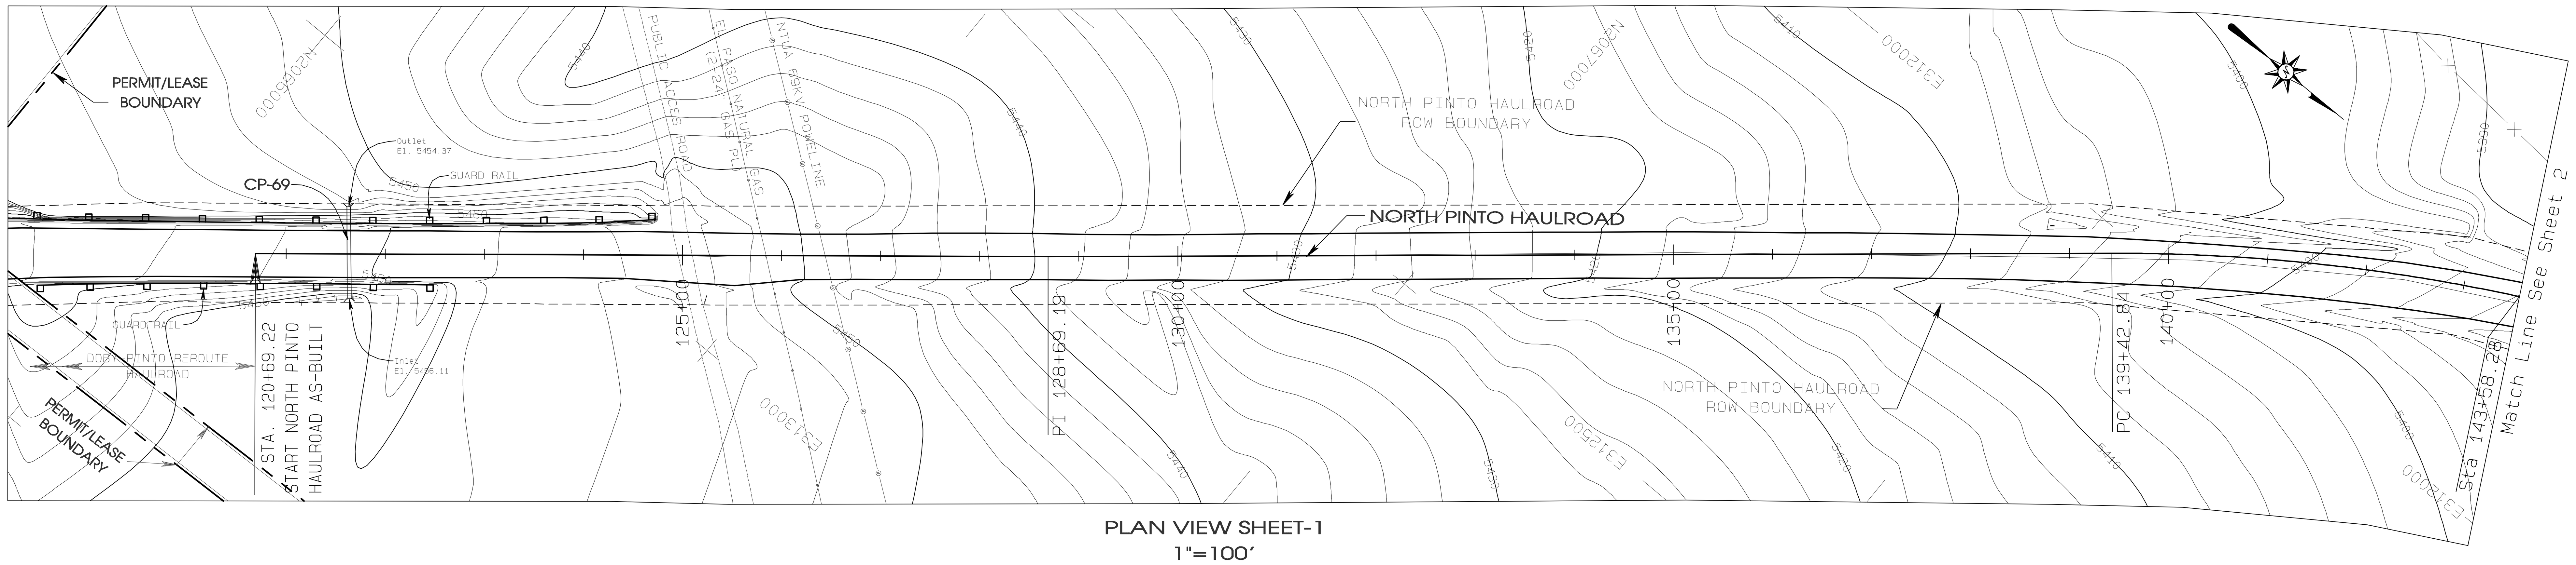

PLAN VIEW SHEET-1
1"=100'

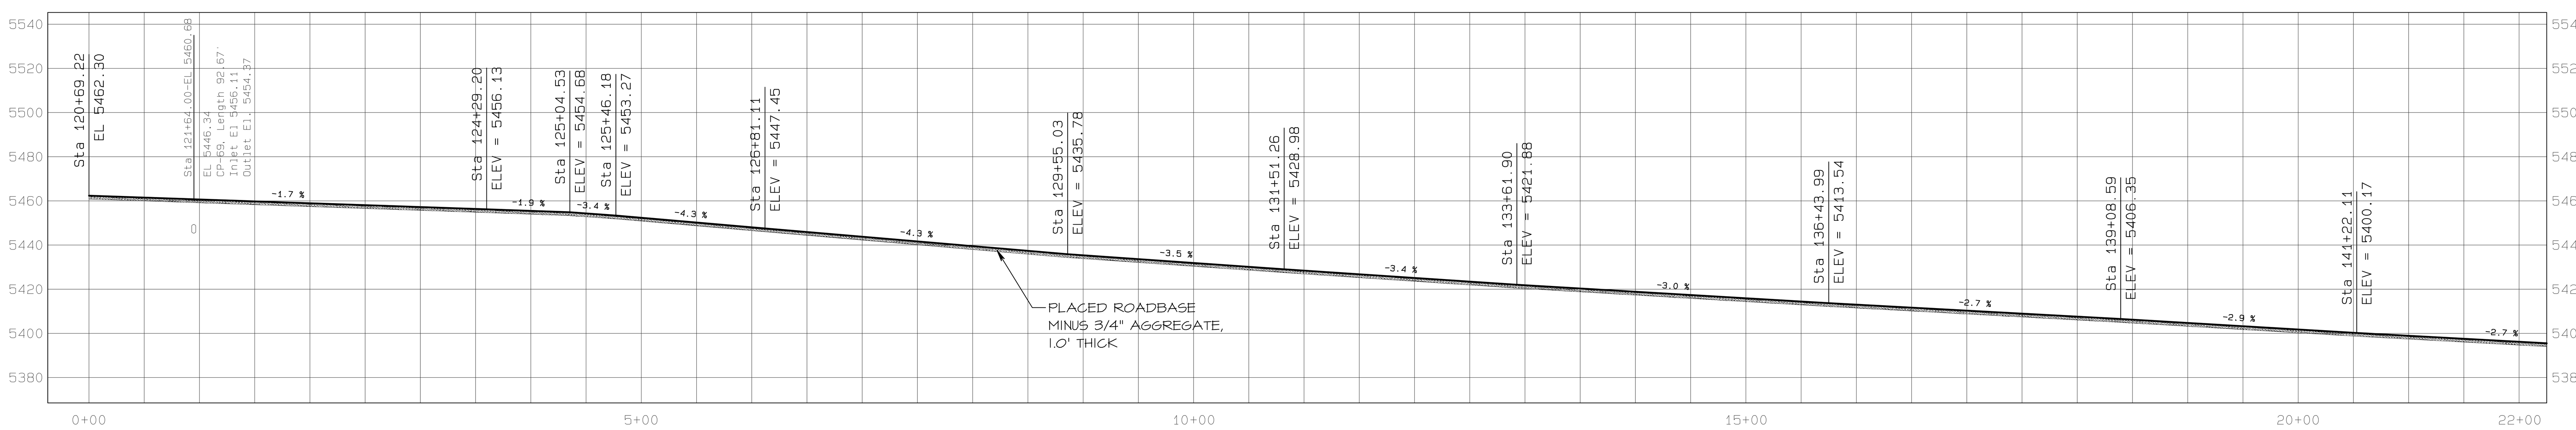

PROFILE VIEW
SCALE: H-1"=100'
V-1"=50'

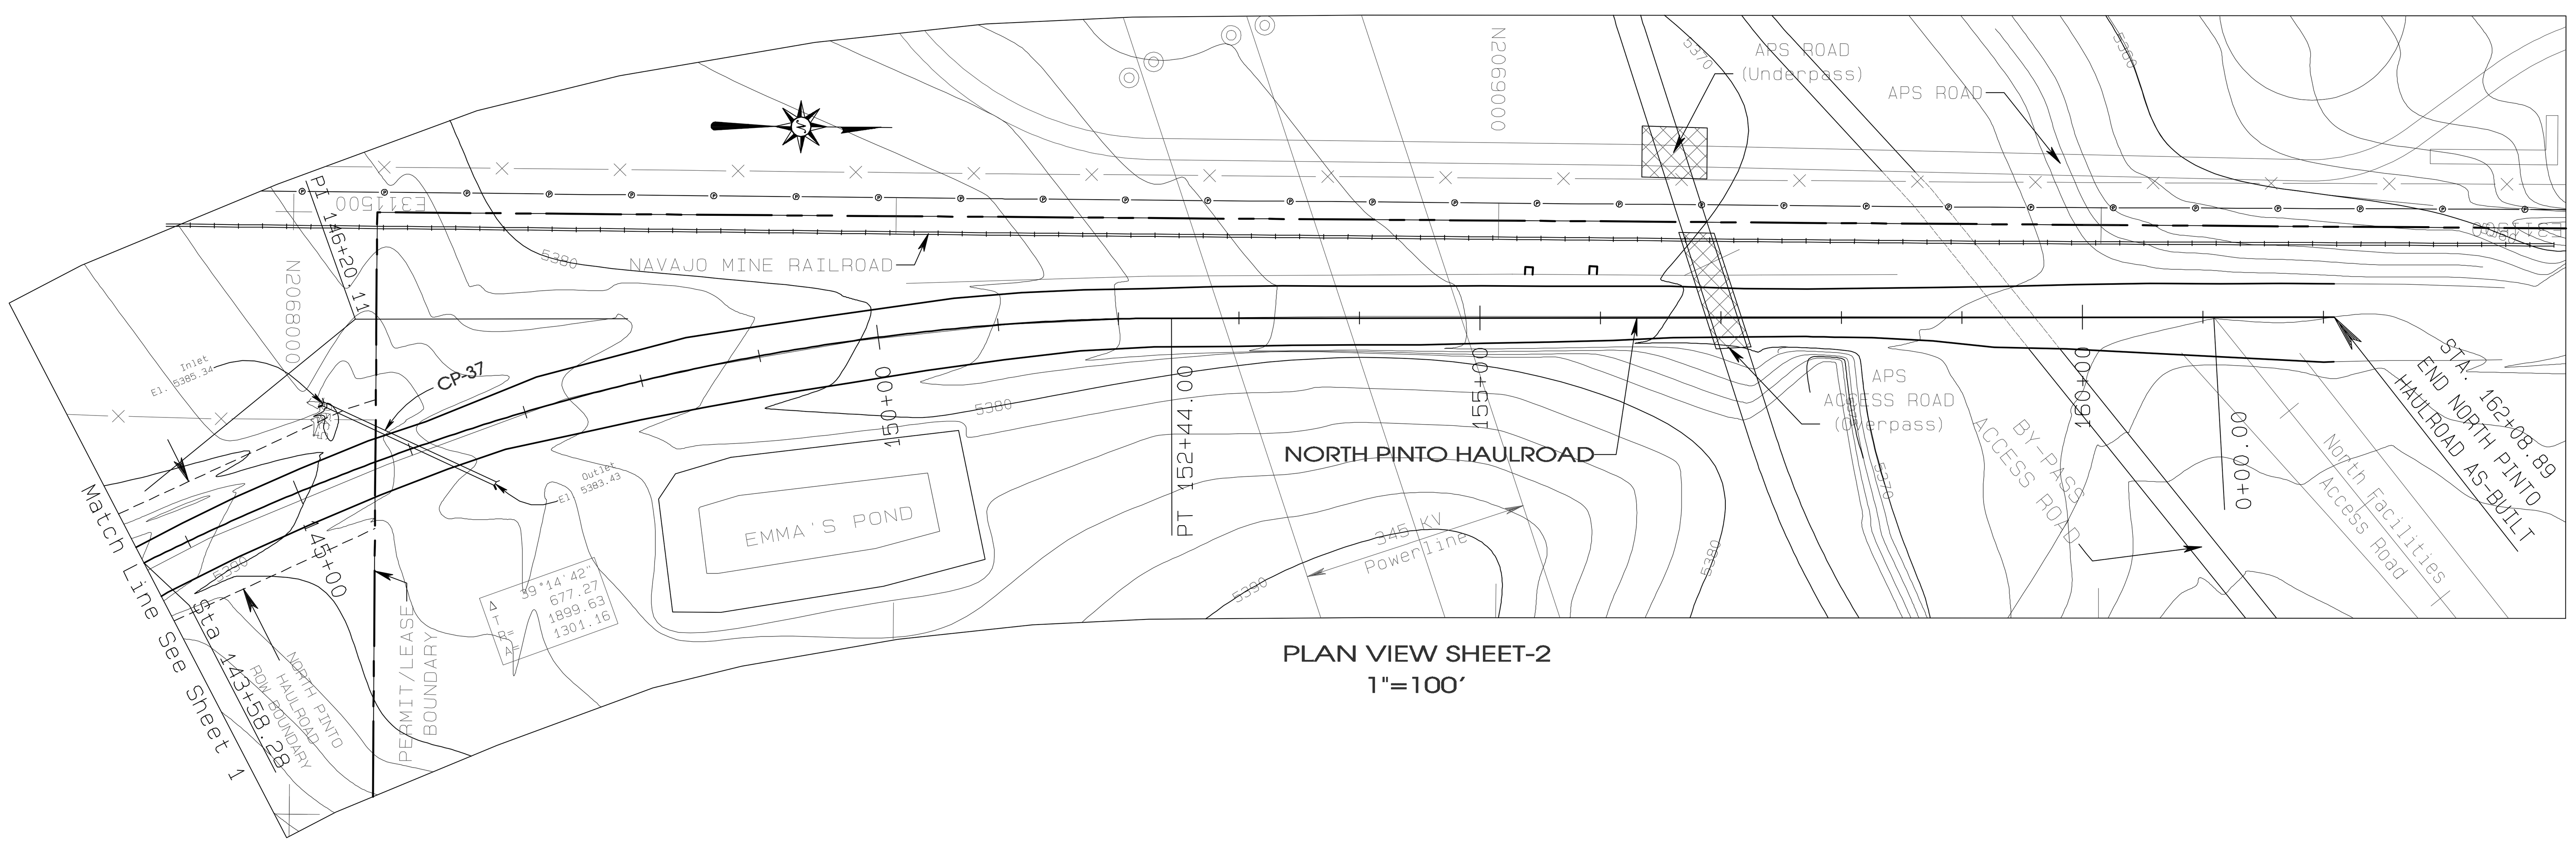

PLAN VIEW SHEET-2
1"=100'

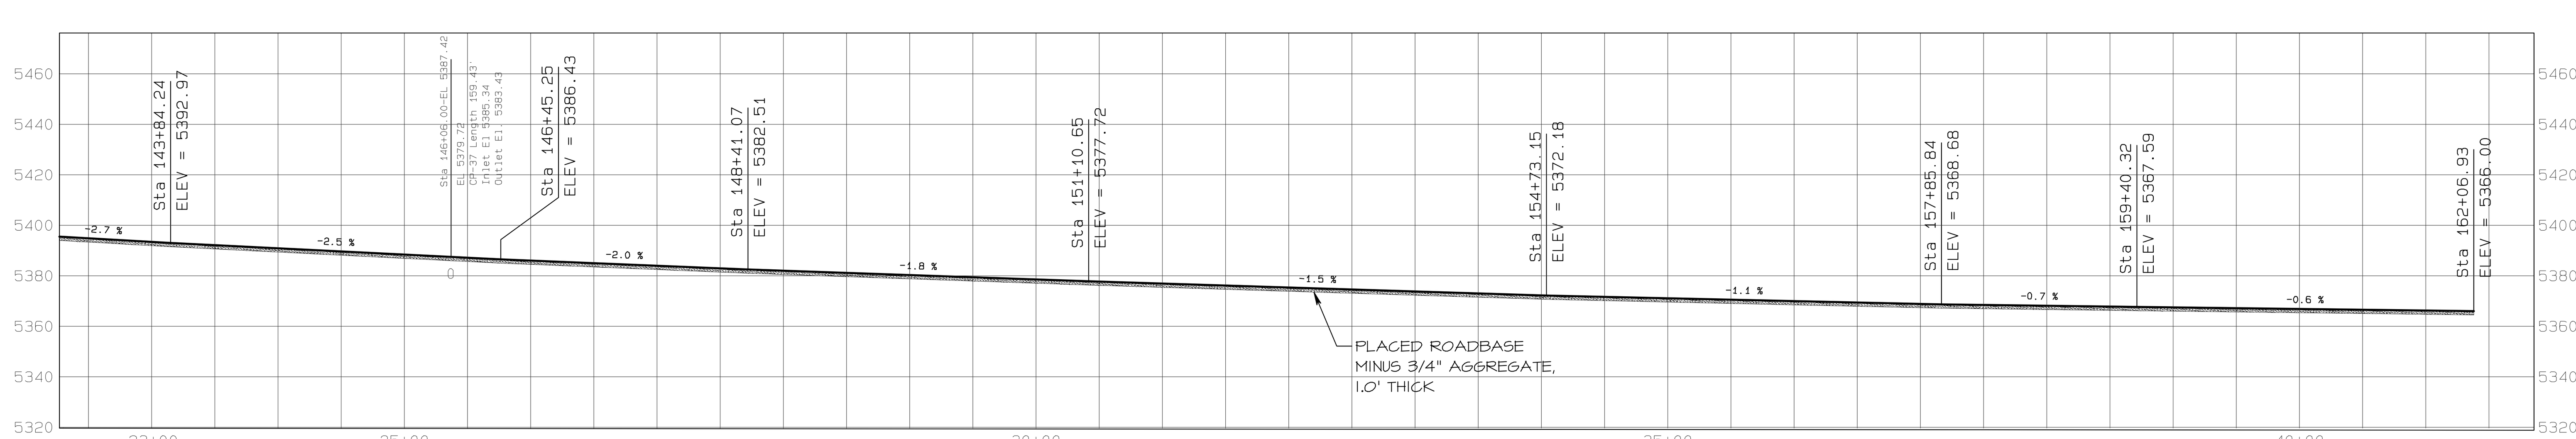

PROFILE VIEW
SCALE: H-1"=100'
V-1"=50'

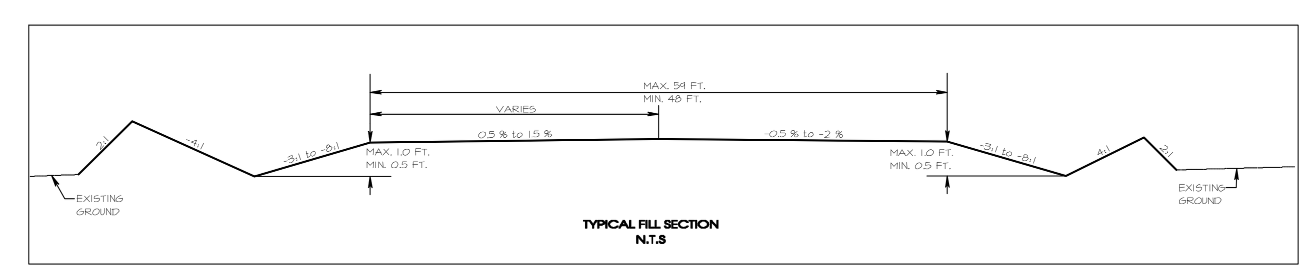

TYPICAL FILL SECTION
N.T.S

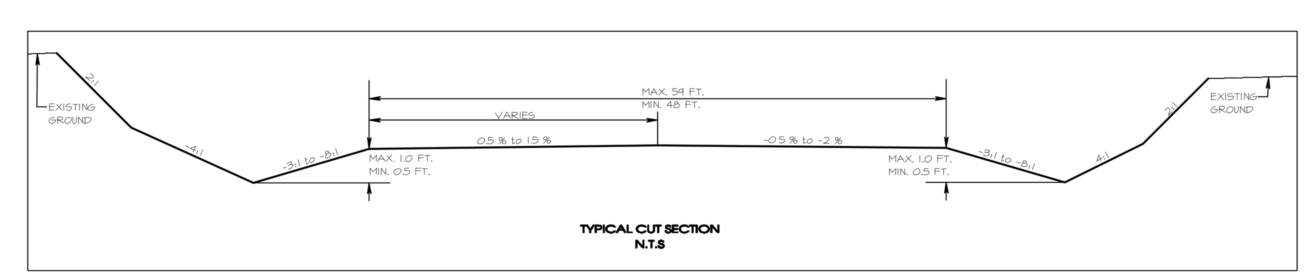

TYPICAL CUT SECTION
N.T.S

LEGEND

- ROAD
- WATERSHED
- BUILDING
- FENCE
- IRRIGATION LINE
- CULVERT
- DAM
- DRAINAGE
- RAILROAD
- TREES
- POWERLINE
- ×5338.5 SPOT ELEVATION
- 5300 INDEX CONTOUR
- 5298 INTERMEDIATE CONTOUR
- 218 5422.45
- L-30 LEASE CORNER
- LEASE/PERMIT BOUNDARY

REV. No.	DATE	DRAFT. BY	REVISION DESCRIPTION	ENG.	E.Q.	P.E.
09-A	11-23-09	PJF	PREPARED AS-BUILT EXHIBIT FOR NORTH PINTO HAULRD AND SUBMITTED TO OSM FOR REVIEW.	RCVV	YB	RCVV

APPROVALS

CERTIFICATION STATEMENT

I, Ron C. Van Valkenburg, hereby certify that this drawing was reviewed by me and that the information shown is complete and accurate to the best of my knowledge.

RON C. VAN VALKENBURG NEW MEXICO 9263 LICENSED PROFESSIONAL ENGINEER

EXHIBIT 11-55D

NAVAJO COAL COMPANY

bhpbilliton

P.O.BOX 1717 FRUITLAND, NEW MEXICO 87416/PHONE 505-598-4200/FAX 505-598-3361

AREA-I
NORTH PINTO HAULROAD
PLAN/PROFILE
AS-BUILT

PREPARED BY PJF	DRAWN BY PJF	AS NOTED
APPROVED BY RVV	DATE 11-09-09	Sheet 2 of 2

G:\Gs\Permit F\Ch 11\Exhibit 11-055\As-Built Data\EXH 11-55_NORTH PINTO HAULRD AS-BUILT.pro
Mon Nov 30 12:45:34 2009