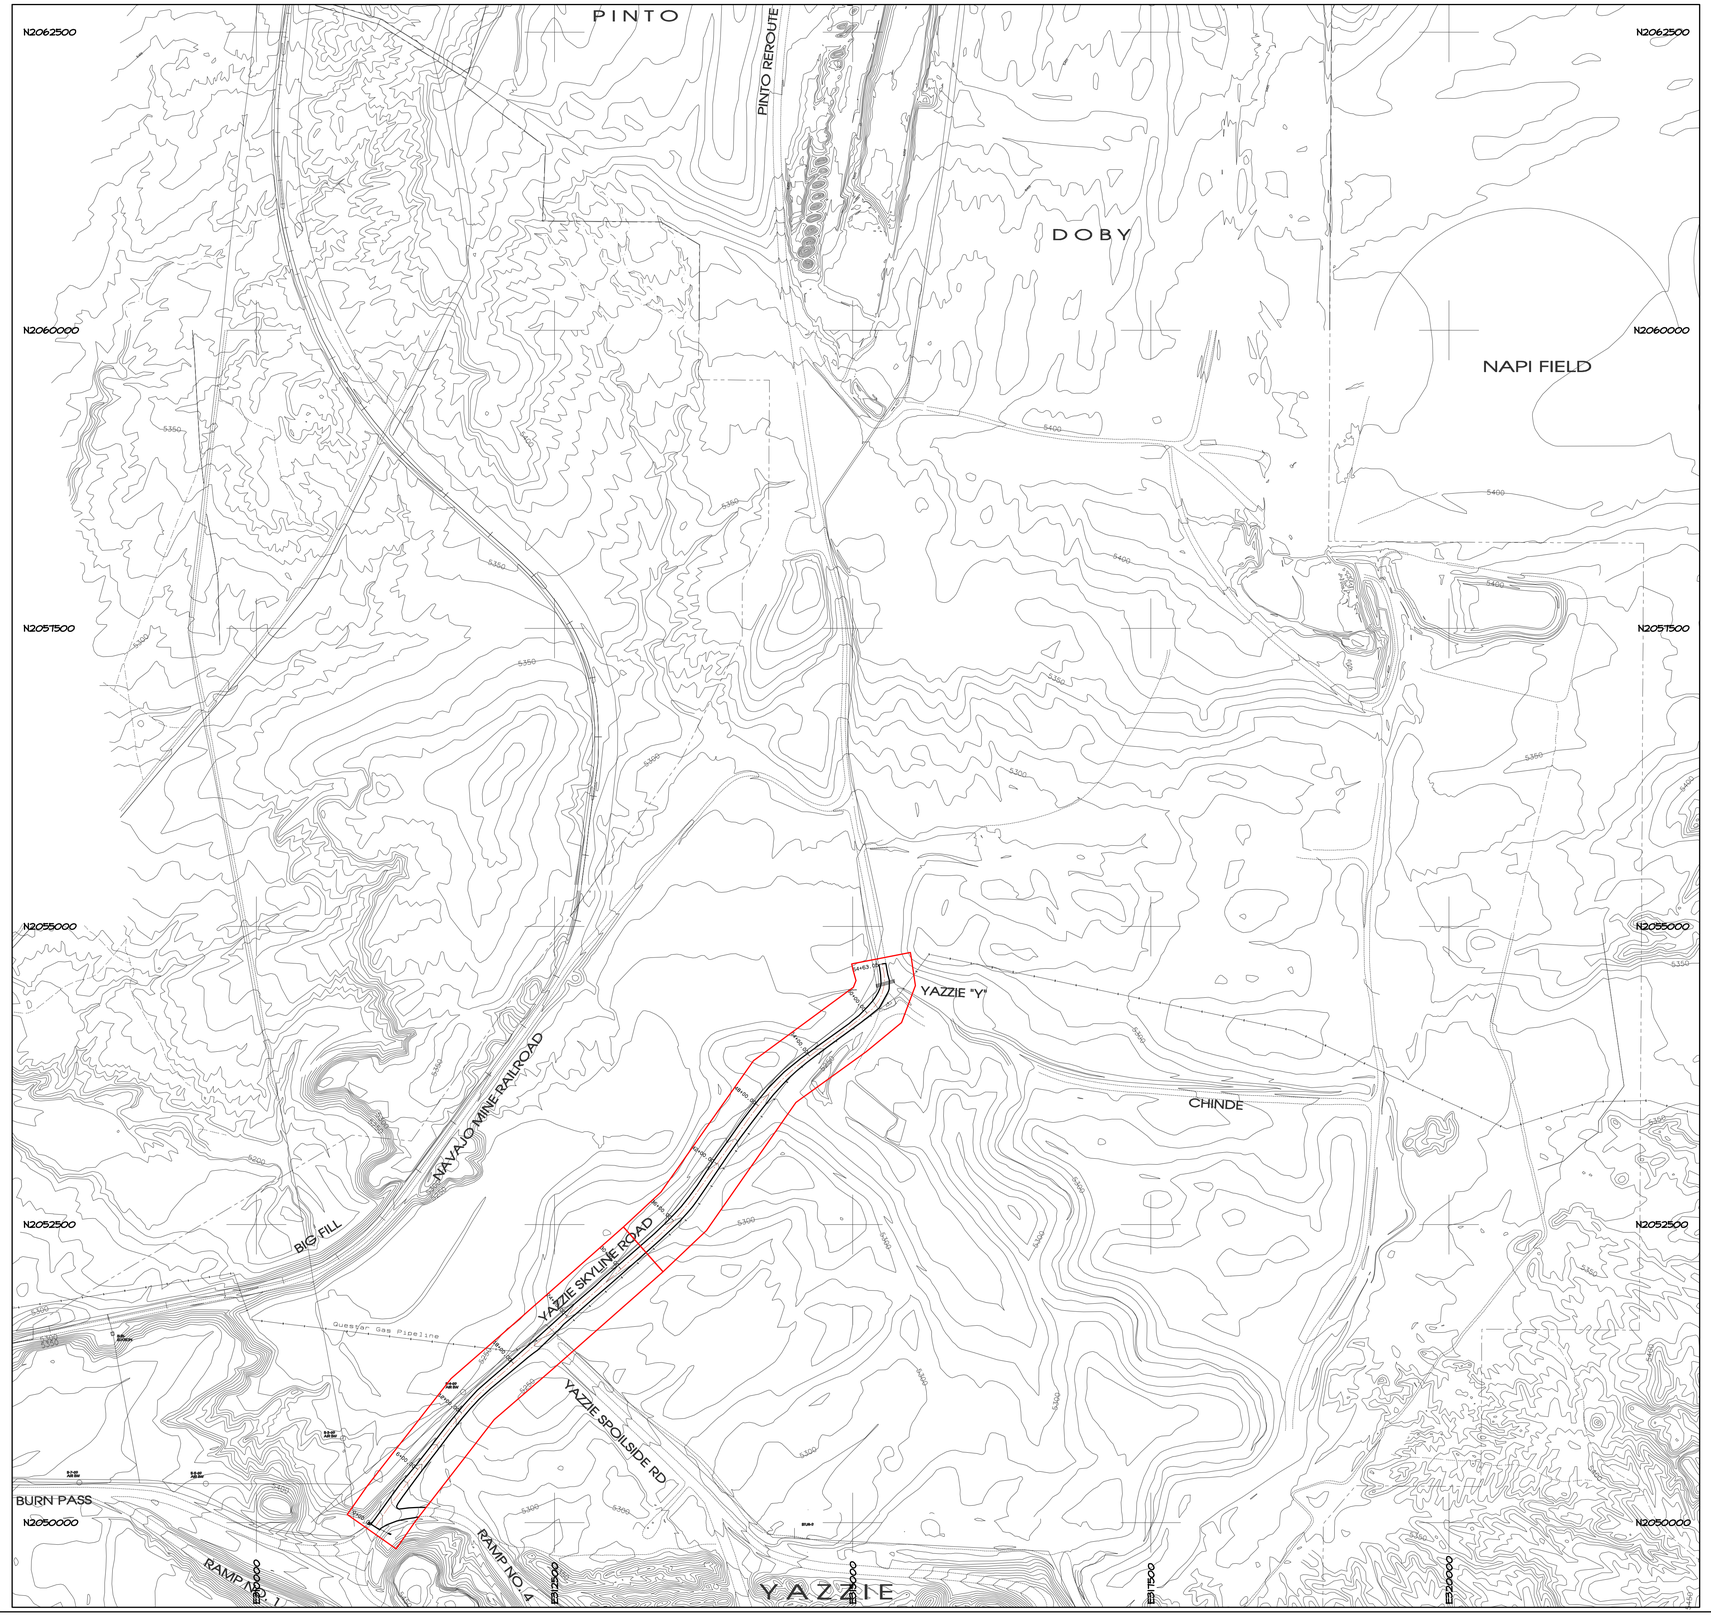

LEGEND

- ROAD
- BUILDING
- FENCE
- CULVERT
- DRAINAGE
- POWERLINE
- 5300 INDEX CONTOUR
- 5298 INTERMEDIATE CONTOUR
- PERMIT/LEASE BOUNDARY

NOTES

1. The watershed areas for culverts are shown on Exhibit 11-12C.

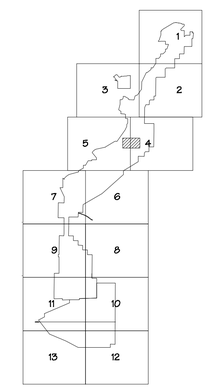

SCALE AS NOTED

CERTIFICATION STATEMENT

I, Ron C. VAN VALKENBURG, hereby certify that this drawing was reviewed by me and that the information shown is complete and accurate to the best of my knowledge.

Ron C. VAN VALKENBURG
NEW MEXICO
9263
LICENSED PROFESSIONAL ENGINEER

REVISION	DATE
Submitted to OSM for Review	3/15/09

PROJECT MANAGER: FG
ENGR. of RECORD: RCV
REG. NO: 9263
SPVTR of RECORD:
REG. NO:

bhpbilliton
BHP NAVAJO COAL COMPANY
NAVAJO MINE
P.O. BOX 1717, FRUITLAND, NEW MEXICO, 87416 PHONE 505-598-3209/FAX 505-598-3361

PROJECT:
DATE: 3/15/09
DESIGNED BY: RV
DRAWN BY: RV
CHECKED BY: RCV
APPROVED BY: RCV

LOCATION MAP

EXHIBIT 11-56
YAZZIE SKYLINE ROAD
AS-BUILT

DRAWING

SHEET 1 OF 3