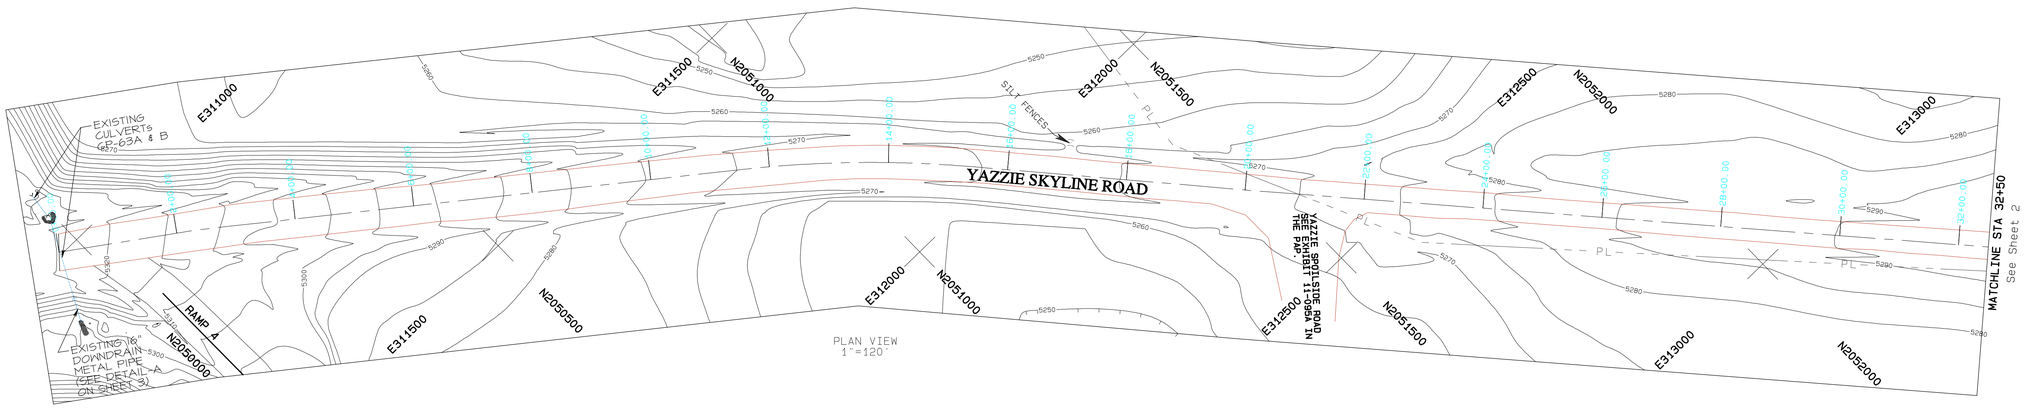

LEGEND

- ROAD
- BUILDING
- FENCE
- CULVERT
- DRAINAGE
- POWERLINE
- 5300 INDEX CONTOUR
- 5298 INTERMEDIATE CONTOUR
- PERMIT/LEASE BOUNDARY

NOTES

1. The watershed areas for culverts are shown on Exhibit 11-12C.

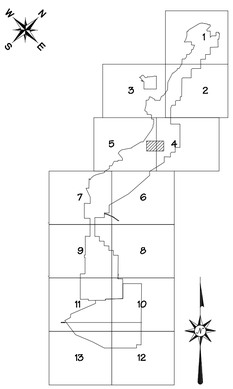

SCALE AS NOTED

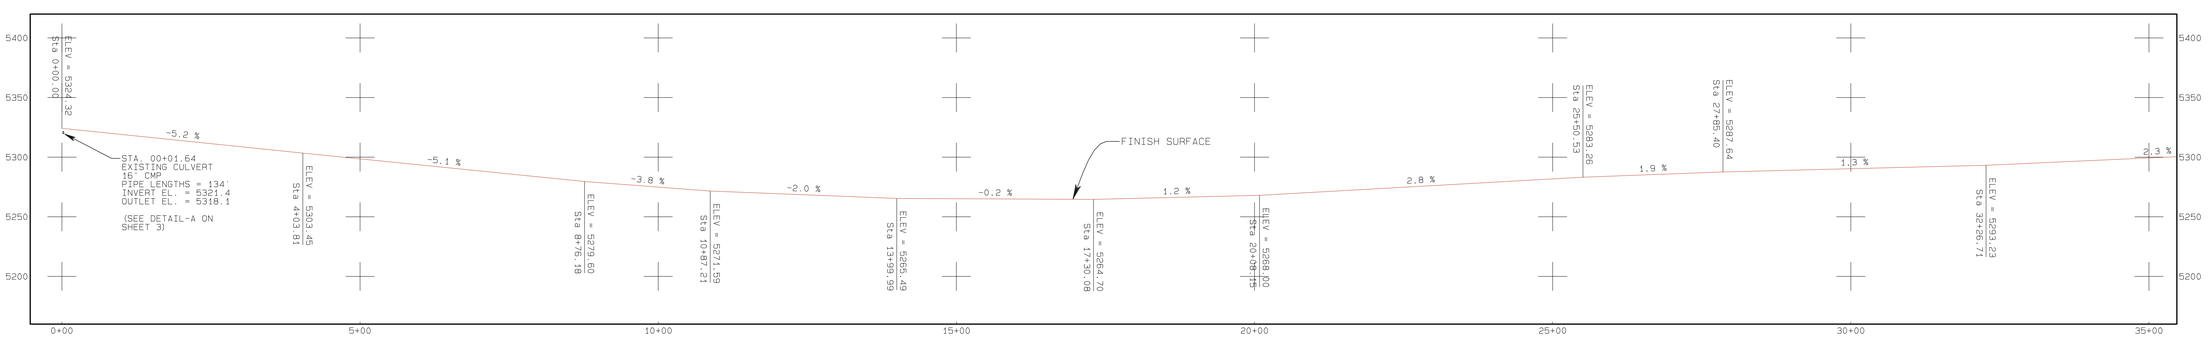

PROFILE VIEW
HORIZONTAL: 1"=120'
VERTICAL: 1"=60'

CERTIFICATION STATEMENT

I, Ron C. VAN VALKENBURG, hereby certify that this drawing was reviewed by me and that the information shown is complete and accurate to the best of my knowledge.

RON C. VAN VALKENBURG
NEW MEXICO
9263
LICENSED PROFESSIONAL ENGINEER

DATE	REVISION	BY
3/15/09	Submitted to OSM for Review	

PROJECT MANAGER: FG
ENGR. of RECORD: RCV
REG. NO: 9263
SPVR of RECORD:
REG. NO:

bhpbilliton
BHP NAVAJO COAL COMPANY
NAVAJO MINE
PO BOX 1717, FRUITLAND, NEW MEXICO, 87416 PHONE 505-598-3209/FAX 505-598-3361

PROJECT:
DATE: 3/15/09
DESIGNED BY: BY
DRAWN BY: BY
CHECKED BY: RCV
APPROVED BY: RCV

PLAN AND PROFILE

EXHIBIT 11-56A
YAZZIE SKYLINE ROAD
AS-BUILT

DRAWING

SHEET 2 OF 3