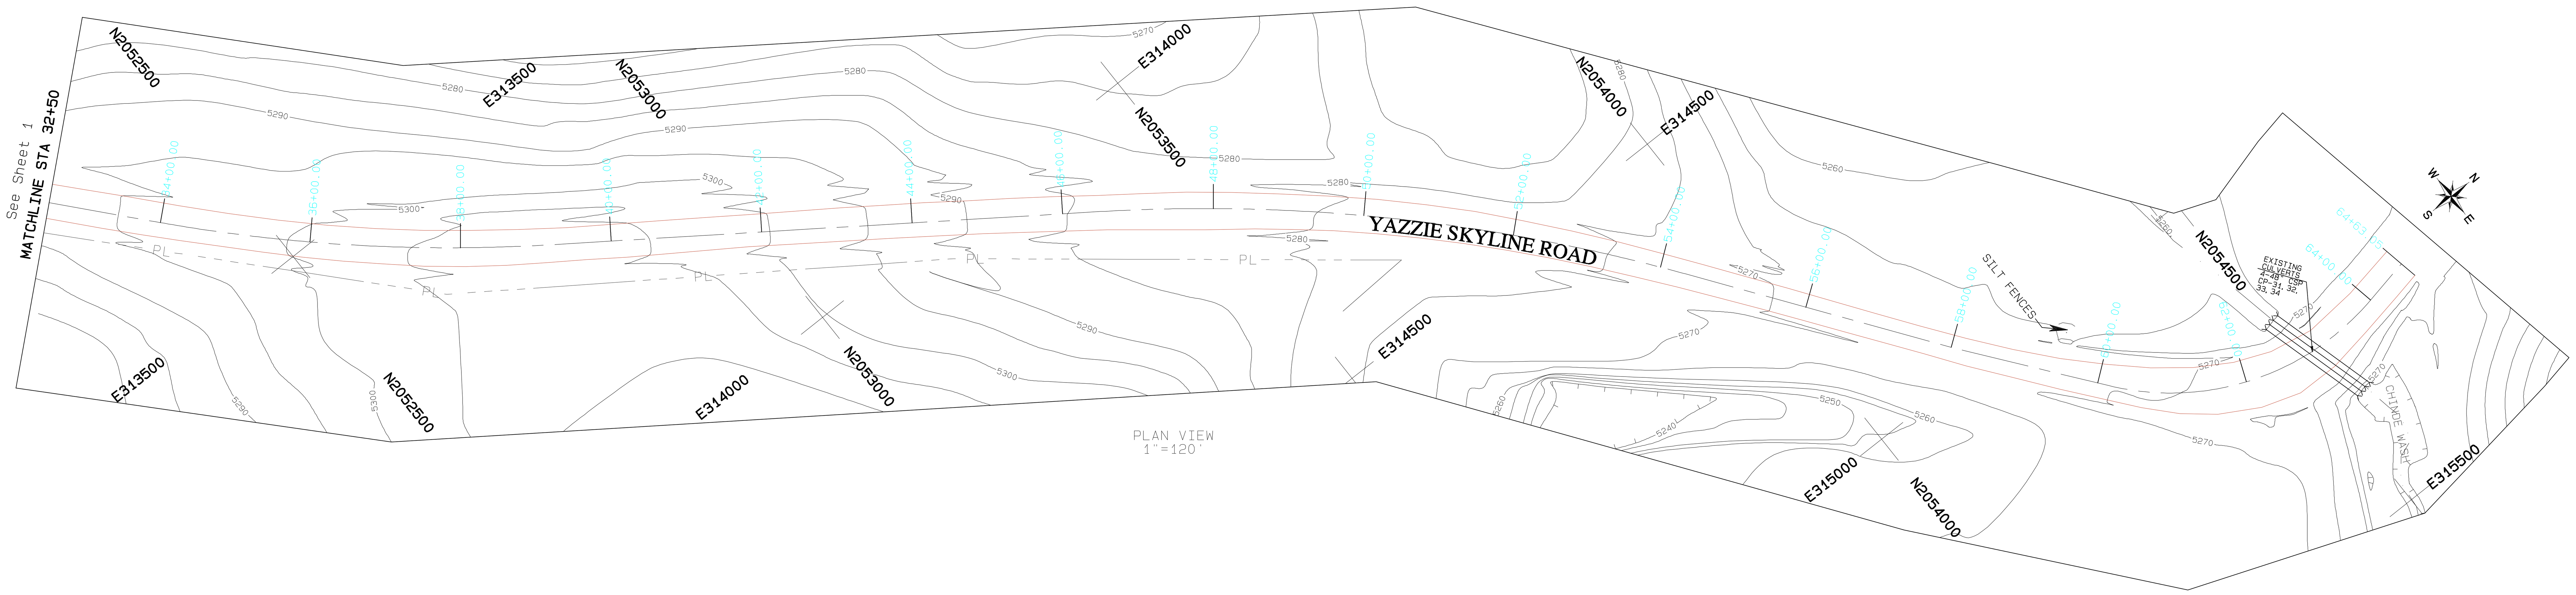

PLAN VIEW
1"=120'

LEGEND

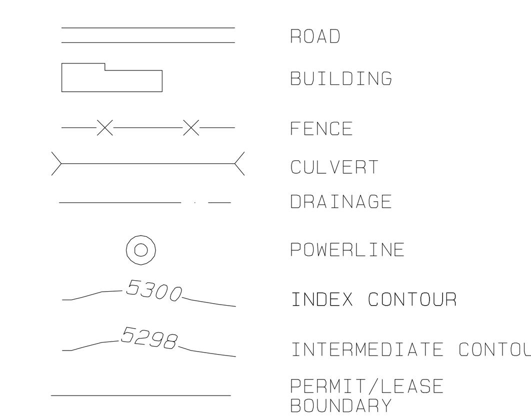

NOTES

1. The watershed areas for culverts are shown on Exhibit 11-12C.

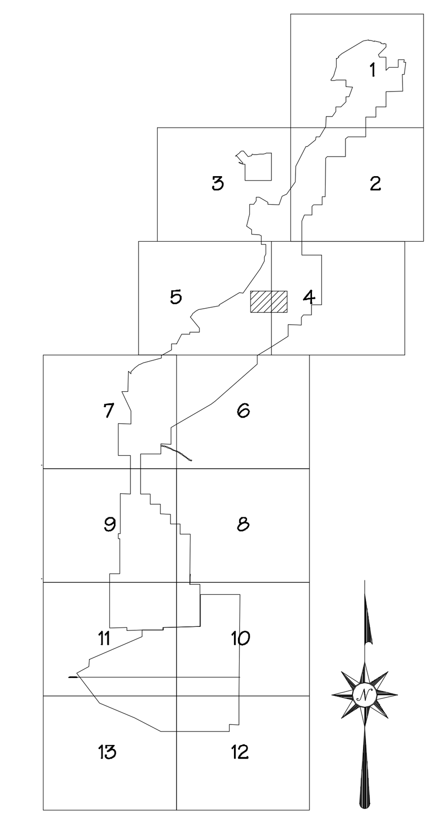

SCALE AS NOTED

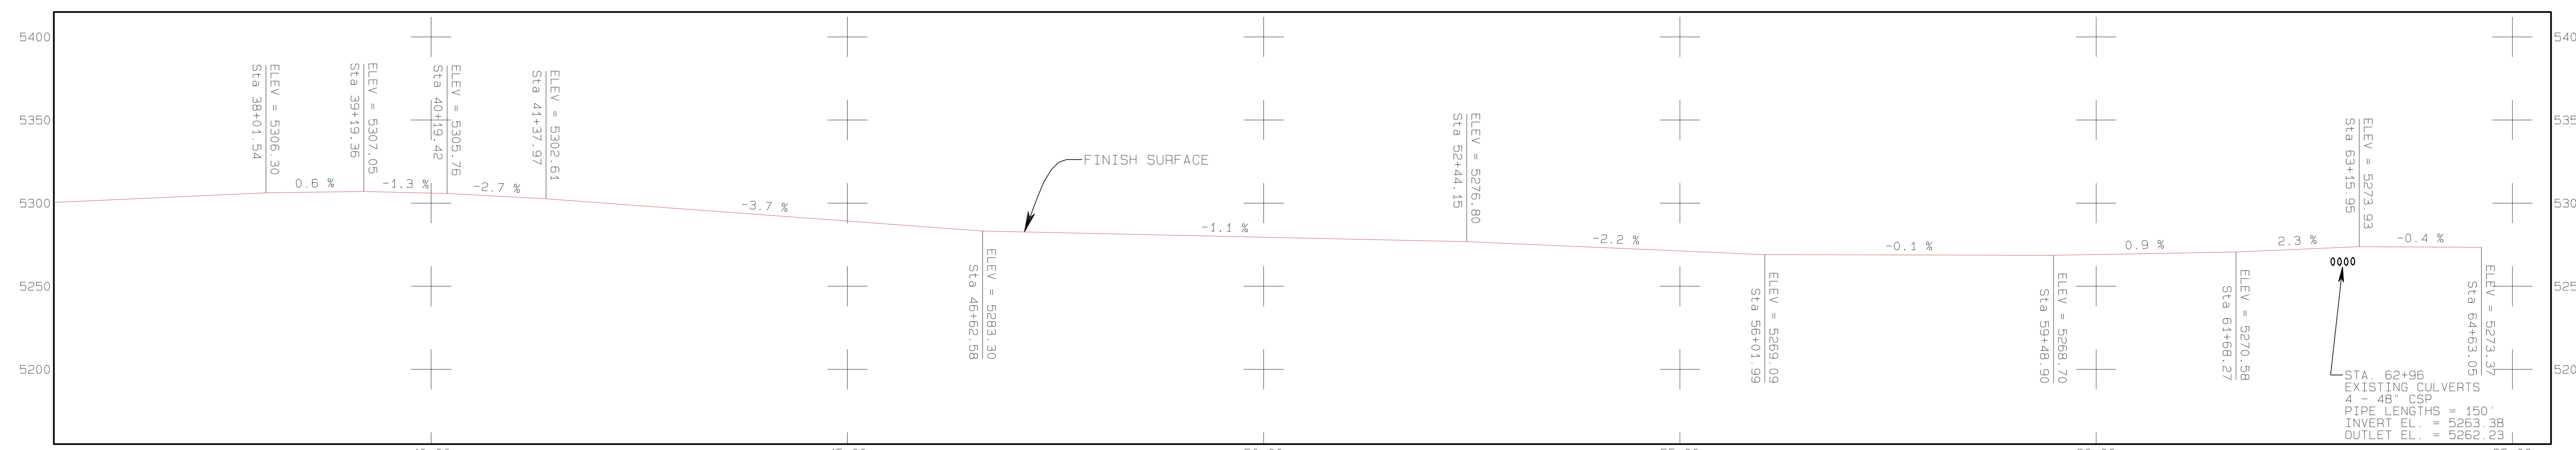

PROFILE VIEW
HORIZONTAL: 1"=120'
VERTICAL: 1"=60'

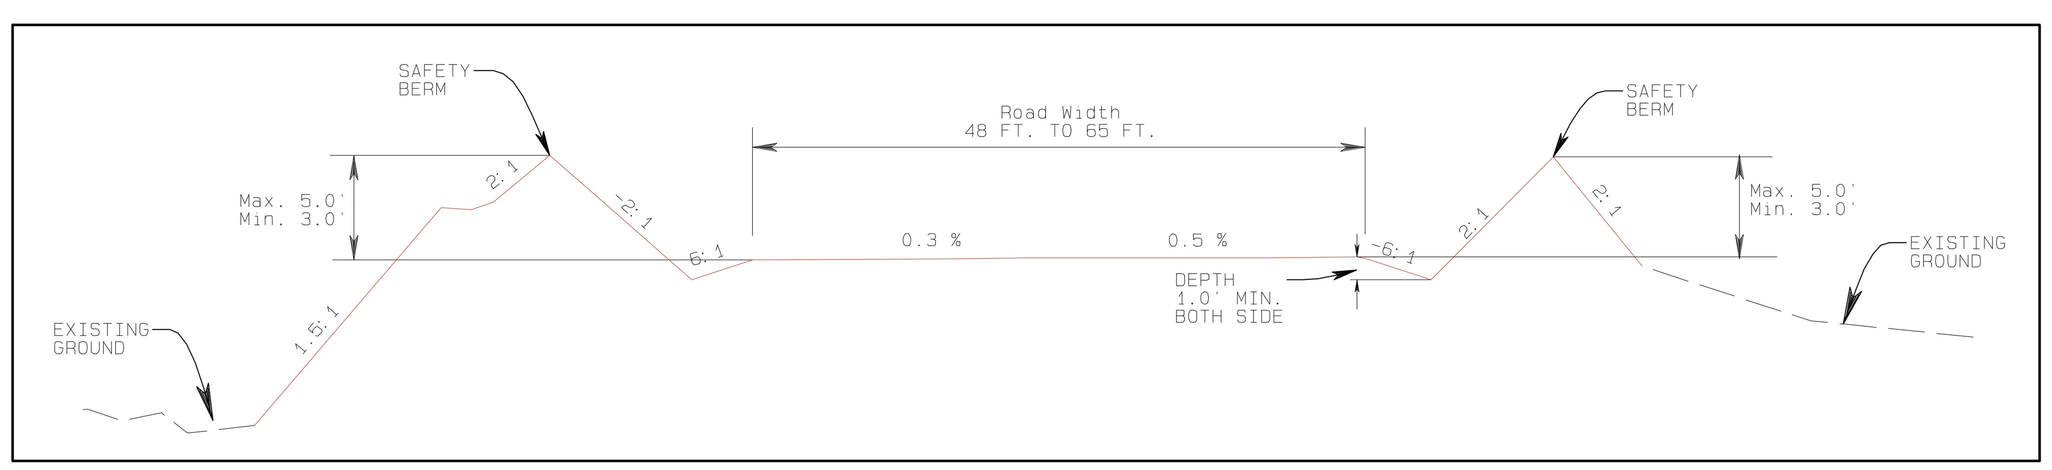

TYPICAL FILL CROSS SECTION

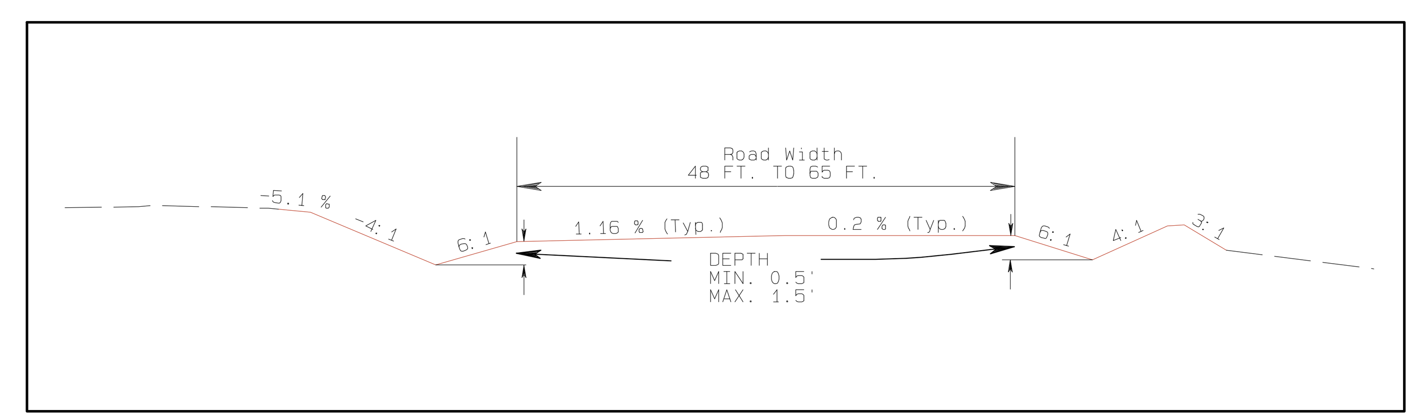

TYPICAL CUT CROSS SECTION

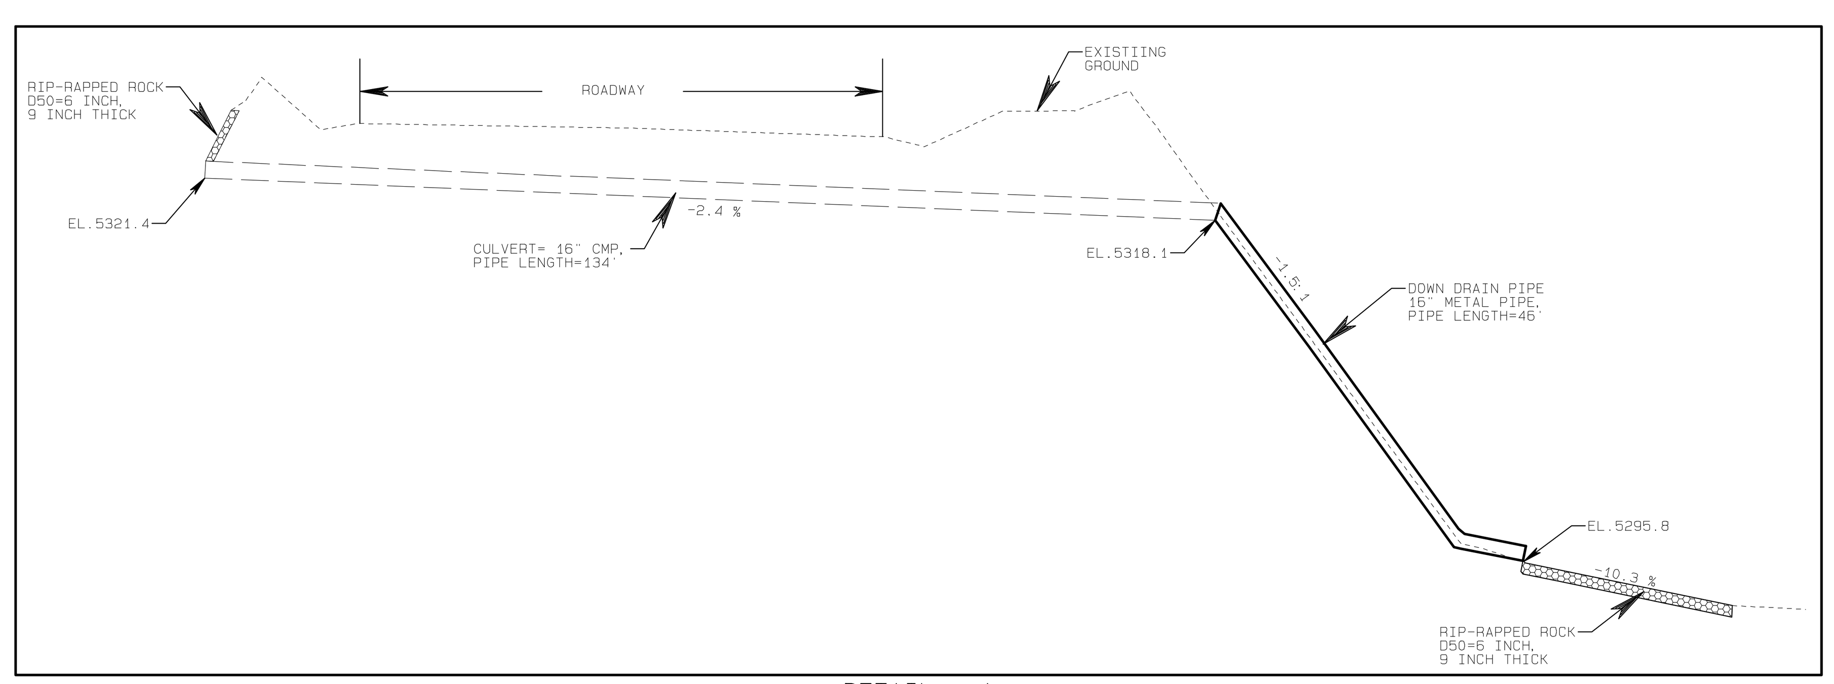

DETAIL - A
SECTION ALONG CP-63B

ABOVE TYPICAL CROSS SECTION
NO SCALE

CERTIFICATION STATEMENT

I, Ron C. VAN VALKENBURG, hereby certify that this drawing was reviewed by me and that the information shown is complete and accurate to the best of my knowledge.

DATE	REVISION	
3/15/09	Submitted to OSM for Review	09-A

PROJECT MANAGER: FG
ENGR. of RECORD: RCV
REG. NO: 9263
SRVYR of RECORD:
REG. NO:

bhpbilliton
BHP NAVAJO COAL COMPANY
NAVAJO MINE

PO BOX 1717, FRUITLAND, NEW MEXICO, 87416 PHONE 505-598-3209/FAX 505-598-3361

PROJECT:
DATE: 3/15/09
DESIGNED BY: RY
DRAWN BY: RY
CHECKED BY: RCV
APPROVED BY: RCV

PLAN, PROFILE AND SECTIONS

EXHIBIT 11-56B
YAZZIE SKYLINE ROAD
AS-BUILT

DRAWING

SHEET 3
OF 3