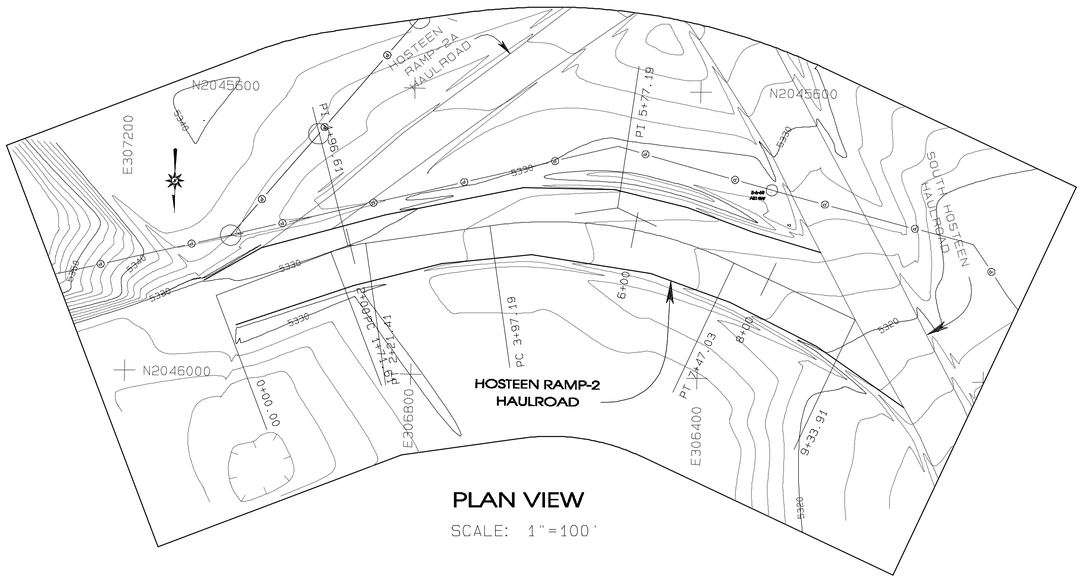

PLAN VIEW

SCALE: 1"=100'

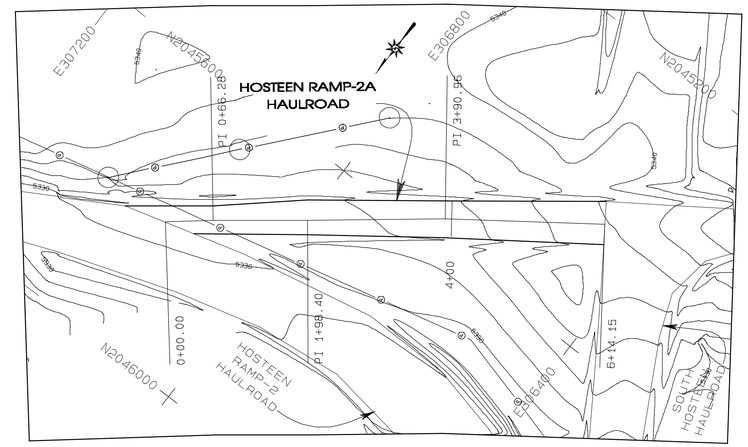

PLAN VIEW

SCALE: 1"=100'

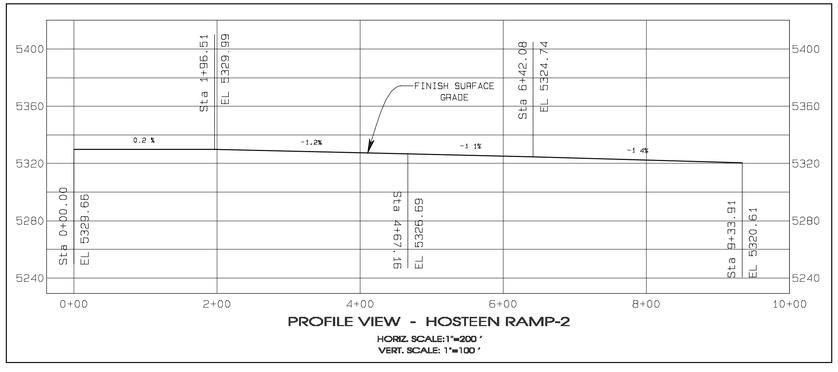

PROFILE VIEW - HOSTEEN RAMP-2

HORIZ. SCALE: 1"=200'
VERT. SCALE: 1"=100'

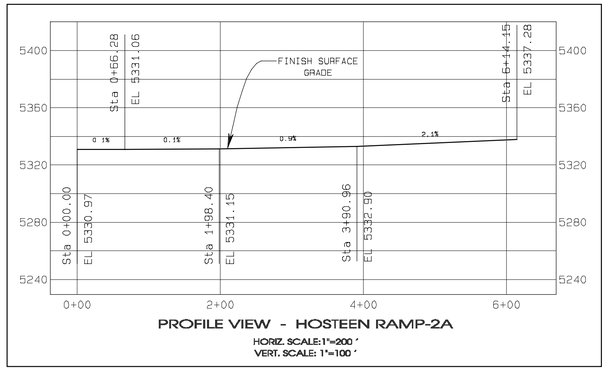

PROFILE VIEW - HOSTEEN RAMP-2A

HORIZ. SCALE: 1"=200'
VERT. SCALE: 1"=100'

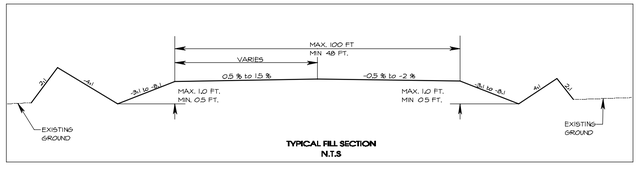

TYPICAL FILL SECTION
N.T.S

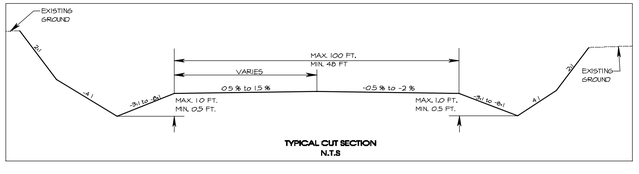

TYPICAL CUT SECTION
N.T.S

LEGEND

- ROAD
- WATERSHED
- BUILDING
- FENCE
- IRRIGATION LINE
- CULVERT
- DAM
- DRAINAGE
- RAILROAD
- TREES
- POWERLINE
- ×5338.5 SPOT ELEVATION
- 5300 INDEX CONTOUR
- 5299 INTERMEDIATE CONTOUR
- 218 9422.45 LEASE CORNER
- L-30
- LEASE/PERMIT BOUNDARY

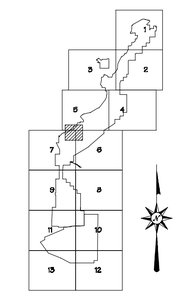

REV. NO.	DATE	DRAFT BY	REVISION DESCRIPTION	ENG.	E.S.	P.E.	APPROVALS
00-6	9-11-09	PJF	SUBMITTED TO OSM FOR REVIEW AND APPROVAL	RCVV	VB	RCVV	

CERTIFICATION STATEMENT

I, Ron C. Van Valkenburg, hereby certify that this drawing was reviewed by me and that the information shown is complete and accurate to the best of my knowledge.

RON C. VAN VALKENBURG — NEW MEXICO — 9263 — LICENSED PROFESSIONAL ENGINEER

EXHIBIT 11-62D

NAVAJO COAL COMPANY

bhpbilliton

P.O.BOX 1717 FRUITLAND, NEW MEXICO 87416/PHONE 505-598-4200/FAX 505-598-3381

AREA-II

HOSTEEN RAMP-2 AND 2A HAULROAD - AS-BUILT LOCATION MAP

PREPARED BY PJF	DRAWN BY PJF	AS NOTED	
APPROVED BY RVV	DATE 3-06-09	Sheet 3 of 3	

Path: \\ENCNMCFMN-SRV02\Data\Departments\Gs\OSM_SUBM\PER_PROG\CH_11_PAP EXHIBITS\11-062 HOSTEEN ROAD\Exh 11-62D_Sq Hosteen Haulrd As_built.pro
PJFoster \Plot time: Thu Mar 12 12:37:53 2009