PLAN VIEW
Scale: 1" = 200'

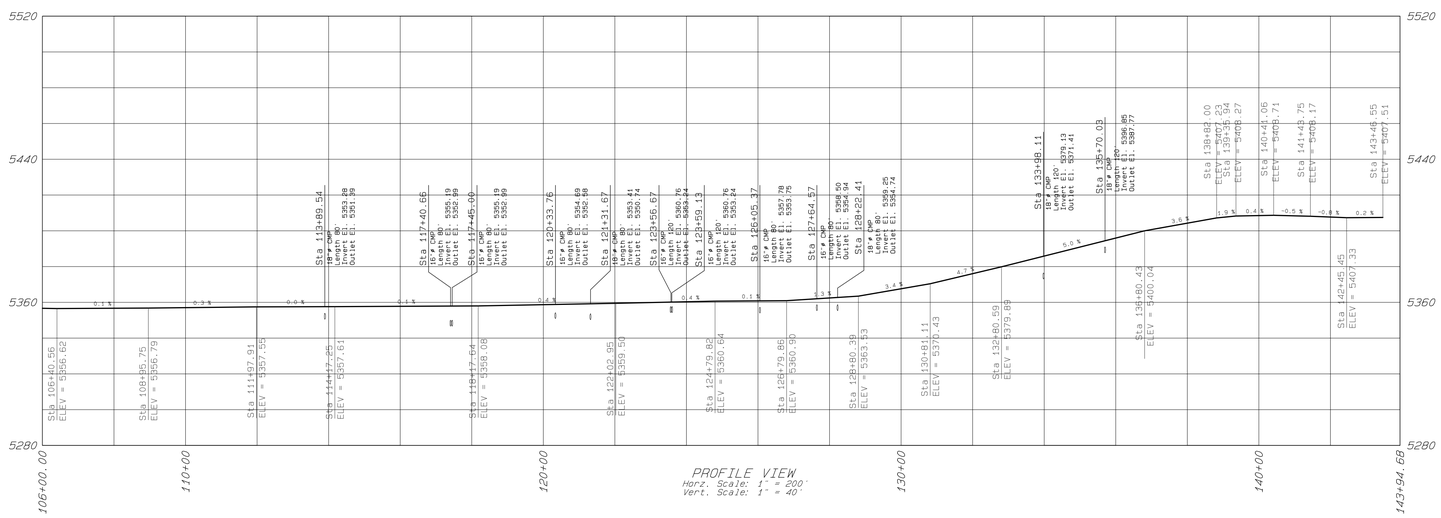

PROFILE VIEW
Horz. Scale: 1" = 200'
Vert. Scale: 1" = 40'

LEGEND

- ROAD
- TRAIL
- BUILDING
- FENCE
- IRRIGATION LINE
- CULVERT
- DAM
- DRAINAGE
- RAILROAD
- TREES
- POWERLINE
- ×5338.5 SPOT ELEVATION
- 5300 INDEX CONTOUR
- 5298 INTERMEDIATE CONTOUR
- 218 5422.45 CONTROL
- LEASE
- WATERSHED

NOTES

1. For hydrology and design information refer to Appendix 11-V in the approved PAP.
2. The watershed areas for culverts are shown on Exhibit 11-12E & 11-12F.
3. Watershed for 96" culvert see Appendix 11-D.

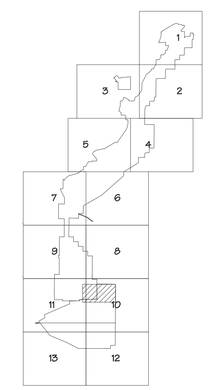

SCALE AS NOTED

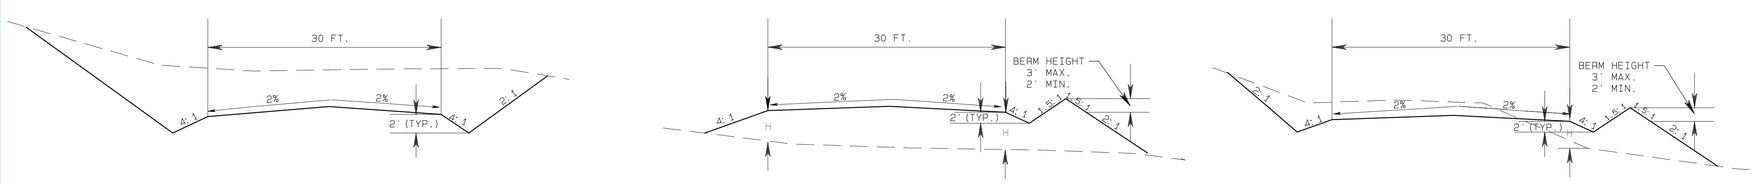

TYPICAL CUT SECTION

TYPICAL FILL SECTION

TYPICAL CUT/FILL SECTION

H ≤ 4.0' SIDESLOPE=3:1
H > 4.0' SIDE SLOPE 2:1 WITH SAFETY BERM

N.T.S

CERTIFICATION STATEMENT

I, Ron C. Van Valkenburg, hereby certify that this drawing was reviewed by me and that the information shown is complete and accurate to the best of my knowledge.

RON C. VAN VALKENBURG
NEW MEXICO
9263
LICENSED PROFESSIONAL ENGINEER

REVISION		DATE
1	SUBMITTED TO OSM FOR APPROVAL	04/30/01
2	REVISED TITLE & SUBMITTED TO OSM	06/21/01
3	REVISED TURNOUT, PLAN, PROFILE AND ADDED CULVERTS	10/29/08
4	AS-BUILT AND SUBMITTED TO OSM FOR APPROVAL	8-21-09

PROJECT MANAGER: W.J. NAPOLEON
ENGR. of RECORD: RON VAN VALKENBURG REG. NO: 9263
SURVR of RECORD: REG. NO:

BHP-NAVAJO COAL CO.
PO BOX 155, FRUITLAND, NEW MEXICO, 87416

ACCOUNT:
DATE: APRIL 30, 2001
DESIGNED BY: Rhazzie
DRAWN BY: Rhazzie
CHECKED BY: RCV
APPROVED BY:

PLAN AND PROFILE

EXHIBIT 11-60C
BURNHAM ROAD
TEMPORARY REROUTE #2
AS-BUILT

DRAWING

SHEET 4 OF 4

Project Desc.: Path: G:\Gis\Permit F\Ch 11\Exhibit 11-060\As-Built\BTRR_AS-BUILT\BH_Temp_Reroute_Asbuilt.prc Plot time: Fri Dec 04 09 41:35 2009