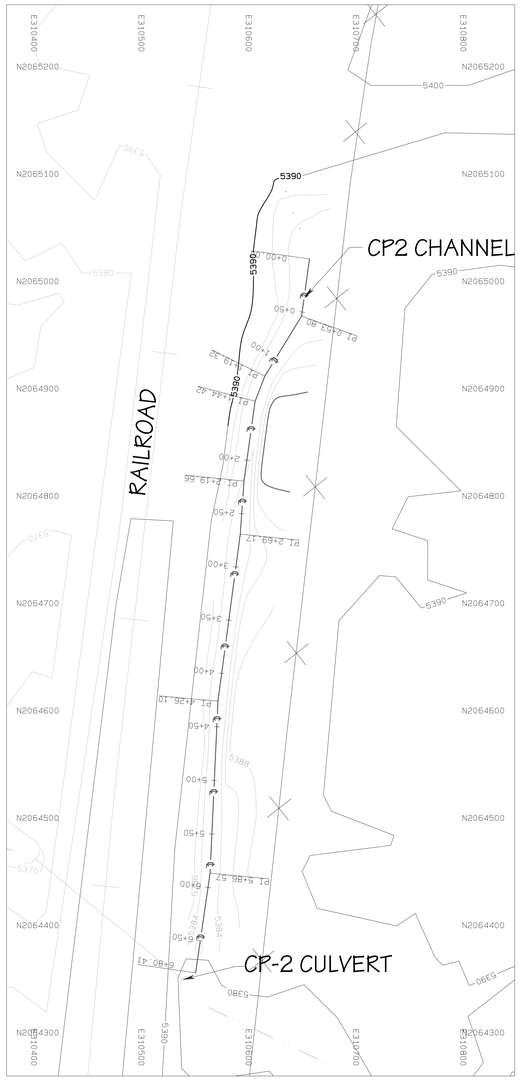

SCALE 1" = 50'

SCALE 1" = 100'

LEGEND

CENTERLINE

FENCE LINE

RAILROAD

DRAIN LINE

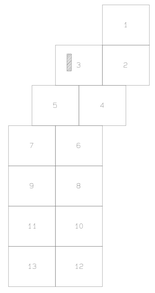

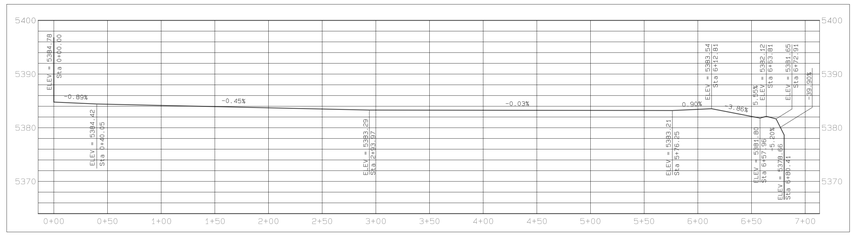

CHANNEL PROFILE

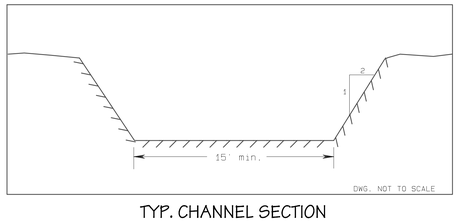

TYP. CHANNEL SECTION

CERTIFICATION STATEMENT

I, Leonard Raymond, hereby certify that this drawing was reviewed by me and that the information shown is accurate and complete to the best of my knowledge.

LEONARD RAYMOND NEW MEXICO 6600 REGISTERED PROFESSIONAL ENGINEER

REV. NO.	DATE	DRAFT BY	REVISION DESCRIPTION	ENG.	E.G.	P.E.	P.S.	CHIEF ENG.
A	6/11/96	ET	SUBMITTED TO OSM FOR APPROVAL					

APPROVALS

EXHIBIT 11-65a

NAVAJO COAL COMPANY

NAVAJO MINE

P.O. BOX 155 FRUITLAND, NEW MEXICO 87416

"AS BUILT"

CP-2 CHANNEL

PREPARED BY ET	DRAWN BY ET	SCALE AS NOTED
APPROVED BY LR	DATE JUNE 25 1996	
REF DWG EXHIBIT 11-65		
DWG LOC G:\Departments\Gs\OSM_SUBM\PER_PROG\CH_11_PAP EXH		