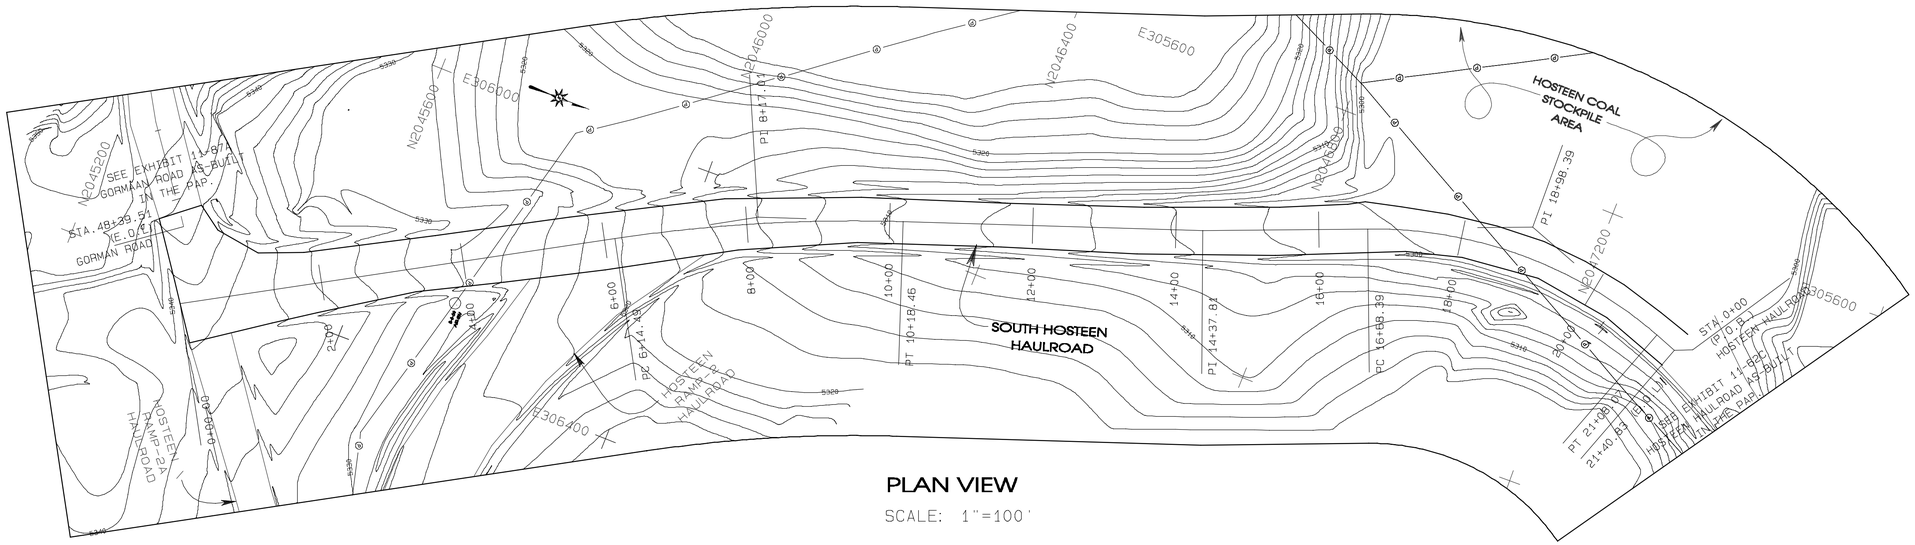

PLAN VIEW

SCALE: 1"=100'

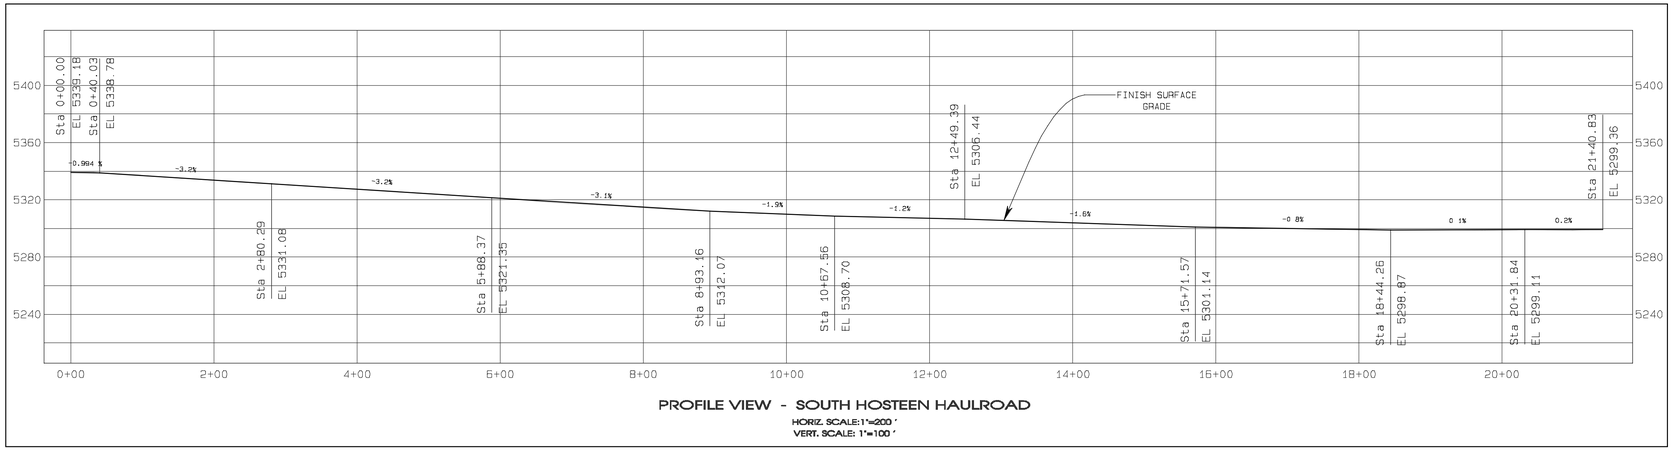

PROFILE VIEW - SOUTH HOSTEEN HAULROAD

HORIZ. SCALE: 1"=200'
VERT. SCALE: 1"=100'

LEGEND

- ROAD
- WATERSHED
- BUILDING
- FENCE
- IRRIGATION LINE
- CULVERT
- DAM
- DRAINAGE
- RAILROAD
- TREES
- POWERLINE
- ×5338.5 SPOT ELEVATION
- 5300 INDEX CONTOUR
- 5298 INTERMEDIATE CONTOUR
- 218 / 5422.45
- L-30 LEASE CORNER
- LEASE/PERMIT BOUNDARY

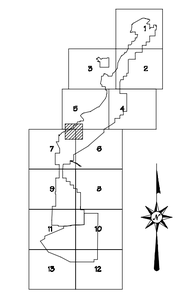

REV. No.	DATE	DRAFT BY	REVISION DESCRIPTION	ENG.	E.O.	P.E.	APPROVLS
09-4	3-11-09	PJF	SUBMITTED TO DSM FOR REVIEW AND APPROVAL	RCVV	VS	RCVV	

CERTIFICATION STATEMENT

I, Ron C. Van Valkenburg, hereby certify that this drawing was reviewed by me and that the information shown is complete and accurate to the best of my knowledge.

RON C. VAN VALKENBURG — NEW MEXICO — 9263 — CERTIFIED PROFESSIONAL ENGINEER

EXHIBIT 11-62D

NAVAJO COAL COMPANY

bhpbilliton

P.O. BOX 1717 FARMINGTON, NEW MEXICO 87415/PHONE 505-598-4200/FAX 505-598-3361

AREA-II
SOUTH HOSTEEN HAULROAD
AS-BUILT
LOCATION MAP

PREPARED BY PJF	DRAWN BY PJF	AS NOTED	
APPROVED BY RVV	DATE 3-06-09	Sheet 2 of 3	

Path: \\ENCMCFMN-SRV02\Data\Departments\Gs\DSM_SUBM\PER_PROG\CH_11_PAP EXHIBITS\11-062 HOSTEEN ROAD\Exh 11-62D_So Hosteen Haulrd As_built.pro
PJFoster \Plot time: Thu Mar 12 12:35:36 2009