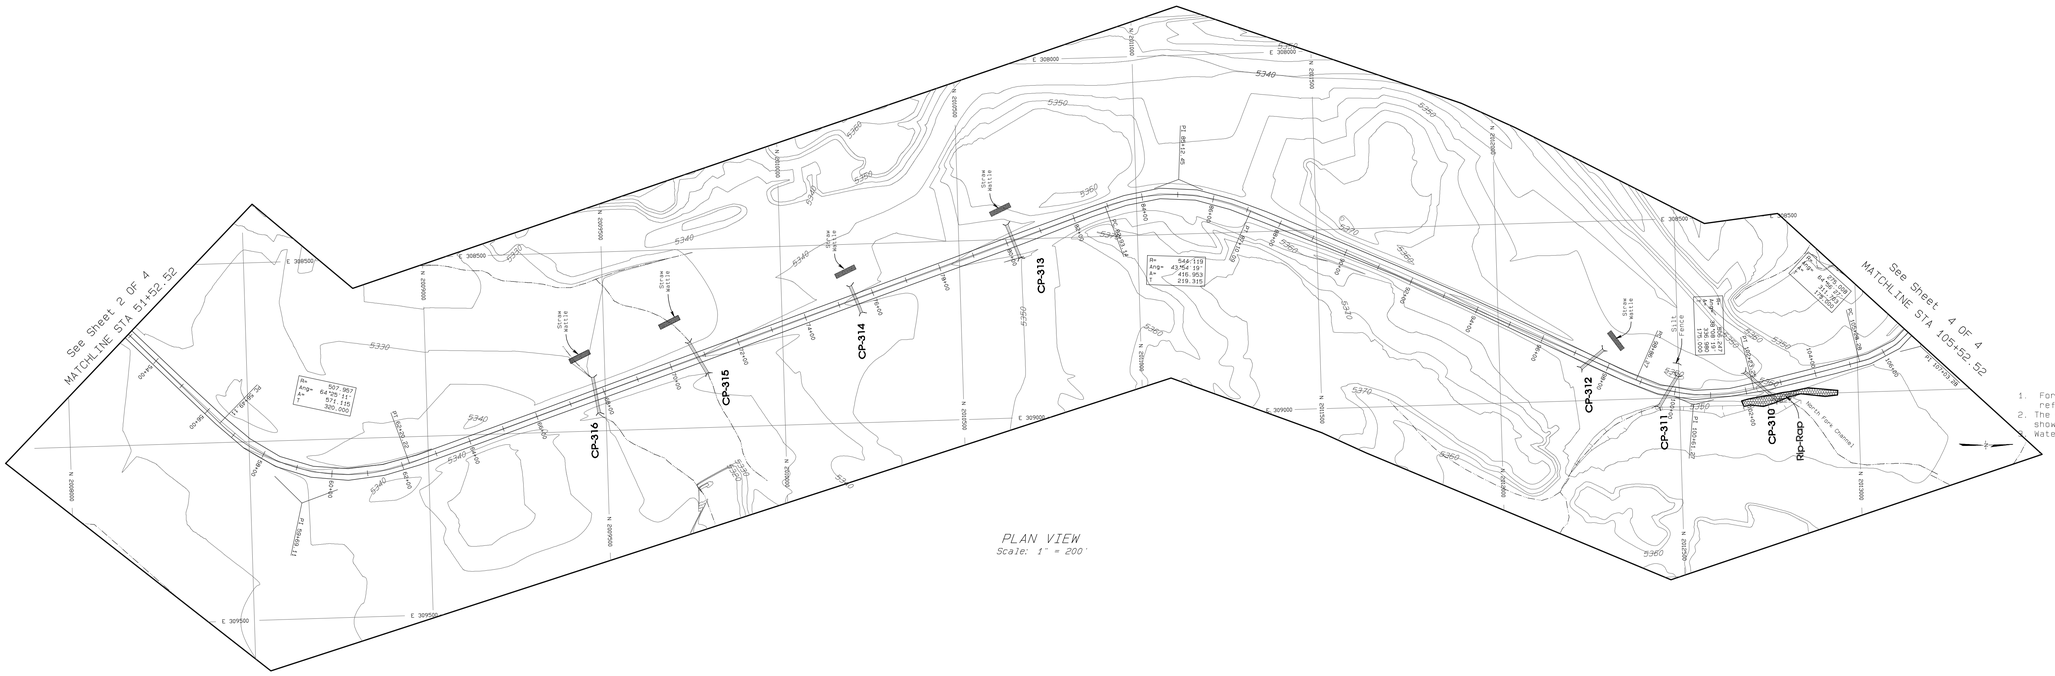

PLAN VIEW
Scale: 1" = 200'

LEGEND

- ROAD
- TRAIL
- BUILDING
- FENCE
- IRRIGATION LINE
- CULVERT
- DAM
- DRAINAGE
- RAILROAD
- TREES
- POWERLINE
- ×5338.5 SPOT ELEVATION
- 5300 INDEX CONTOUR
- 5298 INTERMEDIATE CONTOUR
- 218 5422.45 CONTROL
- LEASE
- WATERSHED

NOTES

1. For hydrology and design information refer to Appendix 11-V in the approved PAP.
2. The watershed areas for culverts are shown on Exhibit 11-12E & 11-12F.
3. Watershed for 96" culvert see Appendix 11-D.

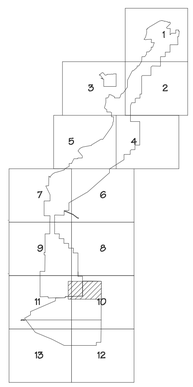

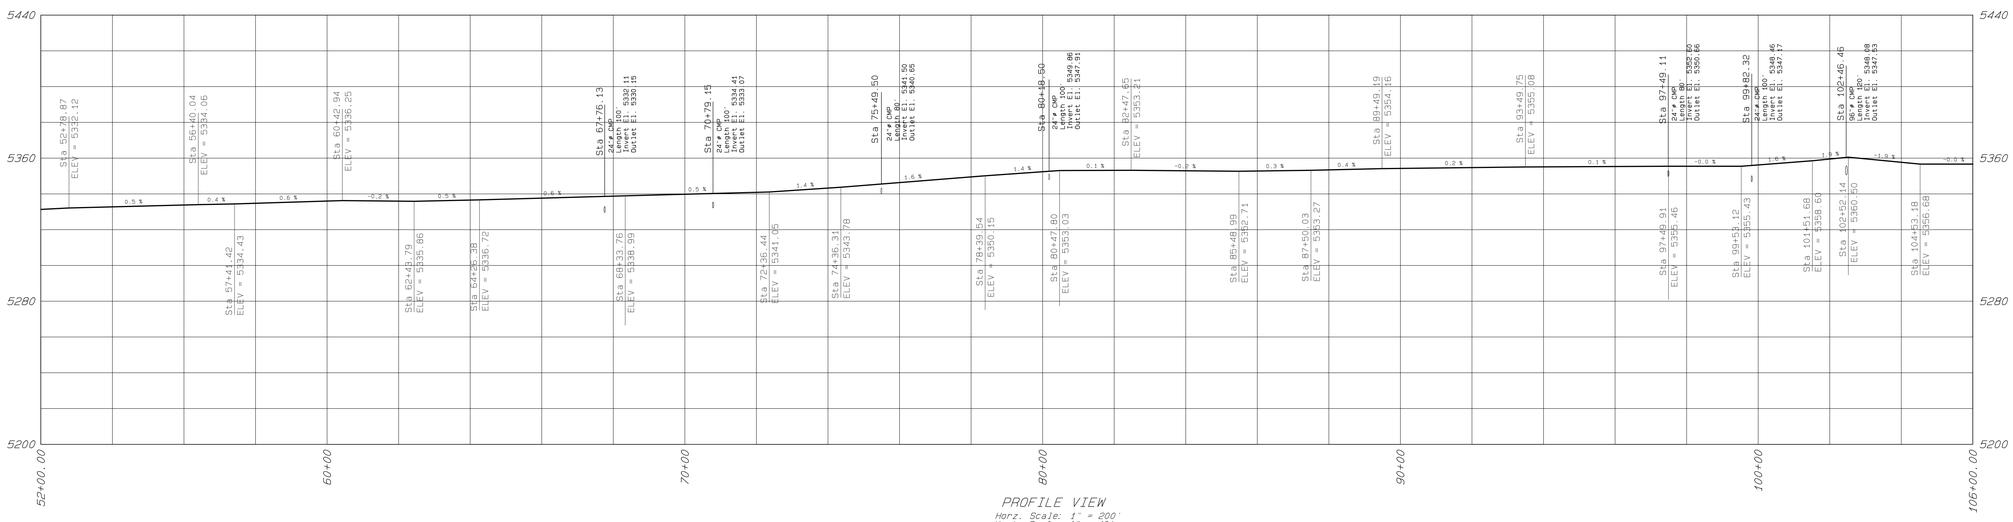

PROFILE VIEW
Horz. Scale: 1" = 200'
Vert. Scale: 1" = 40'

CERTIFICATION STATEMENT

I, Ron C. Van Valkenburg, hereby certify that this drawing was reviewed by me and that the information shown is complete and accurate to the best of my knowledge.

RON C. VAN VALKENBURG
NEW MEXICO
9263
LICENSED PROFESSIONAL ENGINEER

REVISION	DATE
1 SUBMITTED TO OSM FOR APPROVAL	04/30/01
2 REVISED TITLE & SUBMITTED TO OSM	08/21/01
3 REVISED ALIGNMENT, PLAN, PROFILE AND CROSS SECTIONS	10/29/08
4 AS-BUILT AND SUBMITTED TO OSM FOR APPROVAL	9-21-09

PROJECT MANAGER: MJ NAPOLEON
ENGR. OF RECORD: RON VAN VALKENBURG REG. NO. 9263
SRVYR OF RECORD: REG. NO.
SRVYR OF RECORD:

BHP-NAVAJO COAL CO.

PO BOX 155, FRUITLAND, NEW MEXICO, 87416

ACCOUNT:
DATE: APRIL 30, 2001
DESIGNED BY: Rfrazzie
DRAWN BY:
CHECKED BY: RCV
APPROVED BY:

PLAN AND PROFILE

EXHIBIT 11-60B
BURNHAM ROAD
TEMPORARY REROUTE #2
AS-BUILT

DRAWING

SHEET 3 OF 4

Project Desc.: Path: G:\Gs\Permit FiCh 11\Exhibit 11-60D\As-Built\BRR_AS-BUILT\BR_Temp_Reroute_Asbuilt.pro Plot time: Fri Dec 04 08:41:33 2009