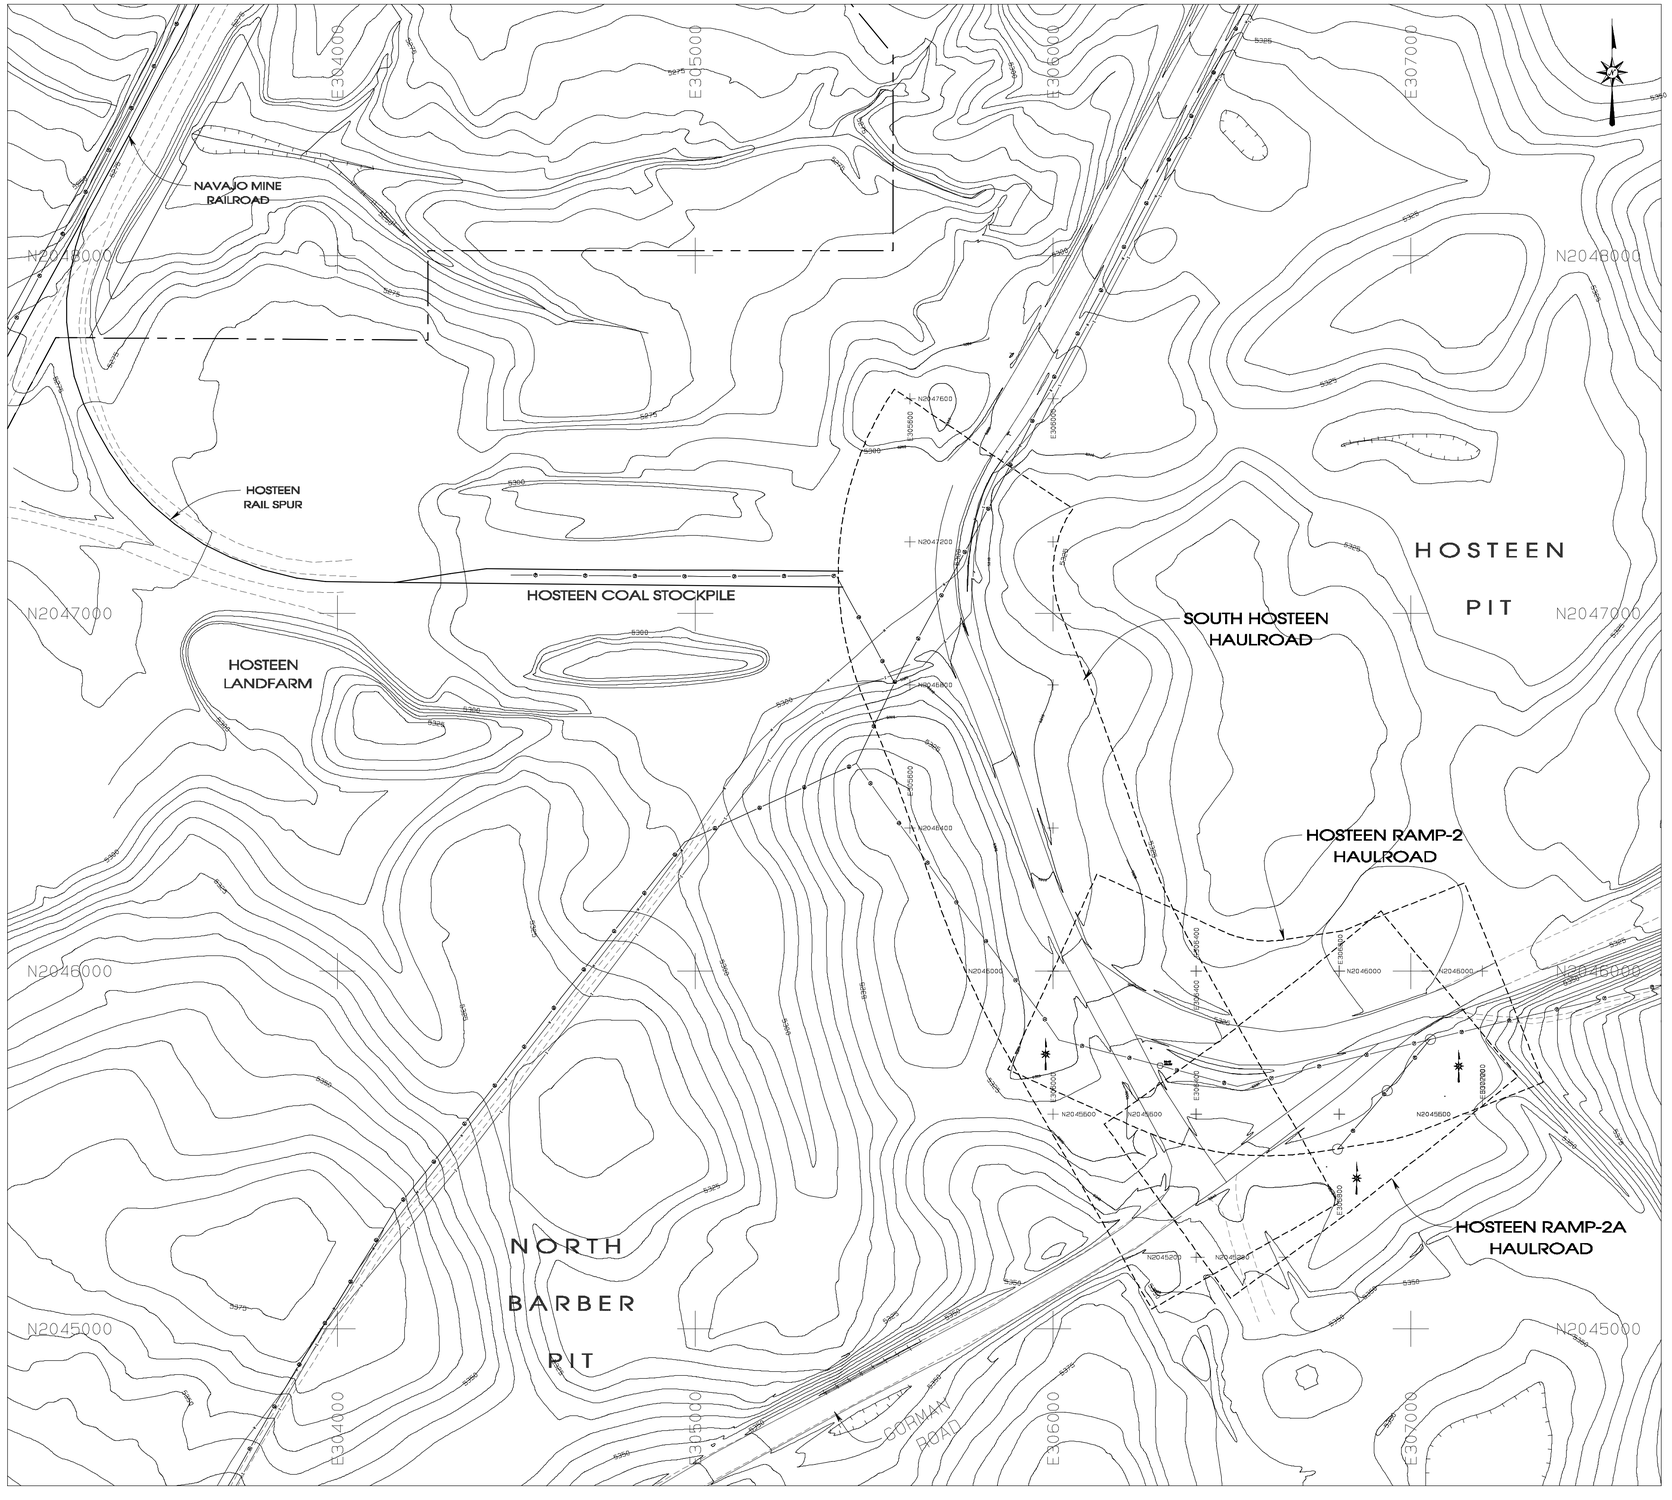

PLAN VIEW

SCALE: 1"=200'

LEGEND

- ROAD
- WATERSHED
- BUILDING
- FENCE
- IRRIGATION LINE
- CULVERT
- DAM
- DRAINAGE
- RAILROAD
- TREES
- POWERLINE
- ×5338.5 SPOT ELEVATION
- 5300 INDEX CONTOUR
- 5299 INTERMEDIATE CONTOUR
- 218 5422.45
- L-30 LEASE CORNER
- LEASE/PERMIT BOUNDARY

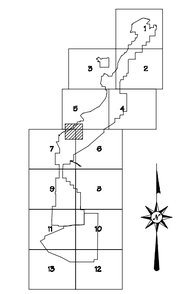

REV. No.	DATE	DRAFT BY	REVISION DESCRIPTION	ENG.	E.G.	P.E. APPROVALS
09-4	3-11-09	PJF	SUBMITTED TO DSM FOR REVIEW AND APPROVAL	RCVV	YB	RCVV

CERTIFICATION STATEMENT

I, Ron C. Van Valkenburg, hereby certify that this drawing was reviewed by me and that the information shown is complete and accurate to the best of my knowledge.

RON C. VAN VALKENBURG — NEW MEXICO — 9263 — LICENSED PROFESSIONAL ENGINEER

EXHIBIT 11-62D

NAVAJO COAL COMPANY

bhpbilliton

P.O.BOX 1717 FARMINGTON, NEW MEXICO 87416/PHONE 505-598-4200/FAX 505-598-3361

AREA-II
HOSTEEN AREA
HAULROAD AS-BUILT
LOCATION MAP

PREPARED BY	PJF	DRAWN BY PJF	AS NOTED
APPROVED BY	RVV	DATE 3-06-09	Sheet 1 of 3

Path: \\ENDMCFMN-SRV02\Data\Departments\Gs\DSM_SUBM\PER_PROG\CH_11_PAP EXHIBITS\11-062 HOSTEEN ROAD\Exh 11-62D_Se Hosteen Haulrd As_built.pro
PJFoster \Plot time: Thu Mar 12 12:33:50 2009