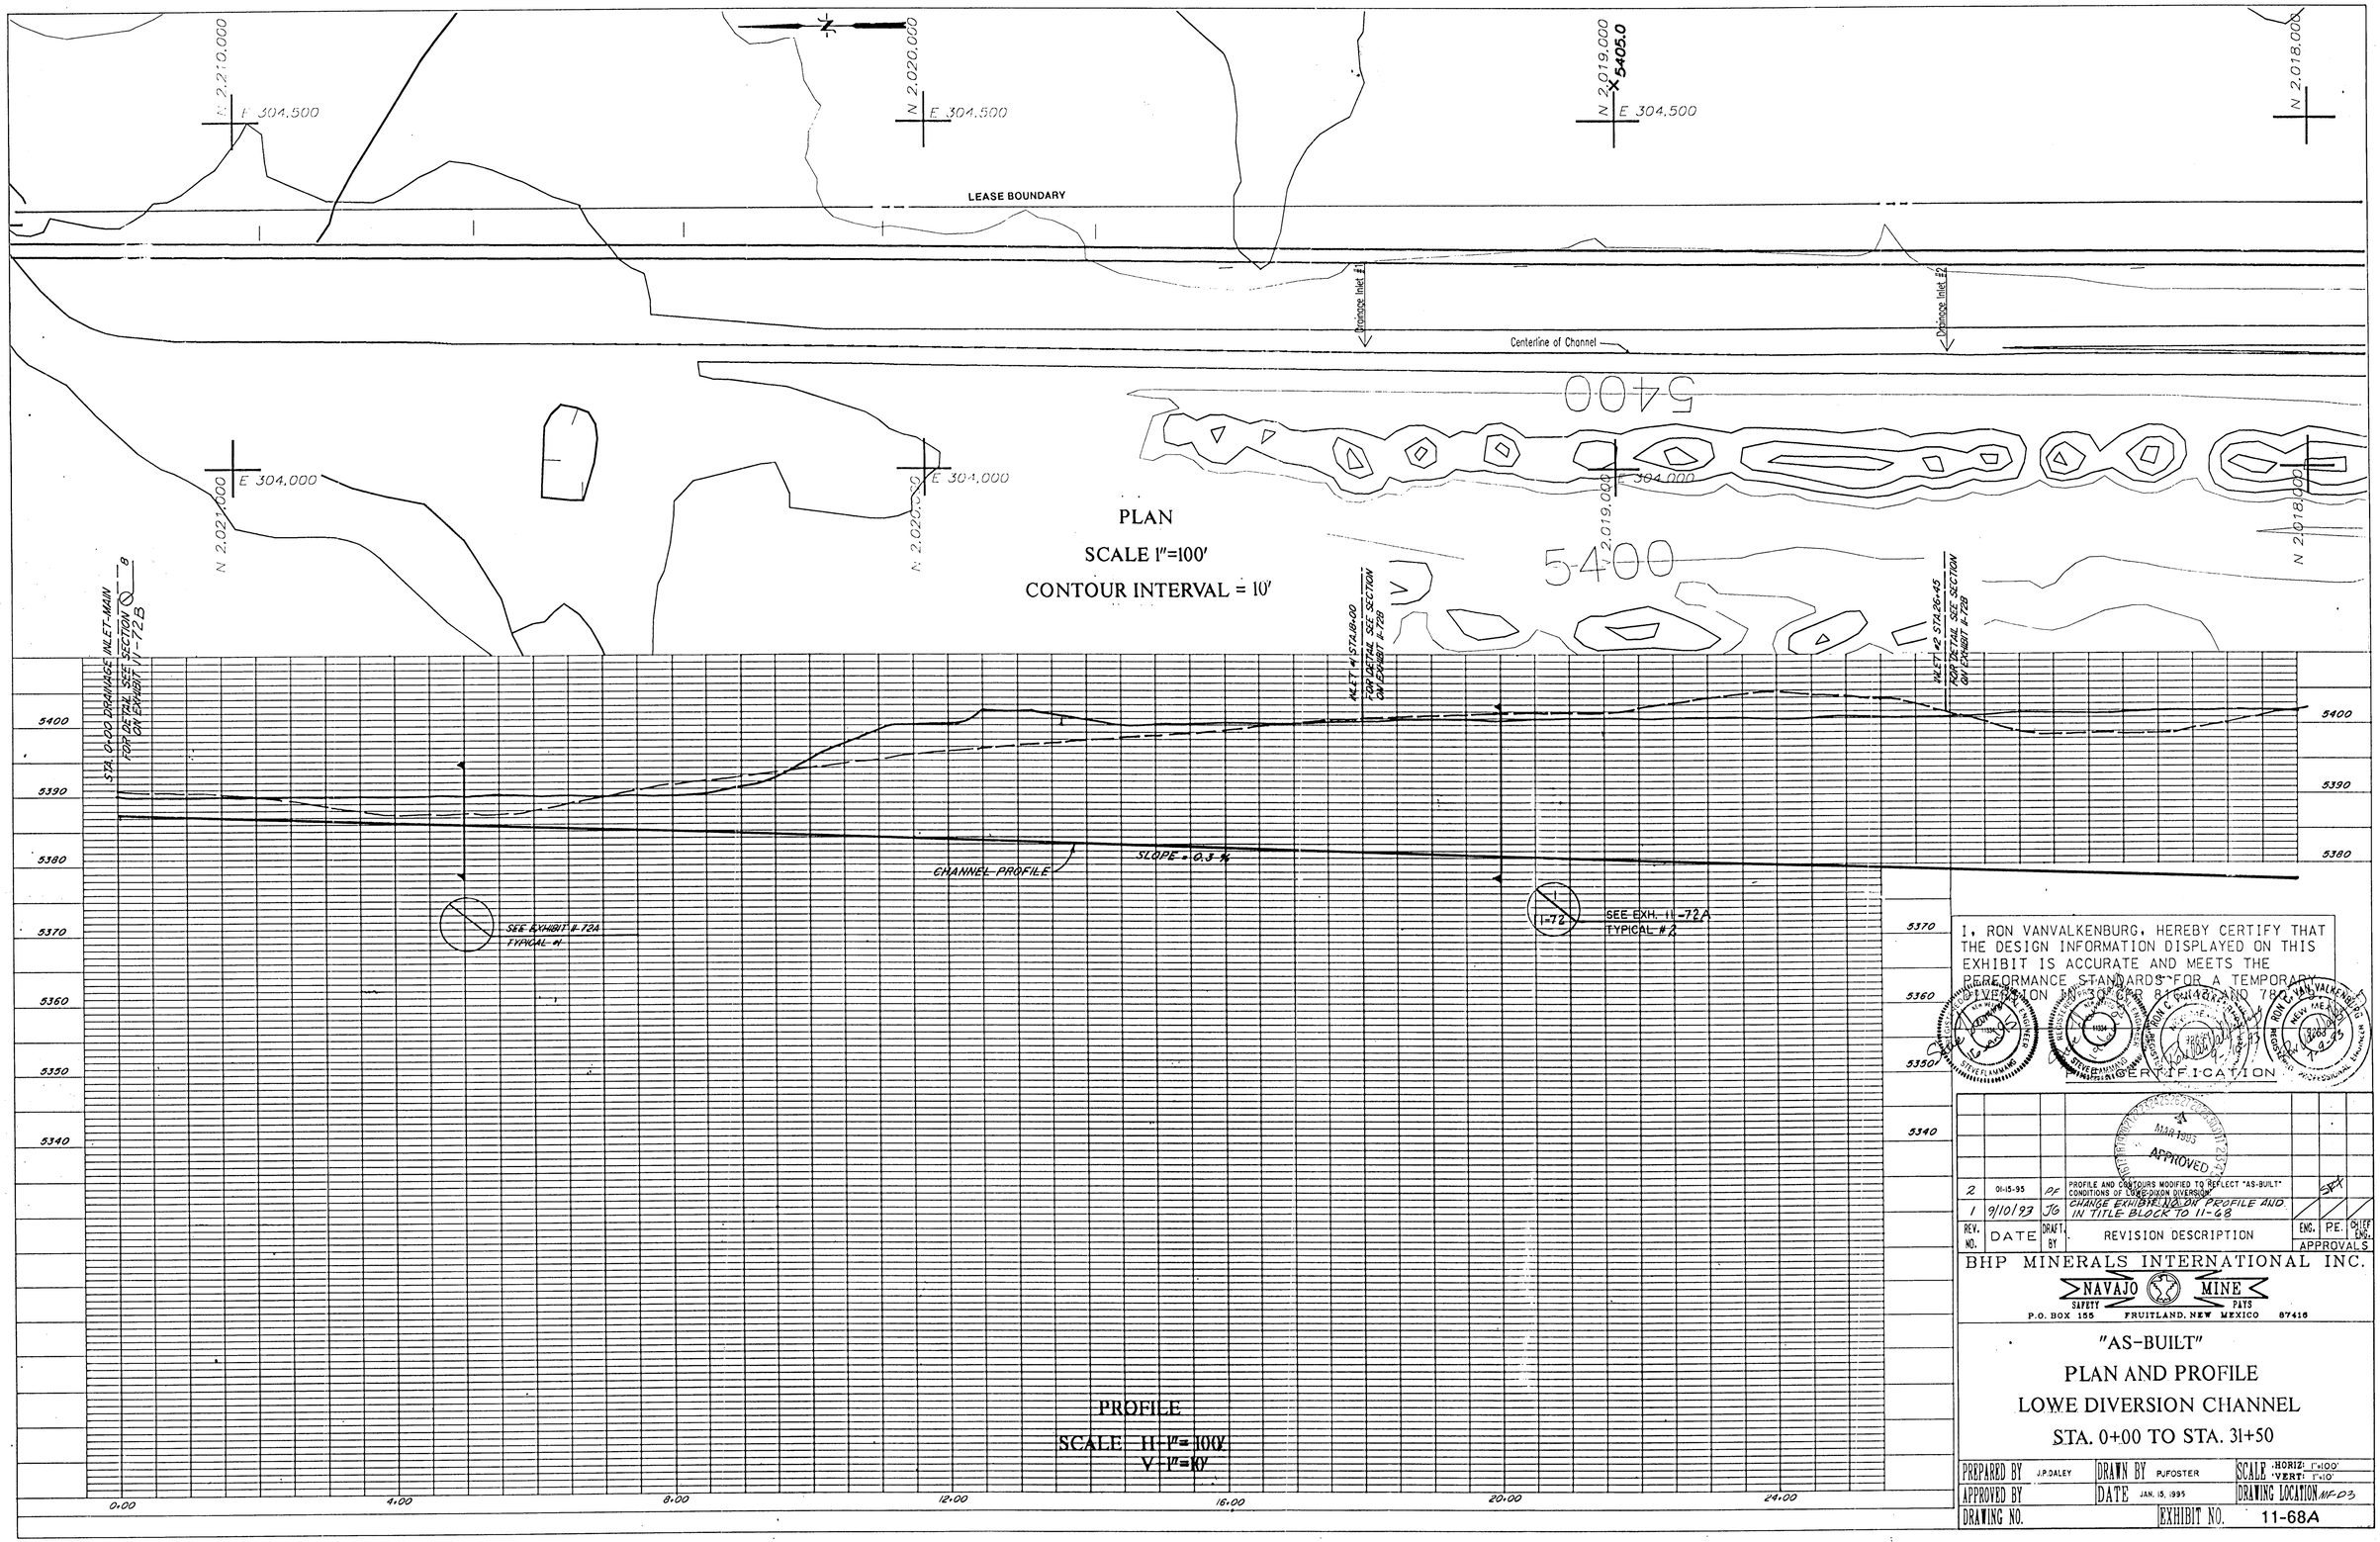

I, RON VANVALKENBURG, HEREBY CERTIFY THAT THE DESIGN INFORMATION DISPLAYED ON THIS EXHIBIT IS ACCURATE AND MEETS THE PERFORMANCE STANDARDS FOR A TEMPORARY DIVERSION UNDER SOCMR R-1 AND 78-5.

CERTIFICATION

REV. NO.	DATE	DRAFT. BY	REVISION DESCRIPTION	ENG.	PE.	CHIEF ENG.
2	01-15-95	DF	PROFILE AND CONTOURS MODIFIED TO REFLECT "AS-BUILT" CONDITIONS OF LOWE-DIXON DIVERSION			
1	9/10/93	JG	CHANGE EXHIBIT NO. ON PROFILE AND IN TITLE BLOCK TO 11-68			

APPROVALS

BHP MINERALS INTERNATIONAL INC.

NAVAJO MINE

SAFETY PAYS

P.O. BOX 155 FRUITLAND, NEW MEXICO 87416

"AS-BUILT"

PLAN AND PROFILE

LOWE DIVERSION CHANNEL

STA. 0+00 TO STA. 31+50

PREPARED BY	J.P.DALEY	DRAWN BY	PJFOSTER	SCALE	HORIZ: 1"=100' VERT: 1"=10'
APPROVED BY		DATE	JAN. 15, 1995	DRAWING LOCATION	NF-03
DRAWING NO.			EXHIBIT NO.	11-68A	