LEGEND

- ROAD
- WATERSHED
- BUILDING
- FENCE
- IRRIGATION LINE
- CULVERT
- DAM
- DRAINAGE
- RAILROAD
- TREES
- POWERLINE
- ×5338.5 — SPOT ELEVATION
- 5300 — INDEX CONTOUR
- 5298 — INTERMEDIATE CONTOUR
- 218 5422.45
- L-30 — LEASE CORNER
- PERMIT/LEASE BOUNDARY
- W — POTABLE WATERLINE

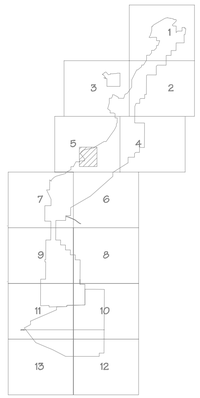

SCALE AS NOTED

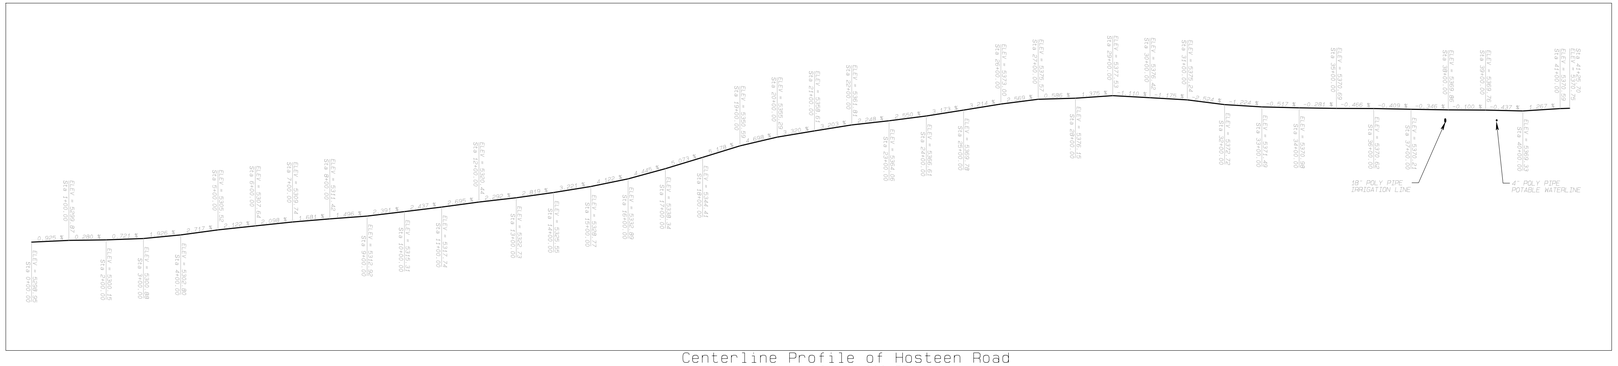

Centerline Profile of Hosteen Road
Horizontal: 1"=200 FT.
Vertical: 1"=40 FT.

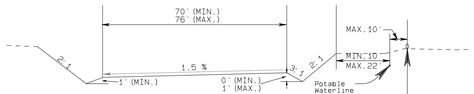

TYPICAL CUT SECTION
FROM STA. 0+00 TO 6+50

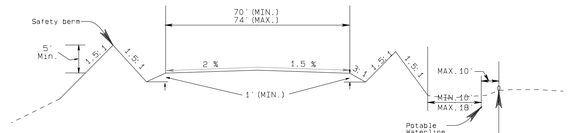

TYPICAL FILL SECTION
FROM STA. 6+50 TO 17+00

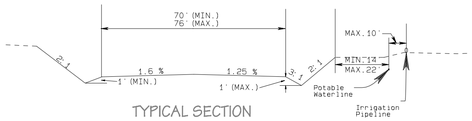

TYPICAL SECTION
FROM STA. 17+00 TO 29+50

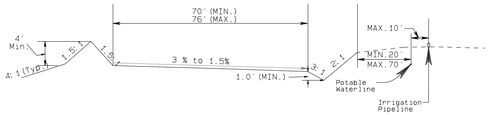

TYPICAL SUPERELEVATED SECTION
FROM STA. 29+50 TO 37+40

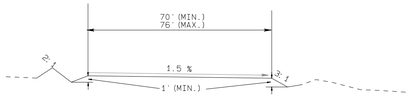

TYPICAL CUT SECTION
FROM STA.37+40 TO 41+25.70

ABOVE SECTIONS
N.T.S

CERTIFICATION STATEMENT

I, Leonard Raymond, hereby certify that this haulroad has been constructed in accordance with the approved design plans and that the information shown is complete and accurate to the best of my knowledge.

LEONARD RAYMOND
NEW MEXICO
6600
REGISTERED PROFESSIONAL ENGINEER

REV. NO.	DESCRIPTION	REV. BY	DATE
2	SUBMITTED TO OSM FOR REVIEW	RY	4-04-05
4			
5			

PROJECT MANAGER: DR
ENGR. of RECORD: LR
REG. NO: 6600
SRVYR of RECORD:
REG. NO:

BHP NAVAJO COAL CO.
NAVAJO MINE
PO BOX 1717, FRUITLAND, NEW MEXICO, 87416

ACCOUNT:
DATE: 4-4-05
DESIGNED BY: RY
DRAWN BY: RY
CHECKED BY: LR
APPROVED BY: LR

PLAN, PROFILE AND SECTION

EXHIBIT 11-062C
HOSTEEN ROAD
AS-BUILT

DRAWING

SHEET 1
OF 1

PATH: C:\Departments\OSM_SUBM\PDF_PMDS\CH_11\11-062 HOSTEN ROAD\Hosteen Road As_built.pnt