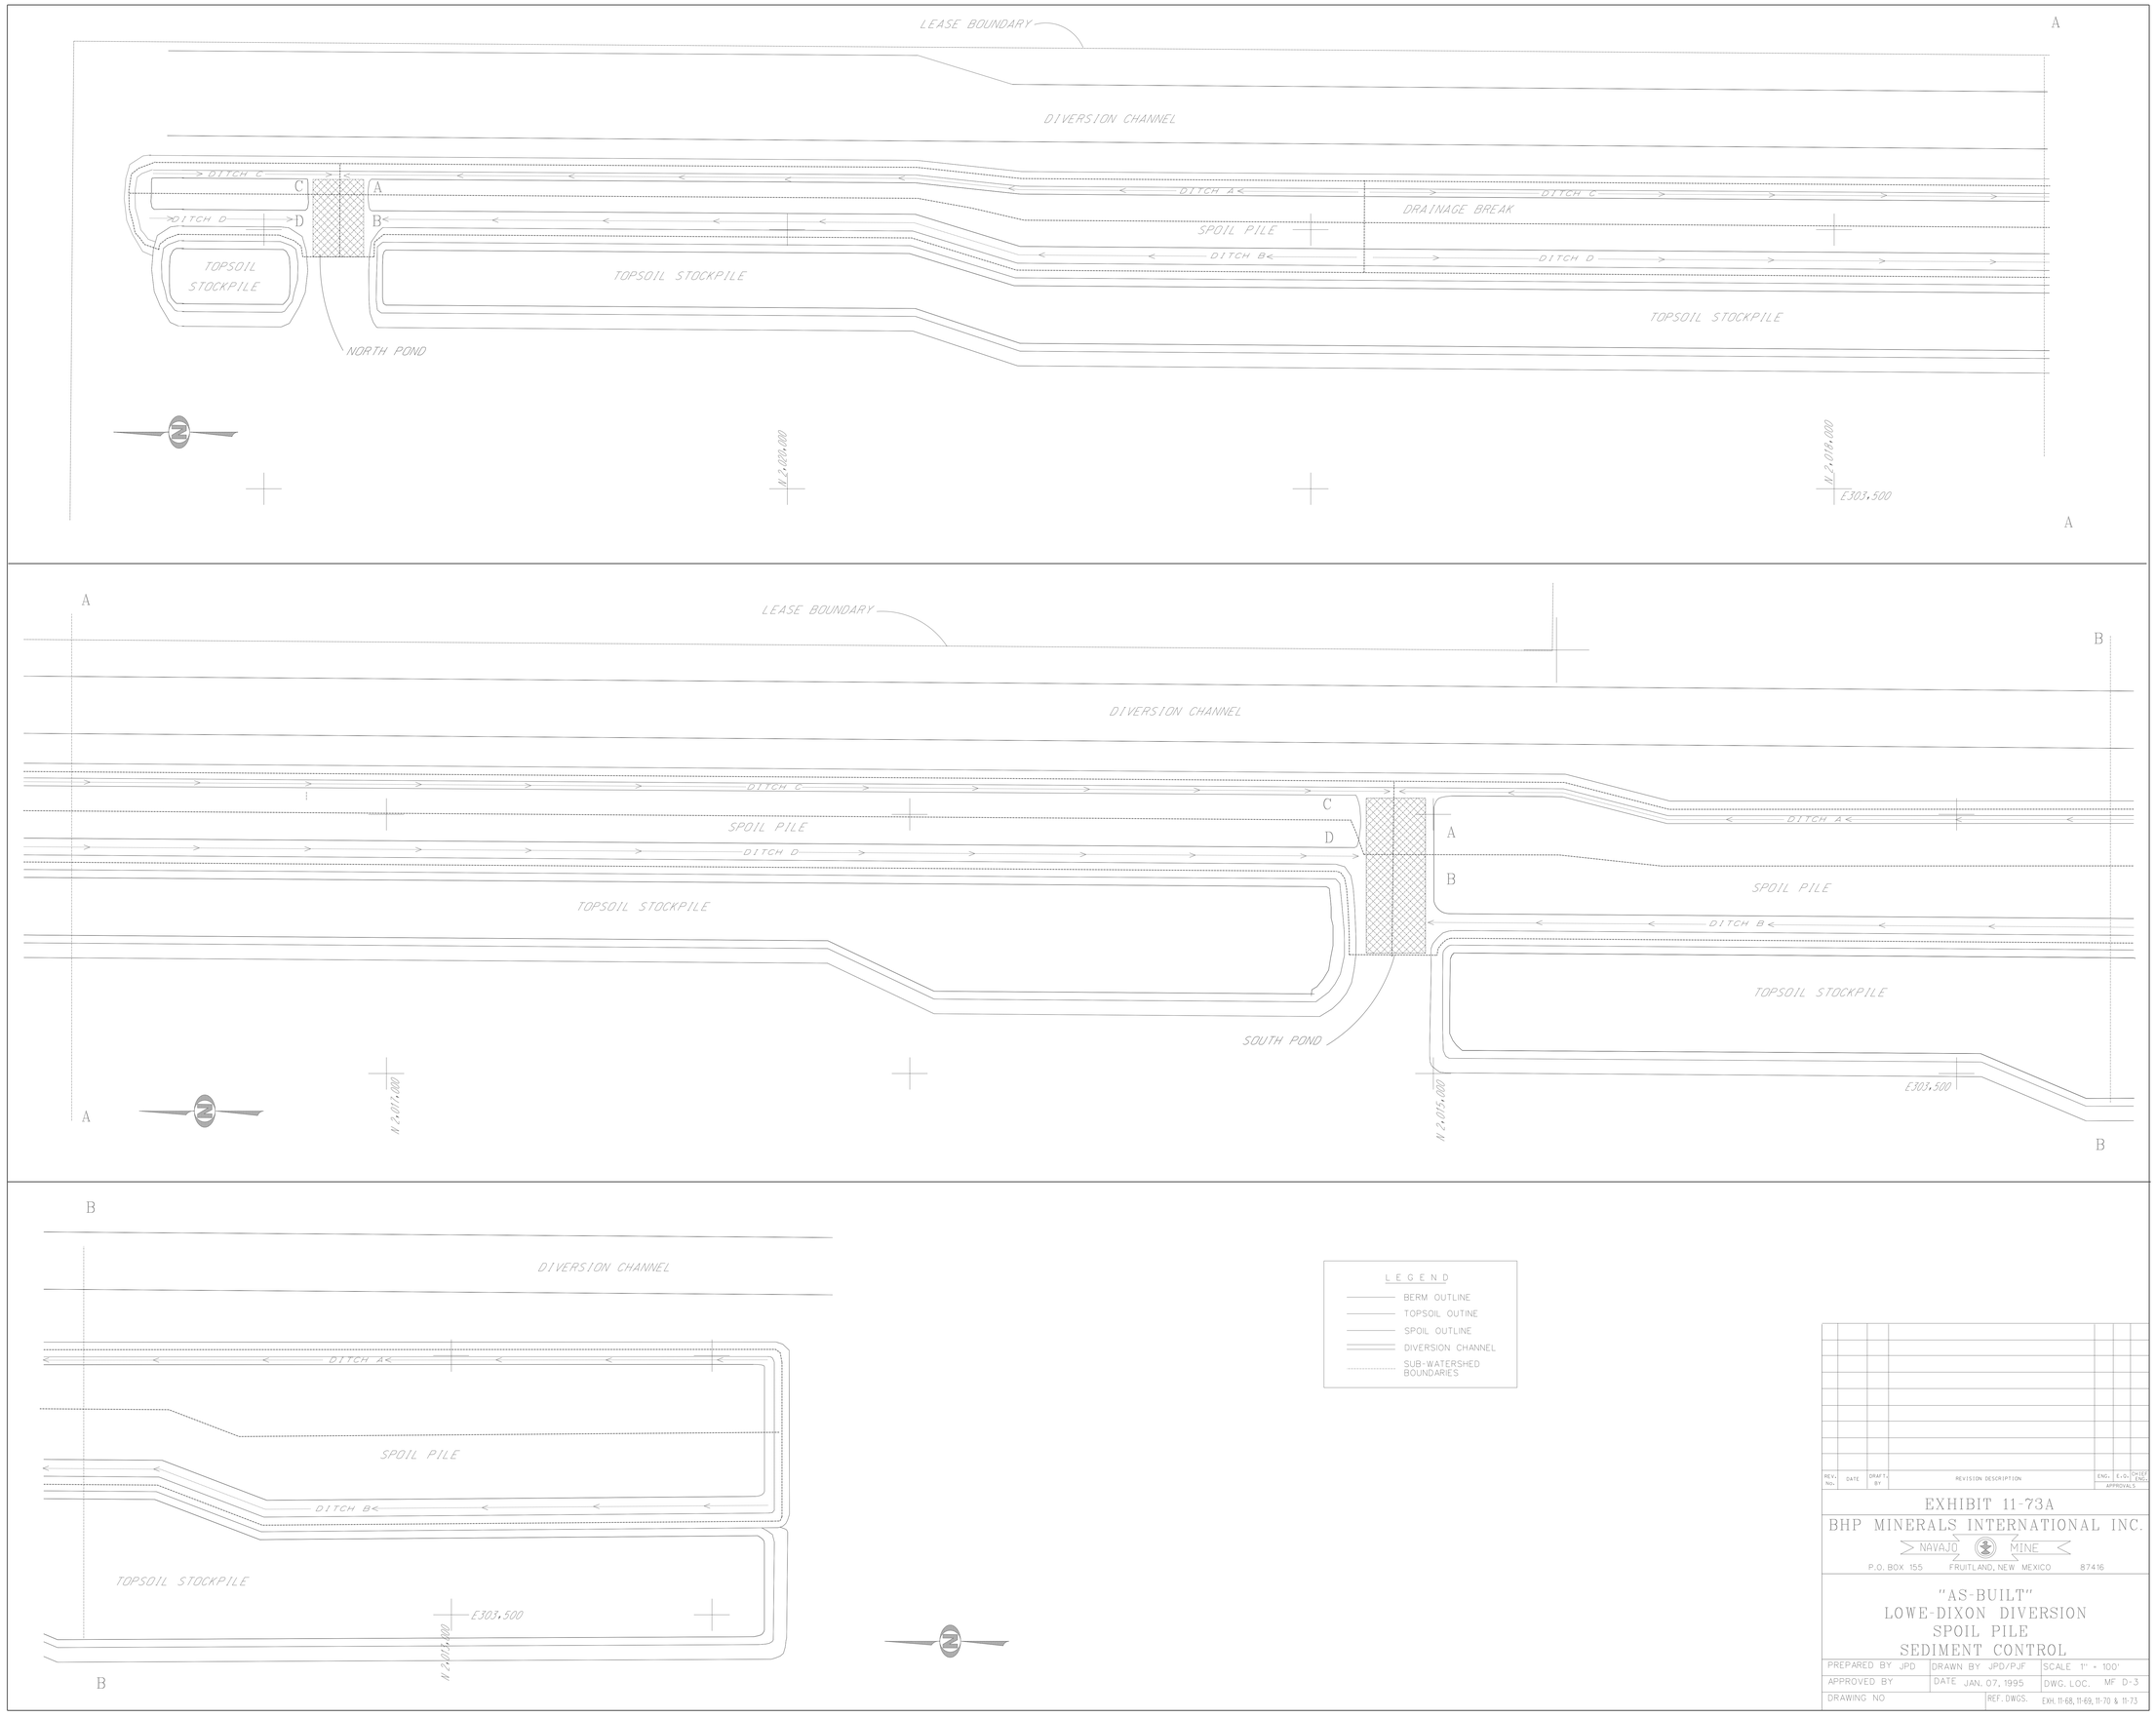

REV. NO.	DATE	DRAFT. BY	REVISION DESCRIPTION	ENG.	E.O.	CHIEF ENG.
				APPROVALS		

EXHIBIT 11-73A

BHP MINERALS INTERNATIONAL INC.

NAVAJO MINE

P.O. BOX 155 FRUITLAND, NEW MEXICO 87416

"AS-BUILT"
LOWE-DIXON DIVERSION
SPOIL PILE
SEDIMENT CONTROL

PREPARED BY JPD	DRAWN BY JPD/PJF	SCALE 1" = 100'
APPROVED BY	DATE JAN. 07, 1995	DWG. LOC. MF D-3
DRAWING NO		REF. DWGS. EXH. 11-68, 11-69, 11-70 & 11-73

...lv7-exh-11-073a.dgn Aug. 04, 2005 08:16:51