LOCATION MAP
Scale: 1" = 200'

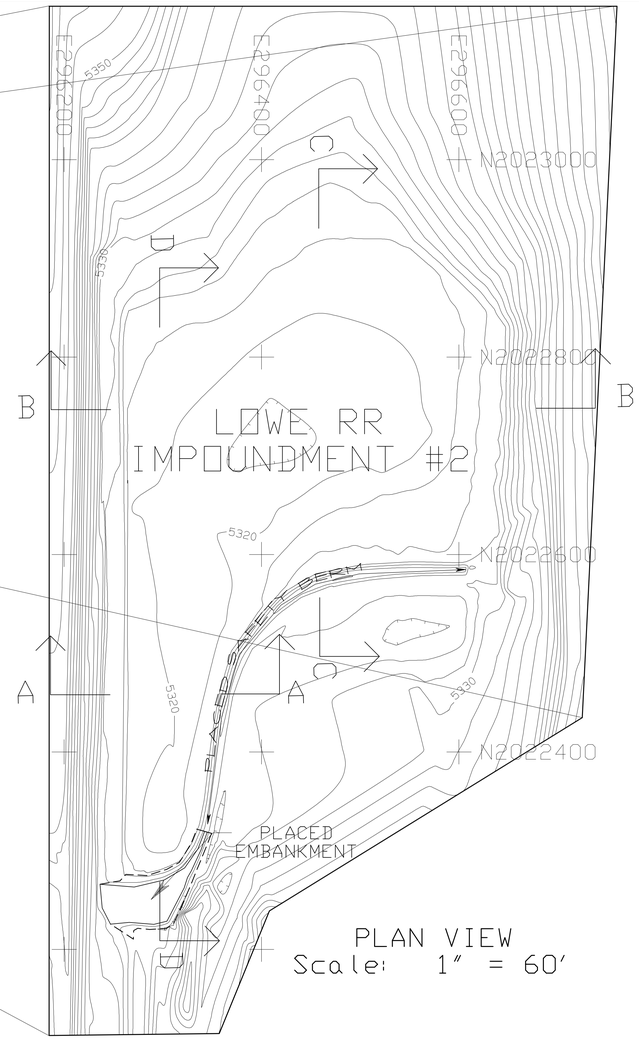

PLAN VIEW
Scale: 1" = 60'

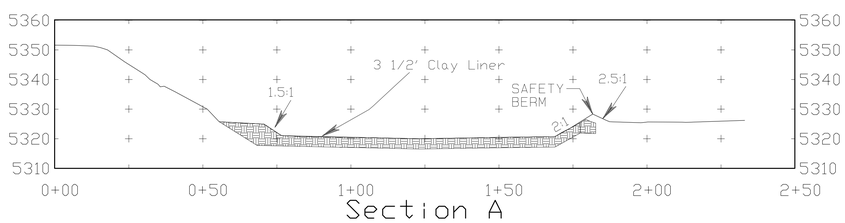

Section A

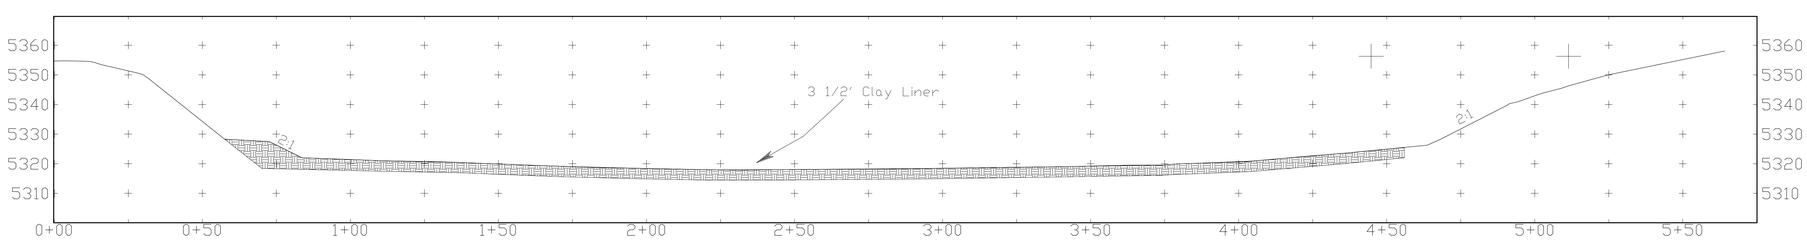

Section B

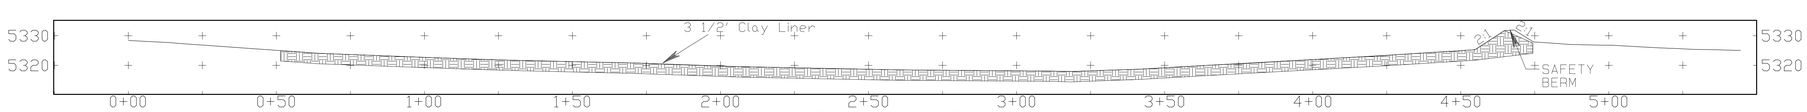

Section C

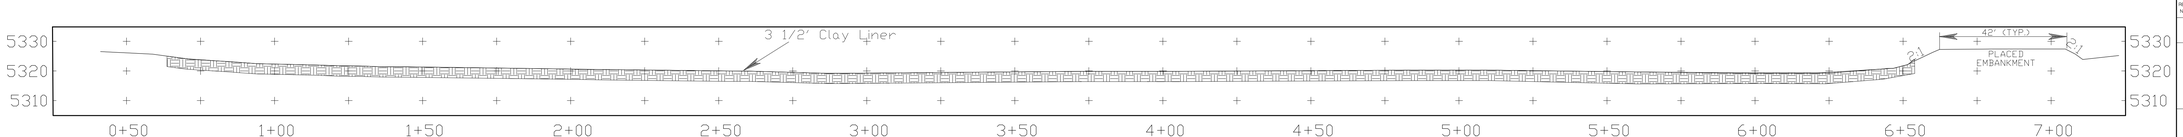

Section D

CROSS SECTIONS
Horiz. Scale: 1" = 20'
Vert. Scale: 1" = 20'

LEGEND

- HAUL ROAD
- TRAIL
- FENCE
- IRRIGATION LINE
- CULVERT
- DAM
- DRAINAGE
- RAILROAD
- POWERLINE
- 5302 INDEX CONTOUR
- 5298 INTERMEDIATE CONTOUR

NOTES

1. For hydrology information refer to Appendix 11-4A in the approved PAP.
2. For watershed information refer to Exhibit 11-13E in the approved PAP.
3. For impoundment and blueline elevation information refer to Table 11-5A.
4. Gauge Post base elevation 5318.0 (GPS)

STAGE STORAGE DATA

ELEV feet	AREA acres	VOLUME ac-ft	CUM. VOLUME ac-ft
5318	0.092	0.000	0.000
5319	0.405	0.248	0.248
5320	1.299	0.852	1.100
5321	2.092	1.695	2.796
5322	2.598	2.345	5.141
5323	2.977	2.788	7.929
5324	3.338	3.155	11.083
5325	3.651	3.488	14.571
5326	3.958	3.797	18.368

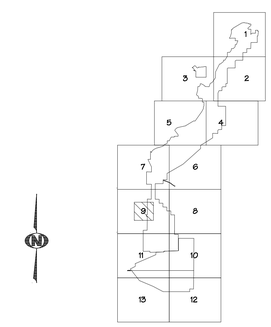

CERTIFICATION STATEMENT

I, Ron C. VAN VALKENBURG, hereby certify that this drawing was reviewed by me and that the information shown is complete and accurate to the best of my knowledge.

RON C. VAN VALKENBURG NEW MEXICO 9263 LICENSED PROFESSIONAL ENGINEER

REV. No.	DATE	DRAFT. BY	REVISION DESCRIPTION	ENG.	E.G.	P.E.	P.S.	CHIEF ENG.
08A	06/2/08	RY	UPDATED AS-BUILT TO CURRENT	SS	YB	RCV	BH	RF
A	05/27/97	VAH	SUBMITTED TO OSM FOR REVIEW					

APPROVALS

EXHIBIT 11-67B

NAVAJO COAL COMPANY

NAVAJO MINE

P.O. BOX 155 FRUITLAND, NEW MEXICO 87416

AREA III

LOWE RAILROAD IMPOUNDMENT #2
AS - BUILT

PREPARED BY FTJ	DRAWN BY FTJ	SCALE AS NOTED
APPROVED BY RCV	DATE Thu Mar 24 2011	REF DWG EXH. 11-67A
DWG LOC	G:\Gs\Permit F\Ch 11\Exh 11-067_Lowe-Railroad Imp 1-2\	