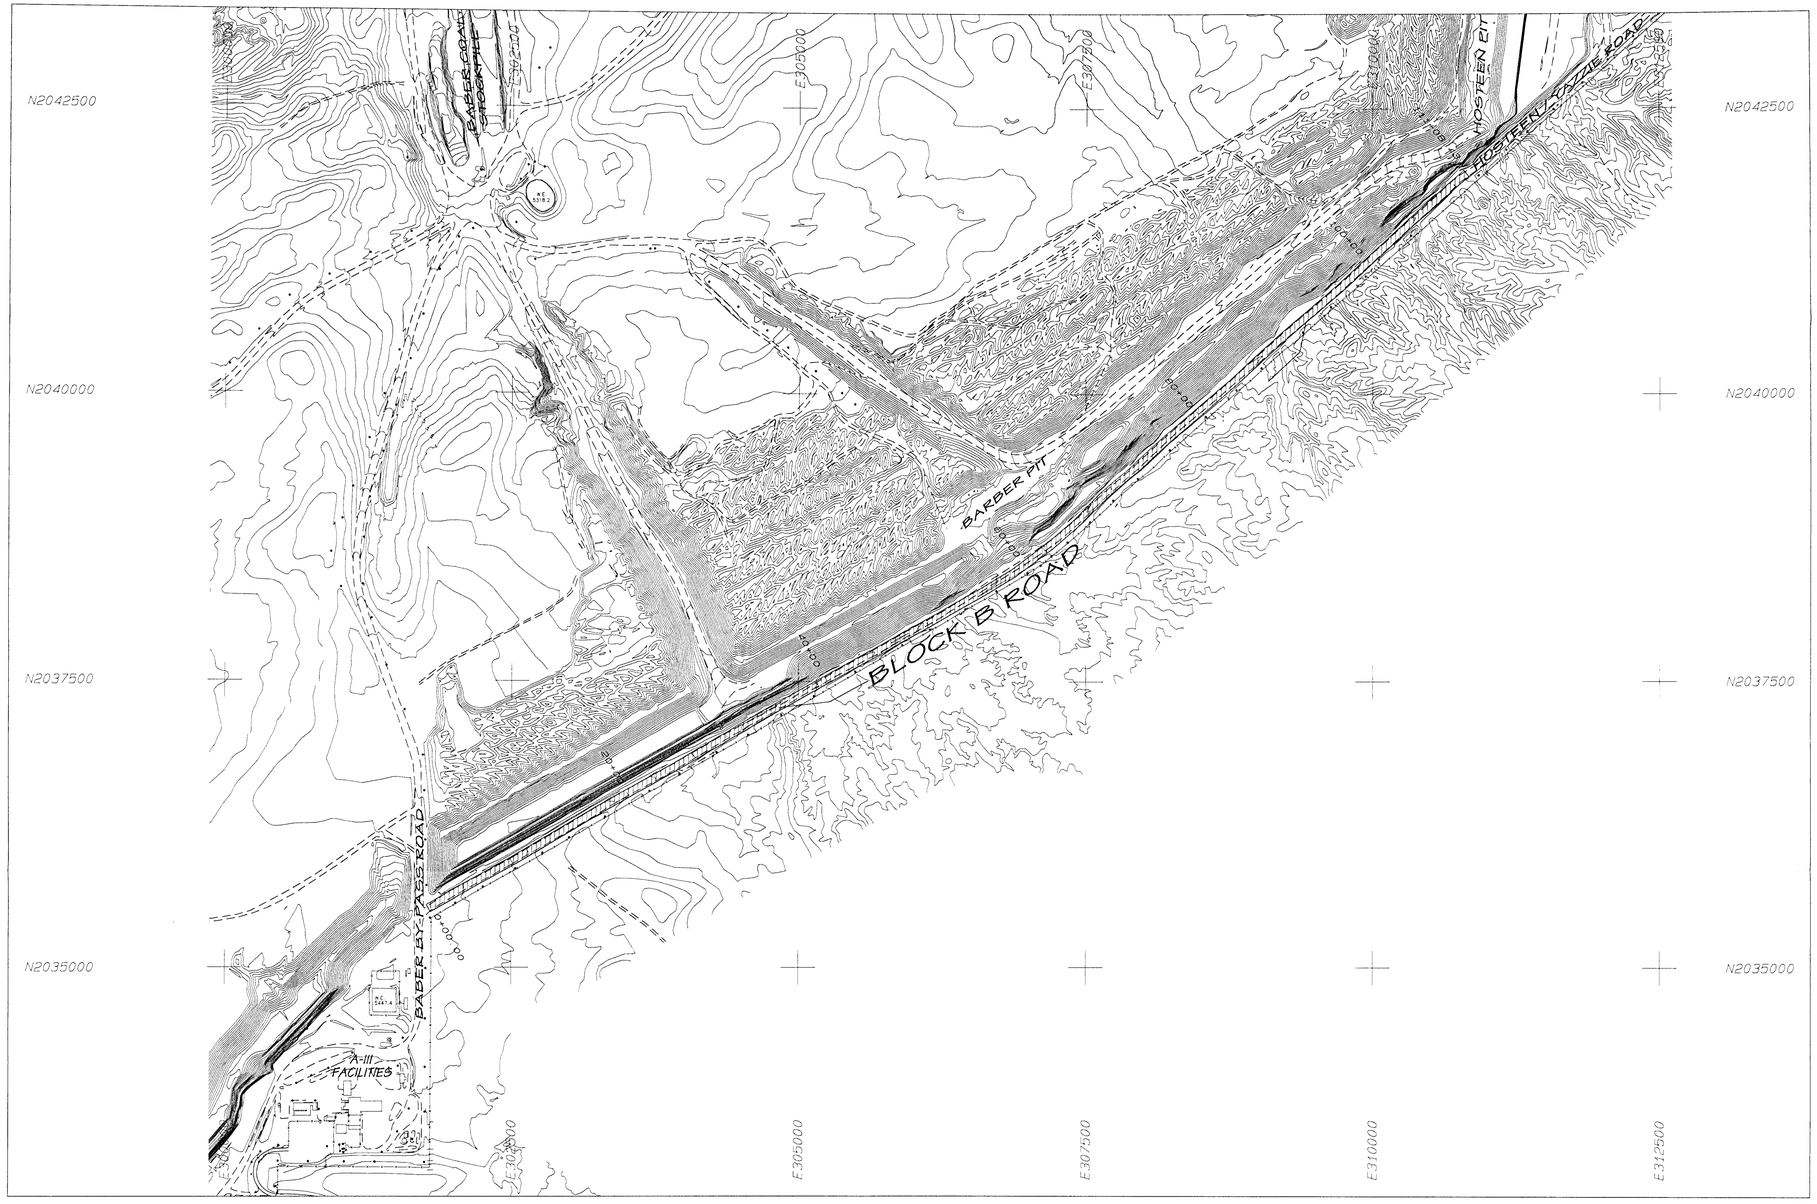

LOCATION MAP
Scale: 1" = 600'

LEGEND

- ROAD
- WATERSHED
- BUILDING
- FENCE
- IRRIGATION LINE
- CULVERT
- DAM
- DRAINAGE
- RAILROAD
- TREES
- POWERLINE
- x5338.5 — SPOT ELEVATION
- 5300 — INDEX CONTOUR
- 5298 — INTERMEDIATE CONTOUR
- 218 / 5422.45 — LEASE CORNER
- L-30 — LEASE CORNER
- PERMIT/LEASE BOUNDARY

NOTES

1. For hydrology and design information refer to Appendix 11-V in the approved PAP.
2. The watershed areas for culverts are shown on Exhibit 11-120

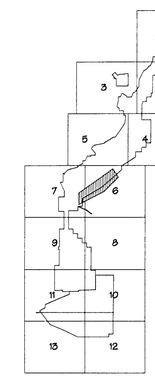

SCALE AS NOTED

CERTIFICATION STATEMENT

I, Leonard Raymond, hereby certify that this haulroad has been constructed in accordance with the approved design plans and that the information shown is complete and accurate to the best of my knowledge.

LEONARD RAYMOND — NEW MEXICO — 6600 — REGISTERED PROFESSIONAL ENGINEER

4-21-06

4-17-06

REV. NO.	DESCRIPTION	REV. BY	DATE
1	SUBMITTED TO OSM FOR REVIEW	RT	04-17-06
2			
3			
4			
5			

PROJECT MANAGER: DR
ENGR. OF RECORD: LR
REG. NO. 6600
SRVYR. of RECORD:
REG. NO.

BHP NAVAJO COAL CO.
NAVAJO MINE
PO BOX 1717, FRUITLAND, NEW MEXICO, 87416

ACCOUNT:
DATE: 4-17-06
DESIGNED BY: RT
DRAWN BY: RT
CHECKED BY: LR
APPROVED BY: LR

LOCATION MAP

EXHIBIT 11-63C
BLOCK "B" ROAD MODIFICATION
AS-BUILT

DRAWING

SHEET 1 OF 3

Path: G:\Departments\GIS\CDM\Submrsk\JAGGUO_13.2\BP_Inhi\15\15-063 Block B Haul Modification as-built.prj