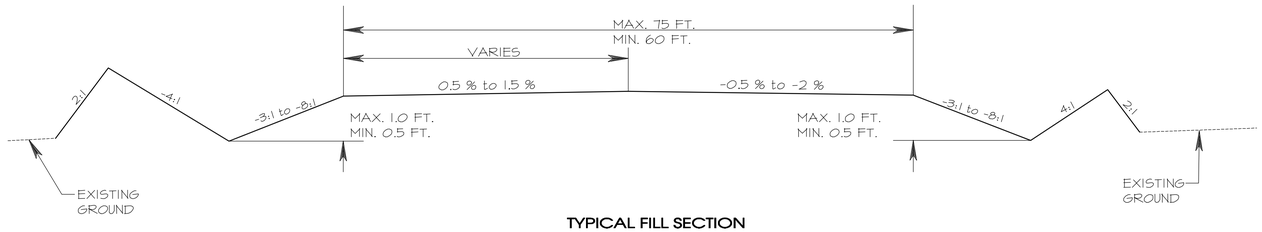

TYPICAL FILL SECTION
N.T.S

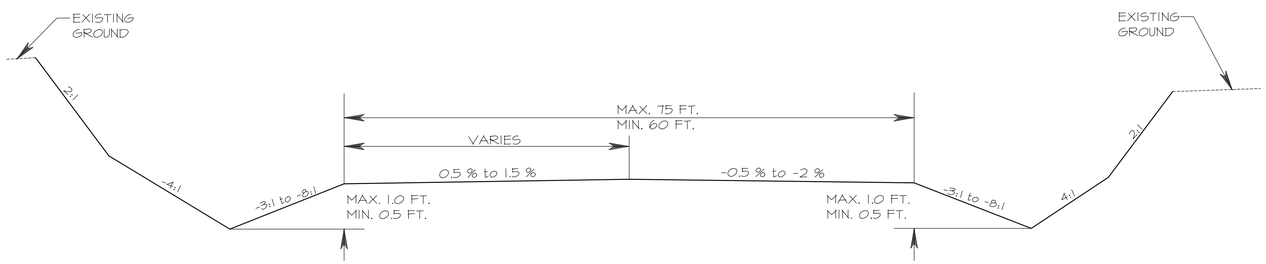

TYPICAL CUT SECTION
N.T.S

LEGEND

	ROAD
	WATERSHED
	BUILDING
	FENCE
	IRRIGATION LINE
	CULVERT
	DAM
	DRAINAGE
	RAILROAD
	TREES
	POWERLINE
x5338.5	SPOT ELEVATION
5300	INDEX CONTOUR
5298	INTERMEDIATE CONTOUR
218 5422.45	
L-30	LEASE CORNER
	LEASE/PERMIT BOUNDARY

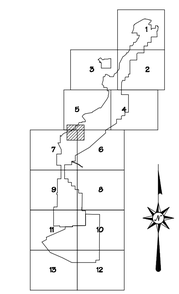

REV. No.	DATE	DRAFT. BY	REVISION DESCRIPTION	ENG.	E.G.	P.E.
09-A	11-30-09	PJF	PREPARED NECK HAULROAD AS-BUILT EXHIBIT AND SUBMITTED TO OSM FOR REVIEW.	RCVV	YB	RCVV

APPROVALS

CERTIFICATION STATEMENT

I, Ron C. Van Valkenburg, hereby certify that this drawing was reviewed by me and that the information shown is complete and accurate to the best of my knowledge.

RON C. VAN VALKENBURG
NEW MEXICO
9263
LICENSED PROFESSIONAL ENGINEER

EXHIBIT 11-93

NAVAJO COAL COMPANY

bhpbilliton

P.O.BOX 1717 FRUITLAND, NEW MEXICO 87416/PHONE 505-598-4200/FAX 505-598-3361

AREA-III
NECK HAULROAD
SECTIONS
AS-BUILT

PREPARED BY PJF	DRAWN BY PJF	AS NOTED
APPROVED BY RVV	DATE 11-18-09	**Sheet 3 of 3**

G:\Gis\Permit F\Ch 11\Exhibit 11-093\As-Built\EXH 11-93_Neck_Haulroad_As-Built.pro
Mon Nov 30 12:58:07 2009