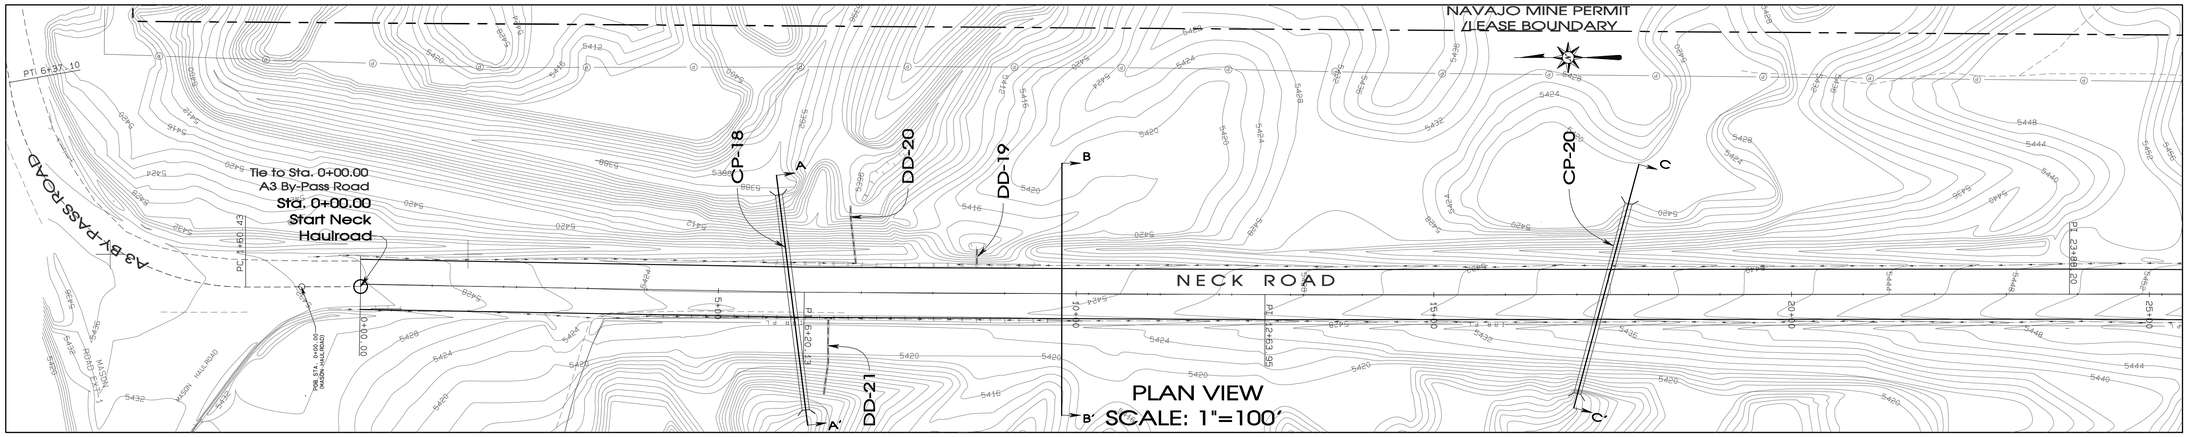

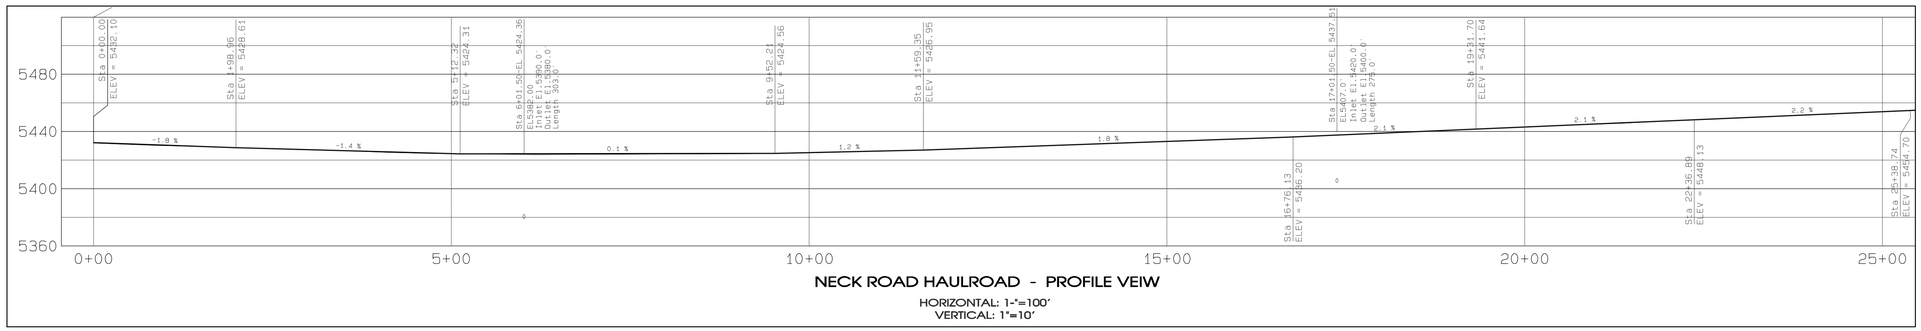

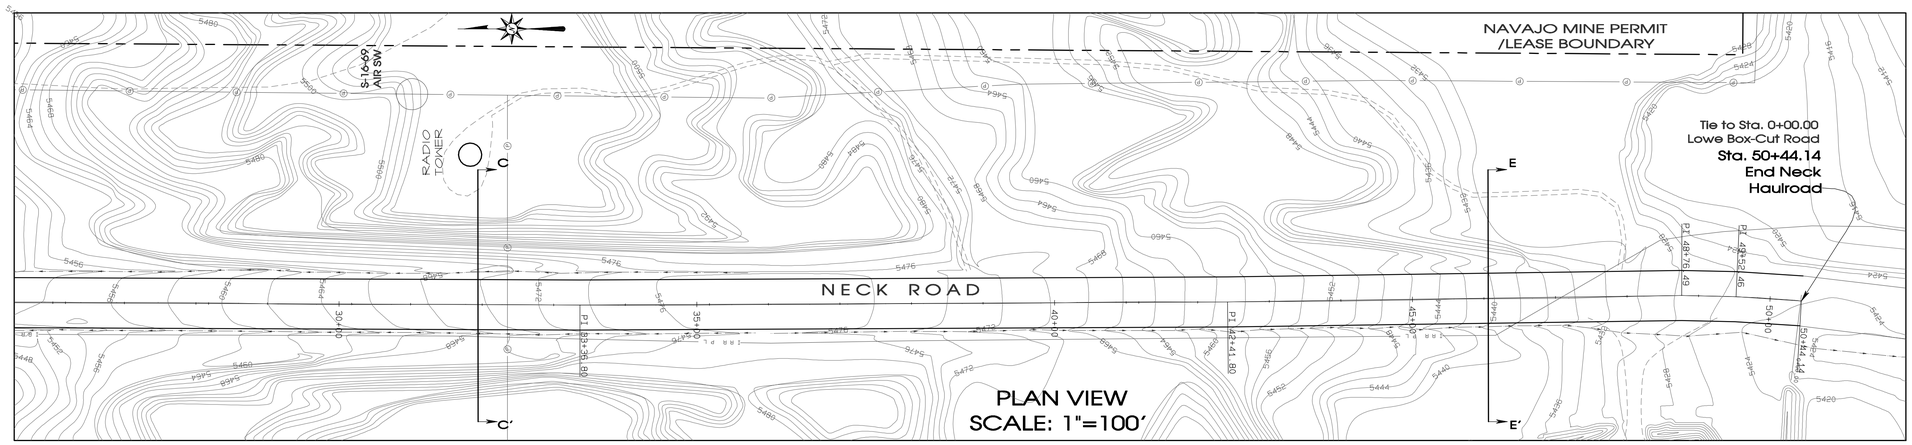

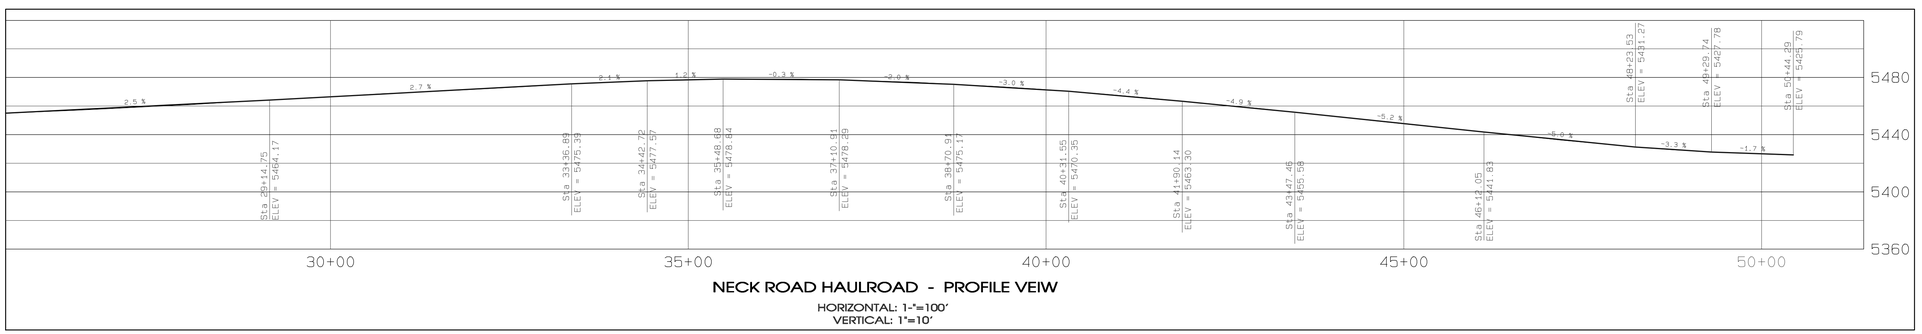

LEGEND

- ROAD
- WATERSHED
- BUILDING
- FENCE
- IRRIGATION LINE
- CULVERT
- DAM
- DRAINAGE
- RAILROAD
- TREES
- POWERLINE
- ×5338.5 SPOT ELEVATION
- 5300 INDEX CONTOUR
- 5298 INTERMEDIATE CONTOUR
- 218 5422.45 L-30 LEASE CORNER
- LEASE/PERMIT BOUNDARY

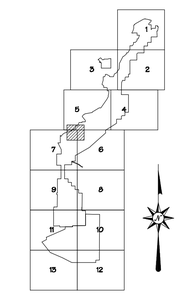

REV. No.	DATE	DRAFT. BY	REVISION DESCRIPTION	ENG.	E.G.	P.E.
D9-A	11-30-09	PJF	PREPARED NECKHAULROAD AS-BUILT EXHIBIT AND SUBMITTED TO OSM FOR REVIEW.	RCVV	YB	RCVV

APPROVALS

CERTIFICATION STATEMENT

I, Ron C. Van Valkenburg, hereby certify that this drawing was reviewed by me and that the information shown is complete and accurate to the best of my knowledge.

RON C. VAN VALKENBURG
NEW MEXICO
9263
LICENSED PROFESSIONAL ENGINEER

EXHIBIT 11-93

NAVAJO COAL COMPANY

bhpbilliton

P.O.BOX 1717 FRUITLAND, NEW MEXICO 87416/PHONE 505-598-4200/FAX 505-598-3361

AREA-III
NECK HAULROAD
PLAN/ PROFILE/
TYPICAL SECTION
AS-BUILT

PREPARED BY	PJF	DRAWN BY	PJF	AS NOTED
APPROVED BY	RVV	DATE	11-18-09	Sheet 2 of 3

G:\Go\Permit F\Ch 11\Exhibit 11-093\As-Built\EXH 11-93_Neck_Haulroad_As-Built.pro
Mon Nov 30 12:52:08 2009