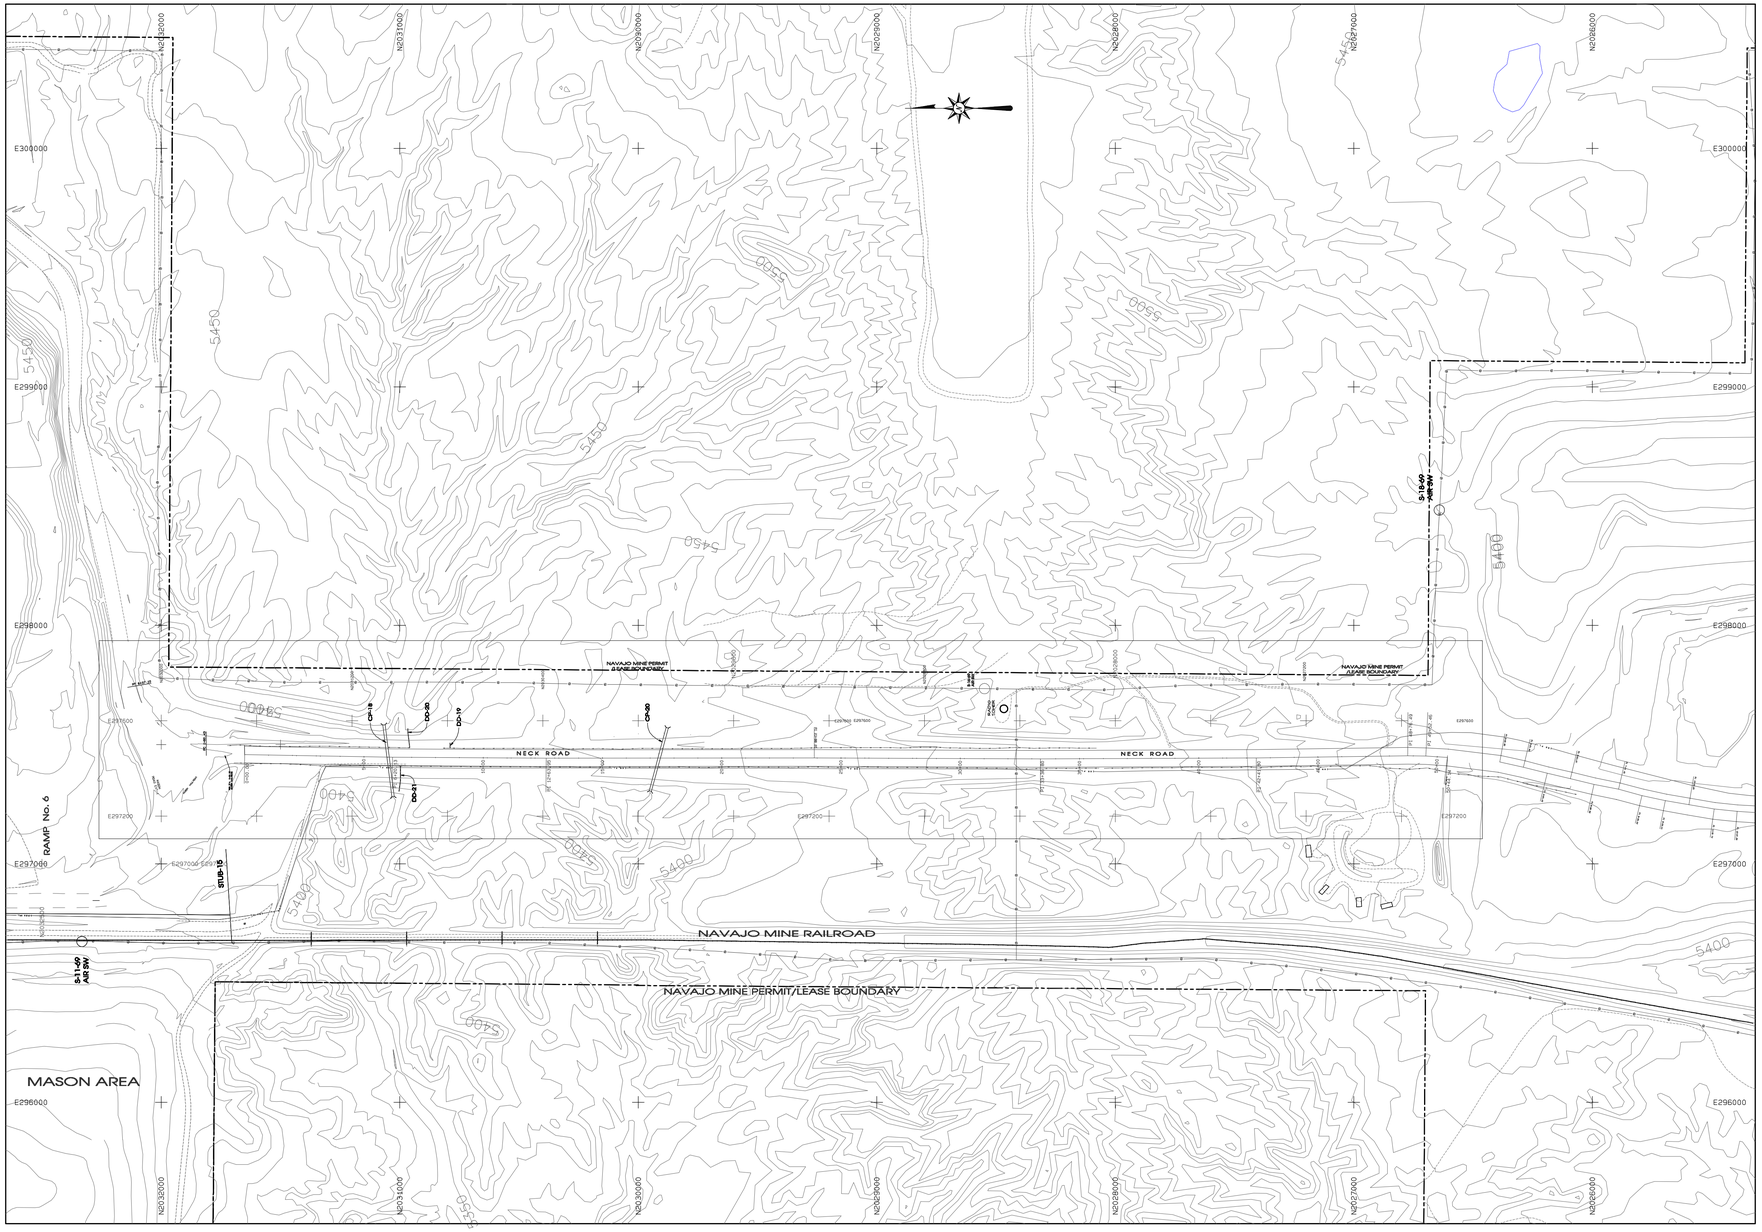

PLAN VIEW
SCALE 1"==300'

LEGEND

- ROAD
- WATERSHED
- BUILDING
- FENCE
- IRRIGATION LINE
- CULVERT
- DAM
- DRAINAGE
- RAILROAD
- TREES
- POWERLINE
- ×5338.5 — SPOT ELEVATION
- 5300 — INDEX CONTOUR
- 5299 — INTERMEDIATE CONTOUR
- 218 5422.45 — L-30 — LEASE CORNER
- LEASE/PERMIT BOUNDARY

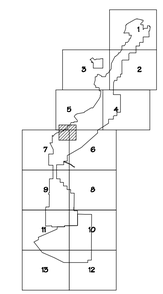

DRAWING INDEX
EXH 11-93_Sheet 1 of 3 NECK HAULROAD AS-BUILT LOCATION MAP
EXH 11-93_Sheet 2 of 3 NECK HAULROAD AS-BUILT PLAN AND PROFILE
EXH 11-93_Sheet 3 of 3 NECK HAULROAD AS-BUILT SECTIONS

REV. No.	DATE	DRAFT. BY	REVISION DESCRIPTION	ENG.	E.G.	P.E.
09-A	11-30-09	PJF	PREPARED NECK HAULROAD AS-BUILT EXHIBIT AND SUBMITTED TO OSM FOR REVIEW.	RCVV	YB	RCVV

APPROVALS

CERTIFICATION STATEMENT

I, Ron C. Van Valkenburg, hereby certify that this drawing was reviewed by me and that the information shown is complete and accurate to the best of my knowledge.

RON C. VAN VALKENBURG
NEW MEXICO
9263
LICENSED PROFESSIONAL ENGINEER

EXHIBIT 11-93

NAVAJO COAL COMPANY

bhpbilliton

P.O.BOX 1717 FRUITLAND, NEW MEXICO 87416/PHONE 505-598-4200/FAX 505-598-3361

AREA-III
NECK HAULROAD
AS-BUILT
LOCATION MAP

PREPARED BY PJF	DRAWN BY PJF	AS NOTED
APPROVED BY RVV	DATE 11-18-09	**Sheet 1 of 3**

G:\Gs\Permit F\Ch 11\Exhibit 11-093\As-Built\EXH 11-93_Neck_Haulroad_As-Built.pro
Mon Nov 30 12:55:09 2009