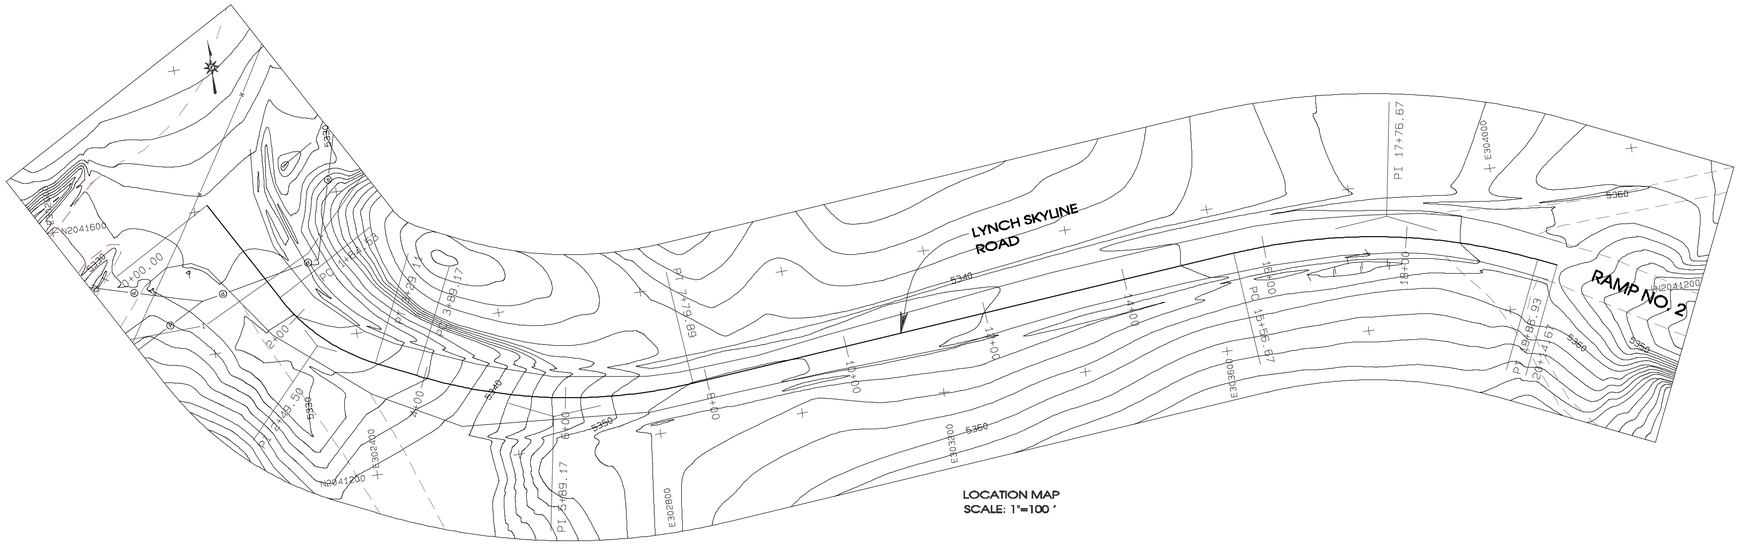

LOCATION MAP
SCALE: 1"=100'

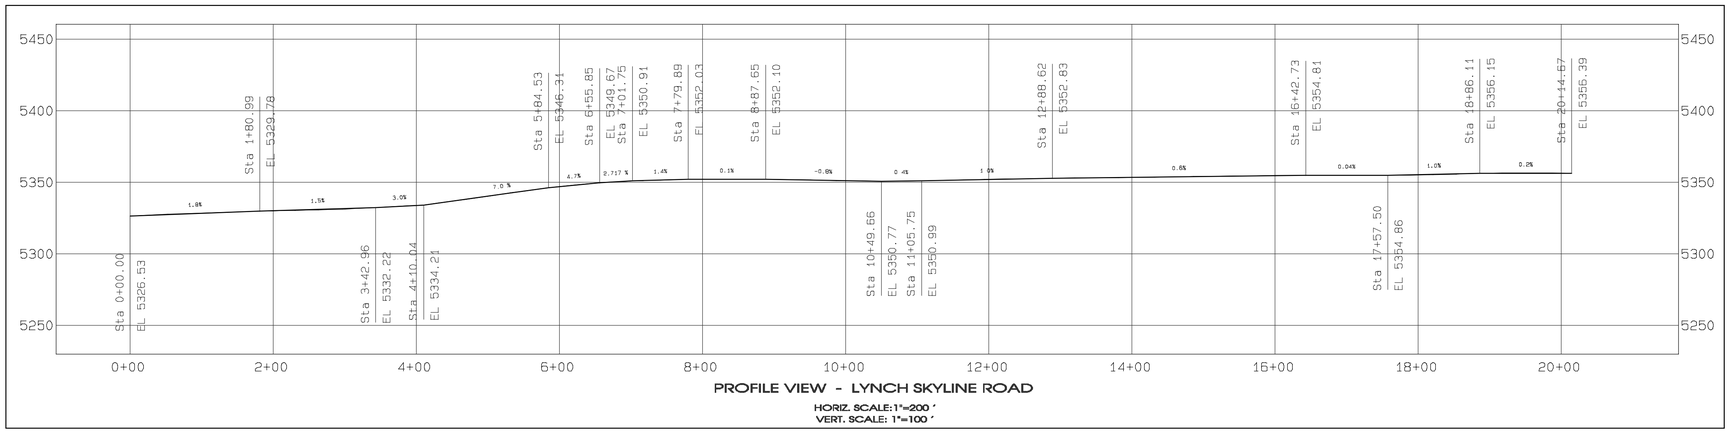

PROFILE VIEW - LYNCH SKYLINE ROAD
HORIZ. SCALE: 1"=200'
VERT. SCALE: 1"=100'

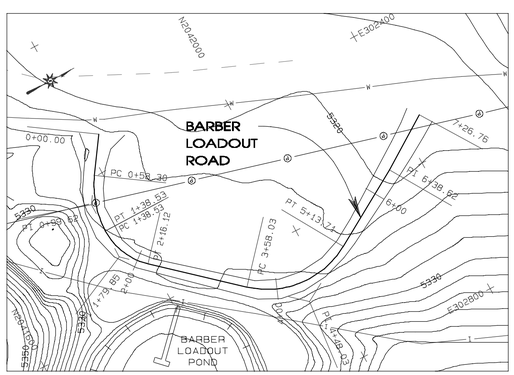

LOCATION MAP
SCALE: 1"=100'

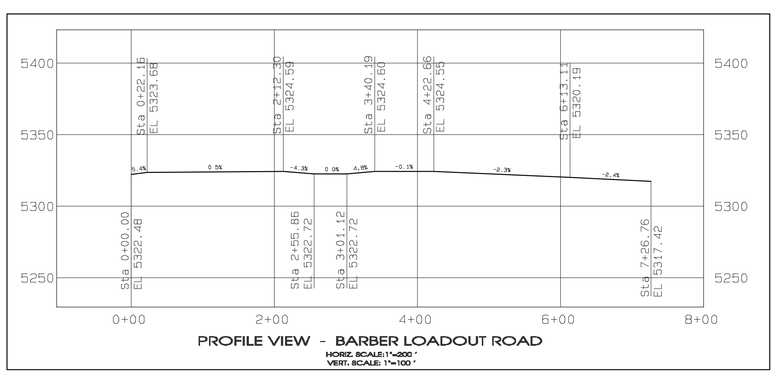

PROFILE VIEW - BARBER LOADOUT ROAD
HORIZ. SCALE: 1"=200'
VERT. SCALE: 1"=100'

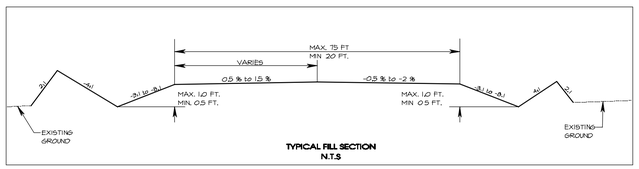

TYPICAL FILL SECTION
N.T.S

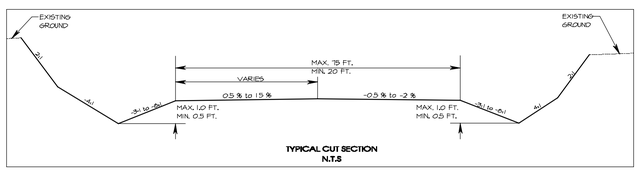

TYPICAL CUT SECTION
N.T.S

LEGEND

- ROAD
- WATERSHED
- BUILDING
- FENCE
- IRRIGATION LINE
- CULVERT
- DAM
- DRAINAGE
- RAILROAD
- TREES
- POWERLINE
- ×5338.5 SPOT ELEVATION
- 5300 INDEX CONTOUR
- 5298 INTERMEDIATE CONTOUR
- 218 5402.45
- L-30 LEASE CORNER
- LEASE/PERMIT BOUNDARY

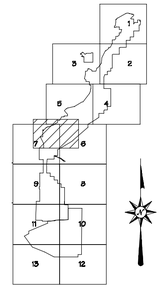

REV. No.	DATE	DRAFT BY	REVISION DESCRIPTION	ENG.	E.G.	P.E.
						APPROVALS
09-1	3-11-09	PJF	SUBMITTED TO DSM FOR REVIEW AND APPROVAL	RCVV	VB	RCVV

CERTIFICATION STATEMENT

I, Ron C. Van Valkenburg, hereby certify that this drawing was reviewed by me and that the information shown is complete and accurate to the best of my knowledge.

RON C. VAN VALKENBURG NEW MEXICO 9263 LICENSED PROFESSIONAL ENGINEER

EXHIBIT 11-100D

NAVAJO COAL COMPANY

bhpbilliton

P.O. BOX 1717 FARMINGTON, NEW MEXICO 87416/PHONE 505-598-4200/FAX 505-598-3361

AREA-II
LYNCH SKYLINE AND BARBER POND LOADOUT ROAD AS-BUILT LOCATION MAP

PREPARED BY PJF	DRAWN BY PJF	AS NOTED	
APPROVED BY RVV	DATE 3-09-09	Sheet 2 of 2	

Path: \\ENDMCFMN-SRV02\Data\Departments\Gs\DSM_SUBM\PER_PROG\CH_11_PAP EXHIBITS\11-100-BARBER BY-PASS-2\EXHIBIT\EXH 11-100D Lynch Skyline.pro
PJFoster \Plot time: Thu Mar 12 12:43:05 2009