REVISIONS			
DWG	DESCRIPTION	DATE	APPROVED
6	REVISED AS BUILT	7/17/91	JRS

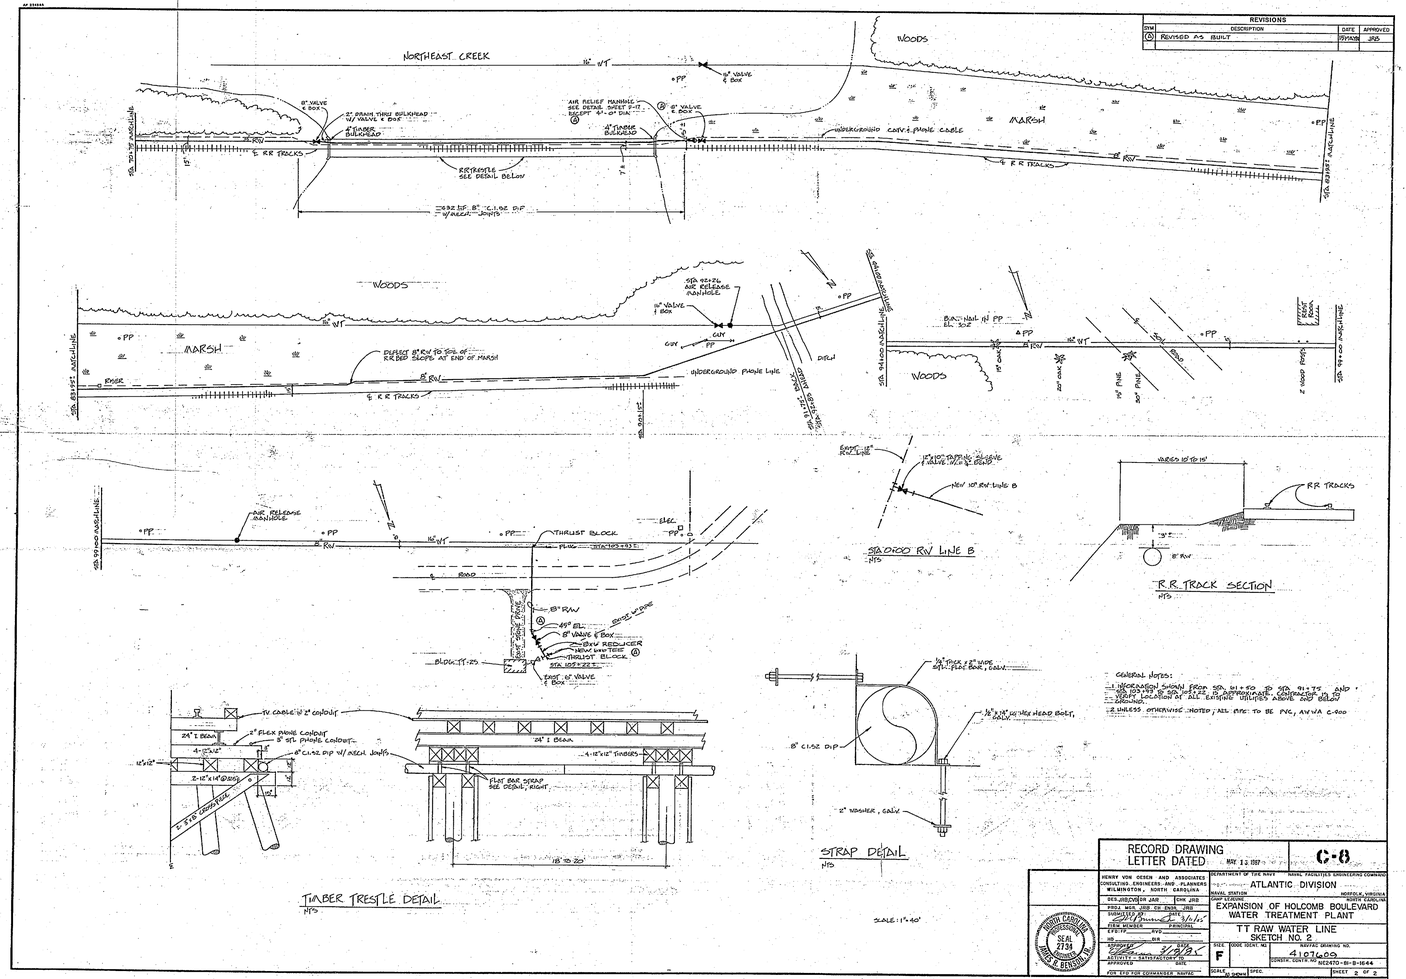

GENERAL NOTES:

1. INCORPORATE SHOWN FROM STA. 91+50 TO STA. 91+77 AND STA. 103+83 TO STA. 103+22.5 IN APPROPRIATE CONTRACTOR'S PLAN FOR EXCAVATION OF ALL EXISTING UTILITIES ABOVE AND BELOW.
2. UNLESS OTHERWISE NOTED, ALL PIPE TO BE PVC, AWWA C-900

RECORD DRAWING LETTER DATED: MAY 12 1987

C-8

HENRY VON OESEN AND ASSOCIATES
CONSULTING ENGINEERS AND PLANNERS
WILMINGTON, NORTH CAROLINA

DESIGNED: JAR | CHK: JRB
REDR. MAR. JRB CH. RAN. JRB
SUPERVISED BY: JRB
DATE: 5/6/86
FIELD REVIEW: FRONTING
EXP-19 REV.
NO. REV.
APPROVED: 5/28/86
ACTIVITY - SATISFACTORILY ID
APPROVED DATE
FOR EXP FOR COMMANDER NAVFAC

NORTH CAROLINA PROFESSIONAL SEAL 2734 ENGINEER

DEPARTMENT OF THE NAVY NAVAL FACILITIES ENGINEERING COMMAND
ATLANTIC DIVISION
NAVAL STATION NORFOLK, VIRGINIA
CHIEF ENGINEER

EXPANSION OF HOLCOMB BOULEVARD
WATER TREATMENT PLANT

TT RAW WATER LINE
SKETCH NO. 2

SIZE: F | CODE IDENT. NO. | NAVFAC DRAWING NO. 4107400
CONTR. CONTR. NO. N62470-81-B-1644
SCALE: 1" = 40' | DRWN | SPEC.
SHEET 2 OF 2
SFG DWG NO. 207409