

$$\text{Kilowatts} \times 1.34 = \text{H.P.}$$

$$\text{Watts} \div 746 = \text{H.P.}$$


P.S.I.	Feet.	Psi	Feet	Psi - Feet.
10.0	23.1	17	39.3	24 - 55.4
10½	24.3	17½	40.4	24½ - 56.6
11	25.4	18	41.6	25 - 57.8
11½	26.6	18½	42.7	25½ - 58.9
12	27.7	19	43.9	26 - 60.1
12½	28.9	19½	45.0	26½ - 61.2
13	30.0	20	46.2	27 - 62.4
13½	31.2	20½	47.4	27½ - 63.5
14	32.3	21	48.5	28 - 64.7
14½	33.5	21½	49.7	28½ - 65.8
15	34.7	22	50.1	29 - 67.0
15½	35.8	22½	52.0	29½ - 68.1
16	37.0	23	53.1	30 - 69.3
16½	38.1	23½	54.3	30½ - 70.5

$$1 \text{ psi} = 2.31$$

$$\frac{1}{4} \text{ psi} = .58$$

$$\frac{1}{2} \text{ psi} = 1.2$$

$$\frac{3}{4} \text{ psi} = 1.7$$

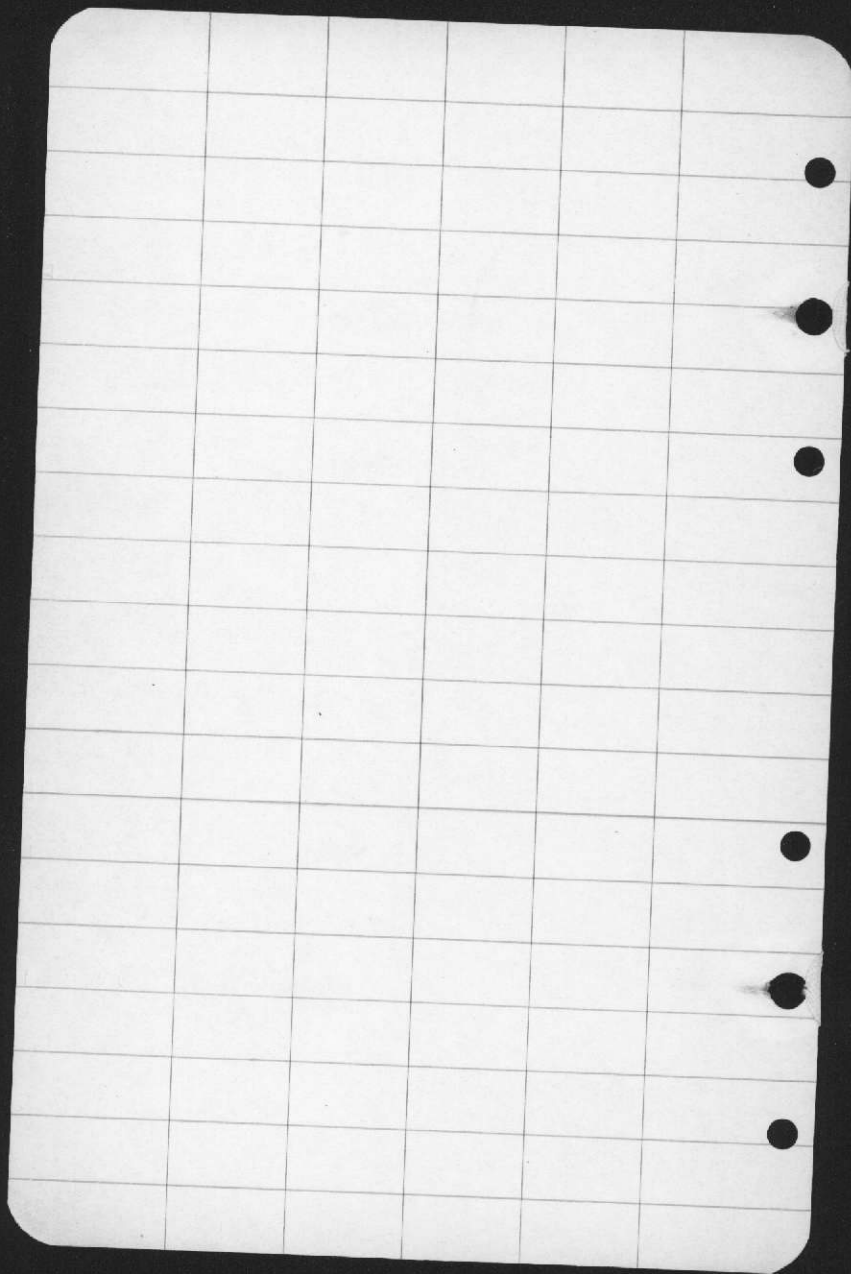

GENERAL NOTES

- 1 - Steel Casing - 18" O.D. - Standard Weight.
- 2 - Steel Tubing - 8" - Standard Weight.
- 3 - Shutter Screens - Silicon Bronze Unless  
Otherwise Noted.
- 4 - EL.  $\pm$  0.00 = Mean Sea Level.

NOTES FEB. 1945

Data marked \* corresponds with Archit. Engrs Report - Feb. 1945

Recommended maximum operating condition for each Well, shown


Max.  
300 G.P.M.



- WELL DATA -

Division Training Area-

Division Training Area

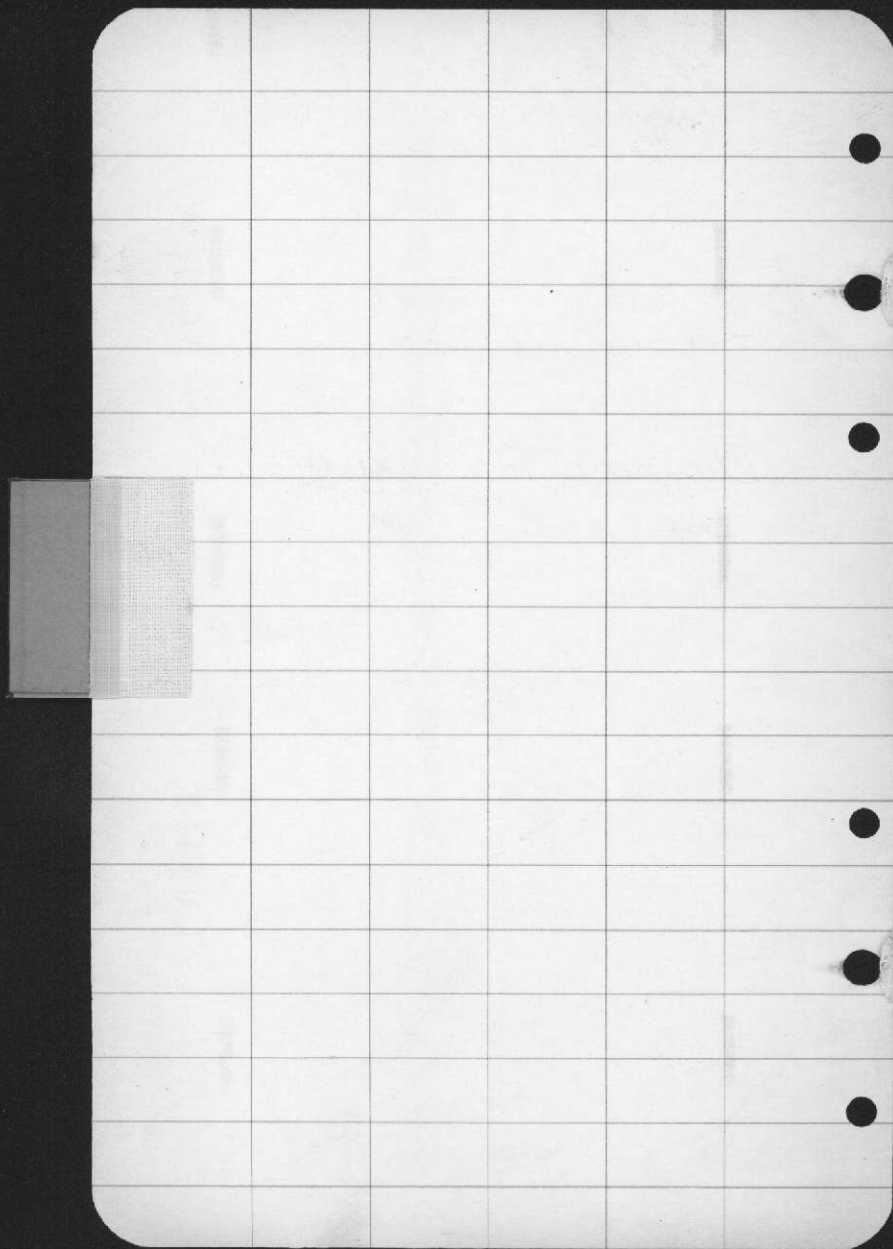




WELL  
1


601




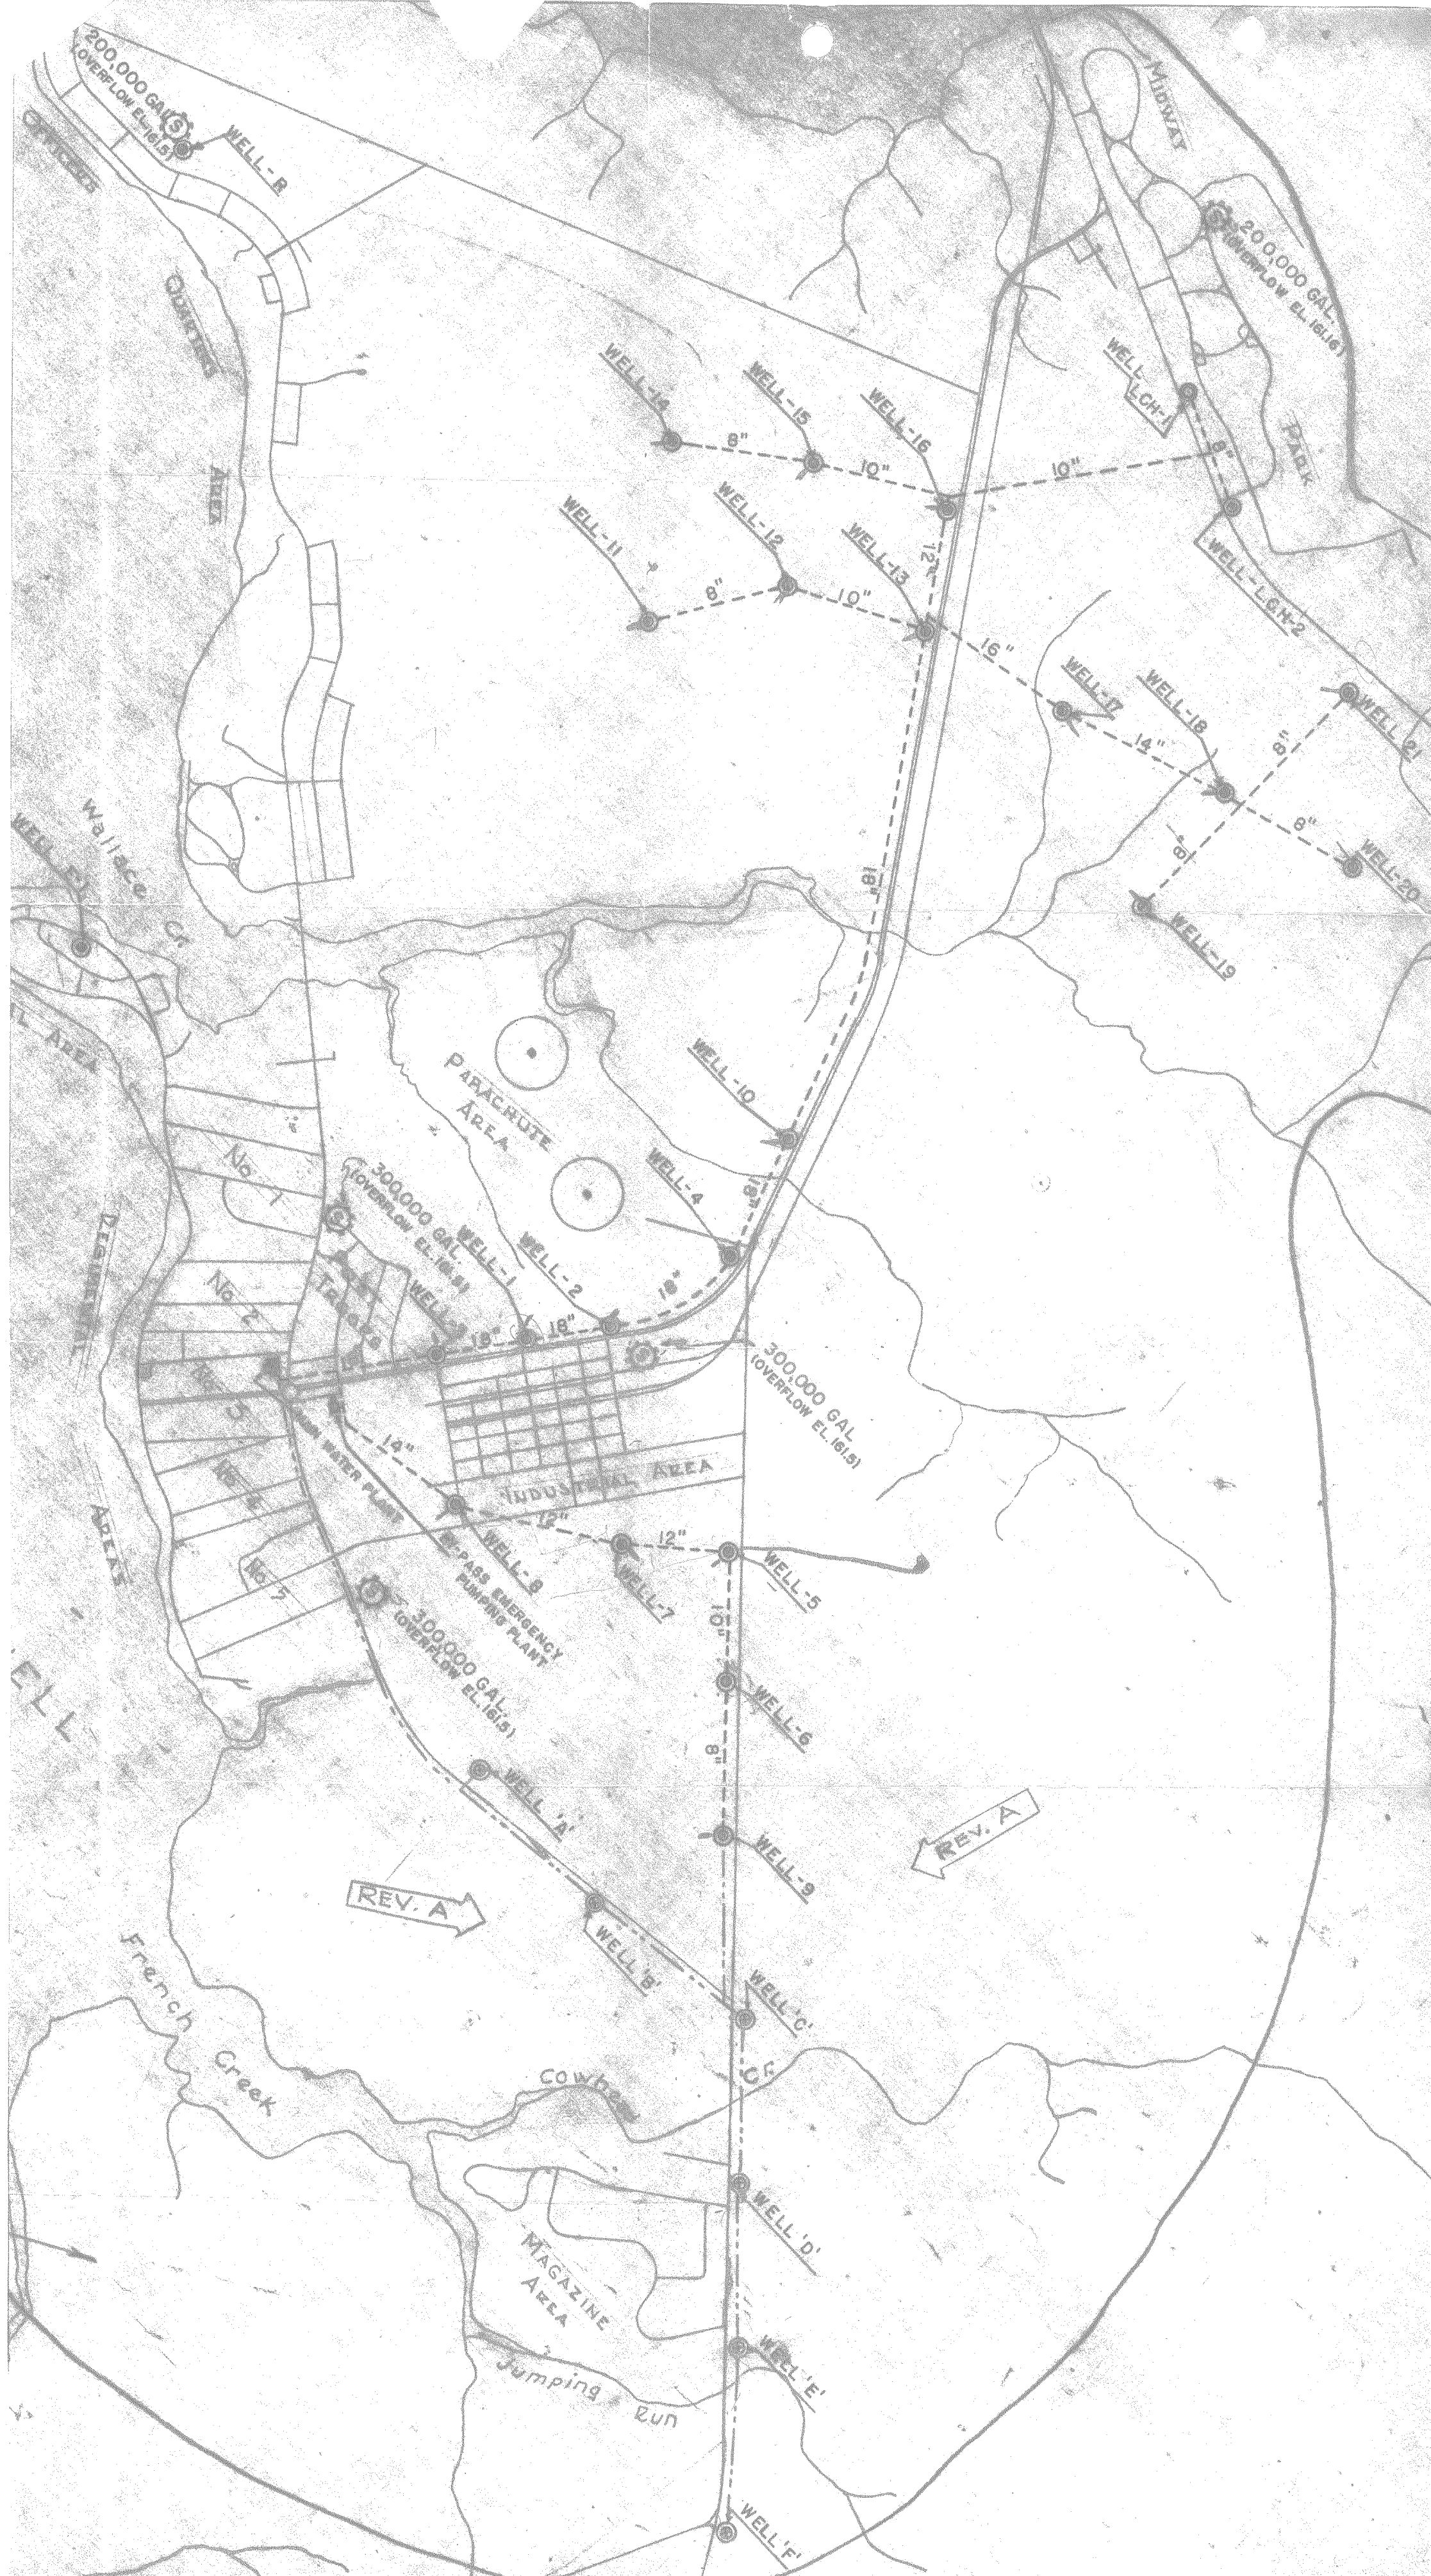


ENGINEER  WELL-ES-1  
 STOCKER

 

250 G.P.M. — DUAL DRIVE — 7½ H.P.  
 237 " " " actual. Recom. 300 G.P.M. 10 H.P.



24.90 (Nov. 13/51)

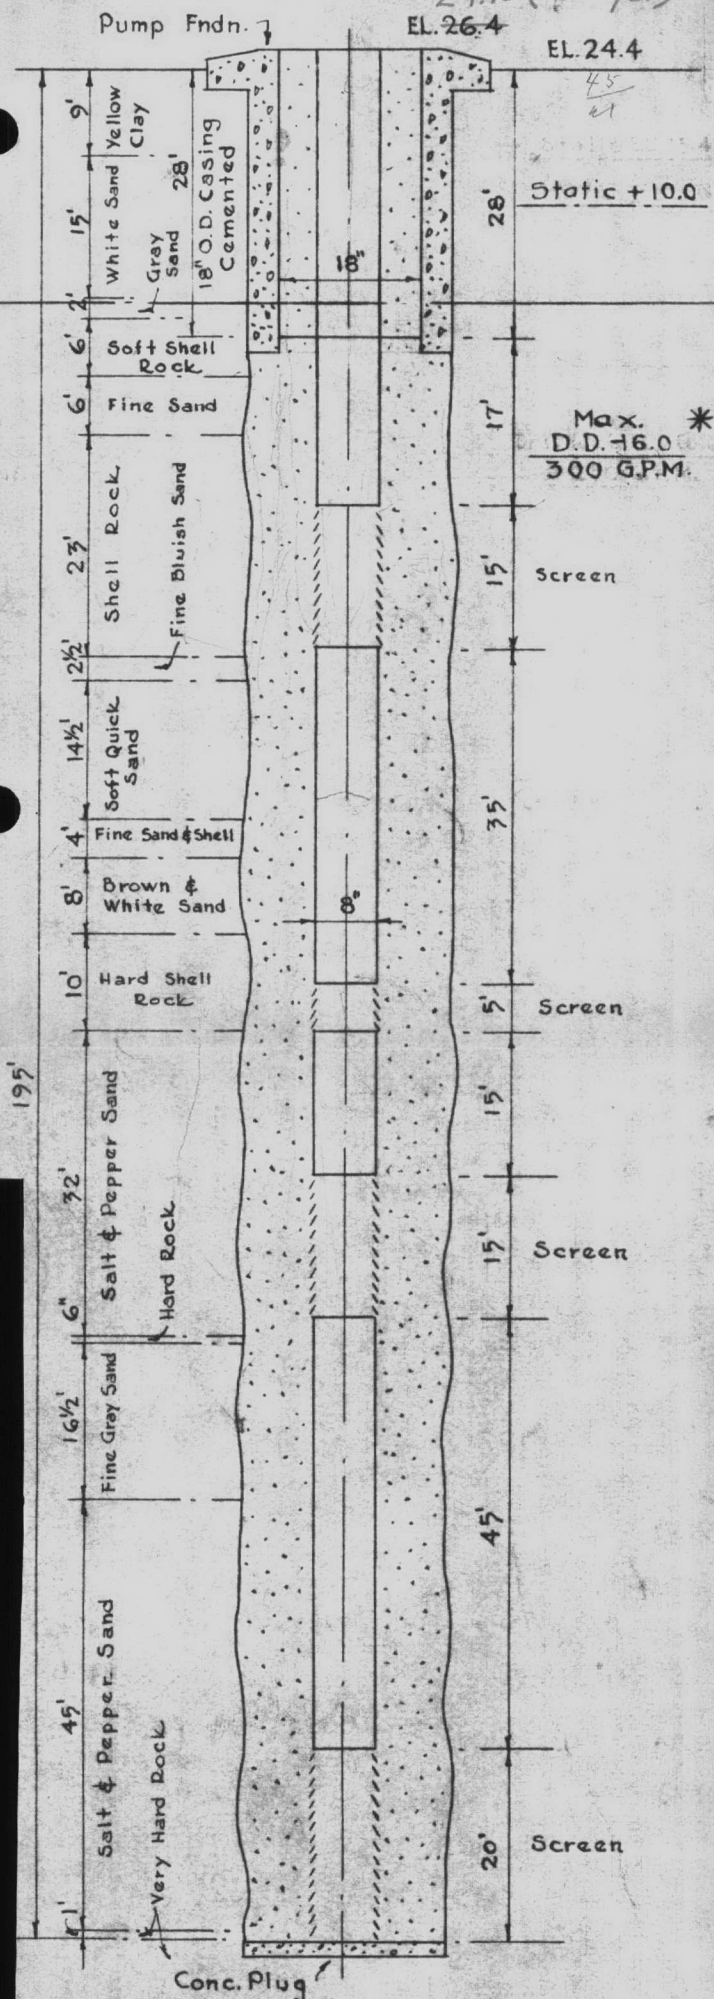

D.T.A. WELL No. 1

2  
14.7  
10.0

10.0

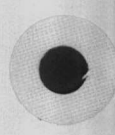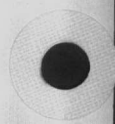



27.9	Run	OPP
26.4 + 1.5	22.1	21.8

no gauge attached







150 G.P.M. - SINGLE DRIVE - 5 H.P.  
154 " " " actual. D.D.-20.3

26.64 (Nov. 13/51)

Pump Fndn.

EL. 25.00

EL. 23.00

48'-6"  
18" O.D. Casing - Cemented

Static + 3.5

18"

48.5'

Max. \*  
D.D.-27.0  
175 G.P.M.

21.5'

83'-6"  
Layers Shell Rock & Sand

10' Screen

8"

20'

5' Screen

15'

5' Screen

18'-0"  
Salt And  
Pepper Sand

20'

5' Screen

10'-0"  
Soft  
Rock

5'



5' Screen

Conc. Plug


5'

5' Screen

D.T.A. WELL NO. 2

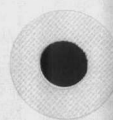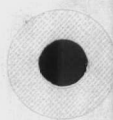



 

Perless Pump 10 HP.


WELL  
3

603





250 G.P.M. — DUAL DRIVE — 10 H.P.  
 236 " " " actual. D.D.-397

26.64 (Nov. 13/51)

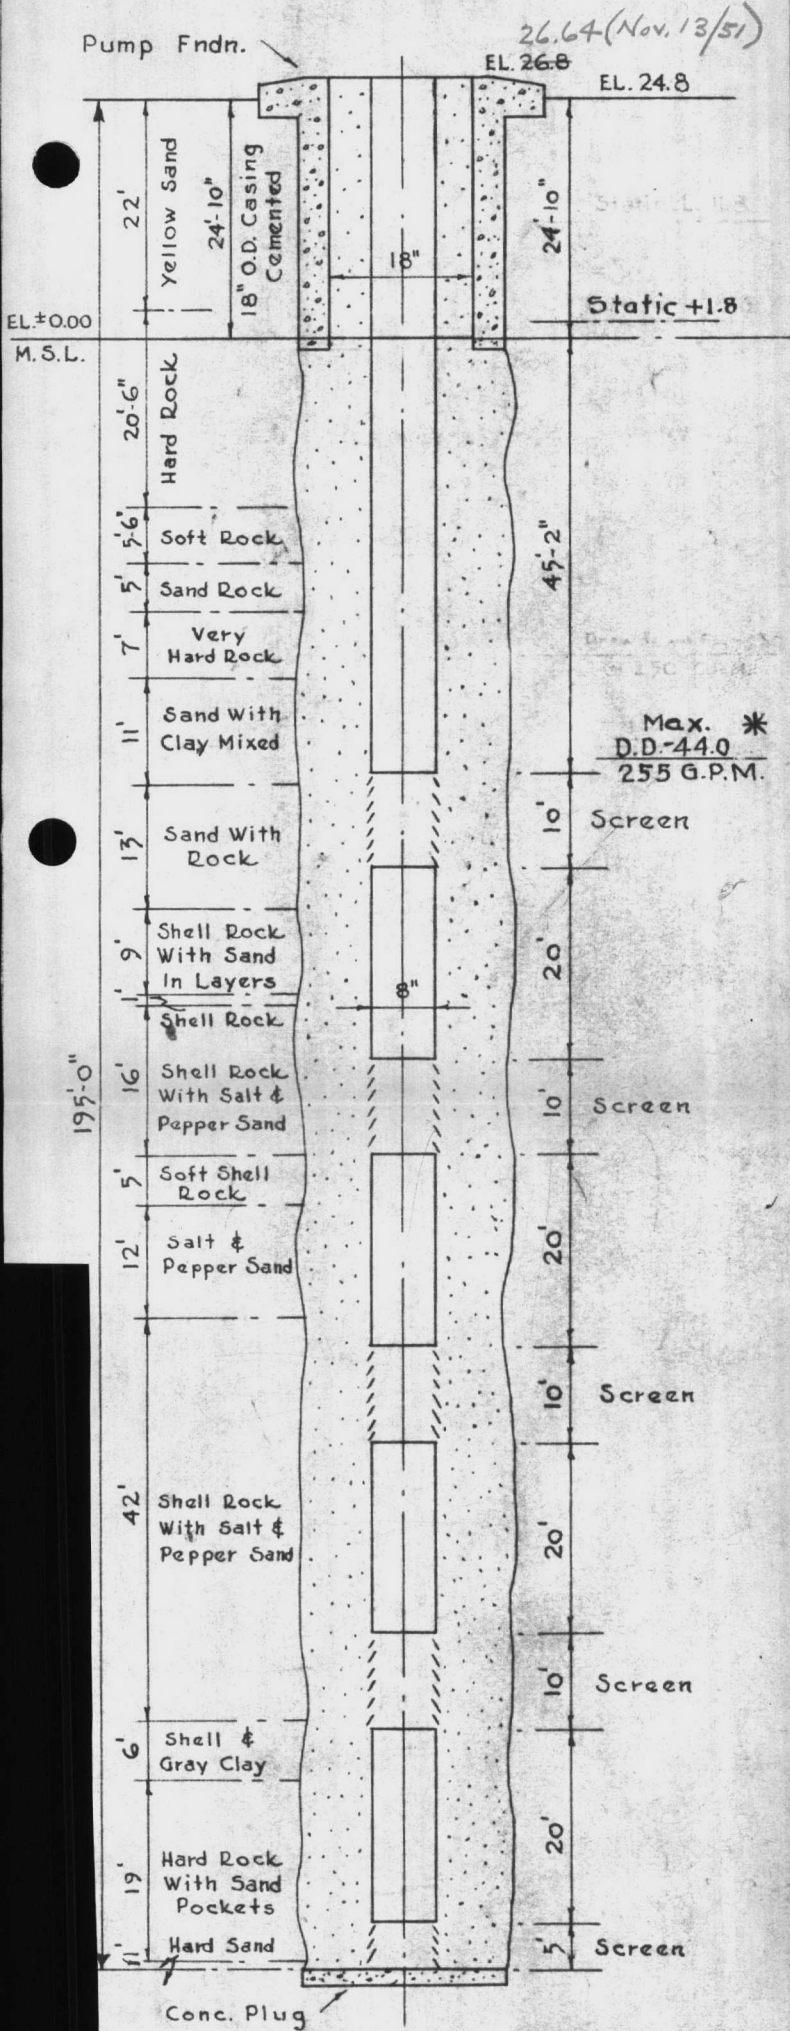


D.T.A. WELL No. 3

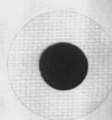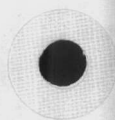







 


WELL  
4

604





150 G.P.M. - SINGLE DRIVE - 7 1/2 H.P.  
 160 " " " actual. D.D.-25.0

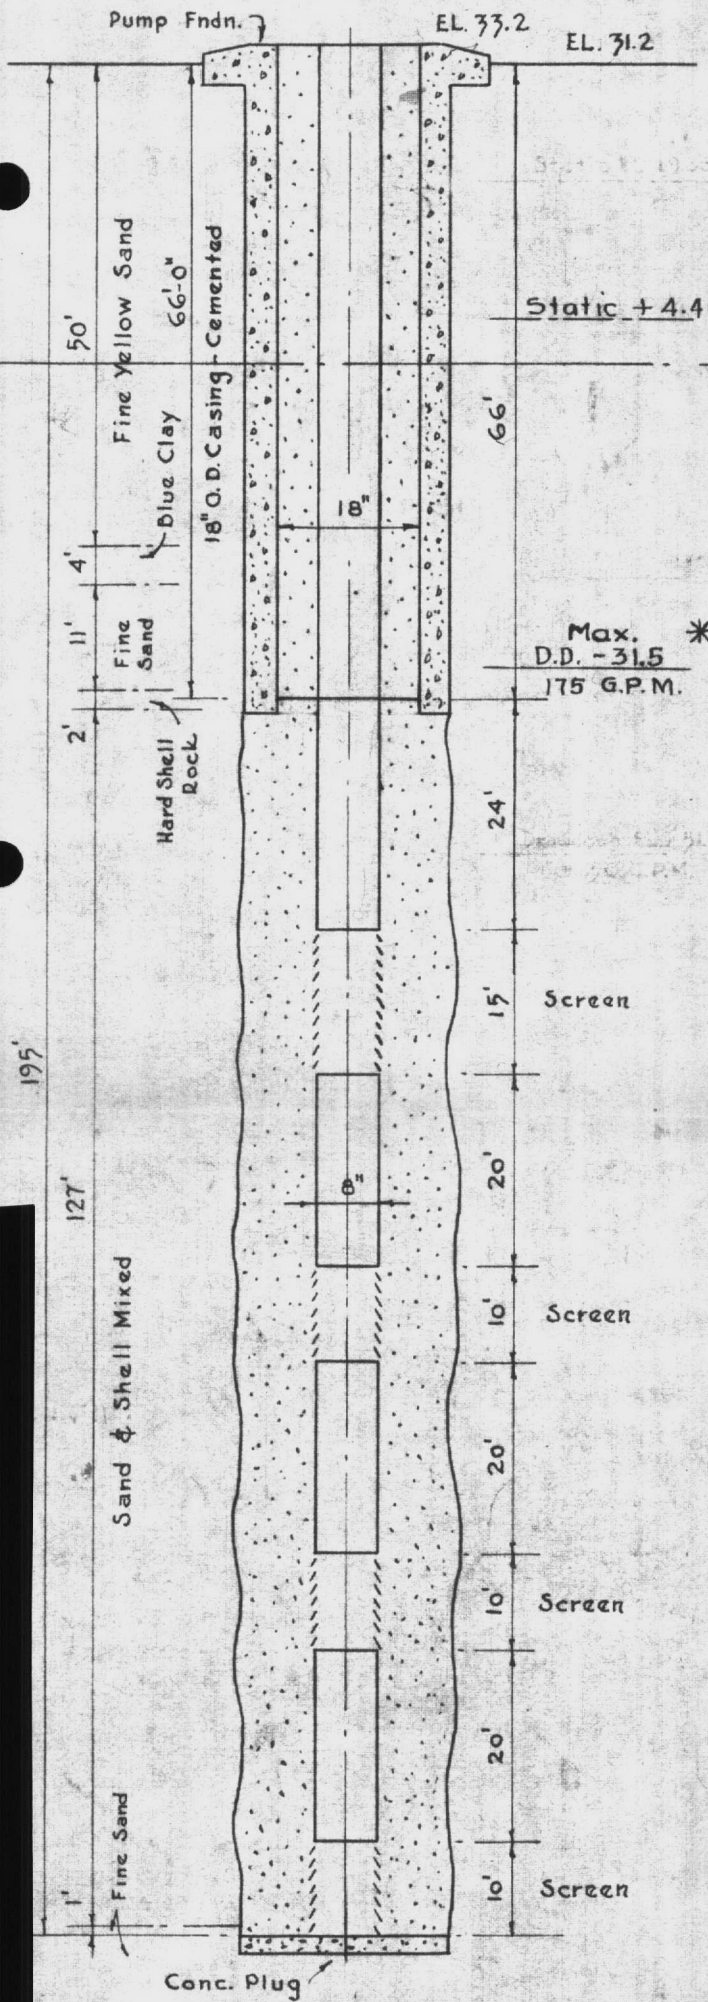


195'


D.T.A. WELL No. 4

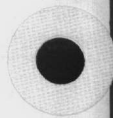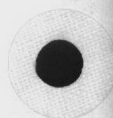



 




 



WELL  
5




250 G.P.M. - SINGLE DRIVE - 10 H.P.  
 270 " " " actual. D.D.-18.0

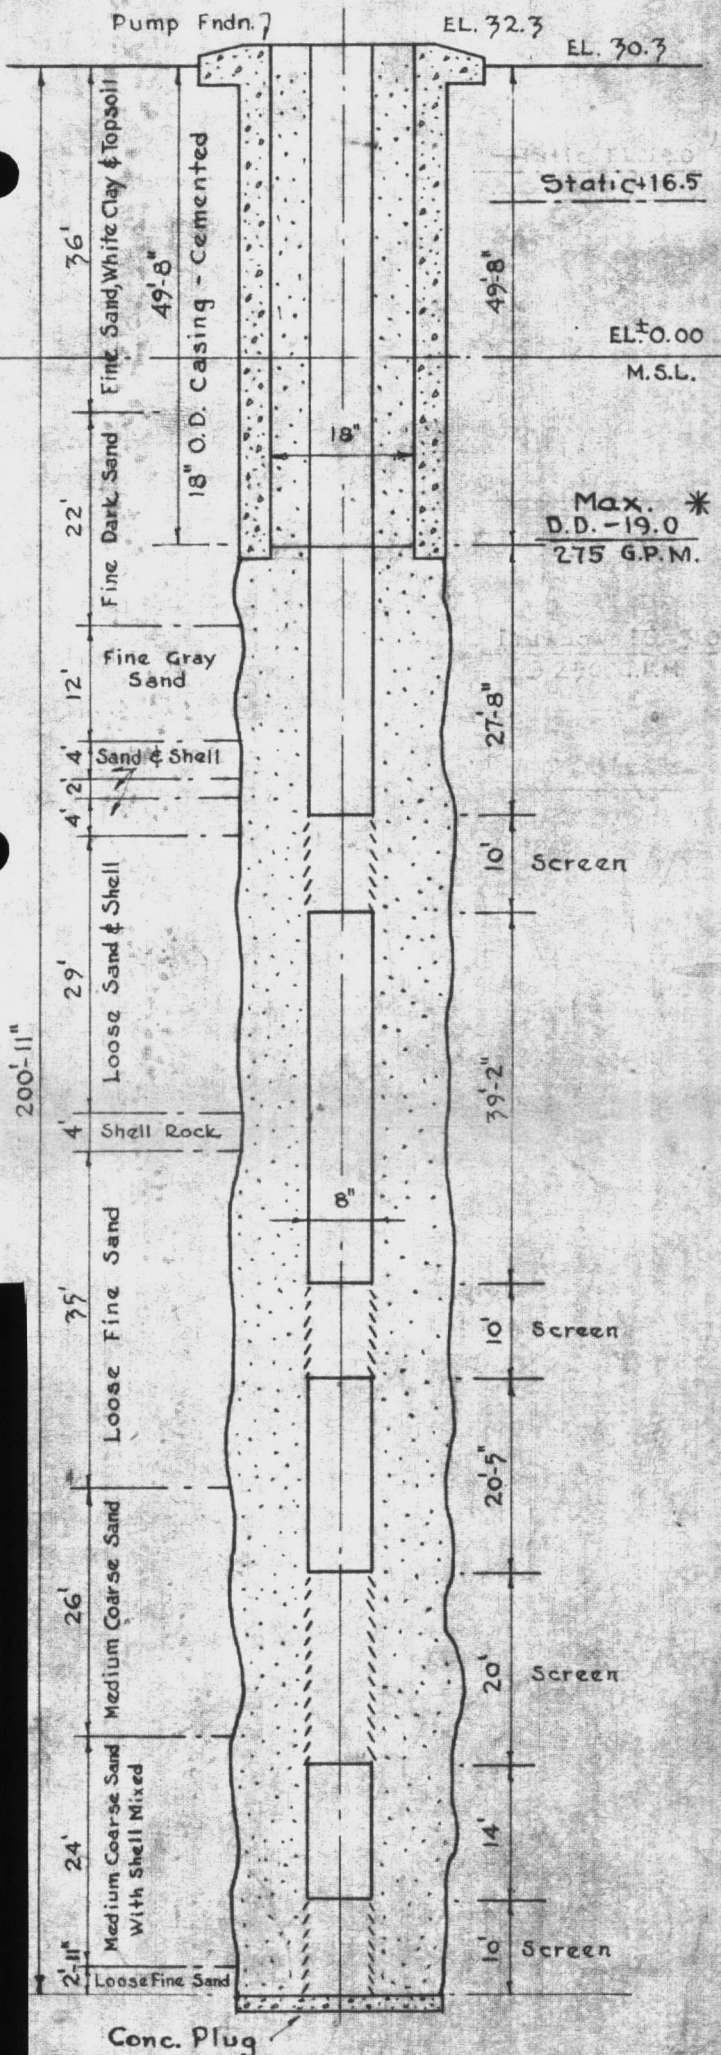


D.T.A. WELL No. 5

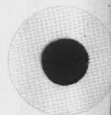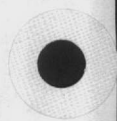



 

 

WELL  
6





200 G.P.M. - SINGLE DRIVE - 7½ H.P.  
 224 " " " actual. D.D. - 13.4  
 Pump Fdn. 7 EL. 34.4

EL. 32.4

70' Fine White Sand  
 27'-8" 18" O.D. Casing Cemented

Static +16.7

EL. ±0.00  
 M.S.L.

10' Med. Coarse Sand

9' Fine Gray Sand

16' Shell Rock

Max. \*  
 D.D. - 25.5  
 275 G.P.M.

8' Sand & Shell Hard Rock

8' Sand & Shell

5' Shell Rock

10' Screen

18' Shell Rock, Sand & Clay

9' Shell & Sand

10' Screen

17' Shell & Sand

4' Shell Rock

5' Soft Shell

10' Screen

20' Soft Shell Rock With Salt & Pepper Sand

5' Salt & Pepper Sand

9' Hard Rock

10' Screen

8' Hard & Soft Shell Rock

14' Soft Rock

8' Sand

6' Salt & Pepper Sand

10' Screen

Conc. Plug

D.T.A. WELL No. 6

210'

70'-8" Air Line

8"

56'-4"

10'

20'

10'

20'

5'

20'

5'



9'

8'


14'


8'

6'

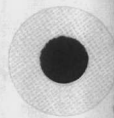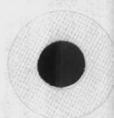



 

 


WELL  
7

60  
31


2.31  
4  
9.24

607

200 G.P.M. - SING DRIVE - 7 1/2 H.P.  
 186 " " actual. D.D. - 22.5

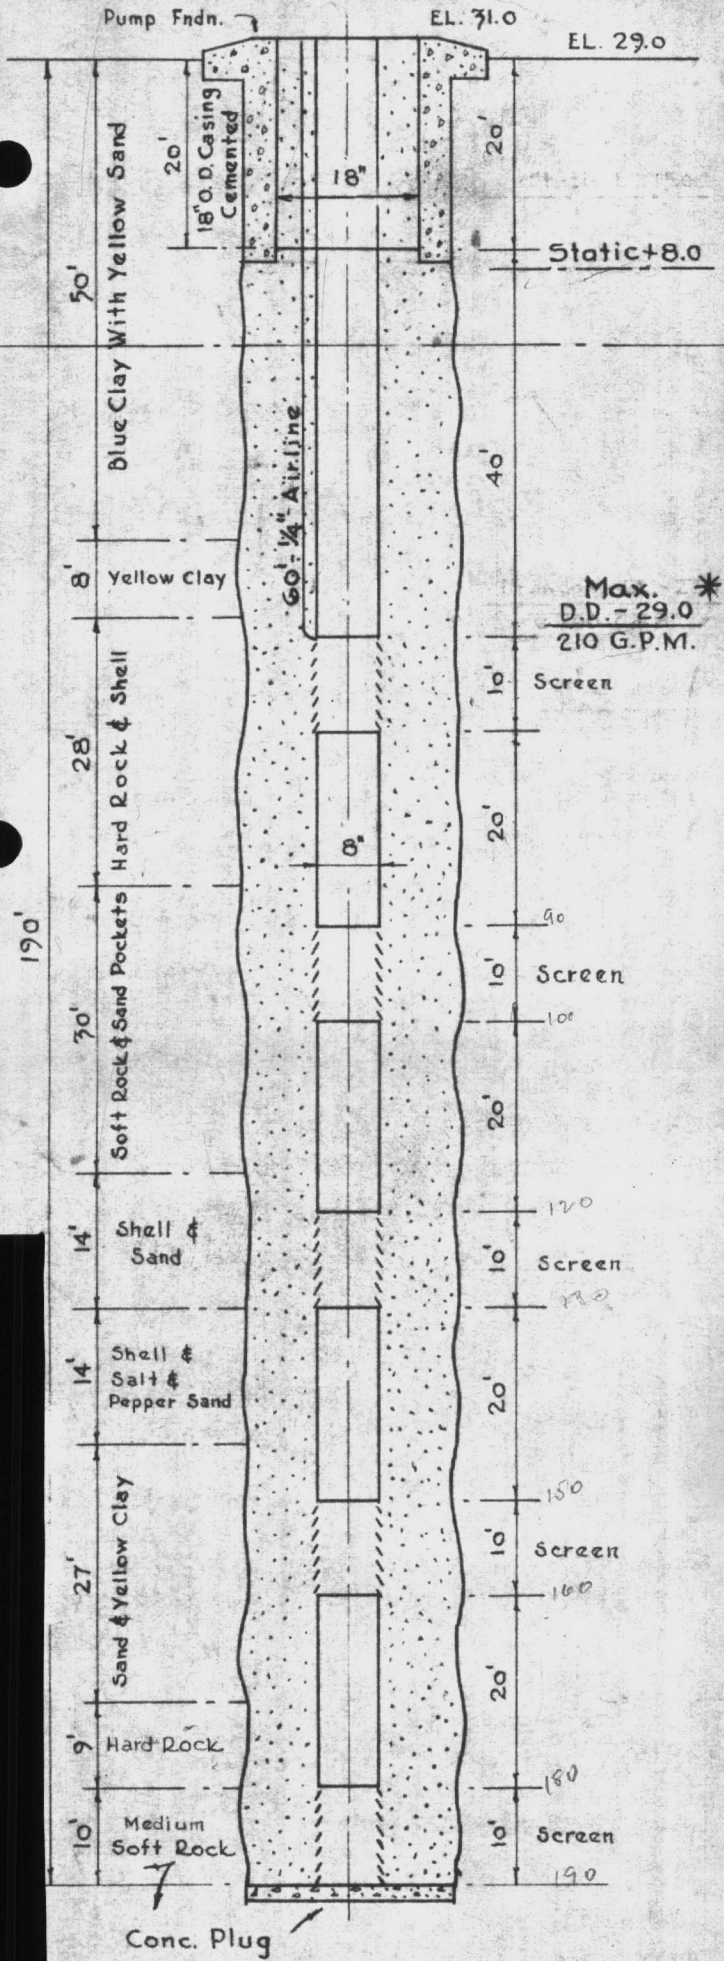



D.T.A. WELL No. 7

 





 


 



WELL  
8

608


250 G.P.M. - DUAL DRIVE - 7 1/2 H.P.  
 250 " " " actual. D.D.-22.0

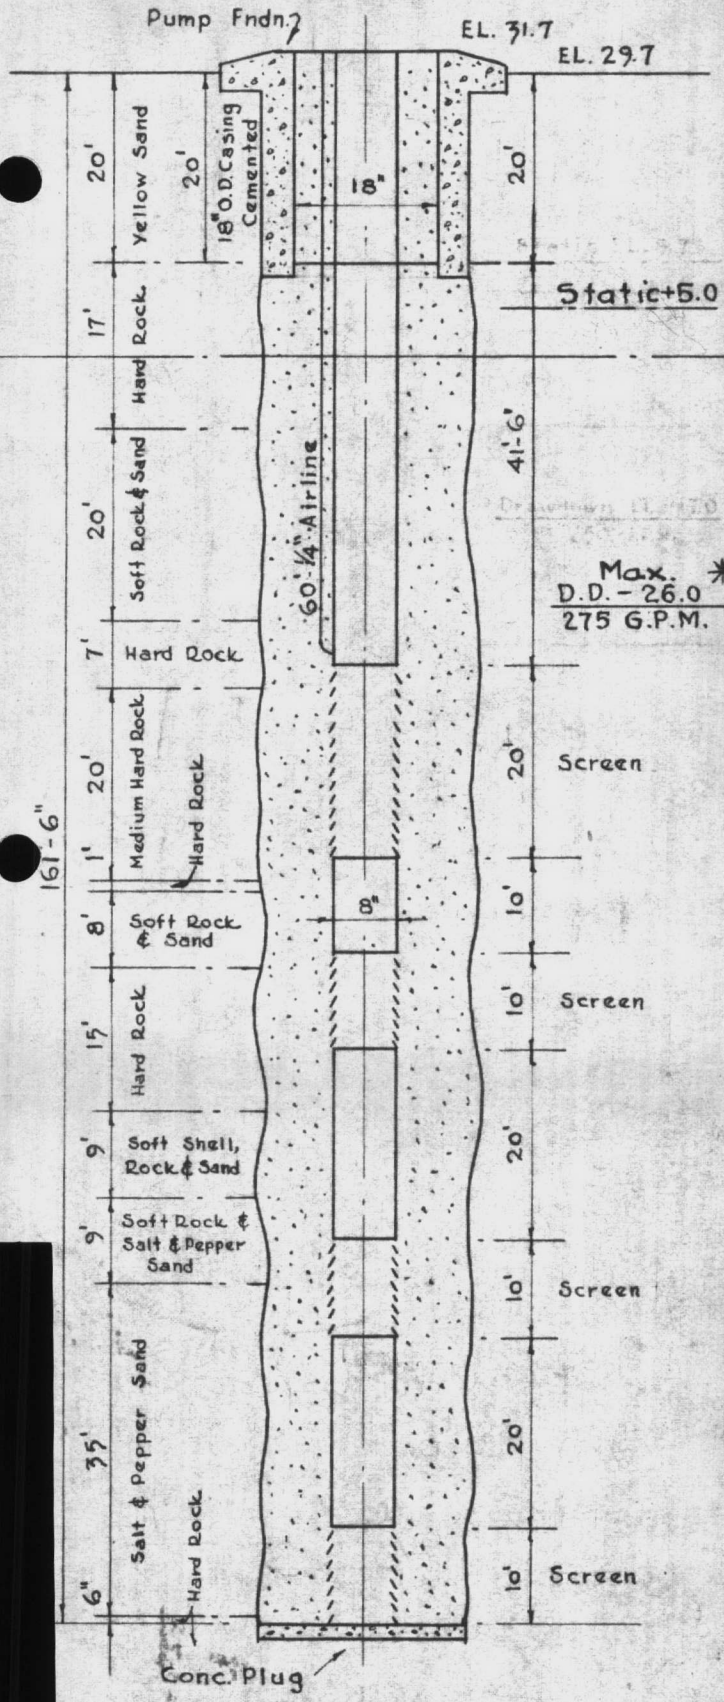


D.T.A. WELL No. 8

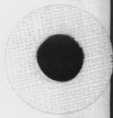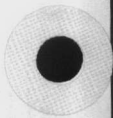



 





 


WELL  
9


609


200 G.P.M. - SINGLE DRIVE - 7½ H.P.  
 200 " " " actual. D.D. - 19.7

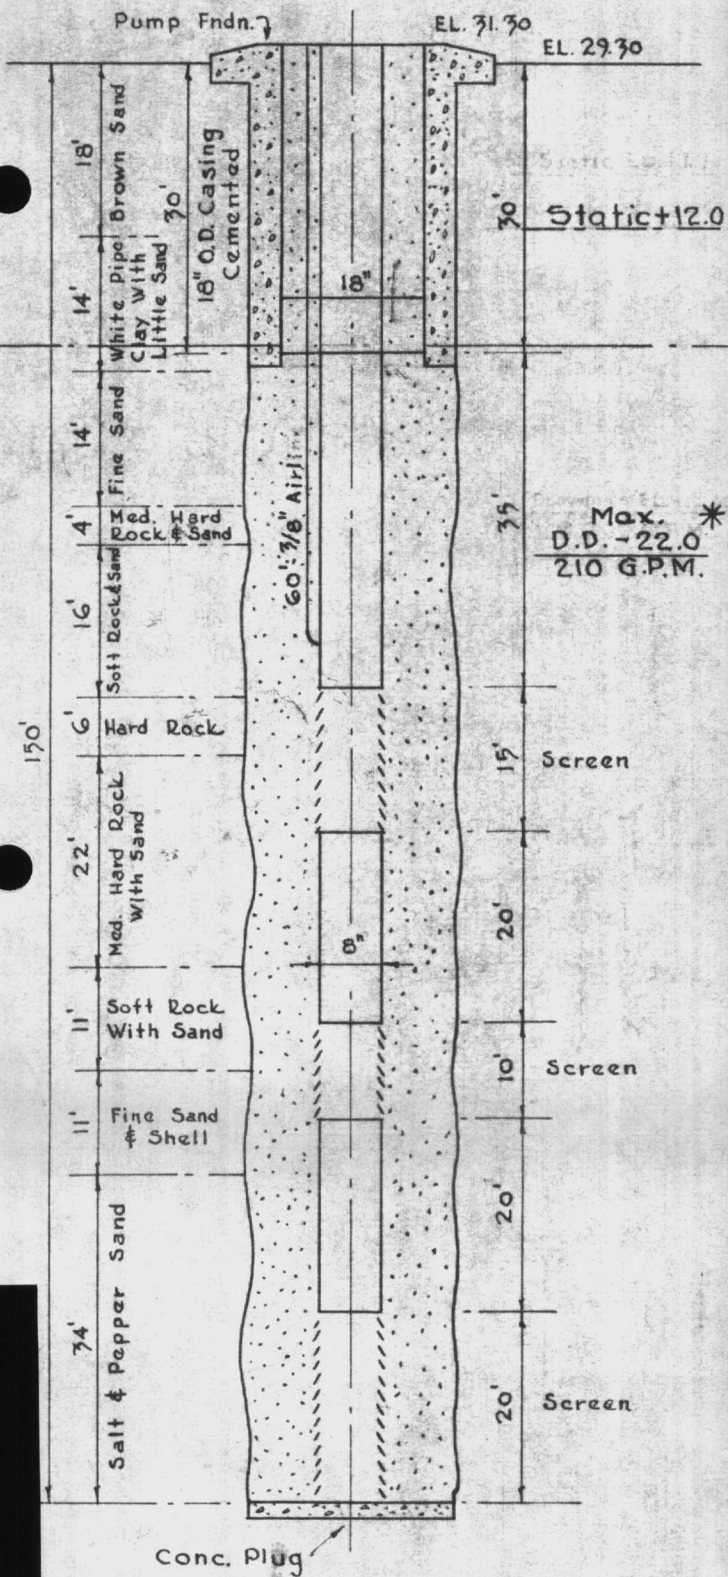

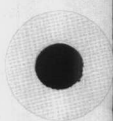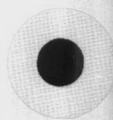



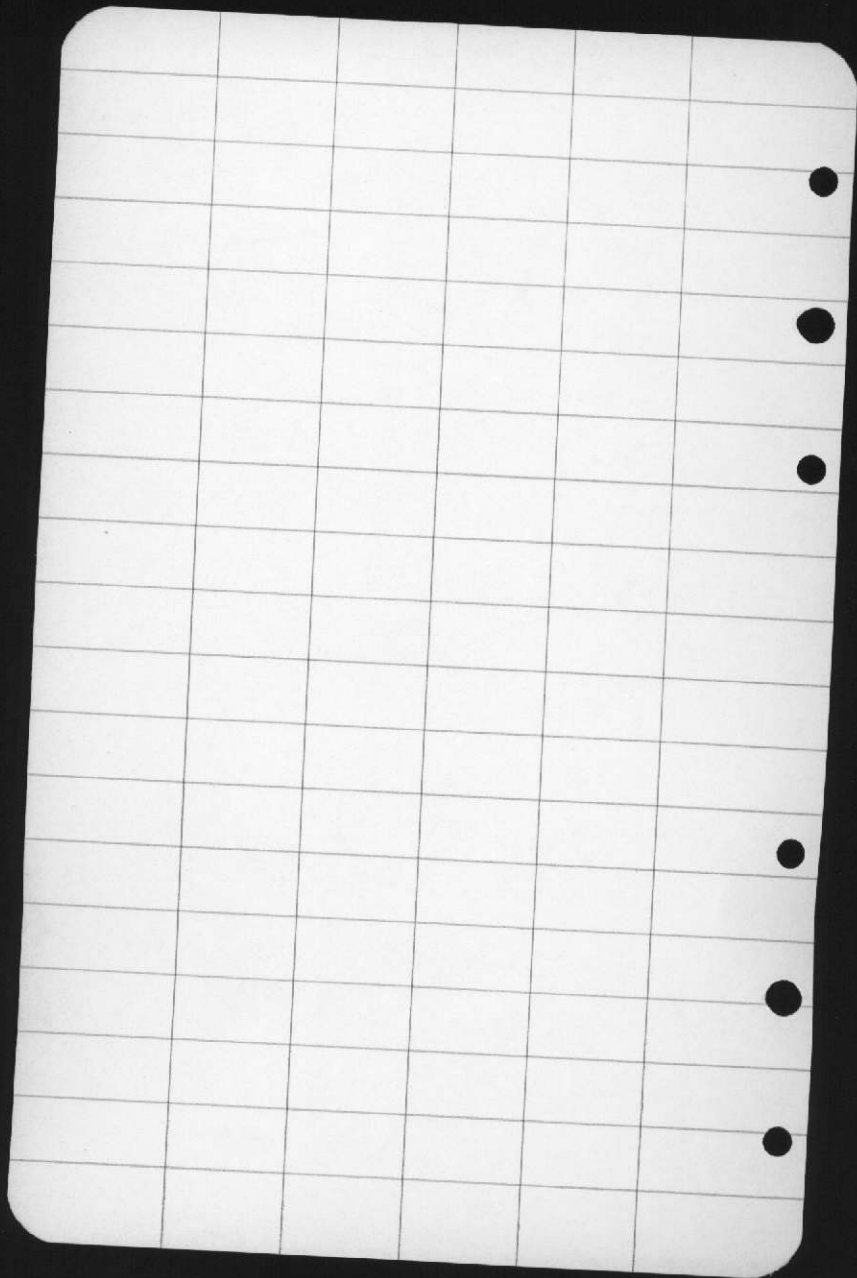

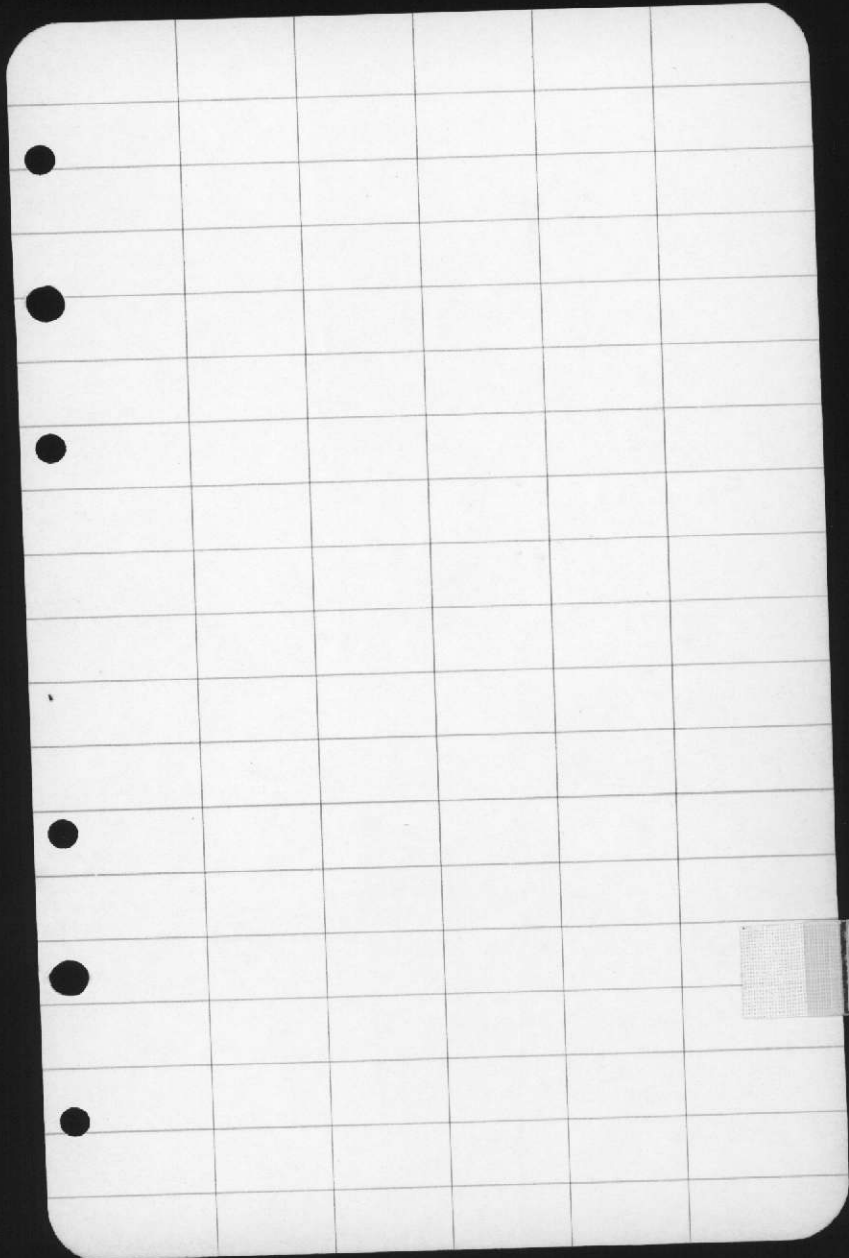


Well  
10


610




250 G.P.M. - DUAL DRIVE - 7 1/2 H.P.  
 260 " " actual. D.D.-11.6

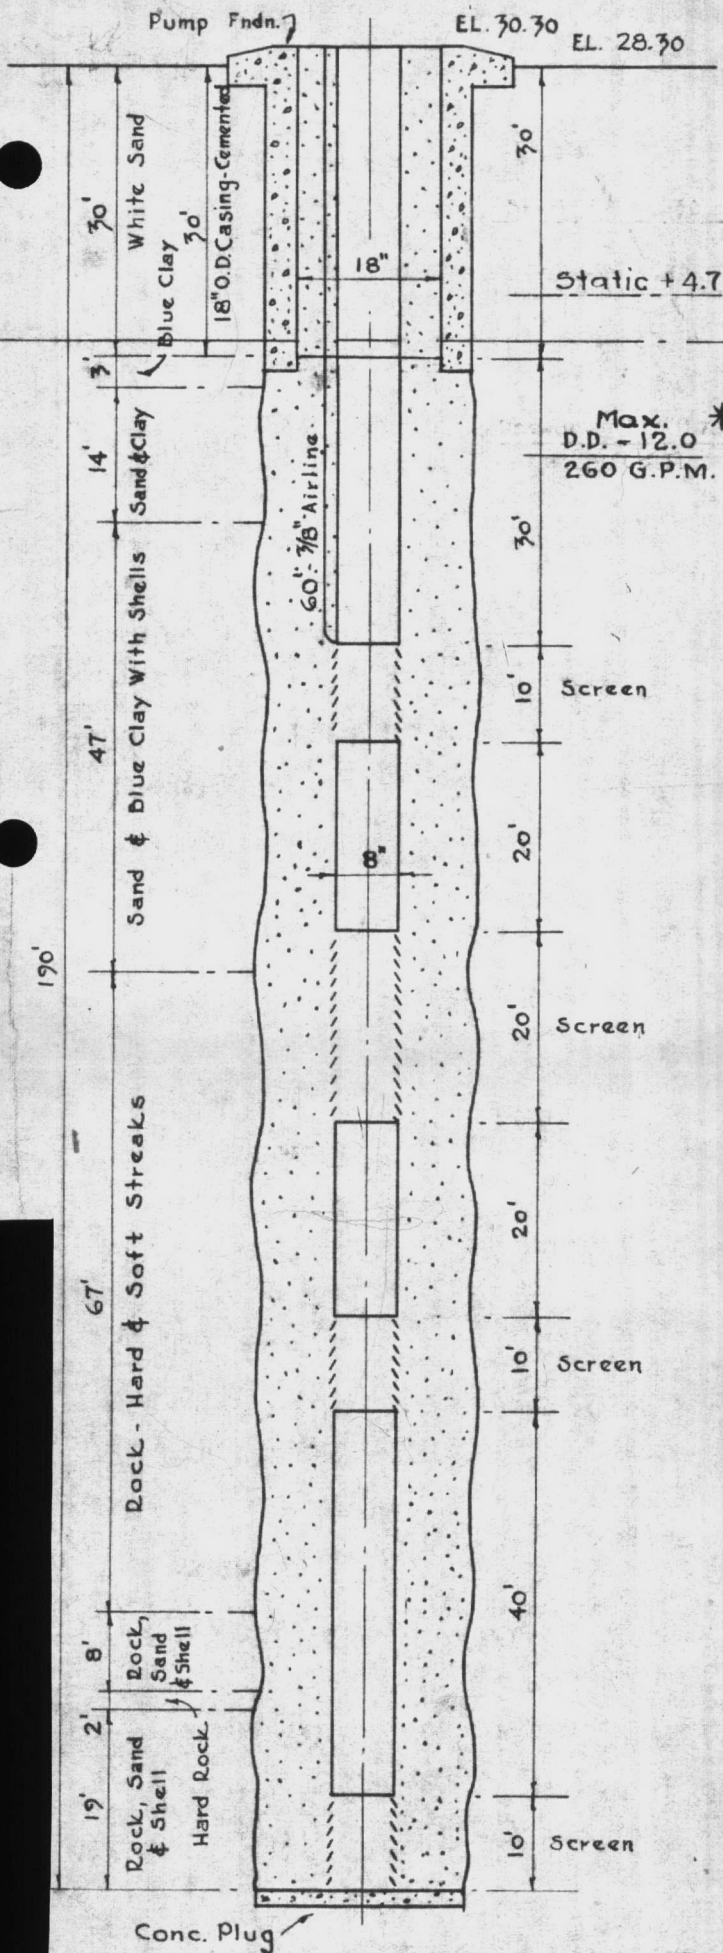

D.T.A. WELL No. 10

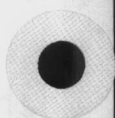


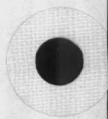



#10	Date	GPM	Drawn D. Elev.	Static Elev.	Recovery	Yield gal/fl.O.D.
	1941	250	-7.2	+12.3	3 min. +10	12.82
	1944	265	-12.0	-		
	1949	215	-21.5	-1.0	6 min -4.0	10.5

April 1953 New Pump Inst. #1386

Sydnor Pump & Well Co.

225 gpm TDH 92 Ft. Jetting 50 ft.

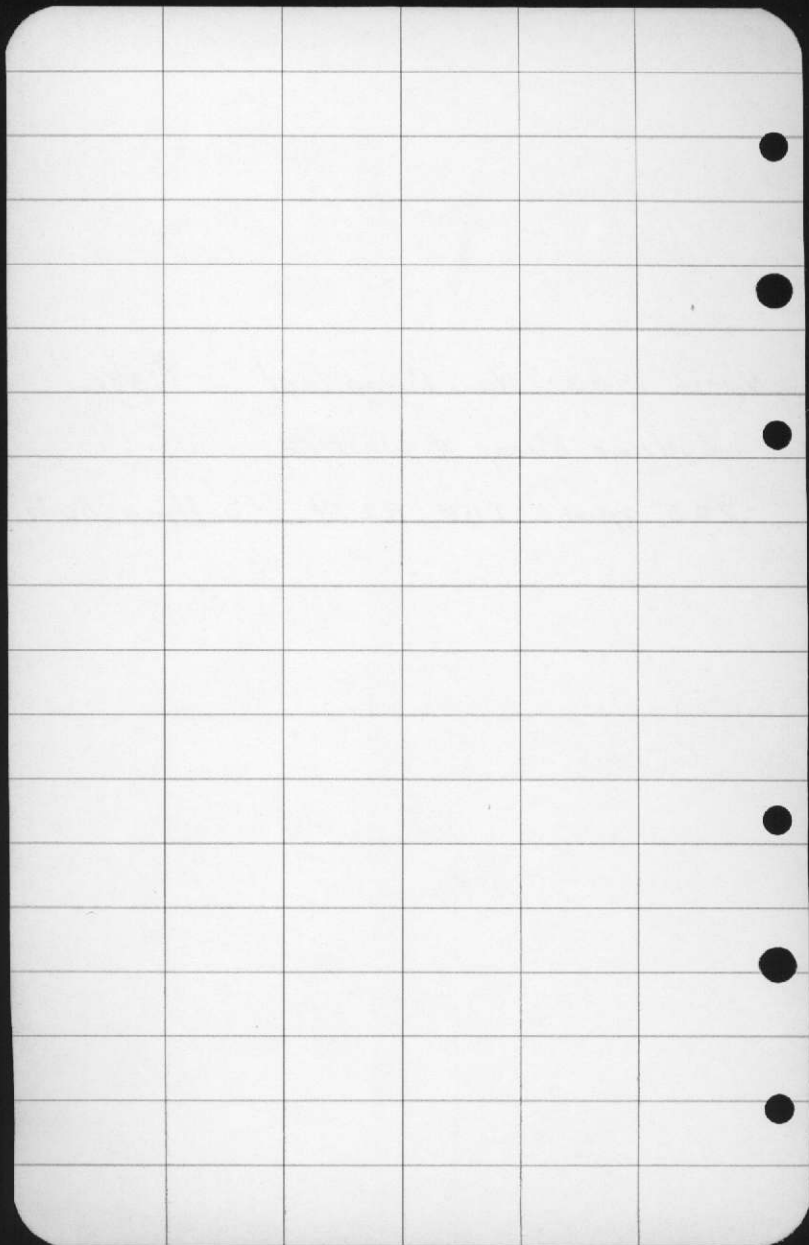

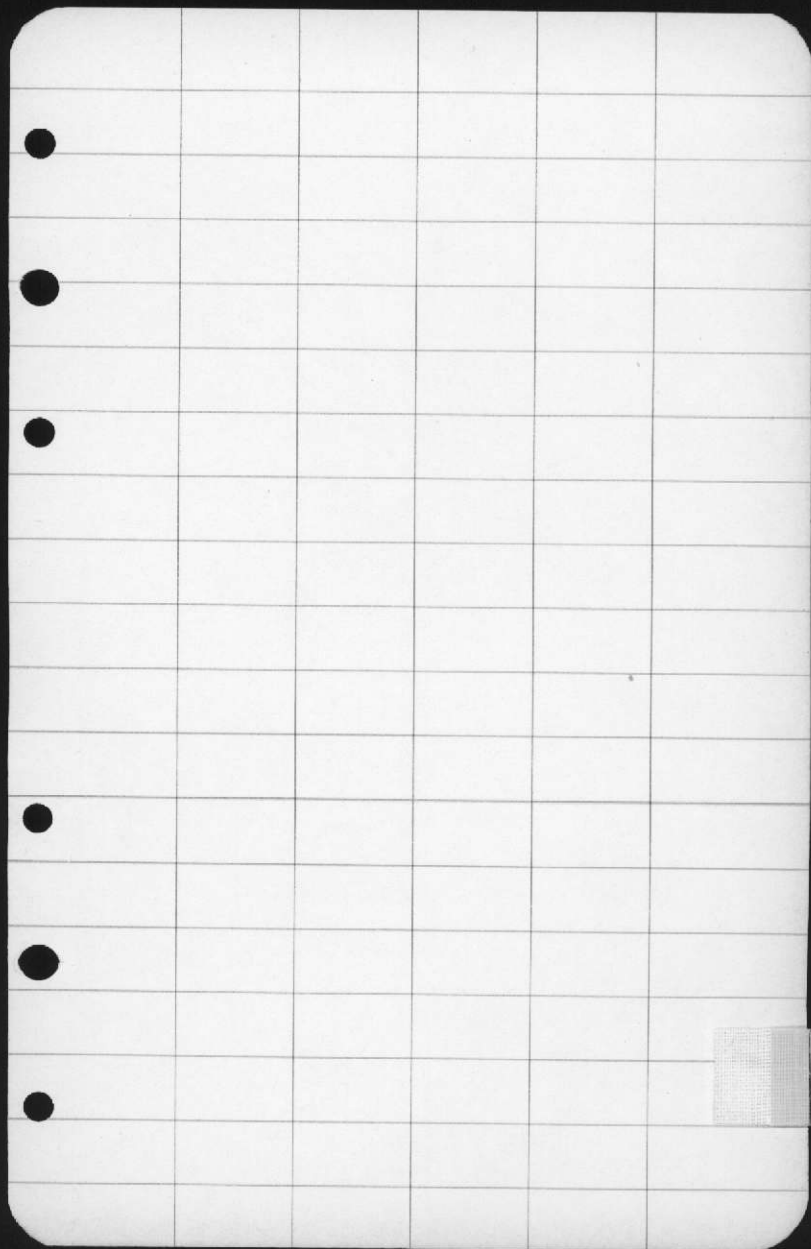

WELL  
11

161  
146  
15

611


250 G.P.M. - SINGLE DRIVE - 10 H.P.

253 " " " actual. D.D. - 8.35

260 " " " " D.D. - 8.90

Pump Fndn.

EL. 33.0  
EL. 31.0

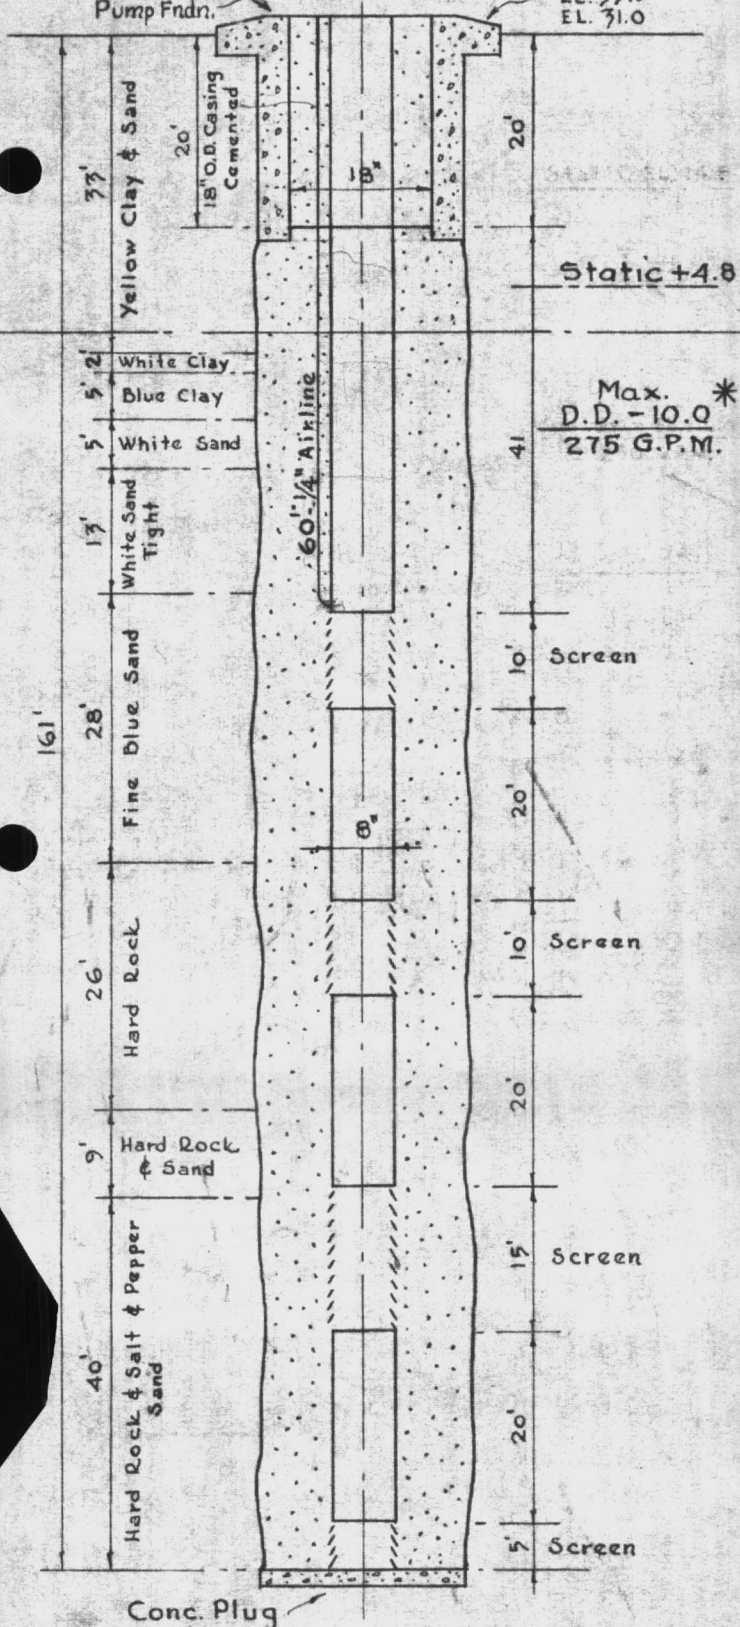



Armco Iron Screen Used In This Well







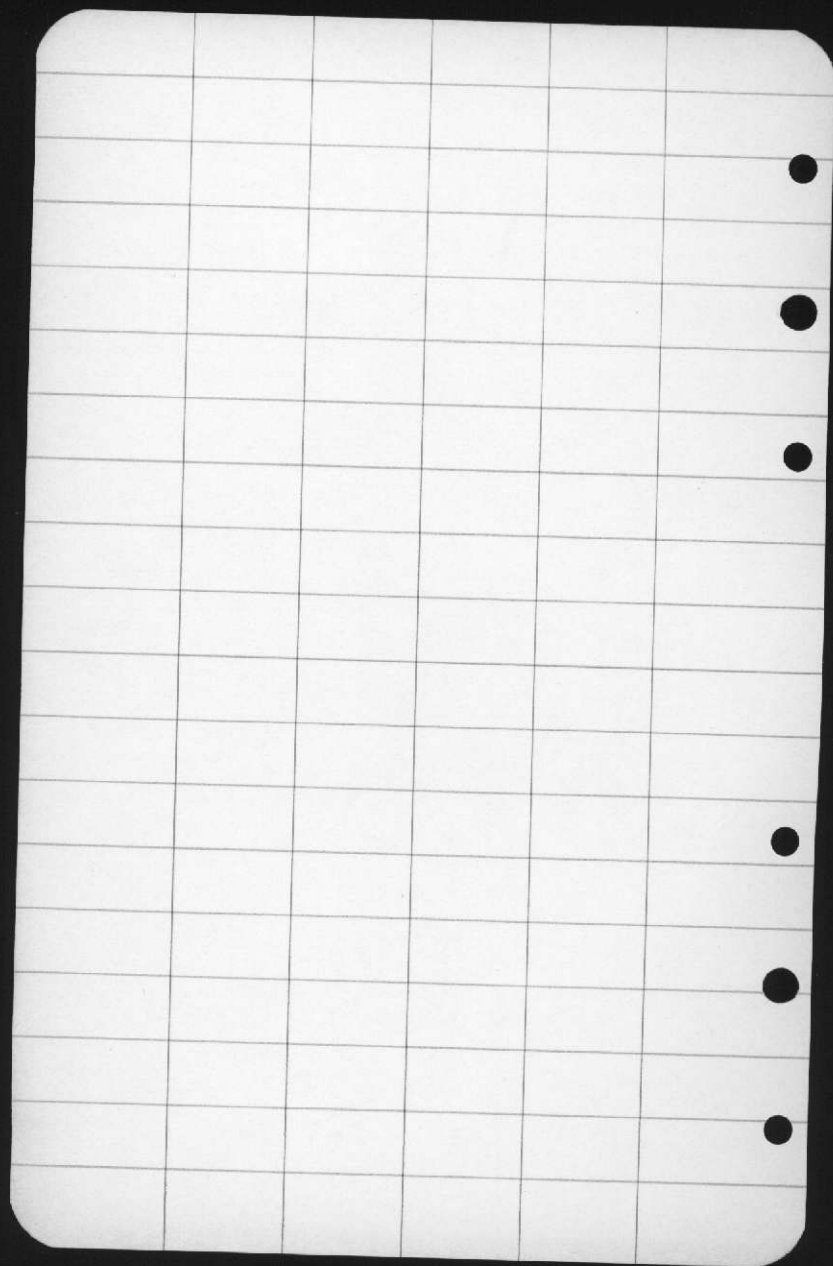


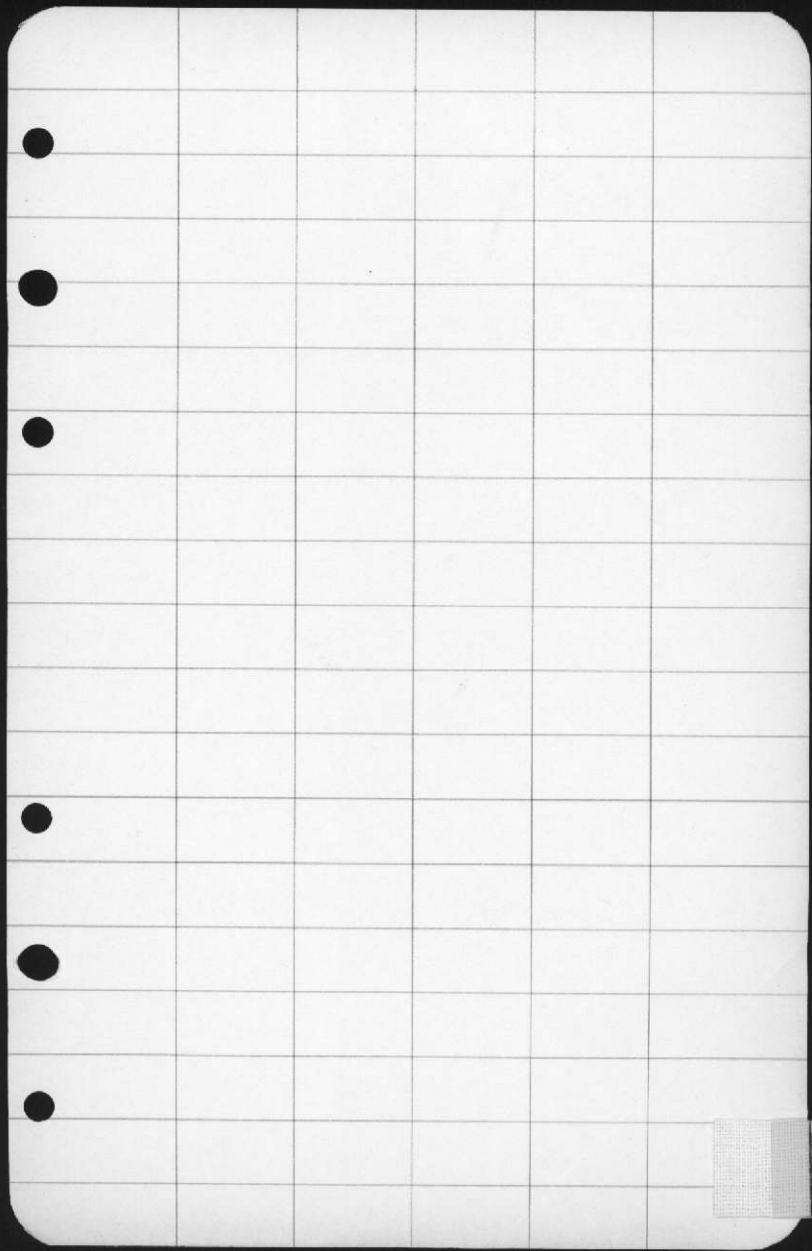



WELL  
12

612


200 G.P.M. - SINGLE DRIVE - 7½ H.P.  
 199 " " " actual. D.D.-79  
 208 " " " " D.D.-84

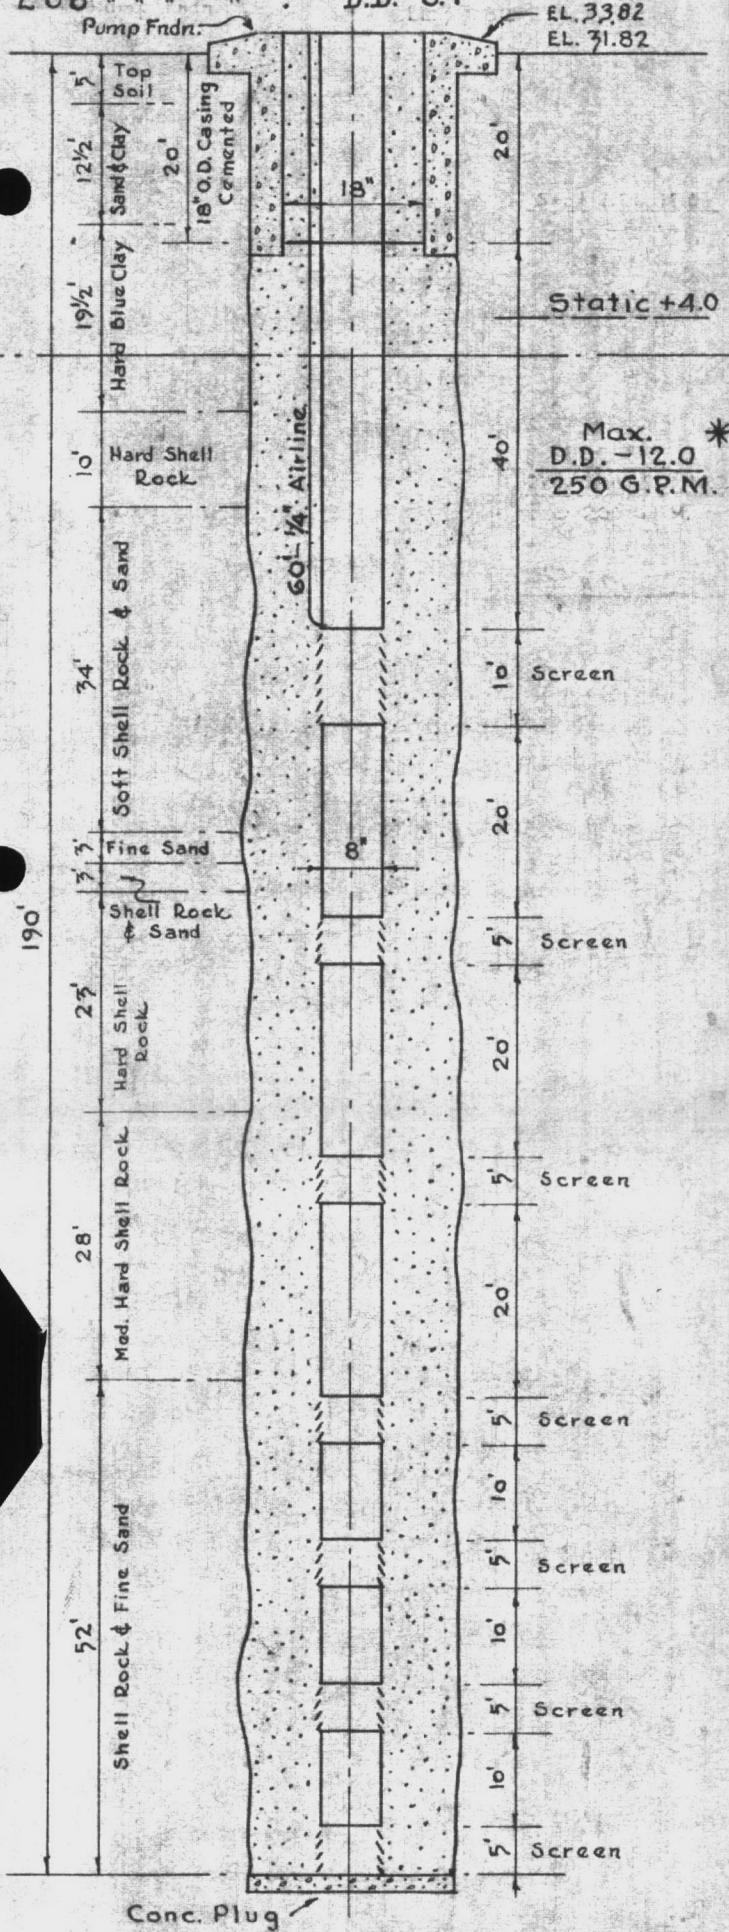


Armco Iron Screen Used In This Well

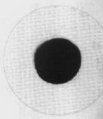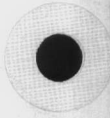



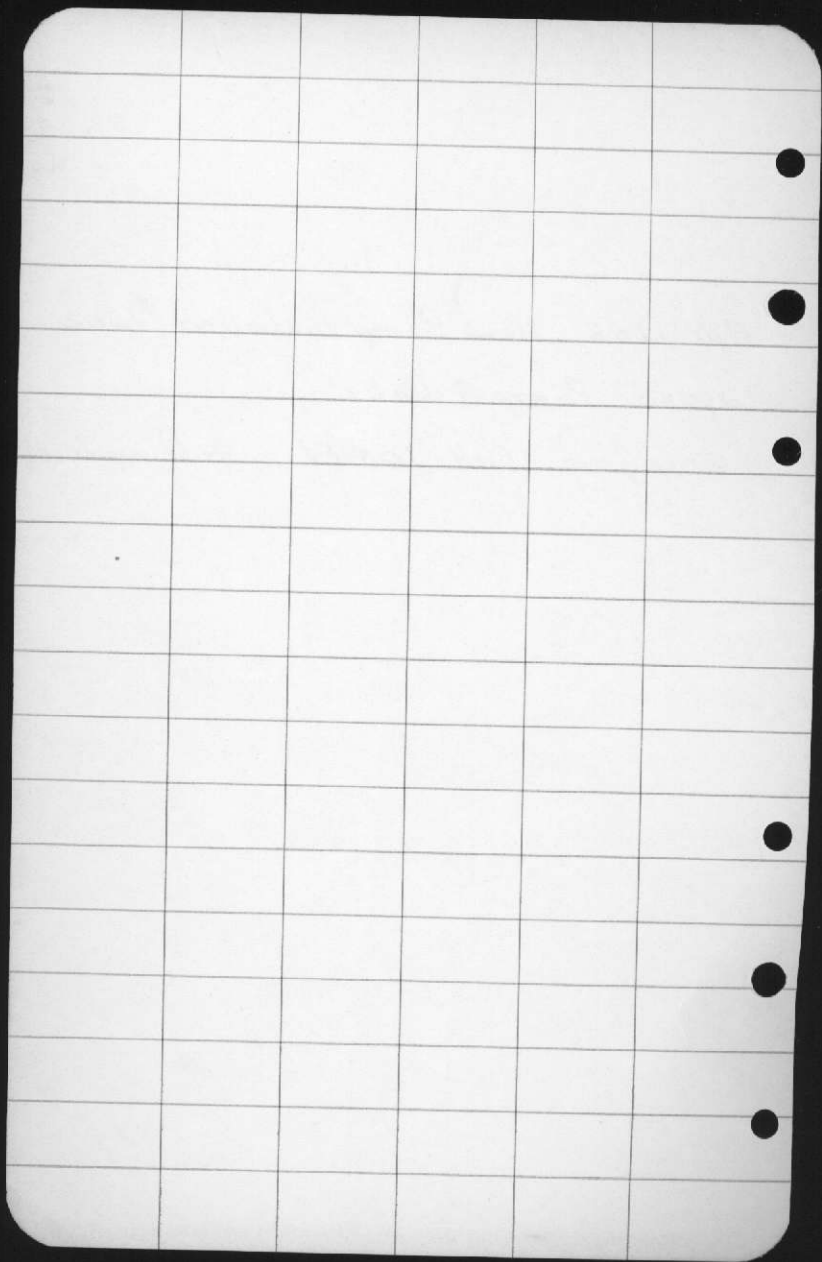




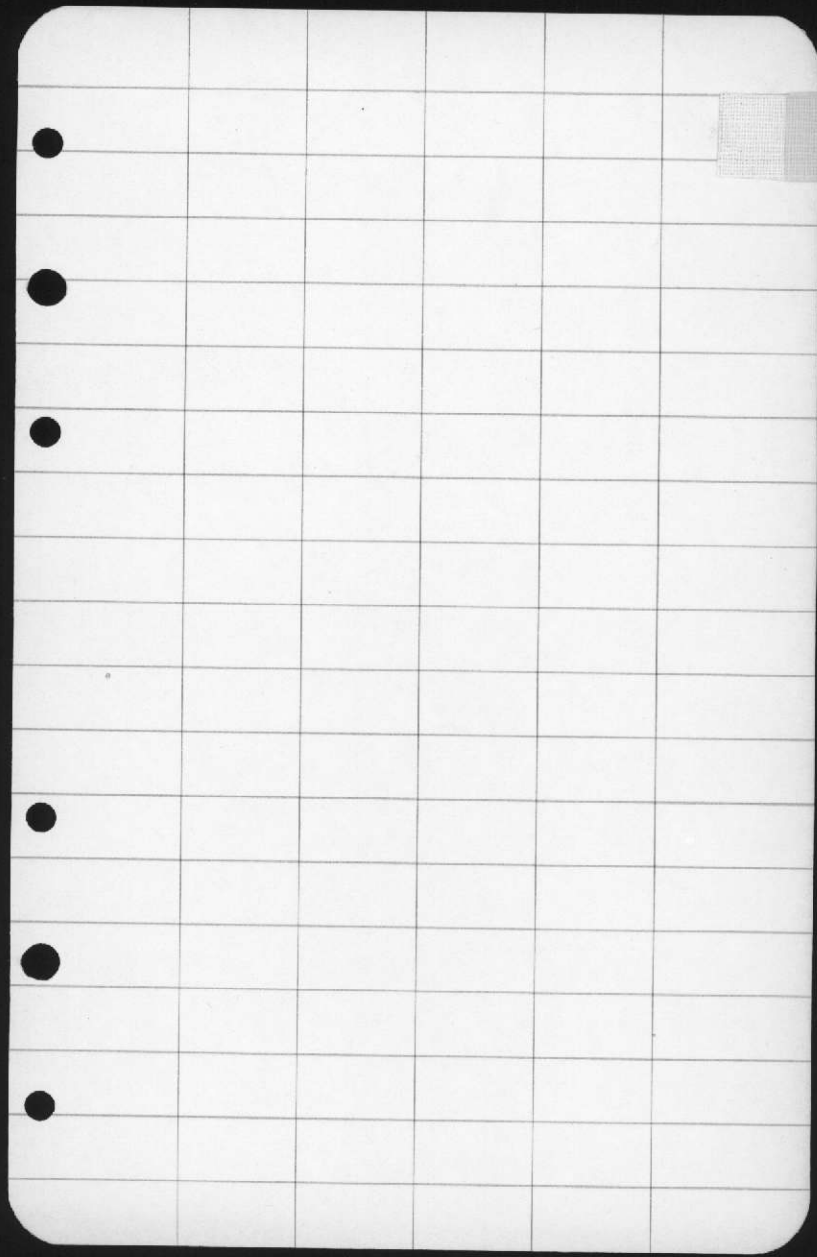

WELL  
13




250 G.P.M. - DUAL DRIVE - 10 H.P.  
 228 " " " actual. D.D. - 14.4  
 242 " " " " . D.D. - 15.9

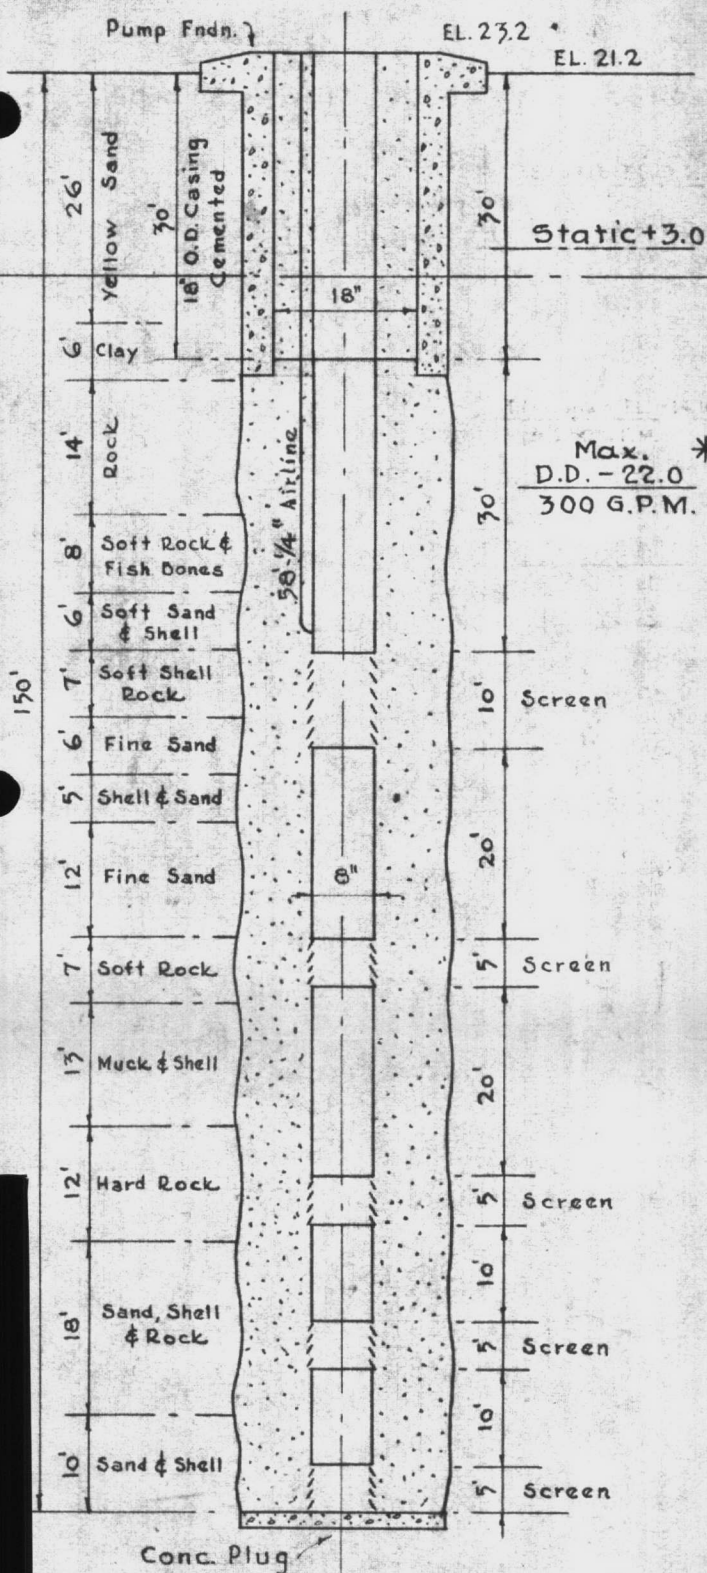


D.T.A. WELL No. 13






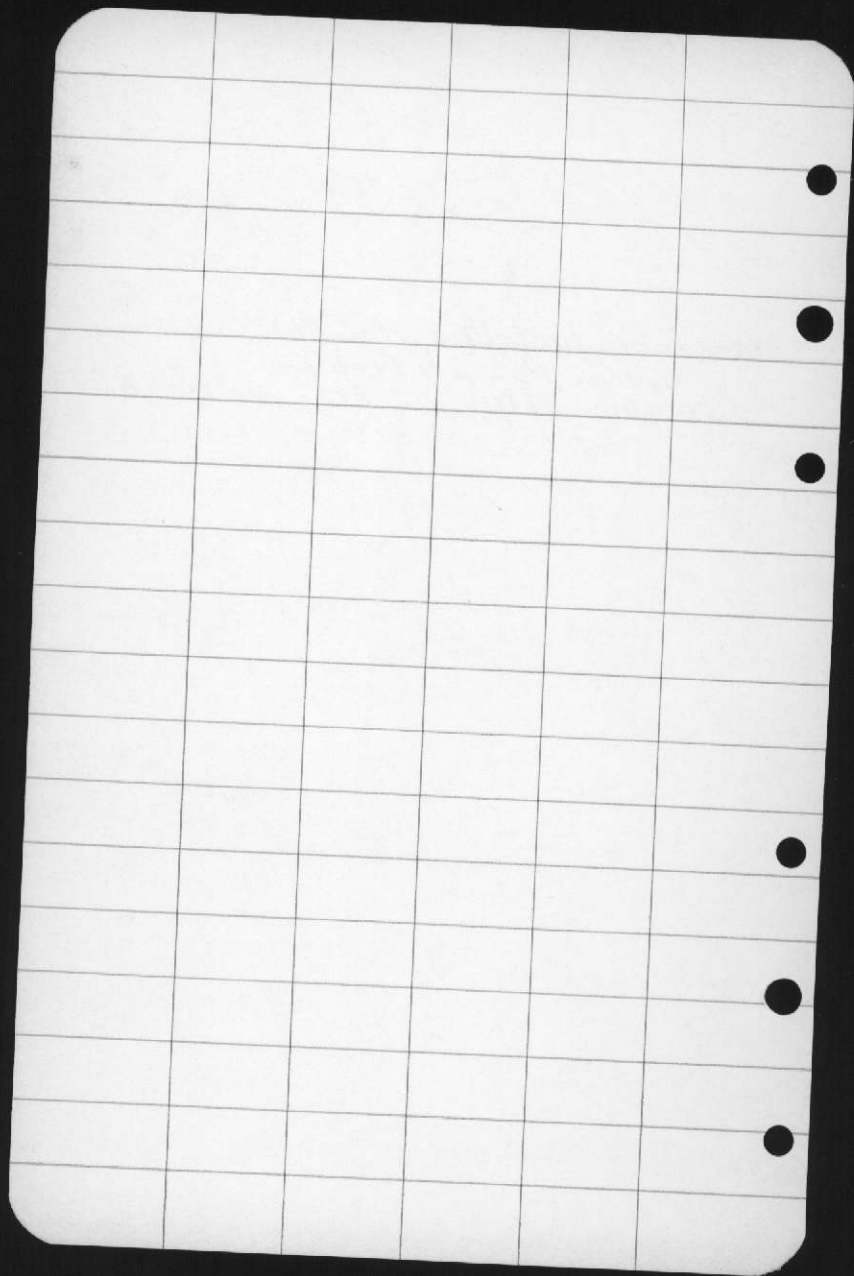

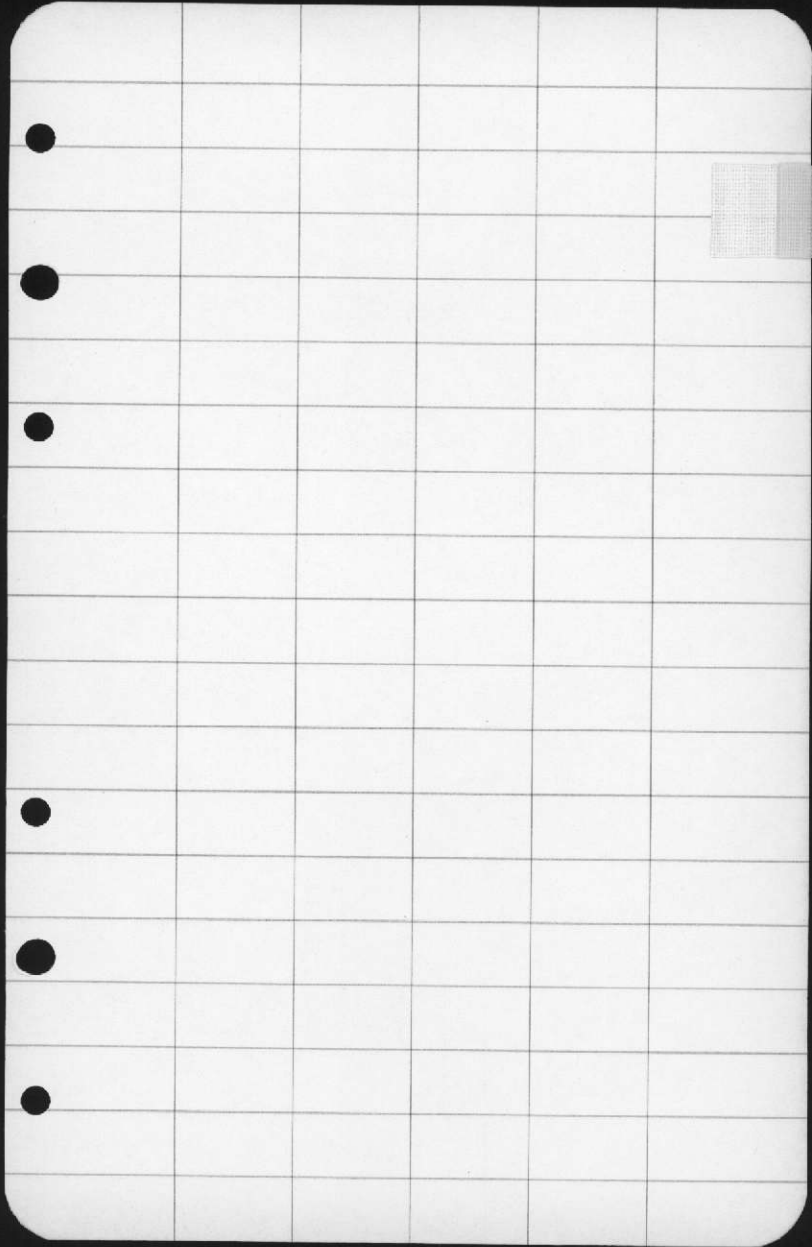

WELL  
14

614

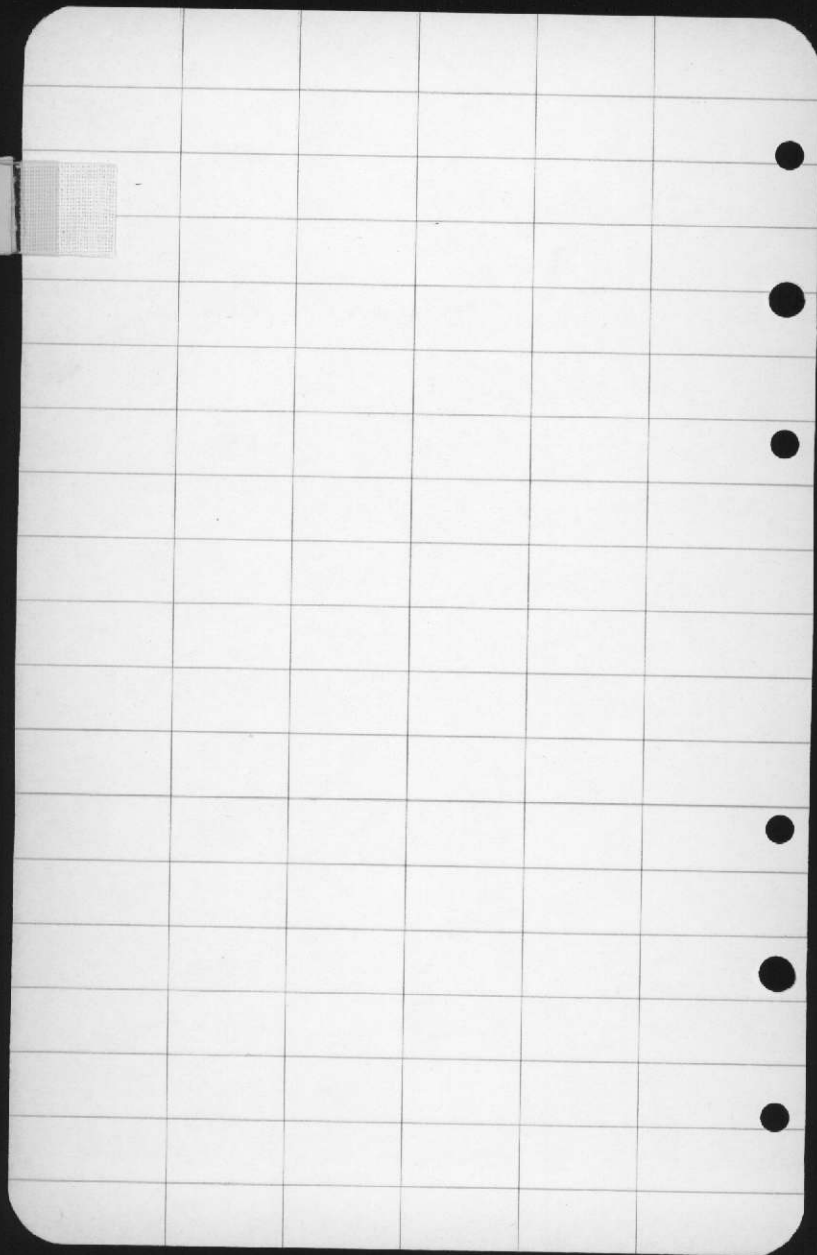




250 G.P.M. - SINGLE DRIVE - 10 H.P.  
 239 " " " actual. D.D.-95

Pump Fndn.

EL. 33.4

EL. 31.4

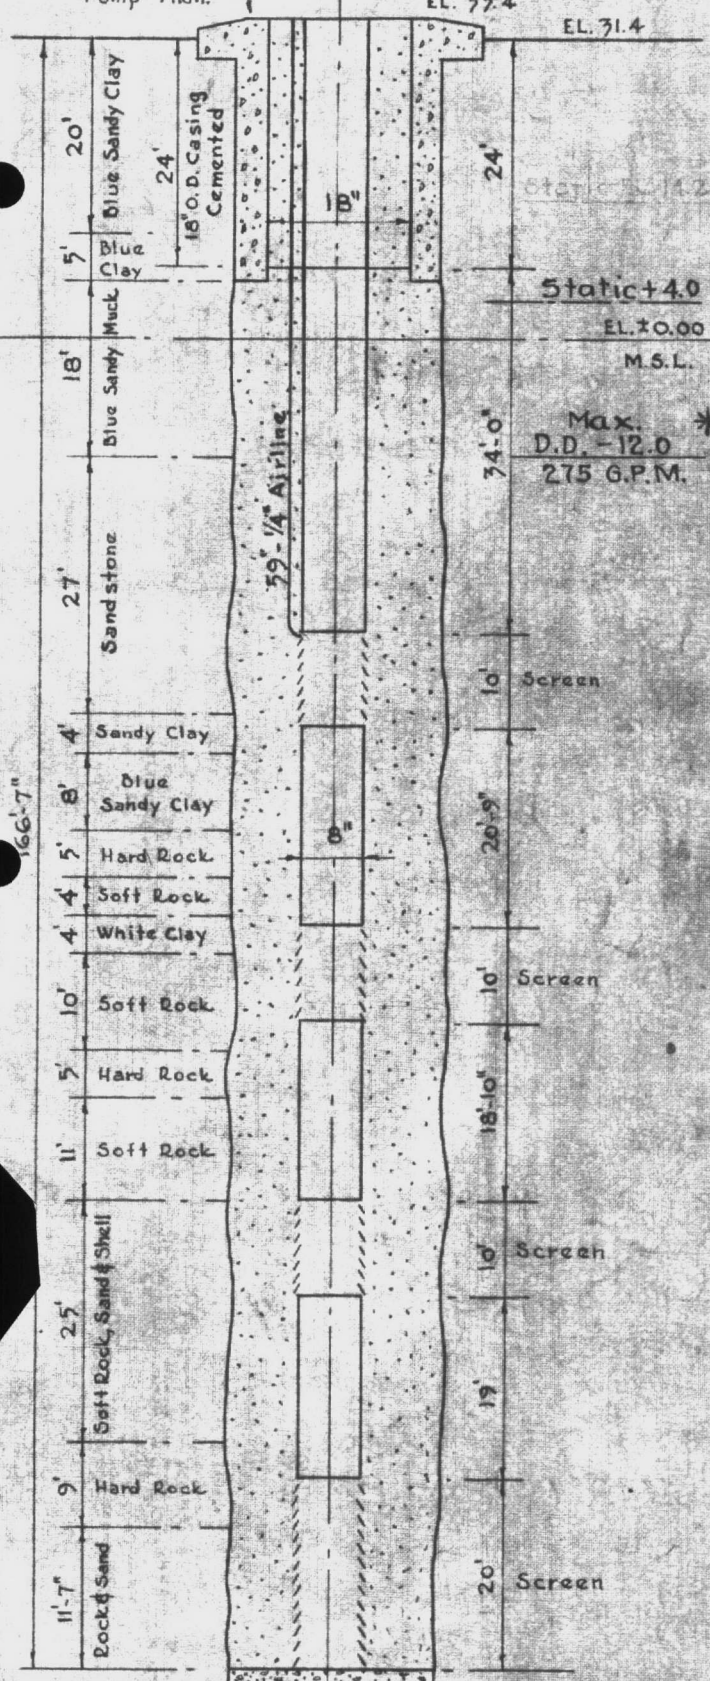


Static +4.0  
 EL. 10.00  
 M.S.L.



Max. D.D. - 12.0 \*  
 275 G.P.M.

166'-7"


Conc. Plug


Armco Iron Screen Used In This Well

D.T.A. WELL NO. 14

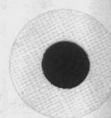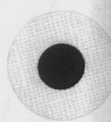



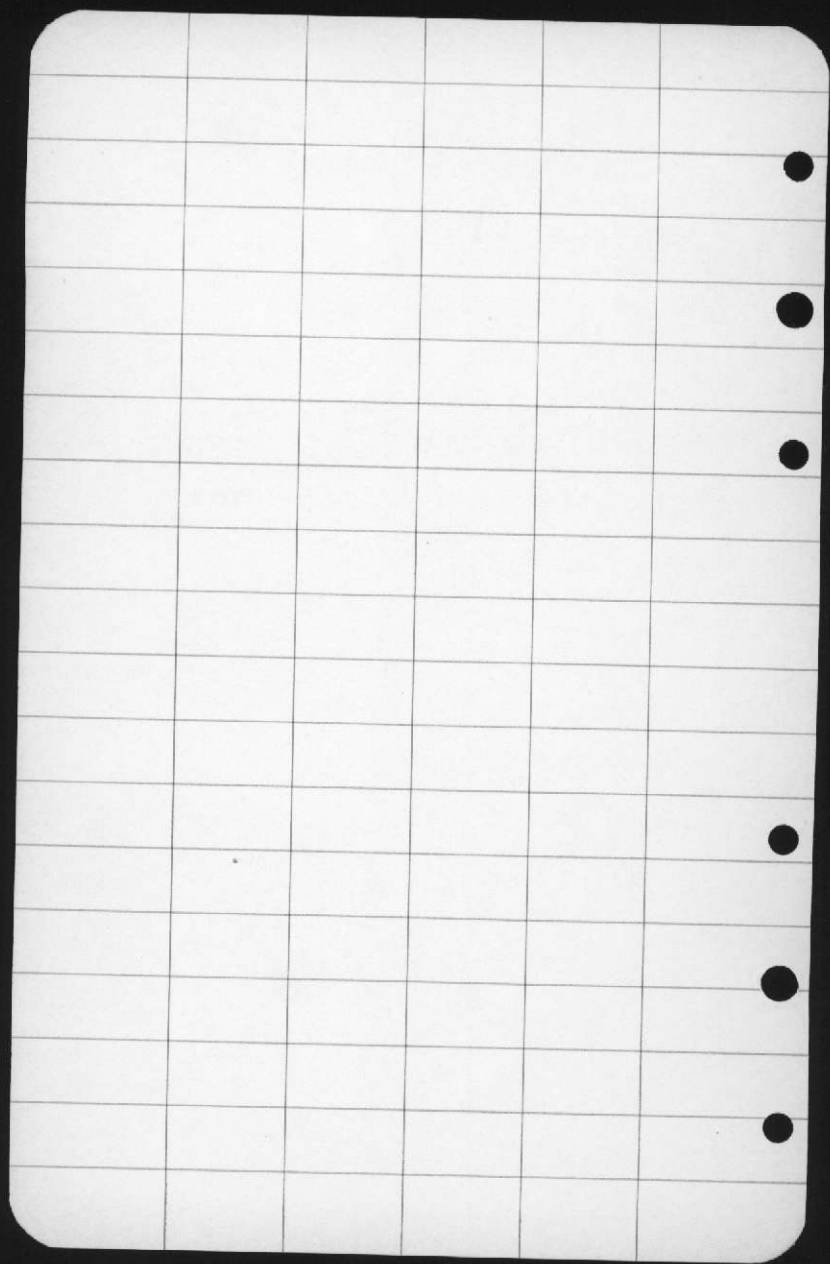

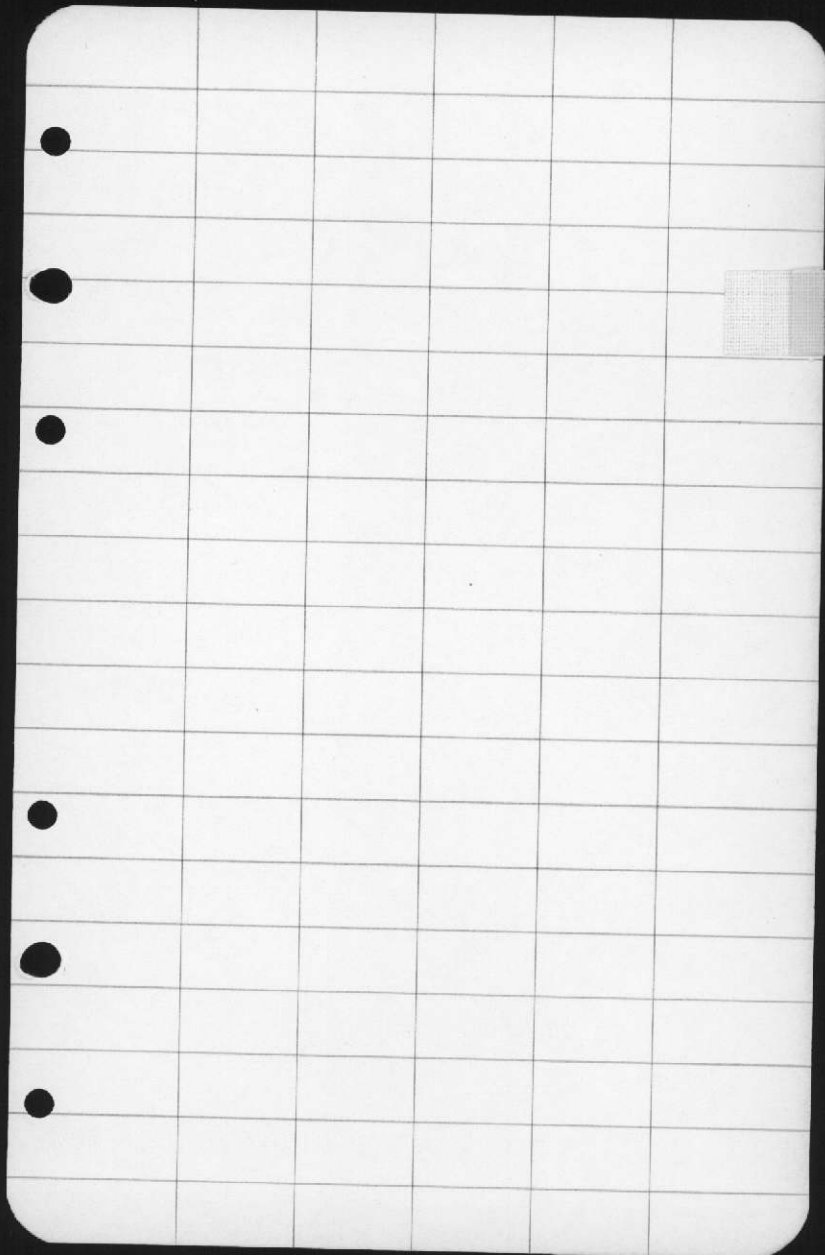


WELL  
15

615


250 G.P.M. - SINGLE DRIVE - 7½ H.P.  
 200 " " actual. D.D. - 4.0

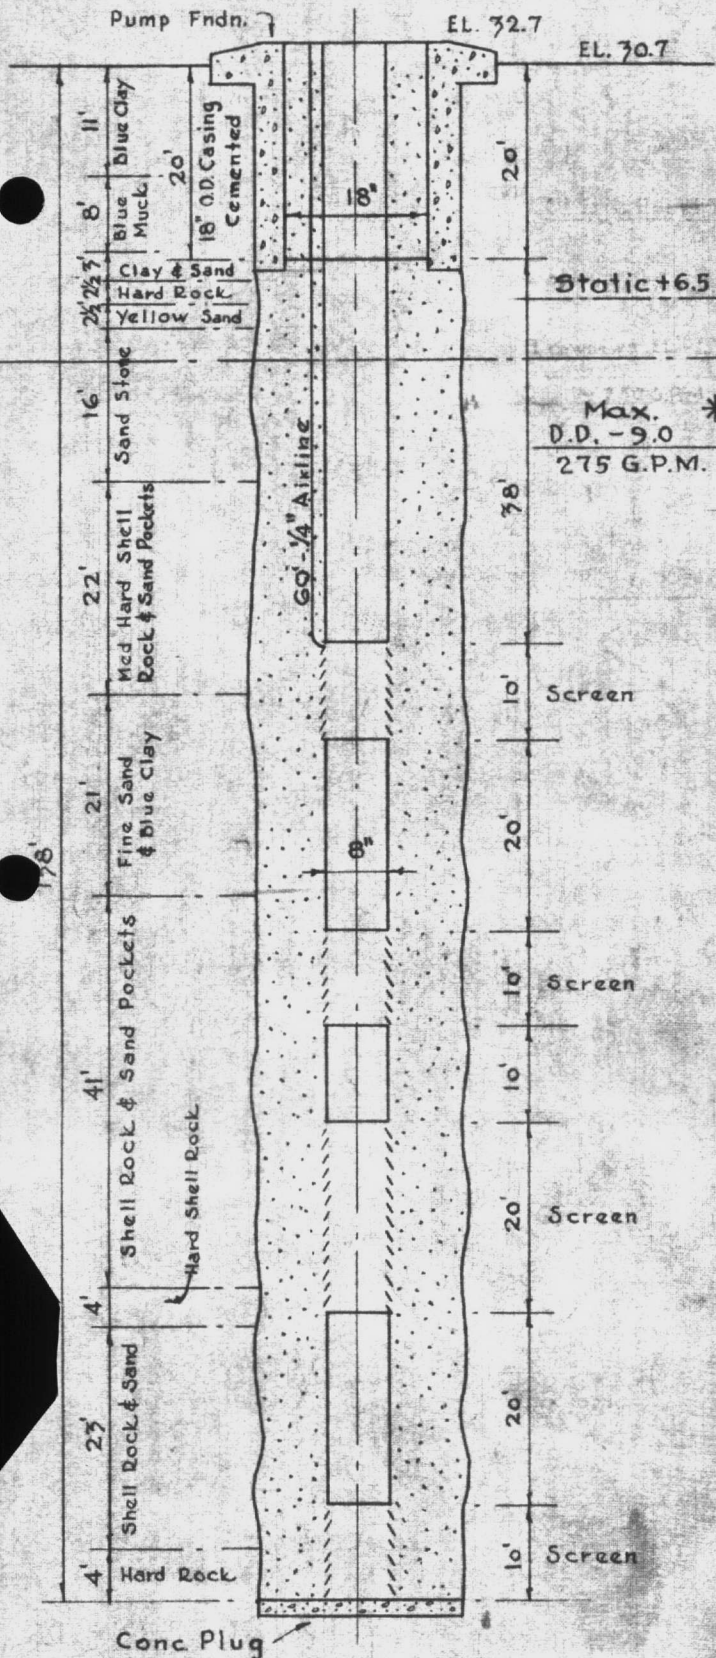



Armco Iron Screen Used In This Well







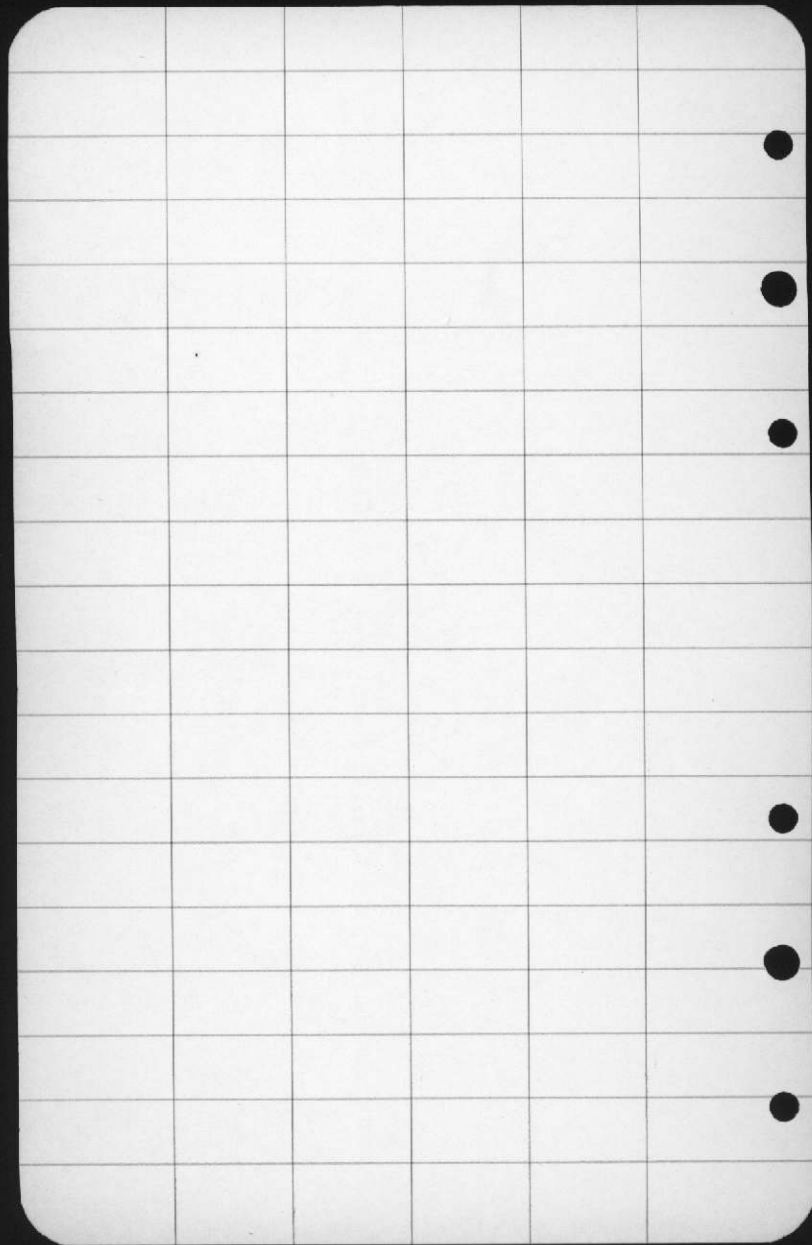


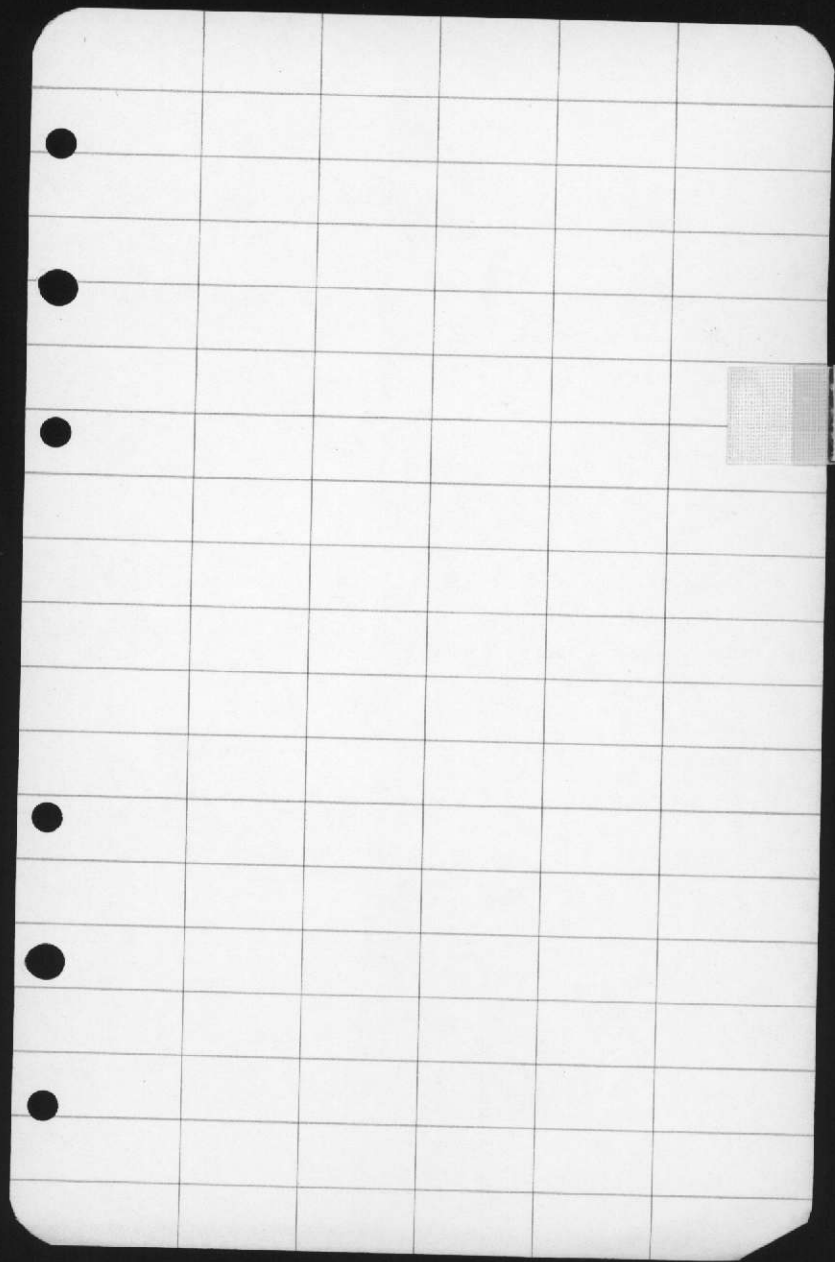

WELL  
16

616

250 G.P.M. - SINGLE DRIVE - 10 H.P.  
 261 " " " actual. D.D. - 15.0

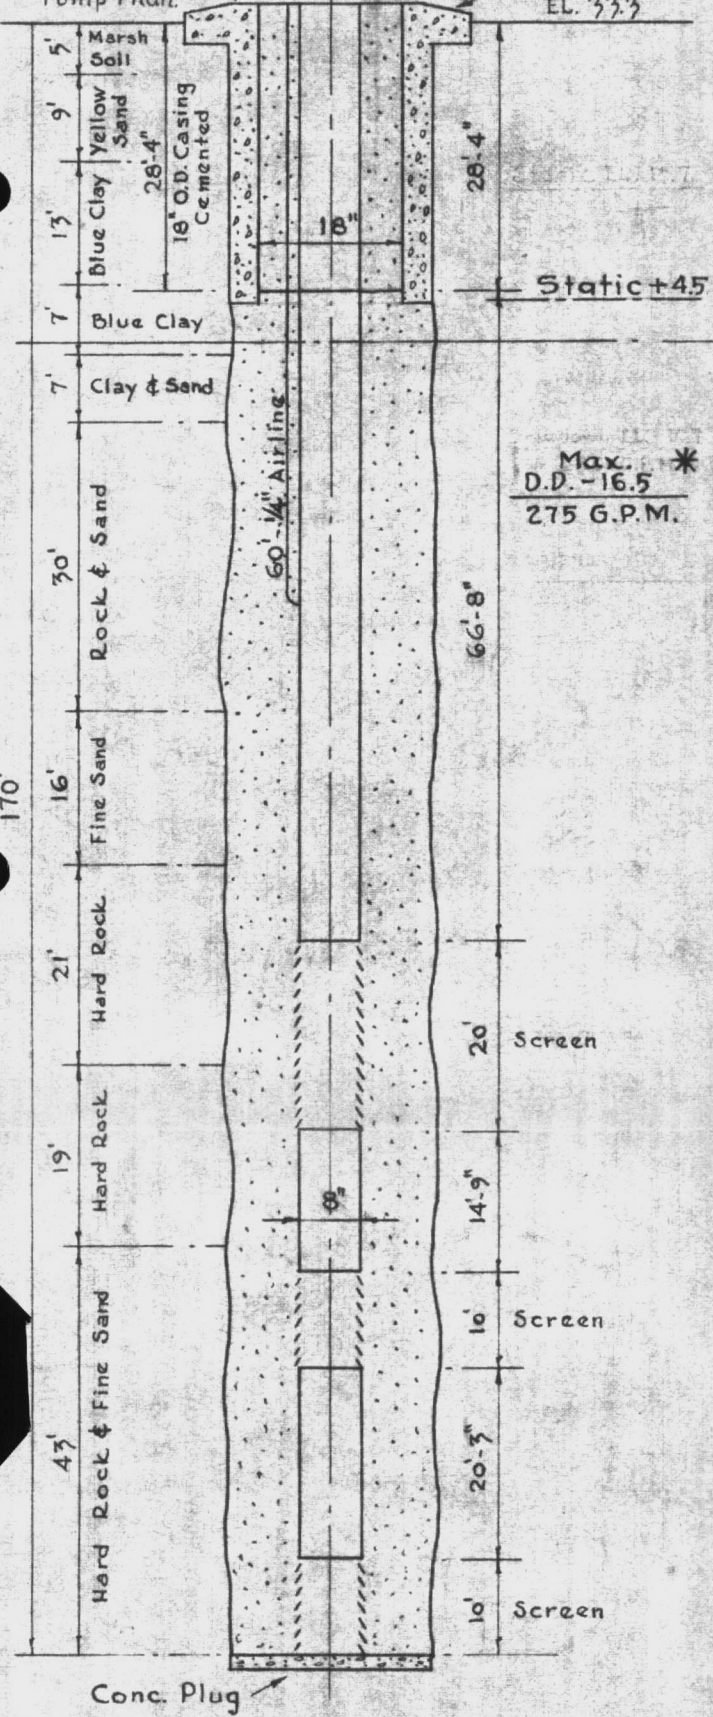


Static +45  
 Max. \*  
 D.D. - 16.5  
 275 G.P.M.


Armco Iron Screen Used In This Well





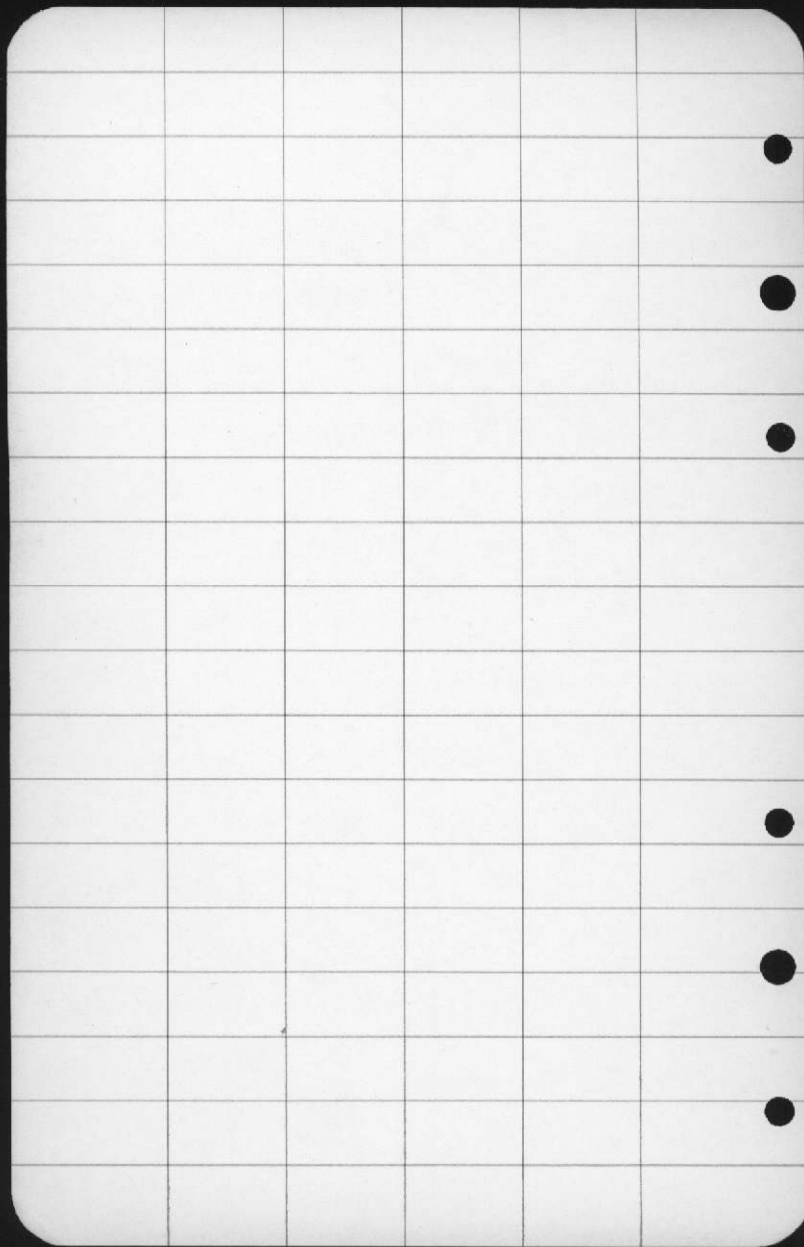




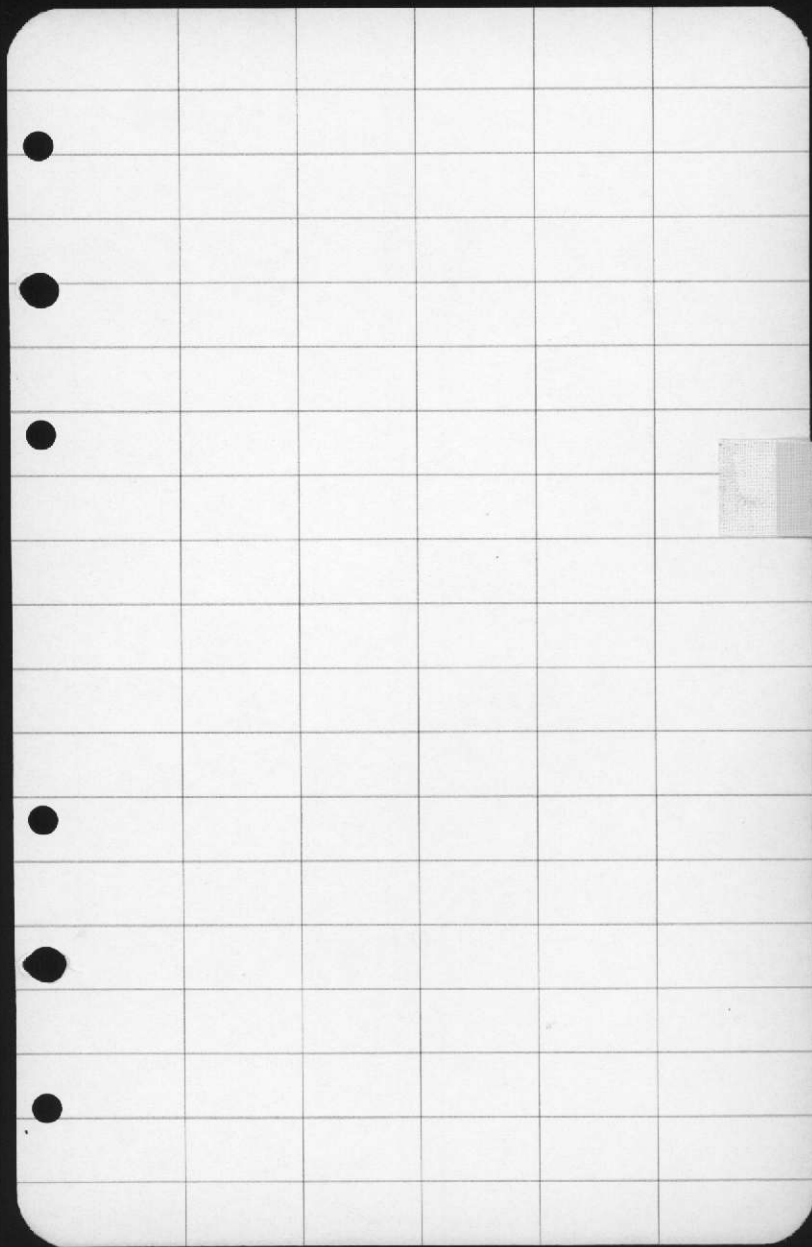

WELL  
17



250 G.P.M. - DUAL DRIVE - 10 H.P.  
 178 " " " actual. Recom. 235 G.P.M. 10 H.P.

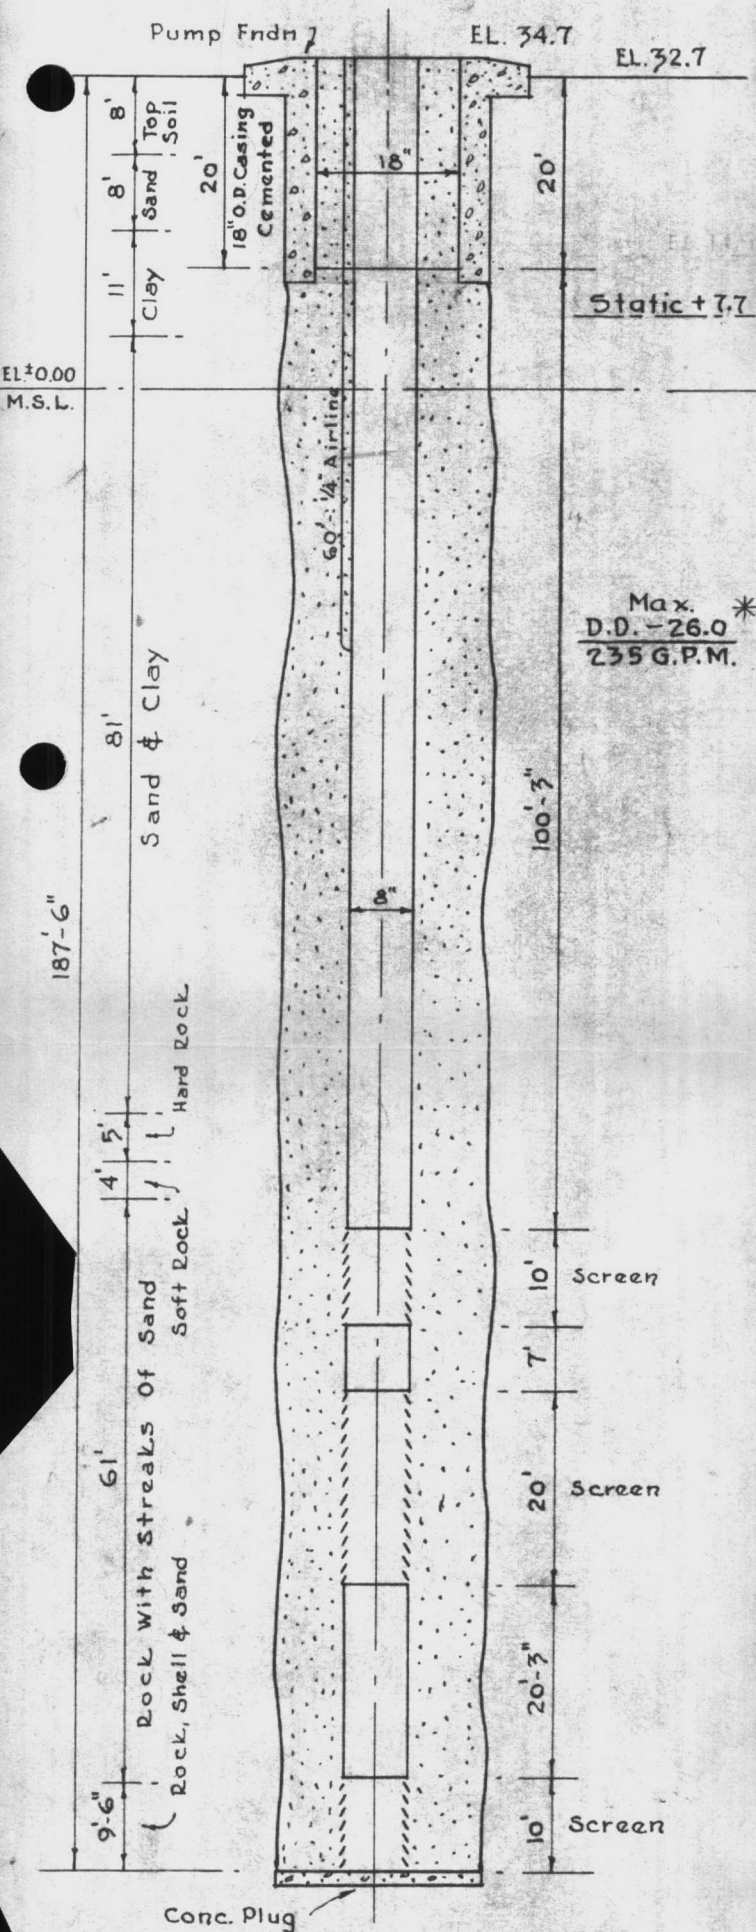



Armco Iron Screen Used In This Well

D. T. A. WELL No. 17





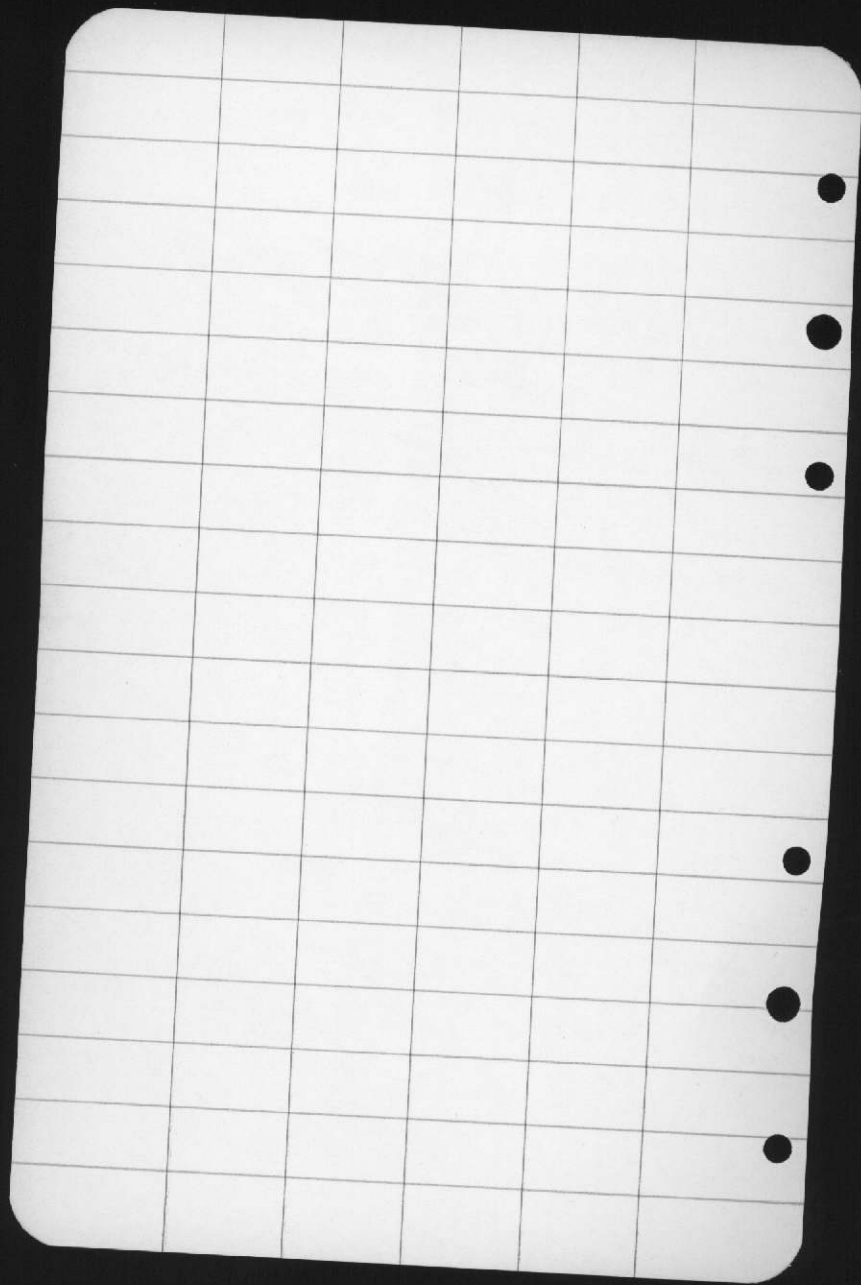

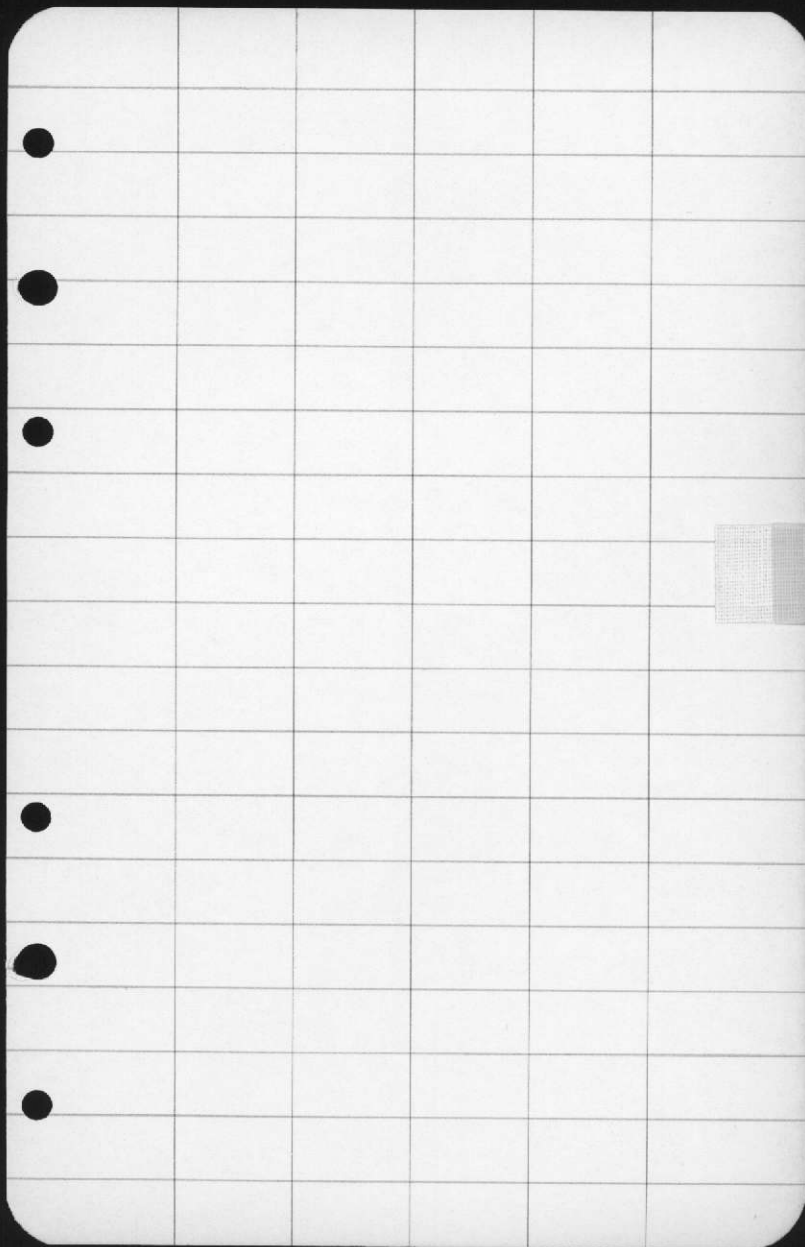

WELL  
18

819




200 G.P.M. — SINGLE DRIVE — 7½ H.P.  
 75 " " " actual. Recom. 260 G.P.M. 10 H.P.

Pumps Sand

Pump Fndn

EL. 37.3

EL. 35.3

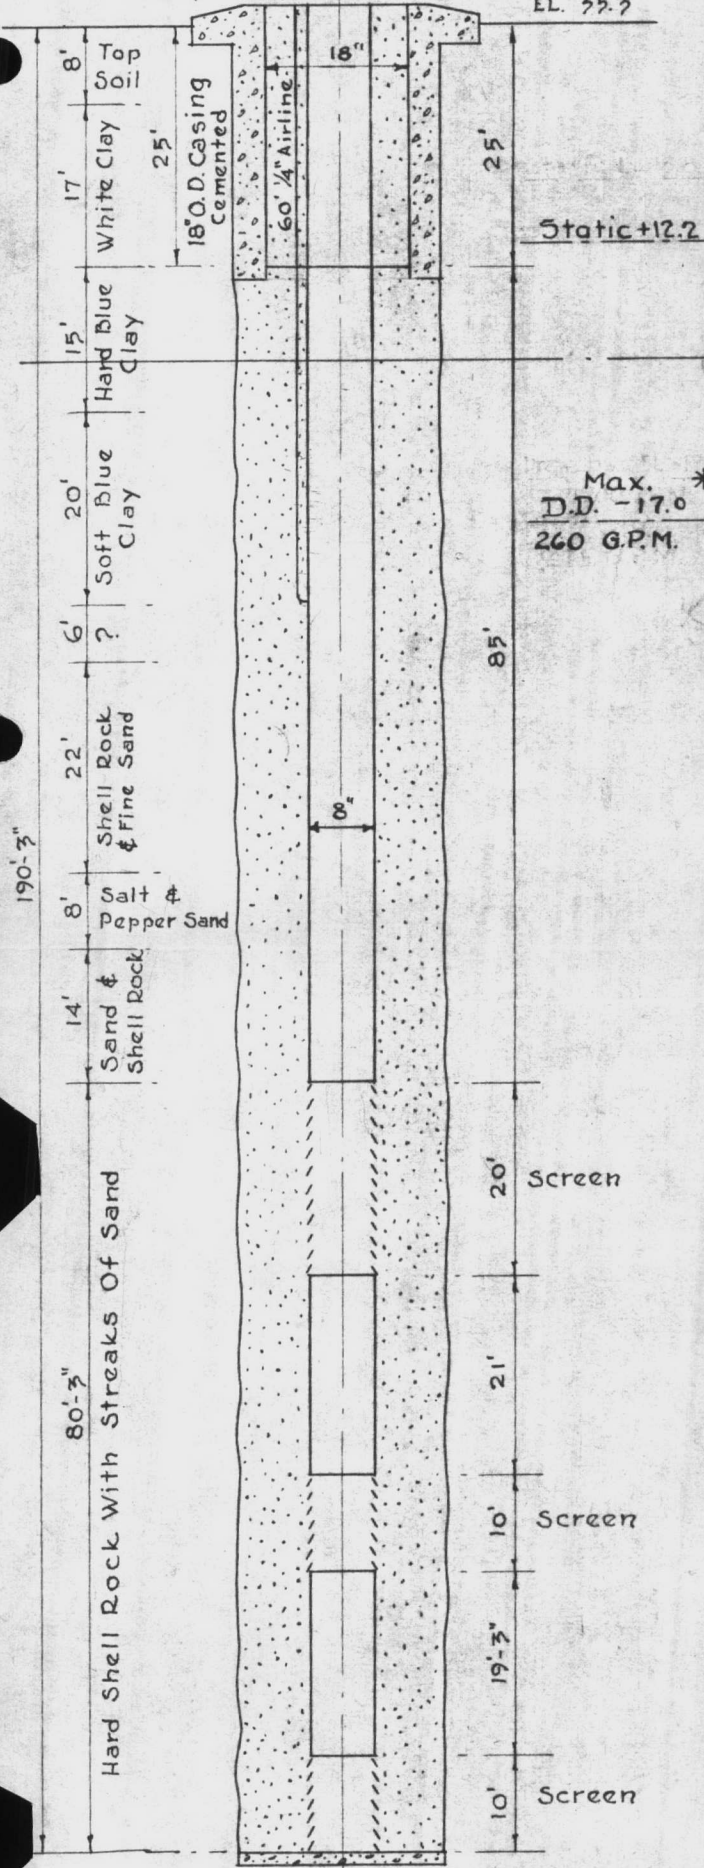

Static +12.2

Max. \*  
 D.D. -17.0  
 260 G.P.M.

85'

20' Screen

10' Screen

10' Screen


Conc. Plug


Armco Iron Screen Used In This Well

D.T.A. WELL No. 18





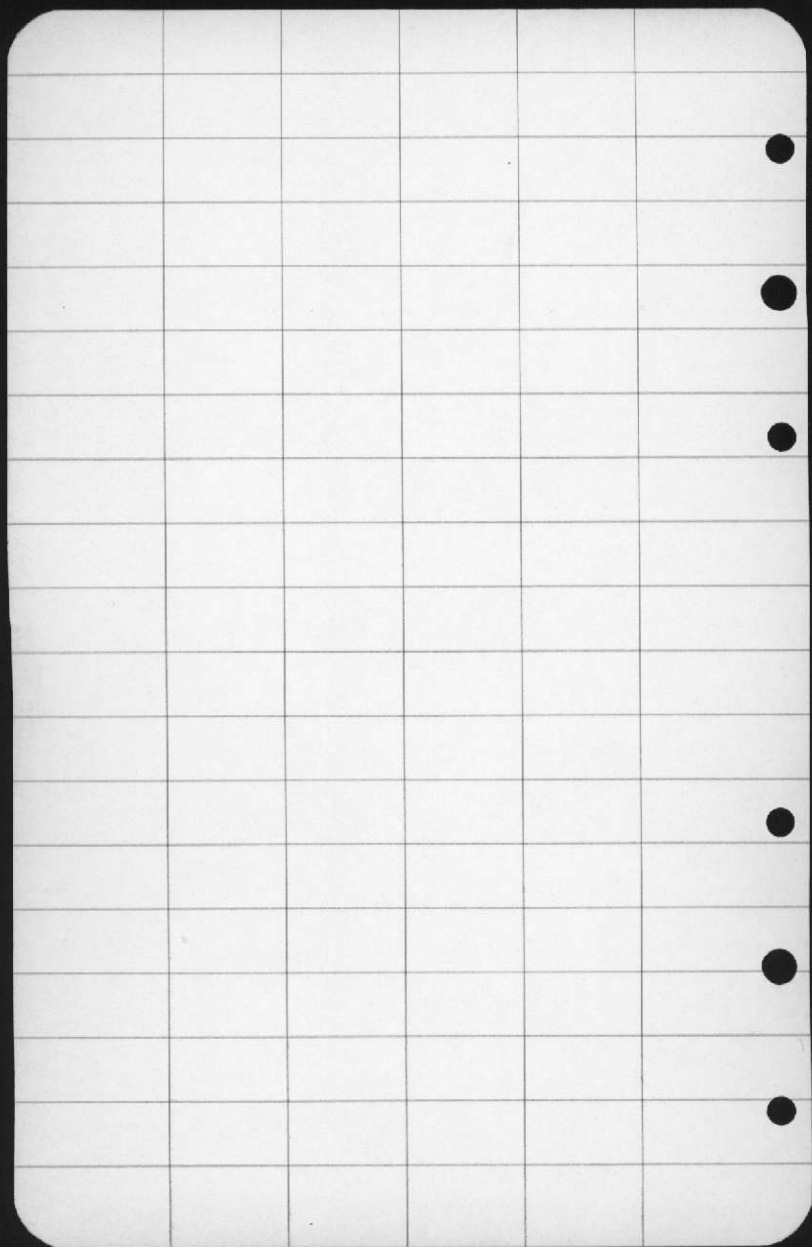

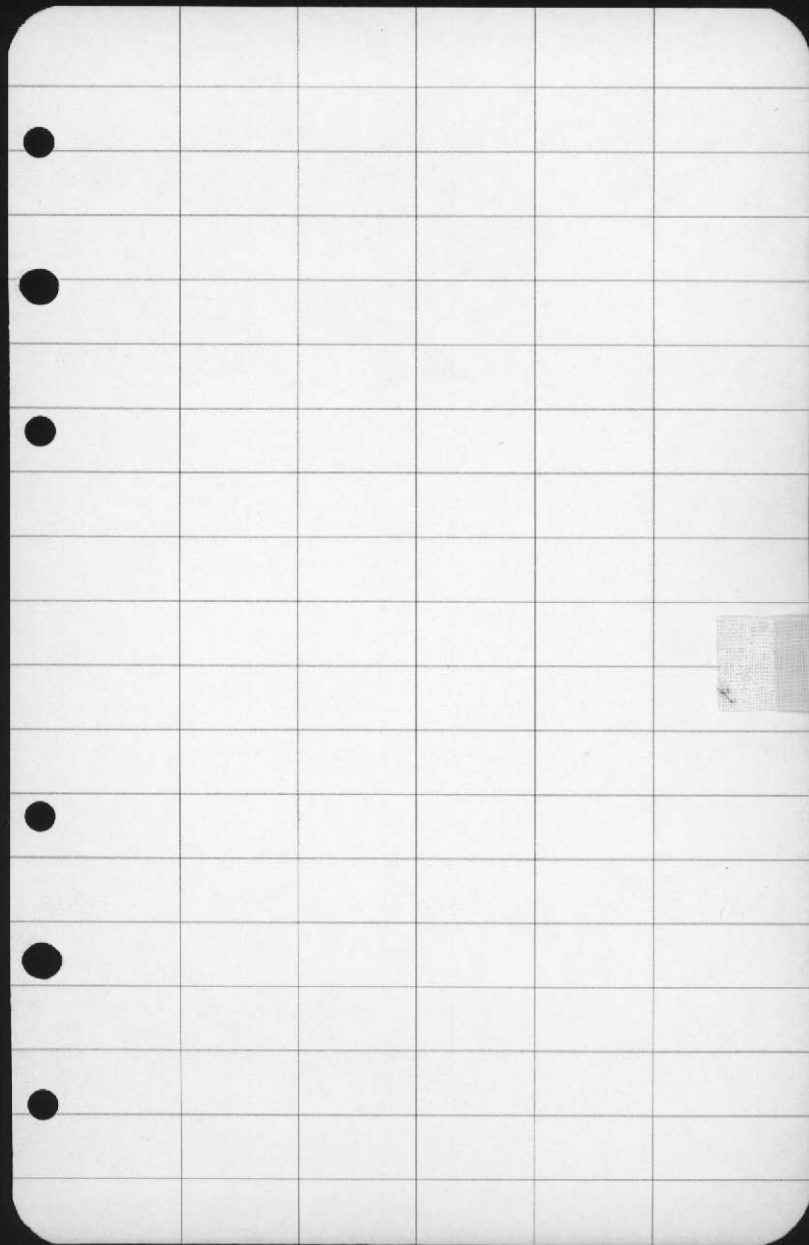


WELL  
19

619



200 G.P.M. — SINGLE DRIVE — 7½ H.P.  
 94 " " " actual. Recom. 250 G.P.M. 10 H.P.

Pumps - Sand

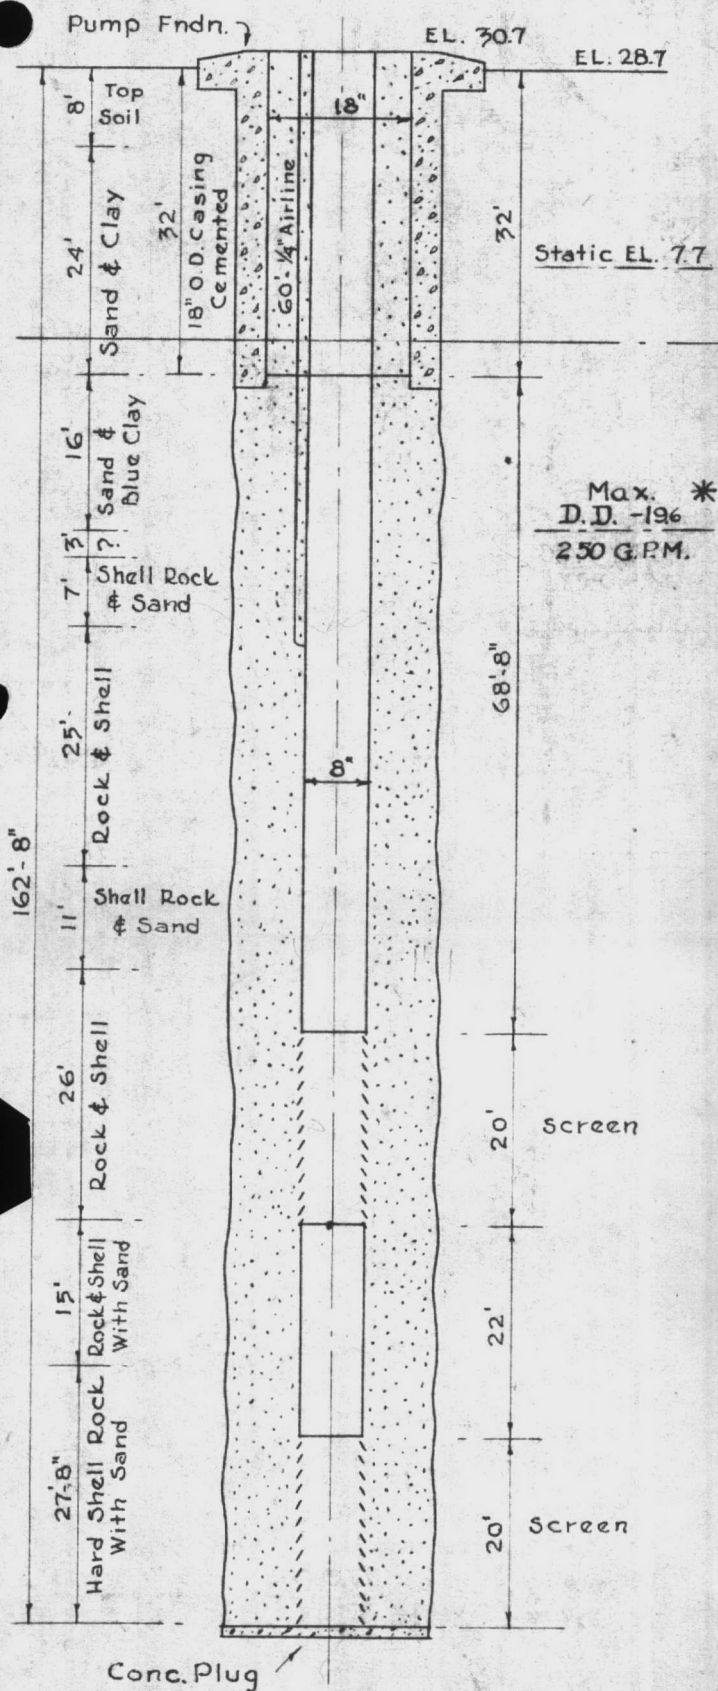

Armco Iron Screen Used In This Well


D.T.A. WELL No. 19

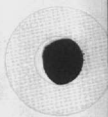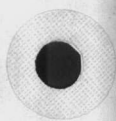








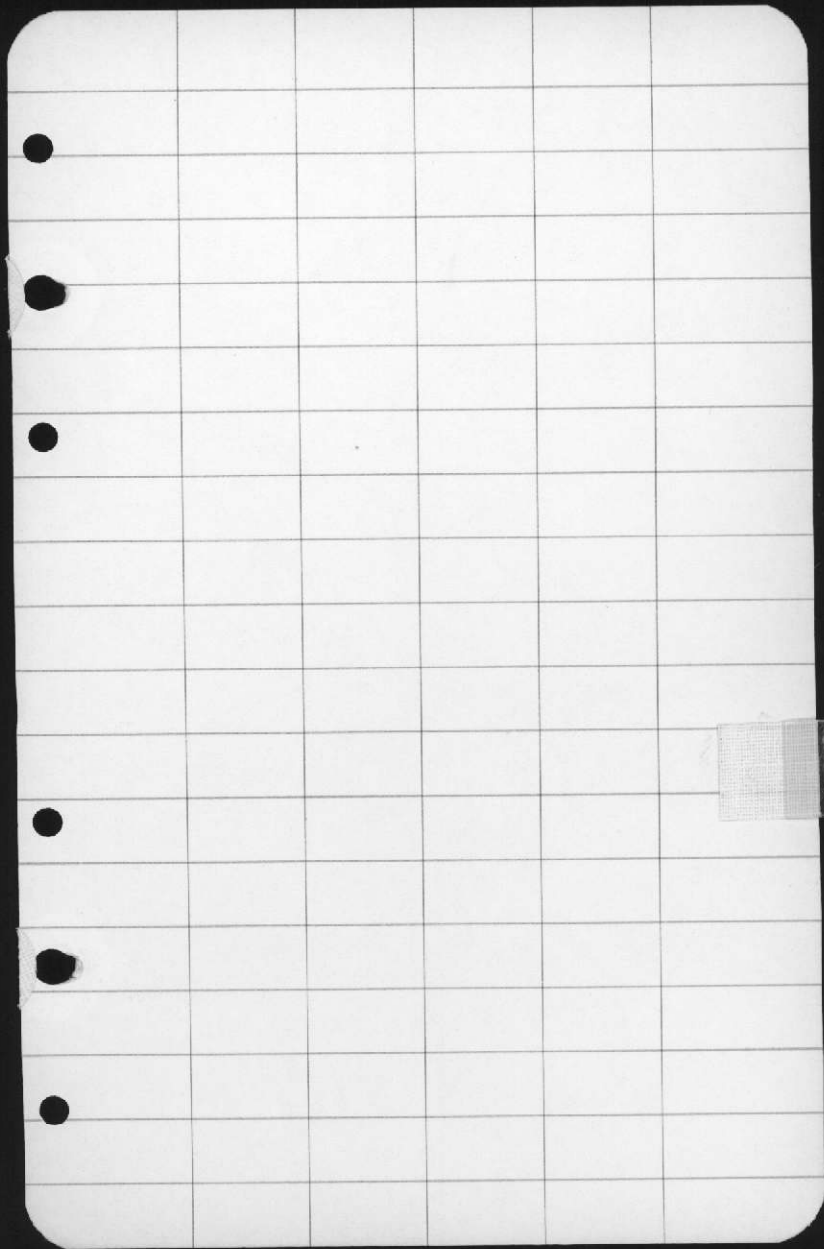


WELL  
20

620


200 G.P.M. — SINGLE DRIVE — 7½ H.P.  
 183 " " " actual. Recom. 215 G.P.M. 7½ H.P.

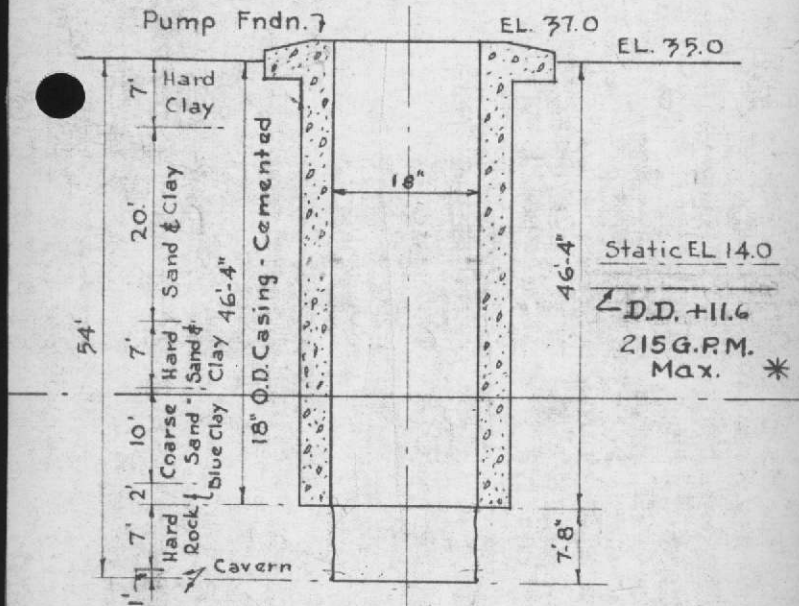


Division Training Area Well No. 20

 



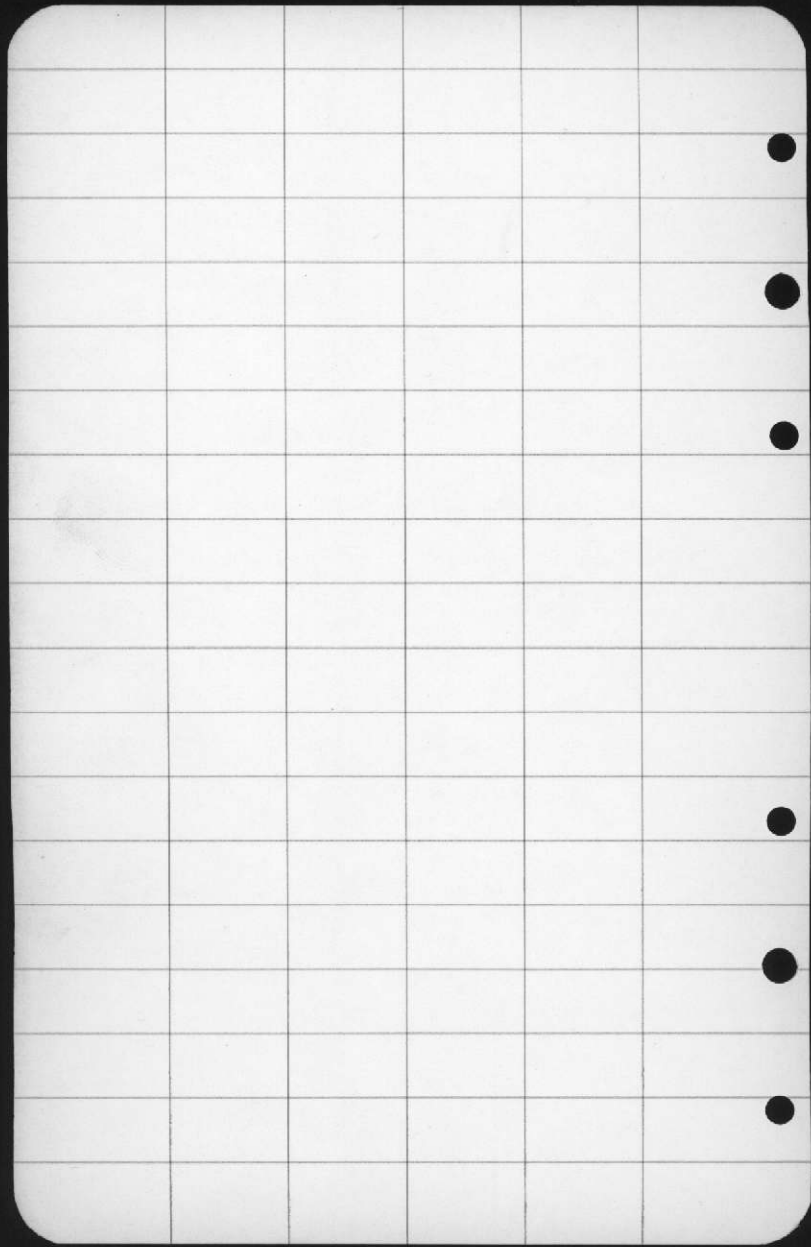




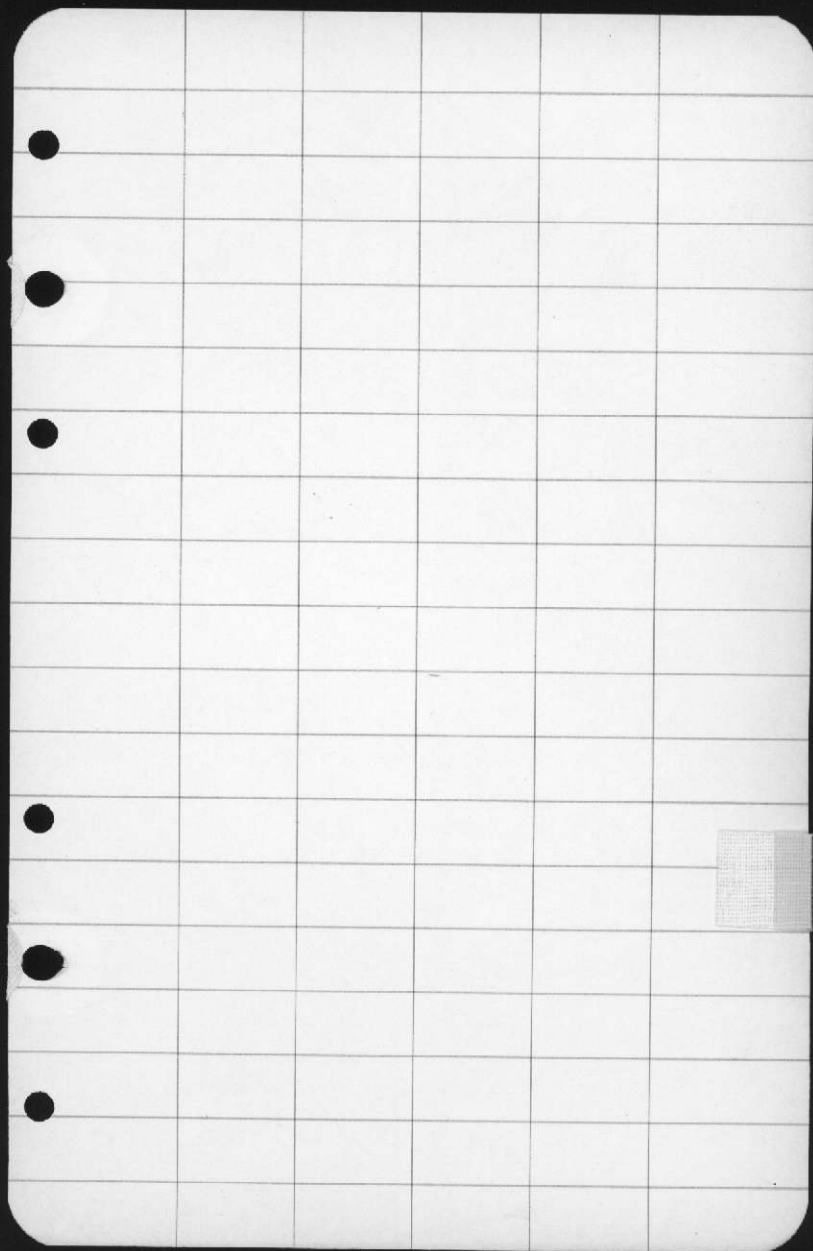


WELL  
21

621


250 G.P.M. — DUAL DRIVE — 7½ H.P.  
 125 " " " actual. Recom. 290 G.P.M. 10 H.P.

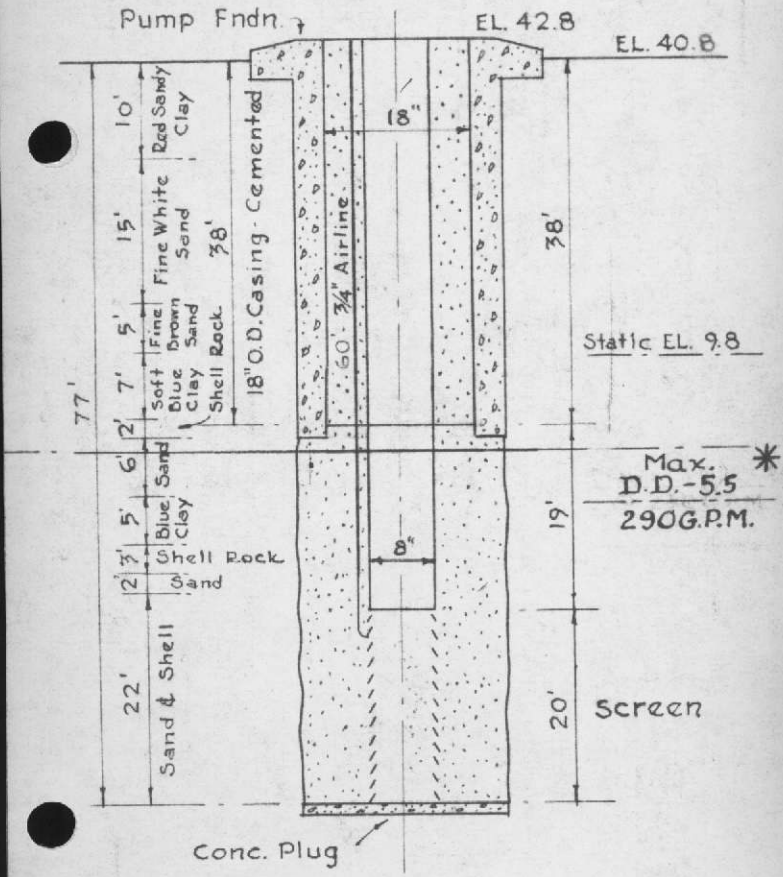

Armco Iron Screen Used in this Well  
 Division Training Area Well No. 21

 




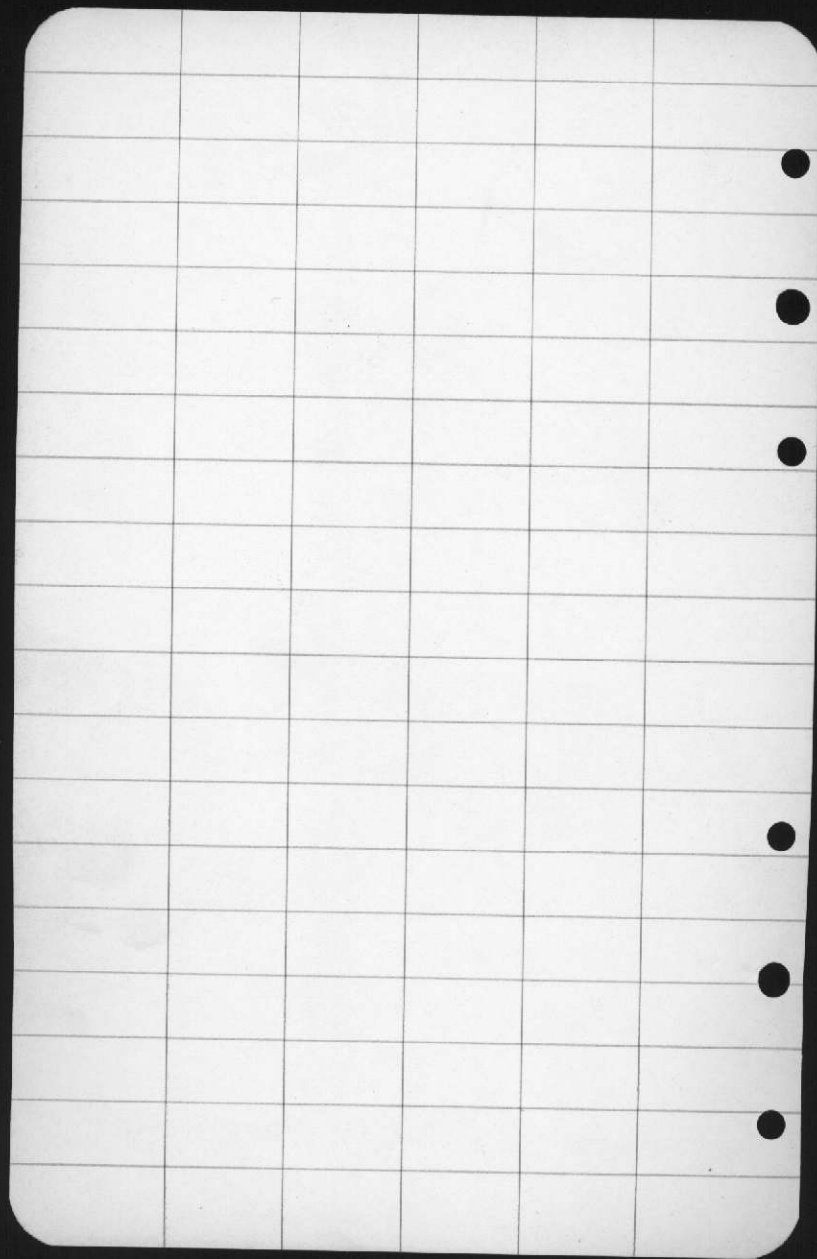



WELL DATA


Onslow Beach Area

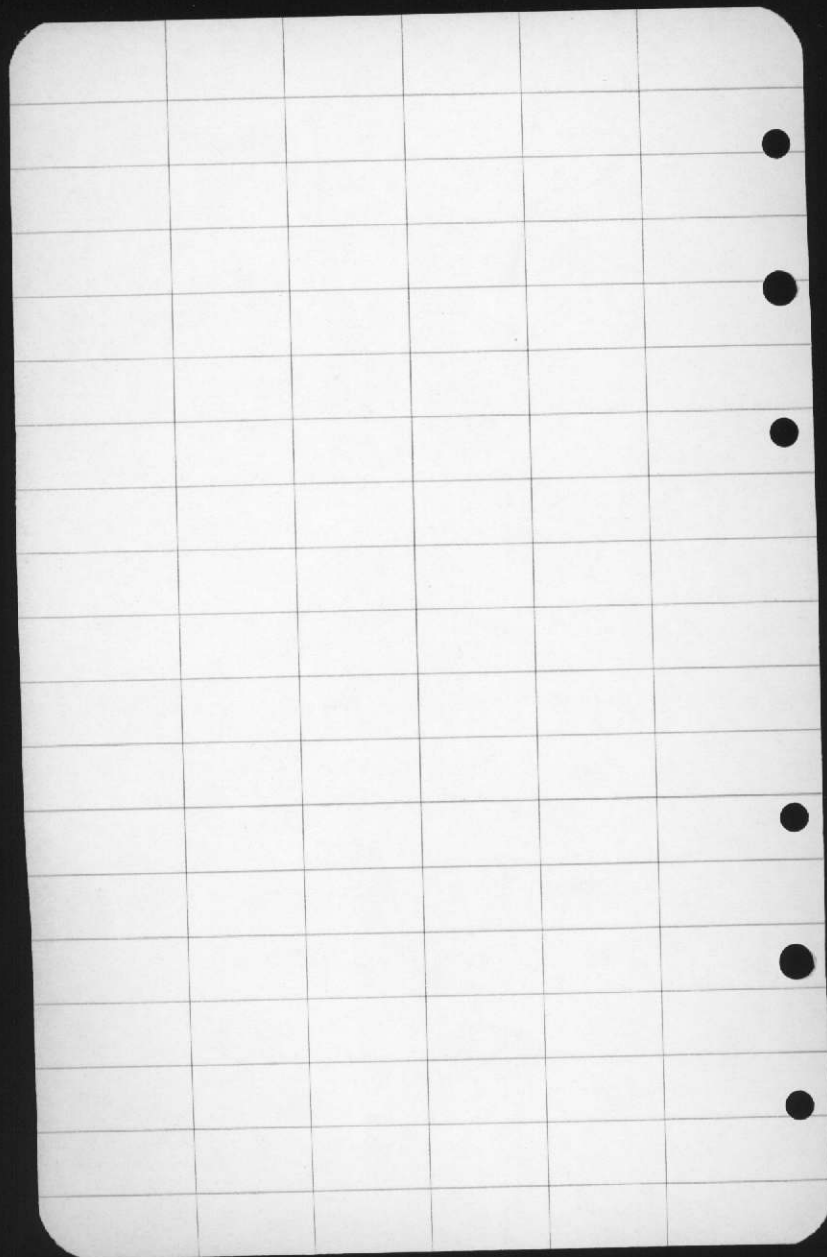




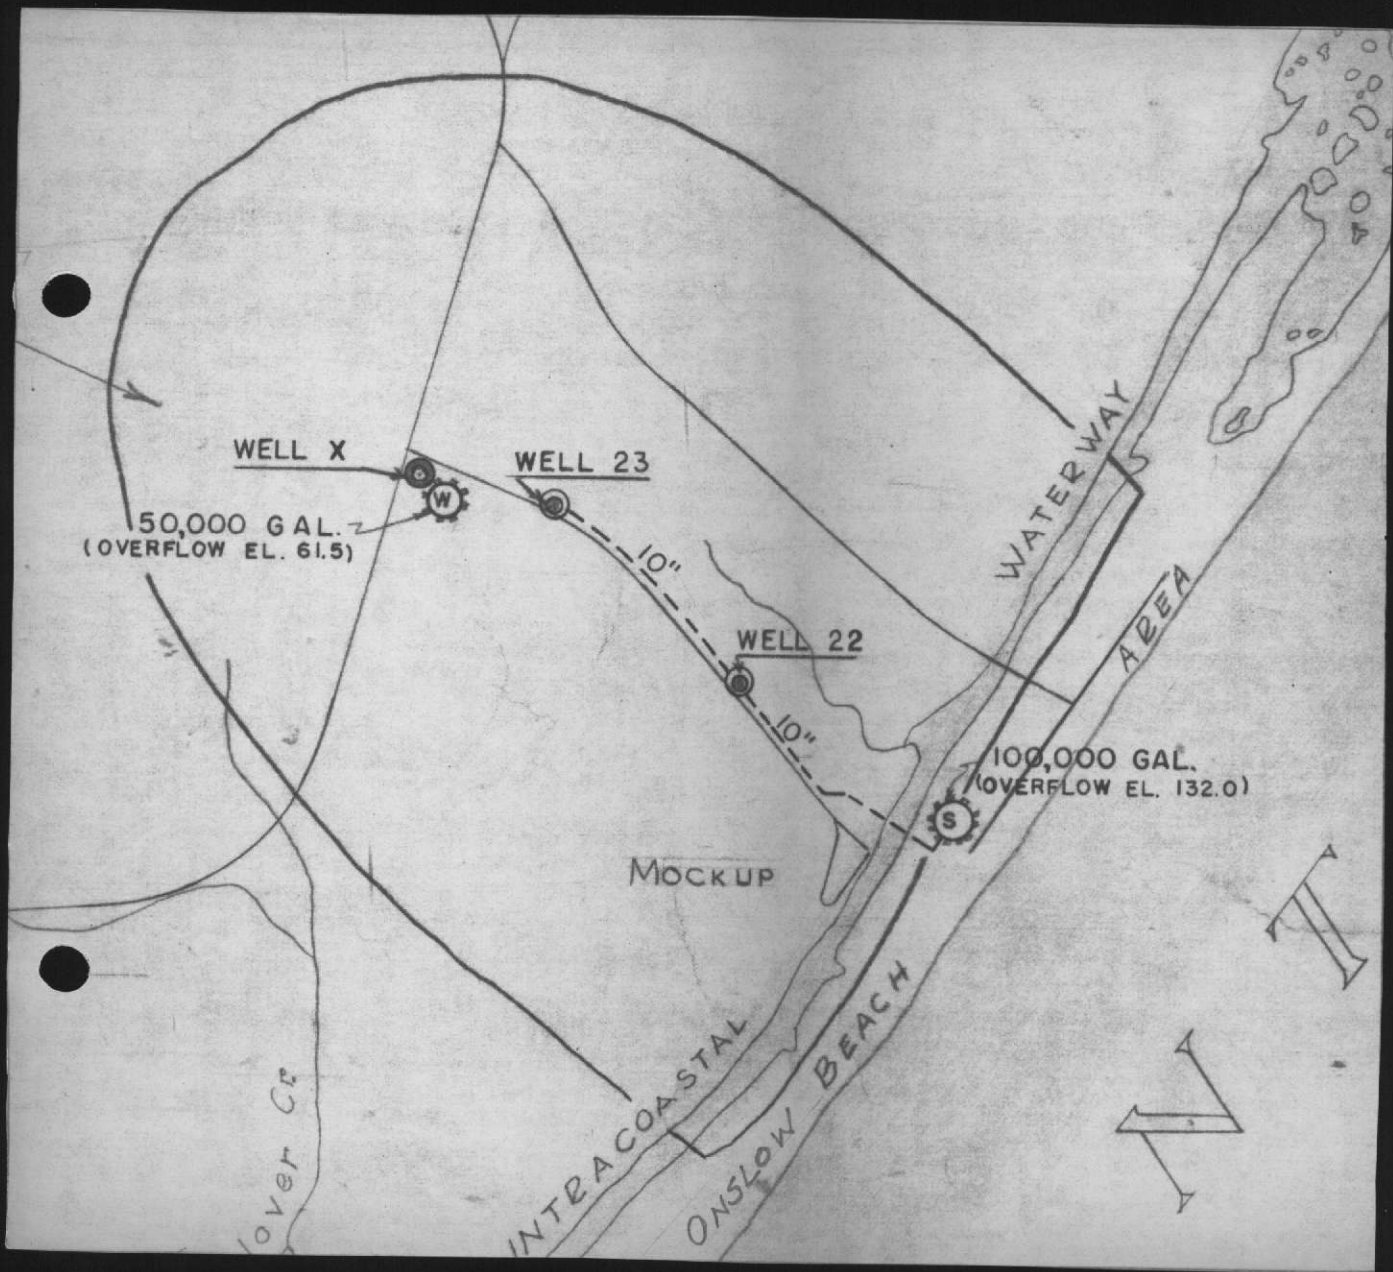

 


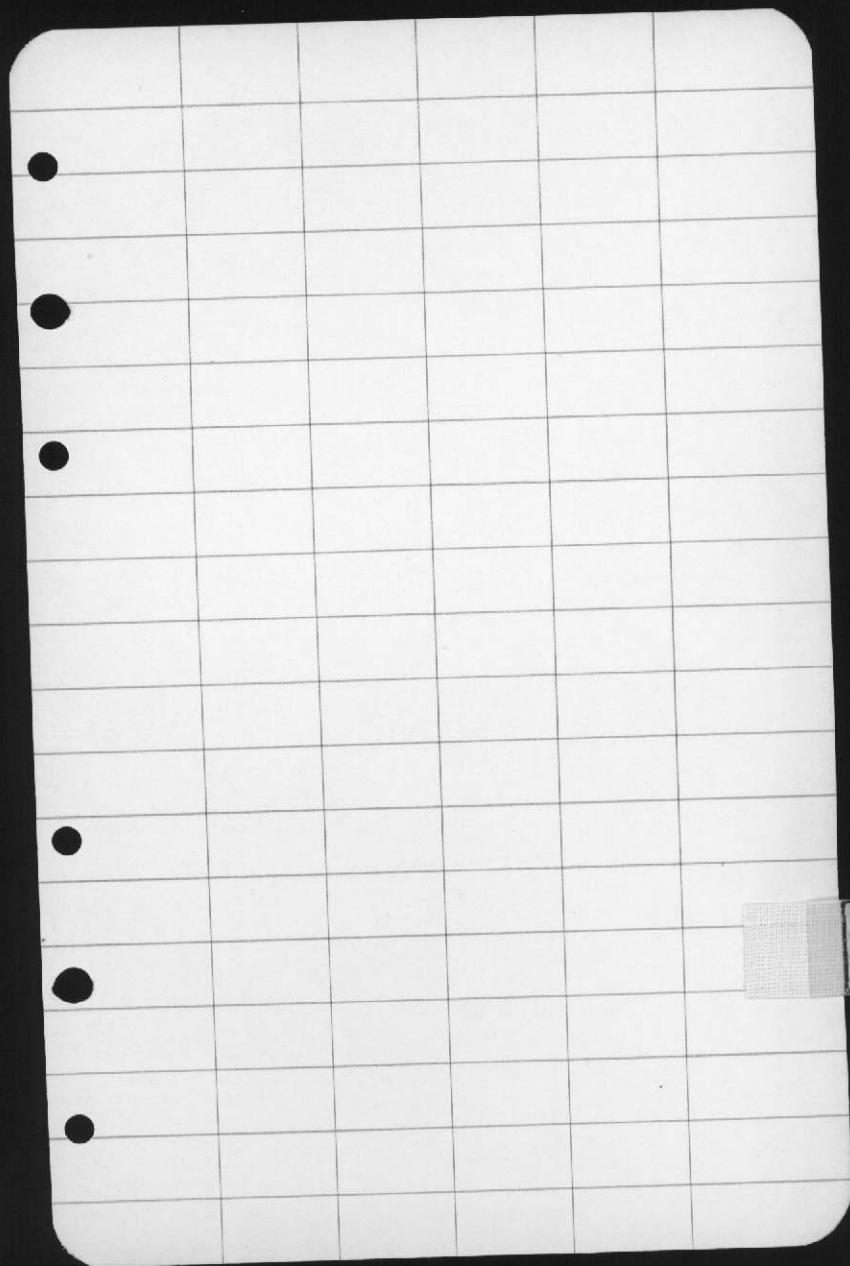


WELL  
22

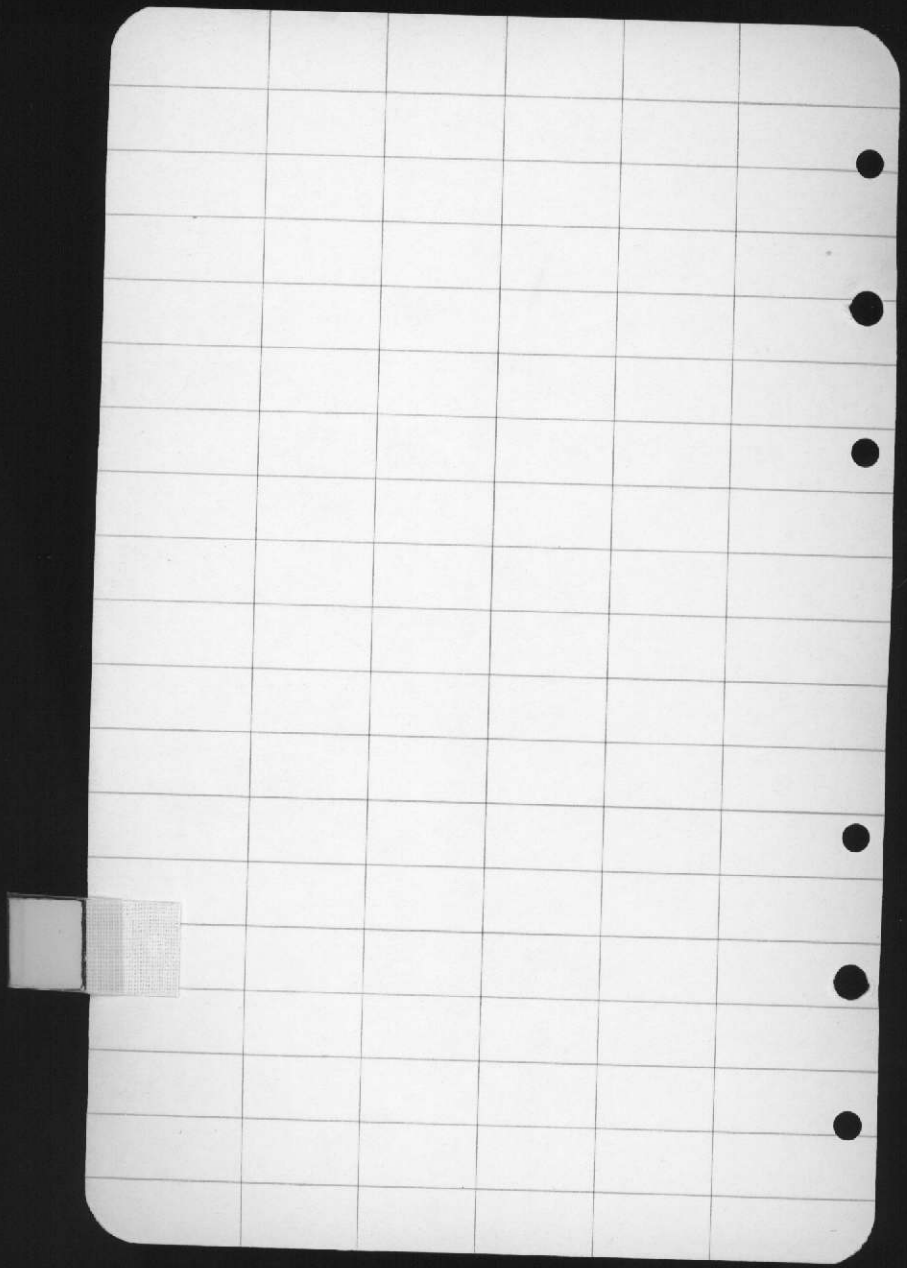


No information on Pump

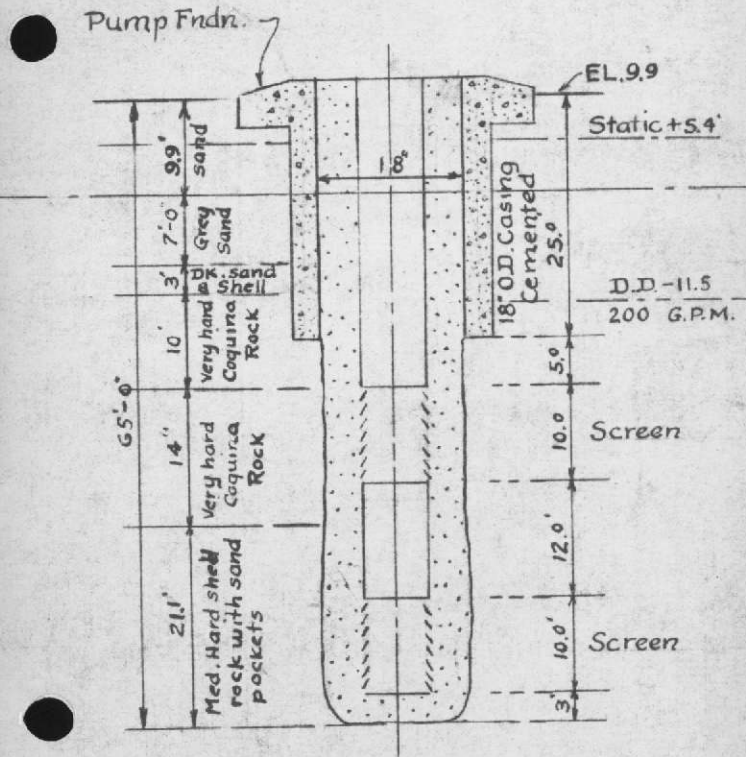

Beach Area Well No. 22

 

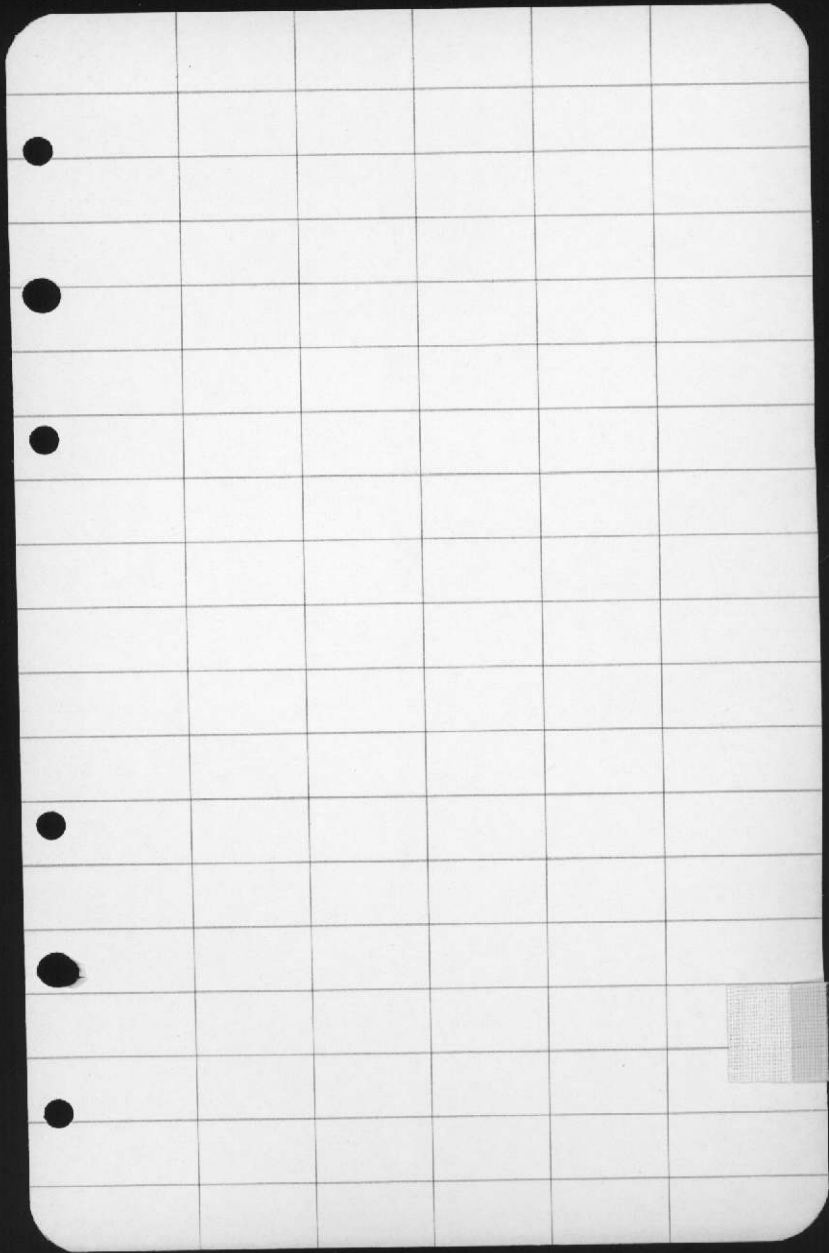



WELL  
23








 


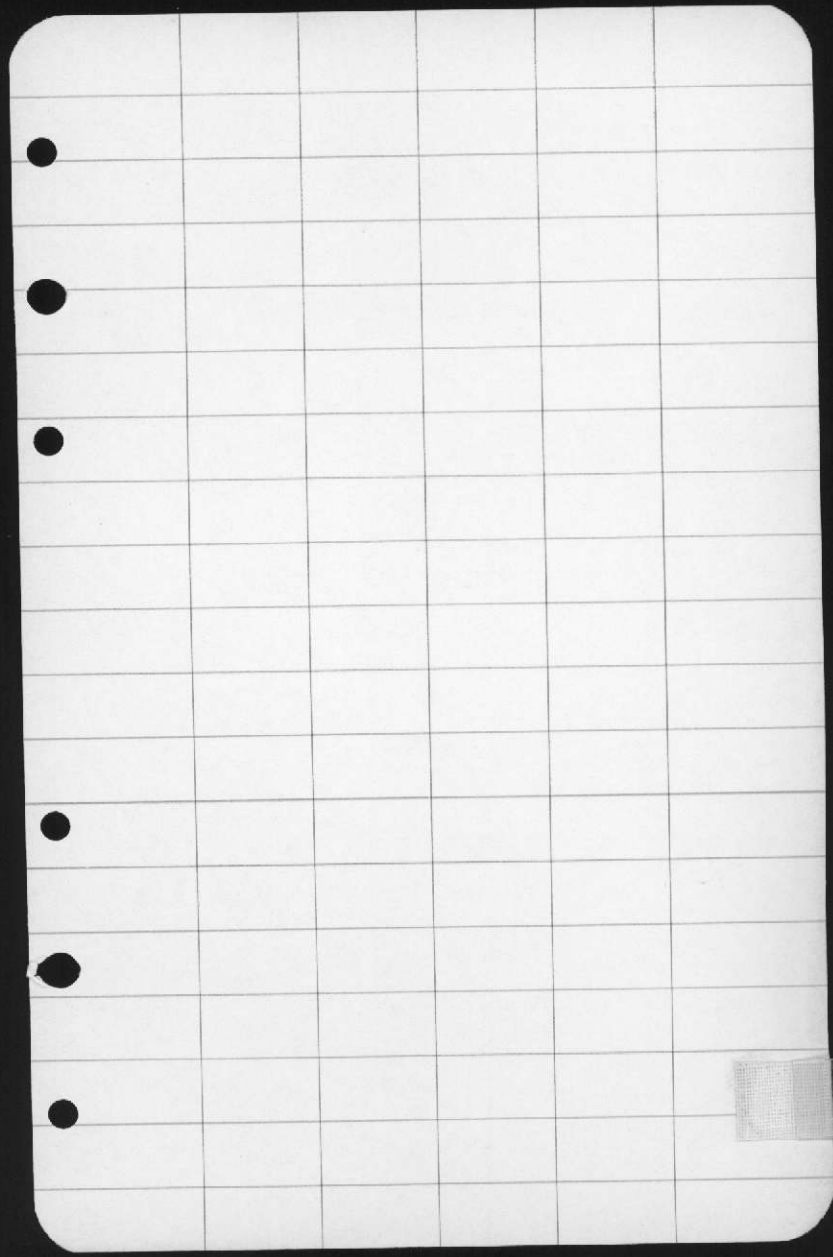


WELL  
LCH-1

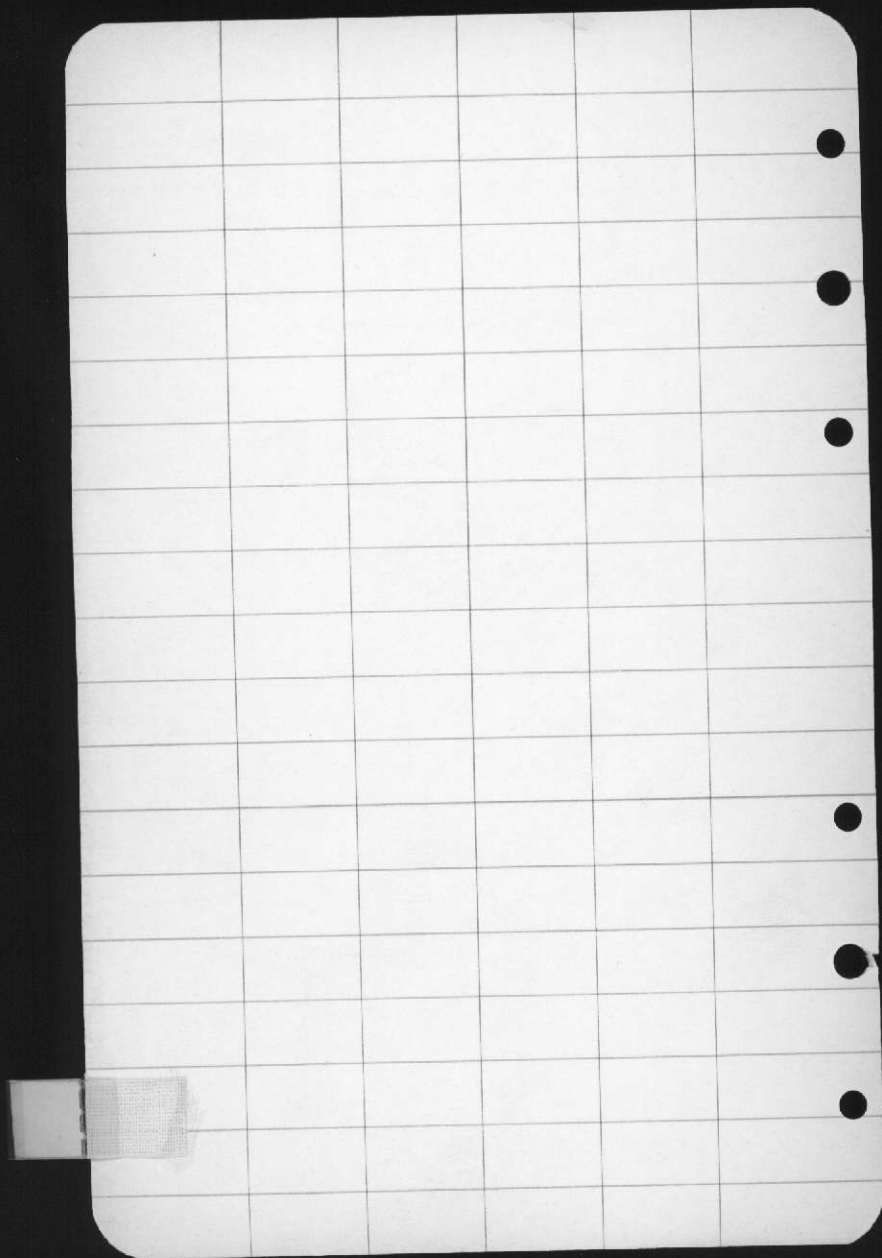


300 G.P.M. - SINGLE DRIVE -

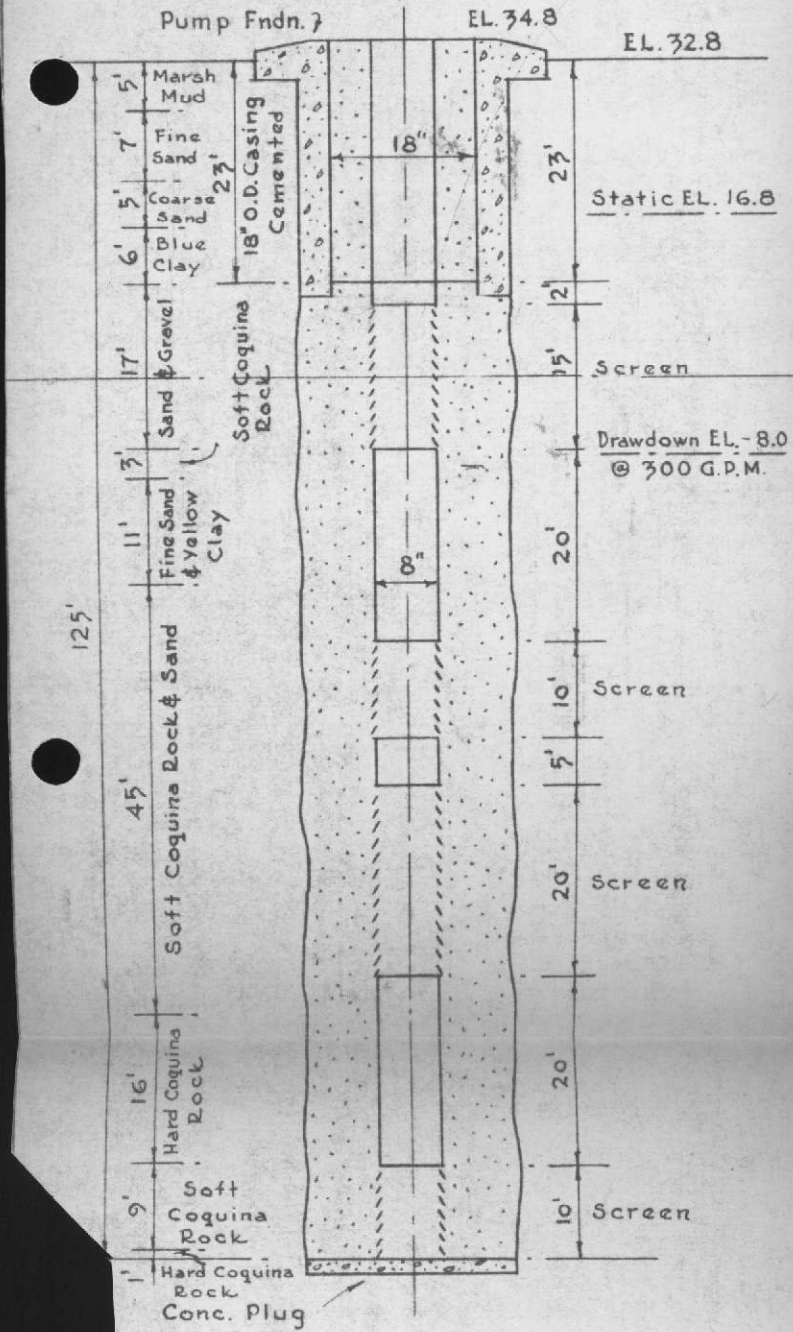


Midway Park Well No. 1 (LCH-1)

 

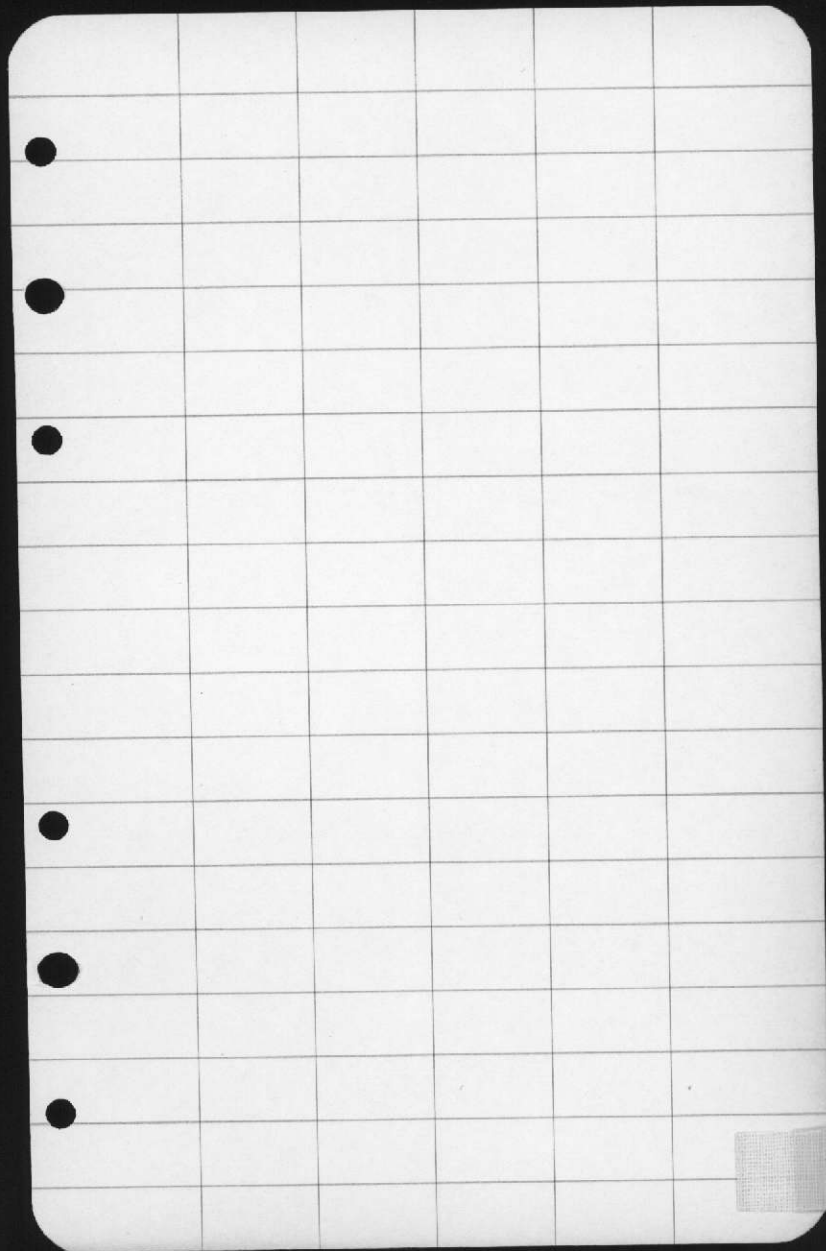


WELL  
LCH-2

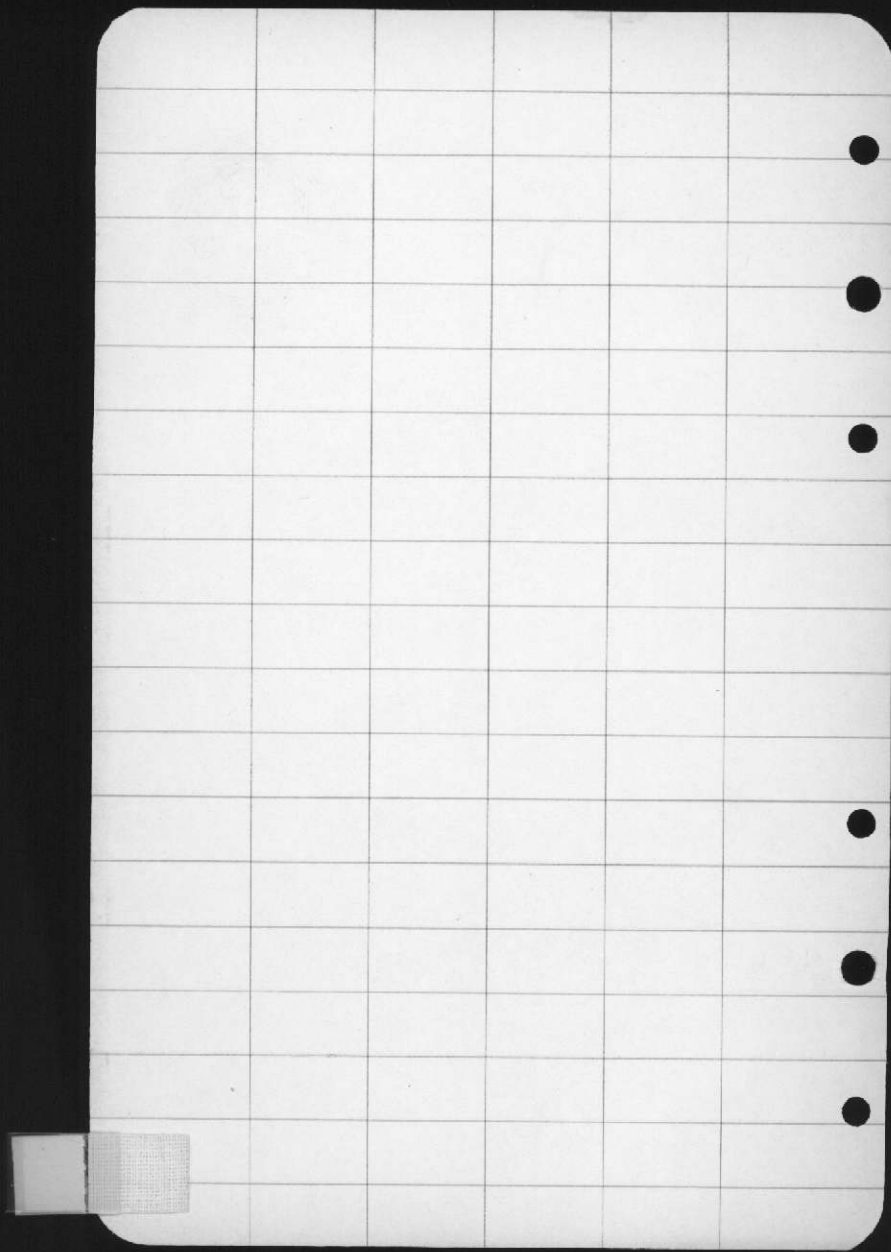





300 G.P.M. - DUAL DRIVE - 20 H.P.

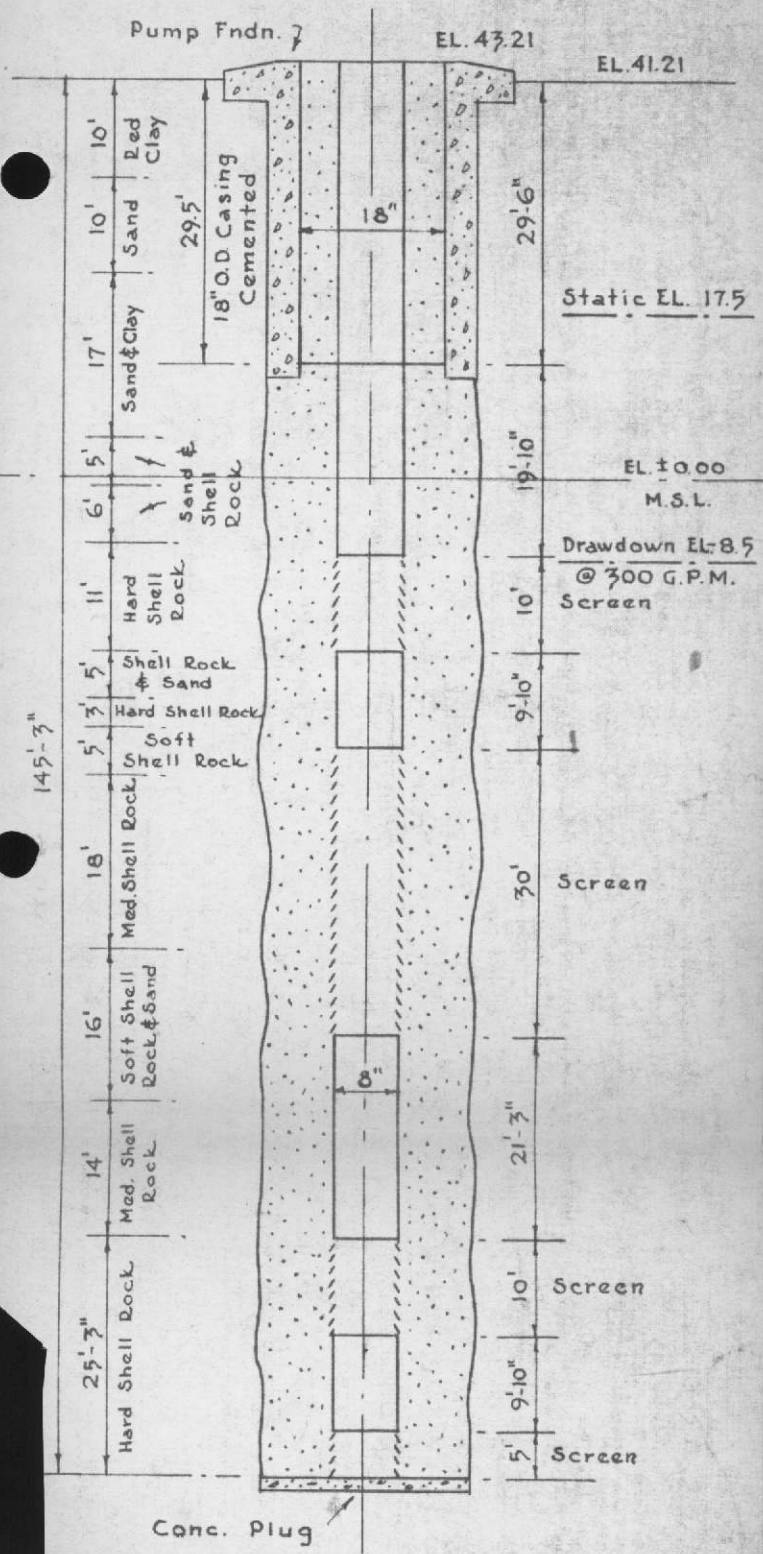


Midway Park Well No. 2 (LCH-2)

 


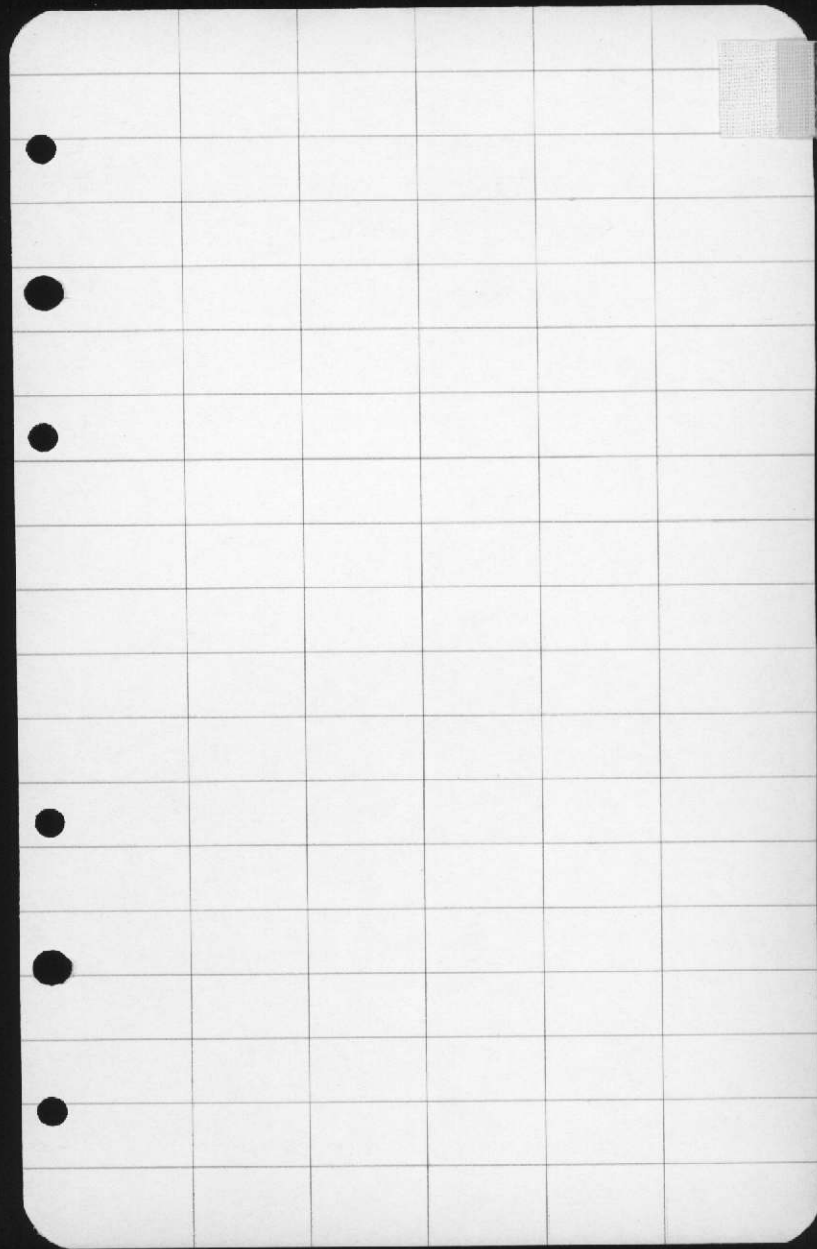


WELL  
"X"

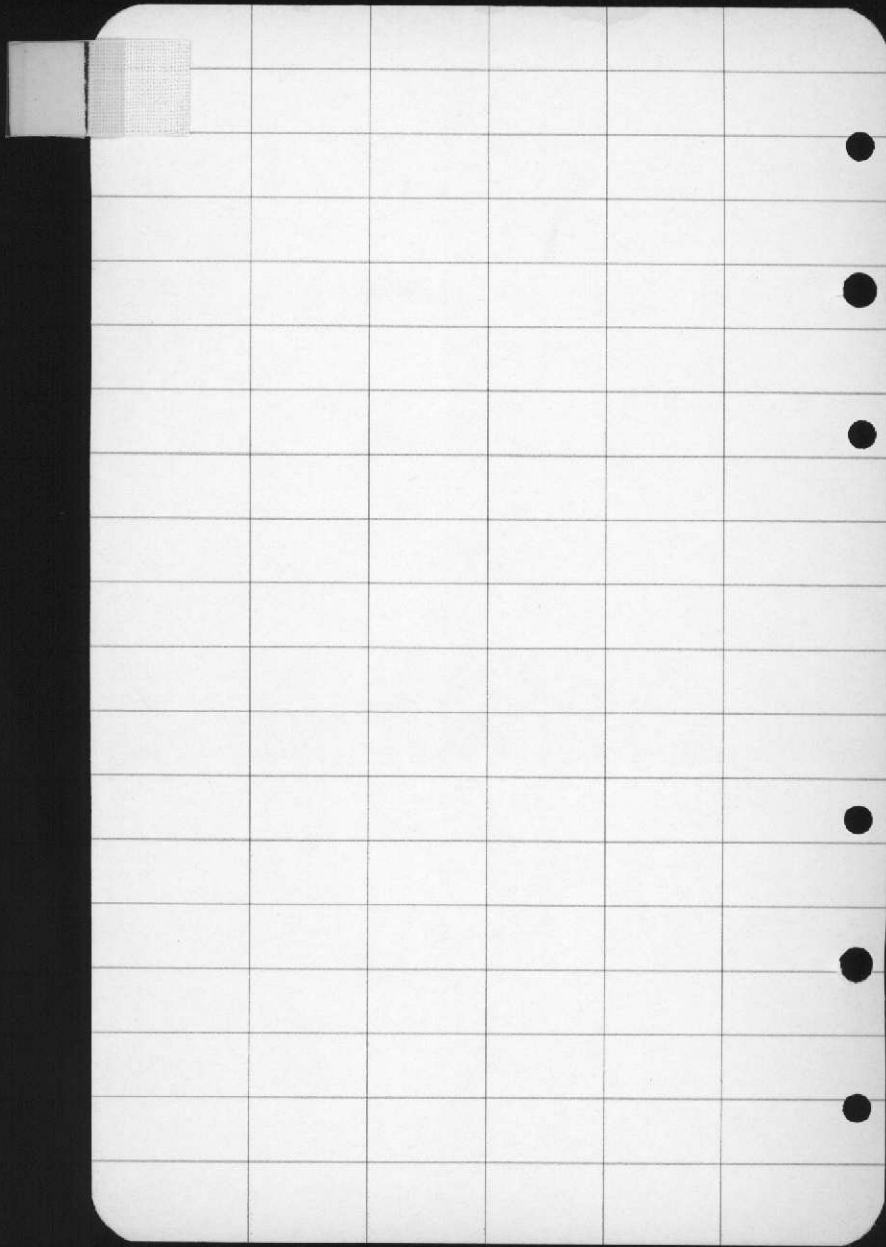


50 G.P.M. - SINGLE DRIVE - 2 H.P.

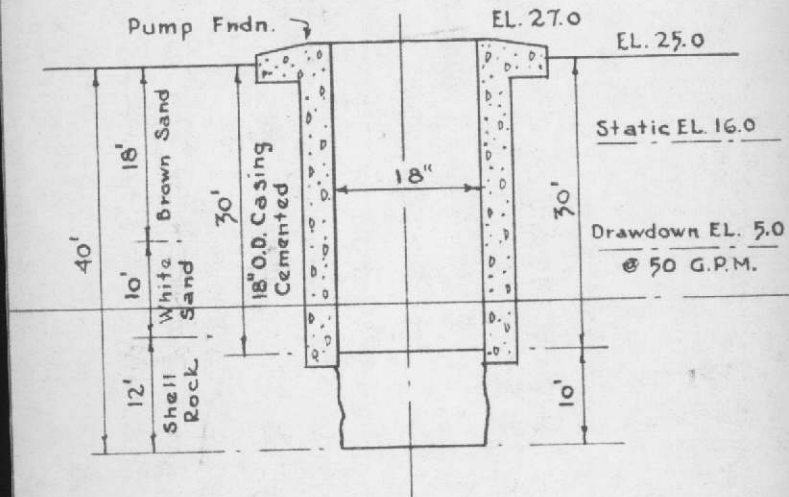


U.S.S. Mockup Well "X"

 

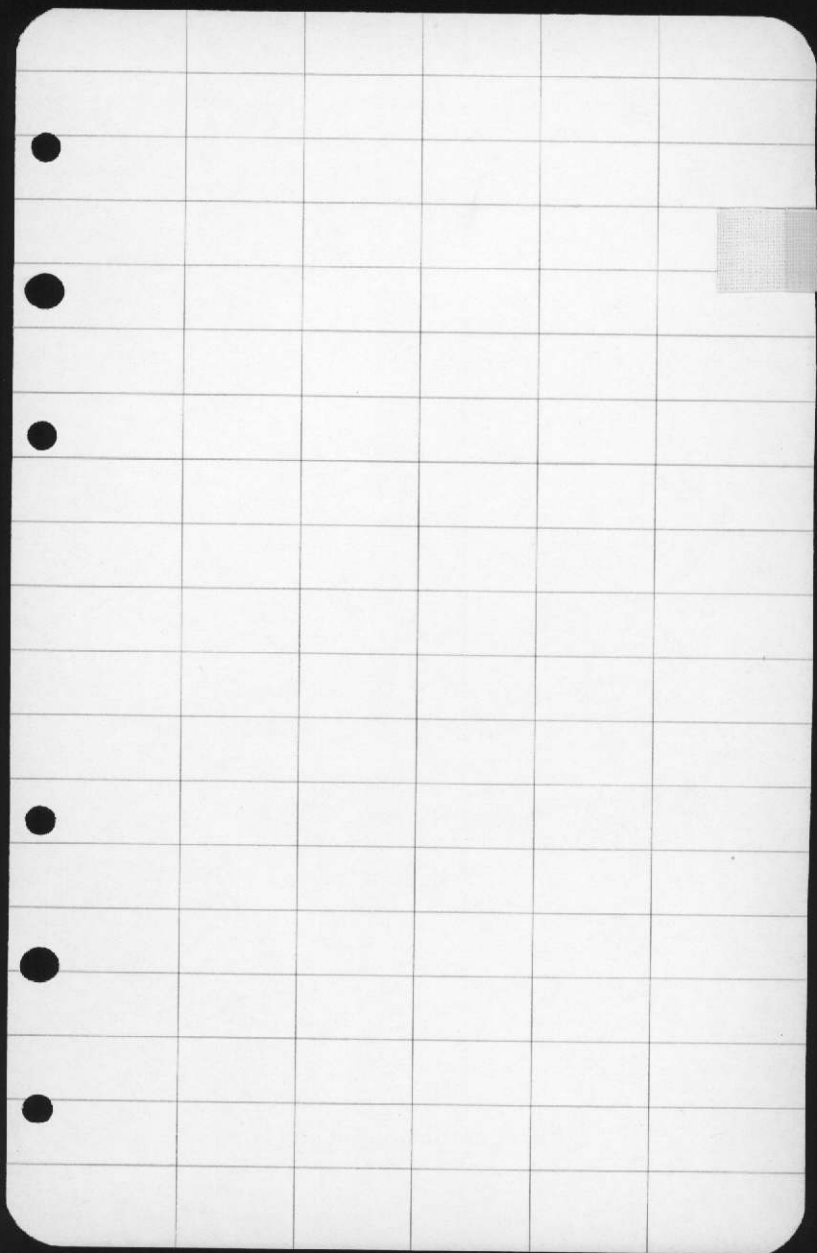


WELL  
"E-1"

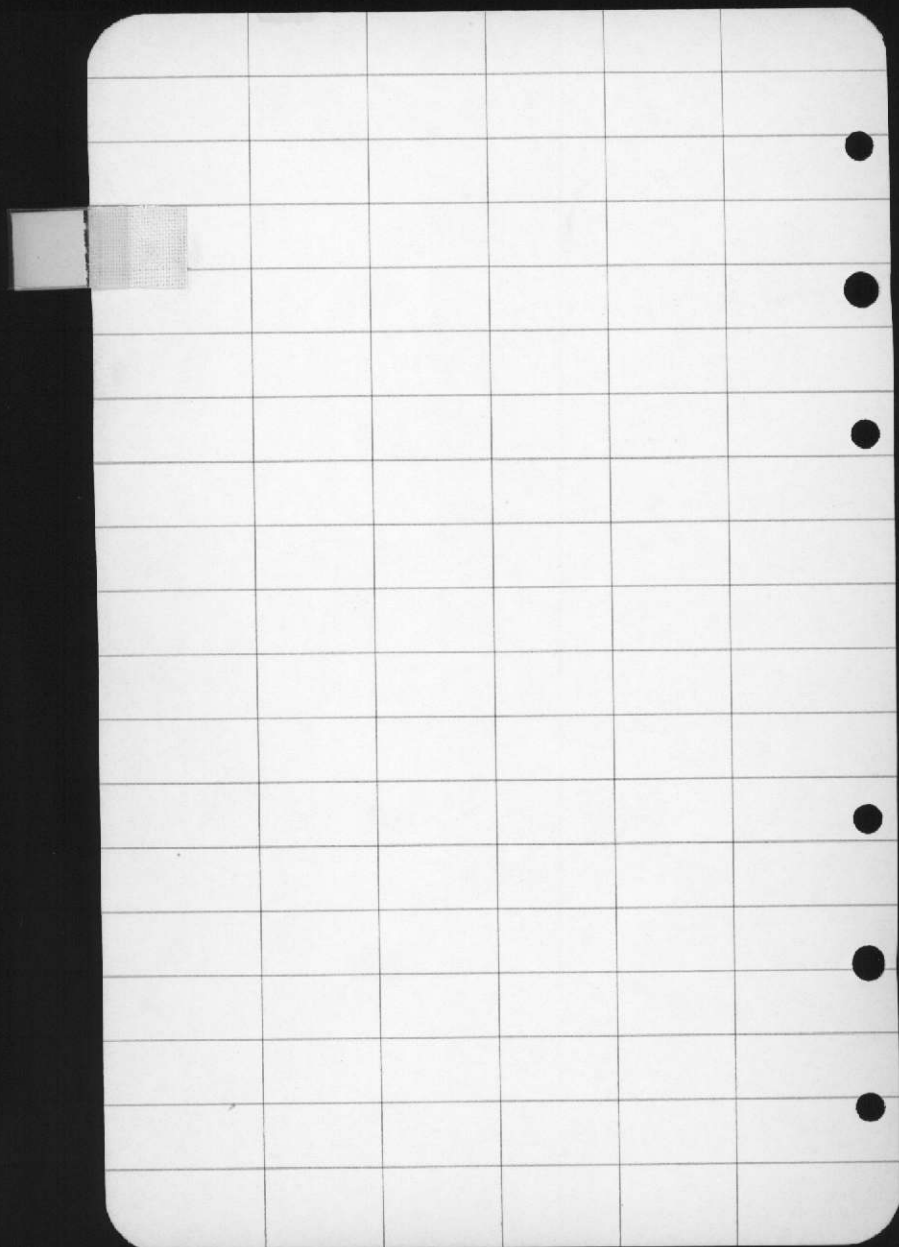





100 G.P.M. - Dual Drive - 7-1/2 H.P.

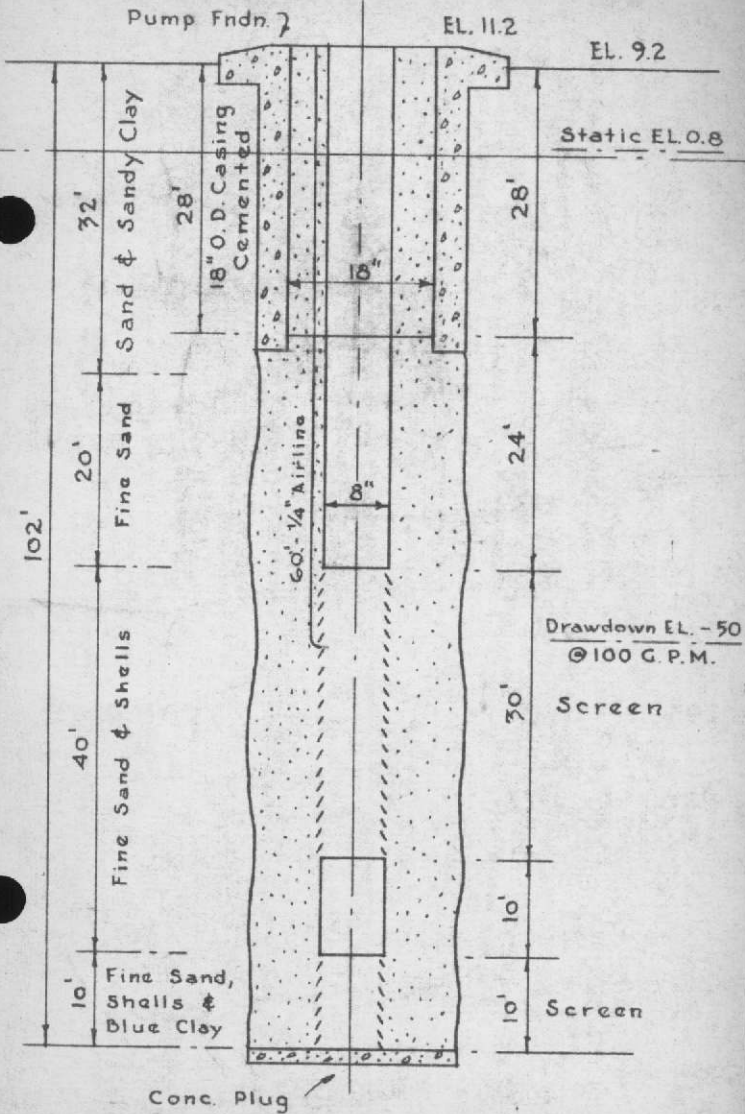


Armco Iron Screen Used in this Well  
Hospital Well "E-1"

 


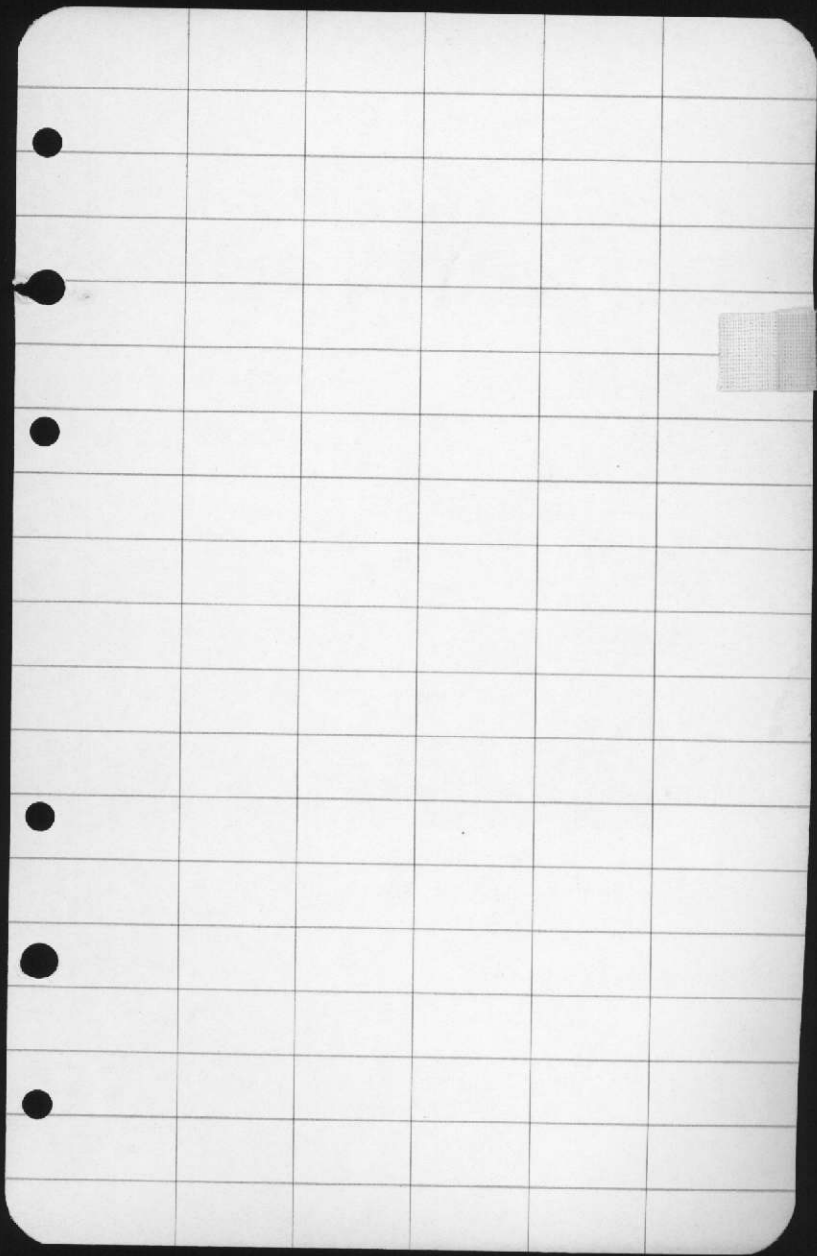


Well  
"R"

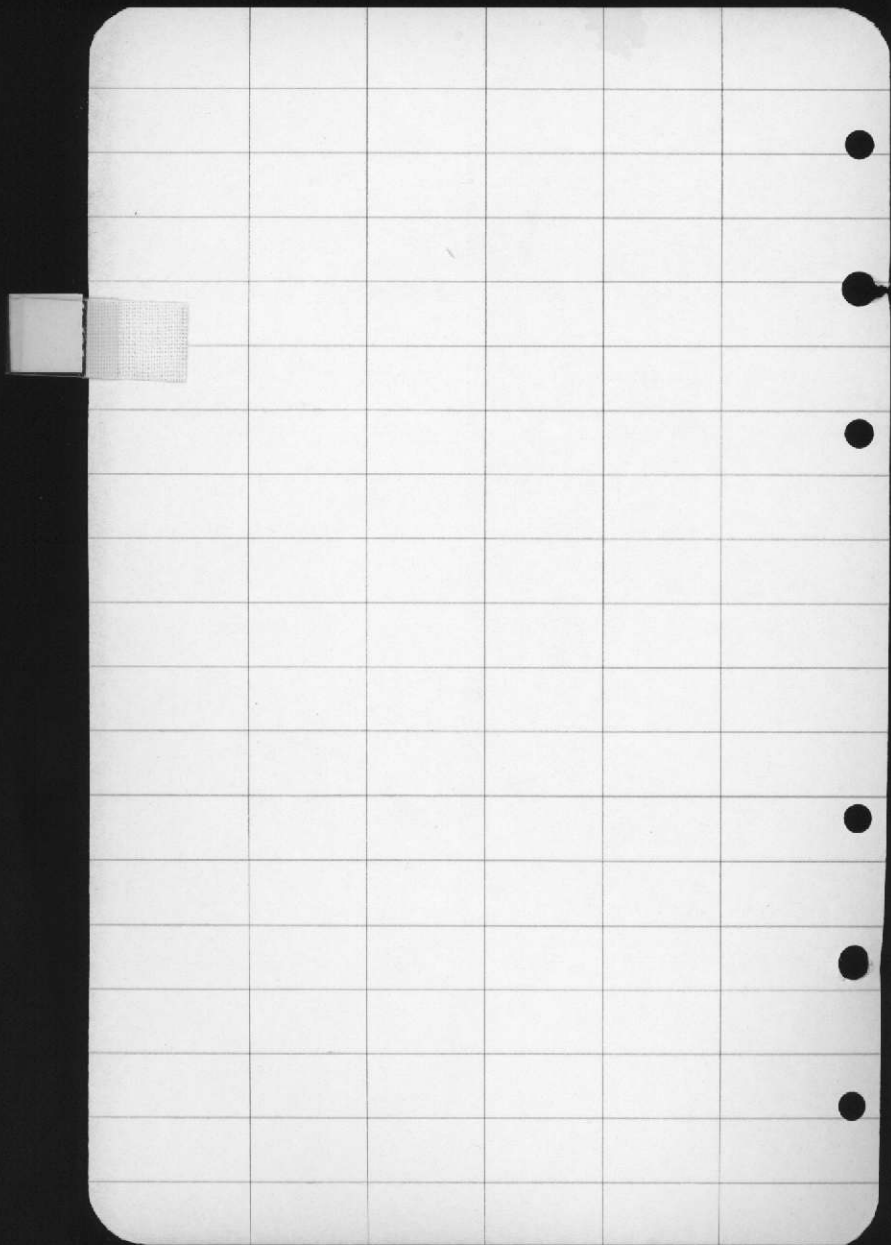



250 G.P.M. - Dual Drive - 20 H.P.

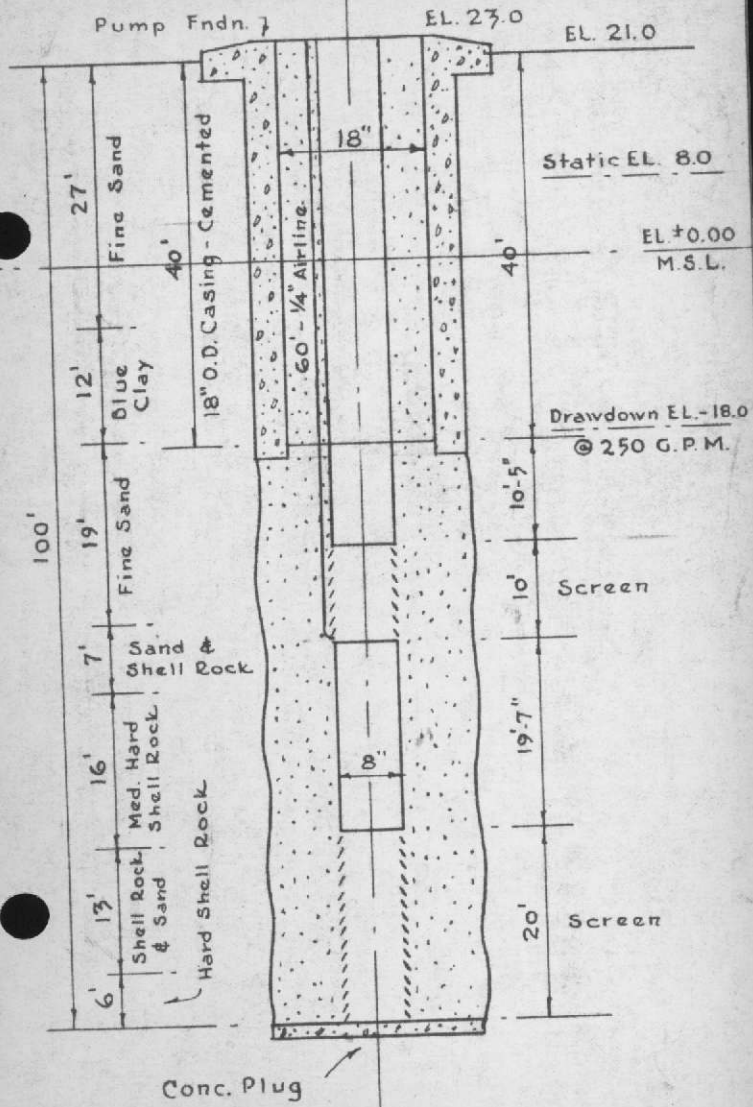


Paradise Point Well "R"

 


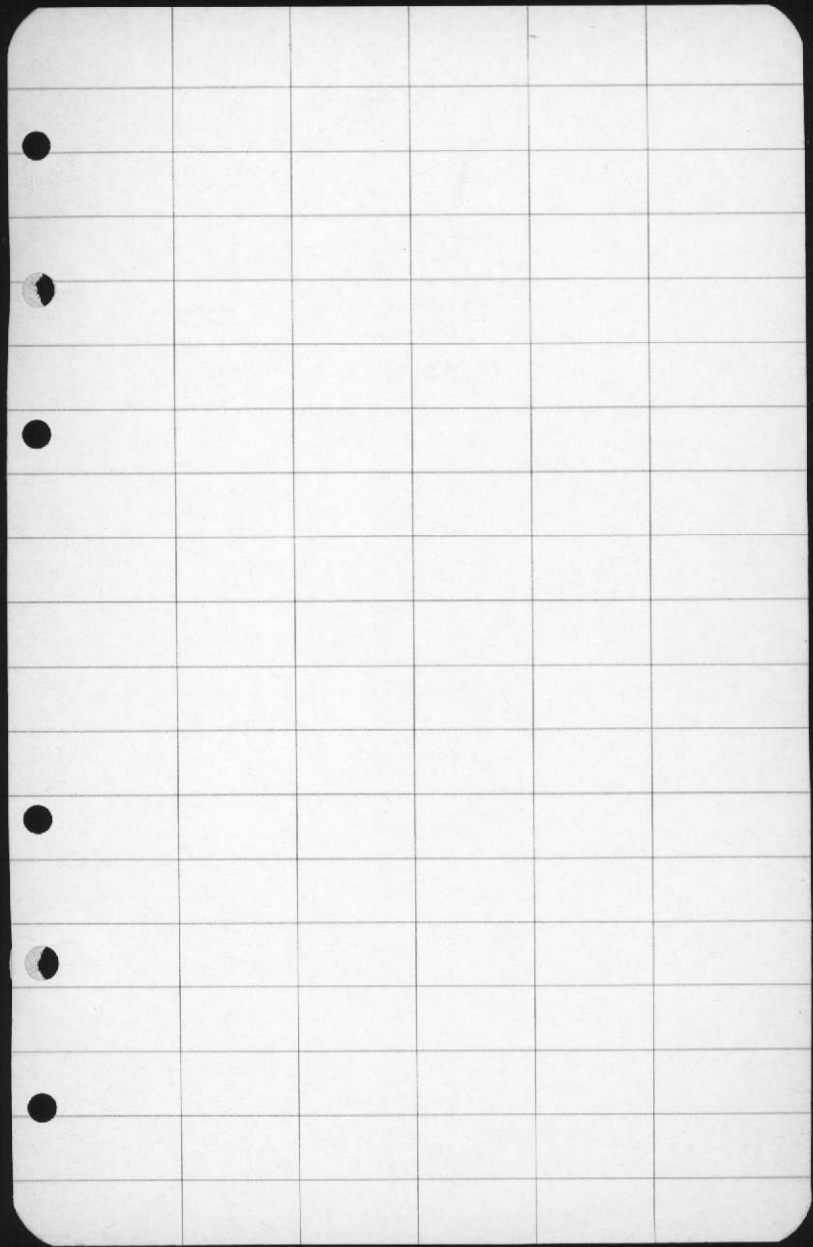


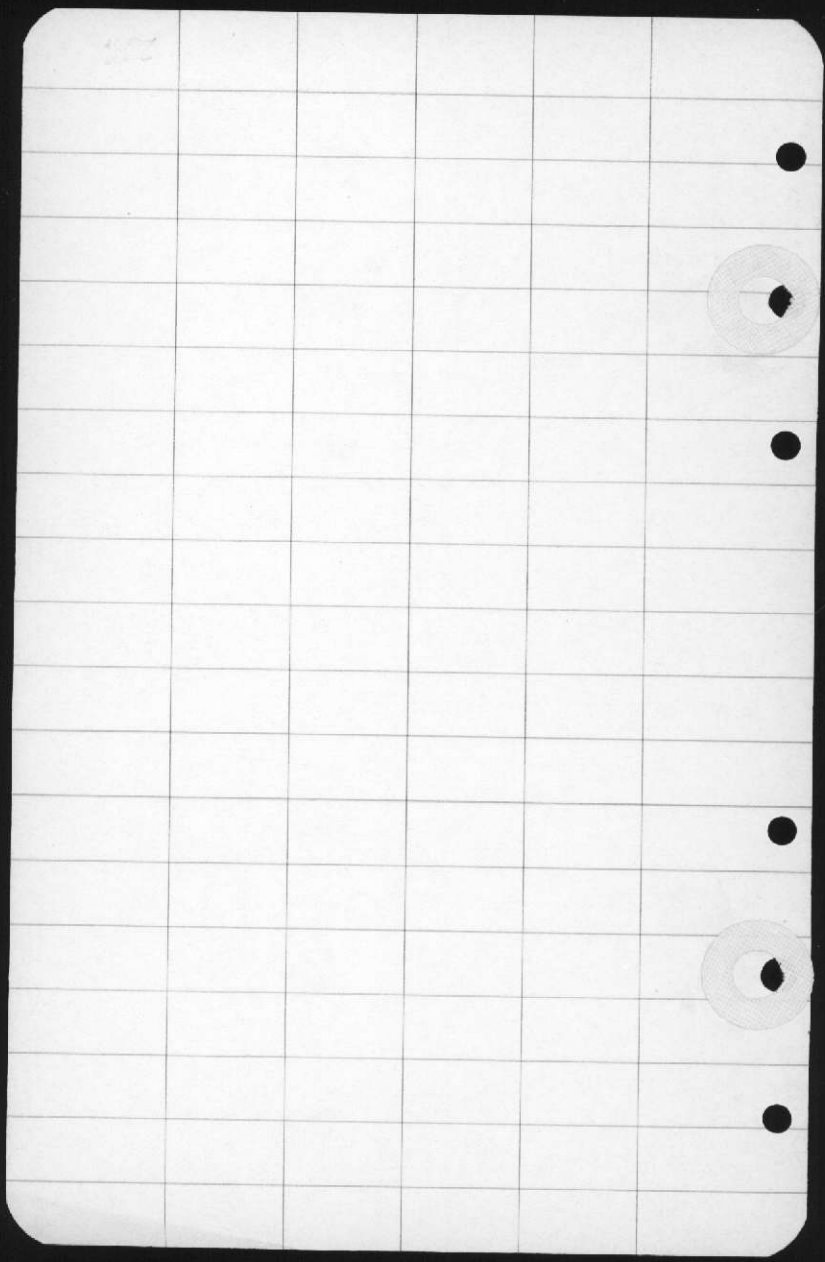





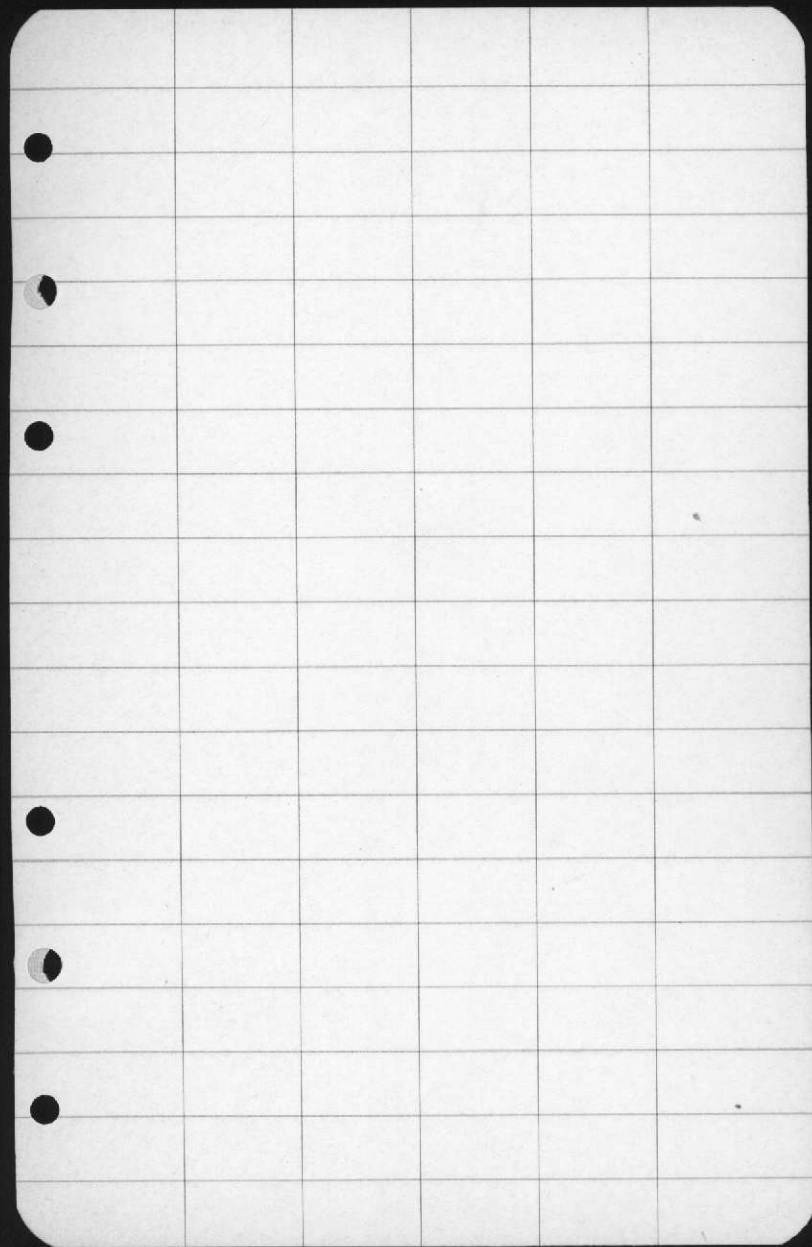


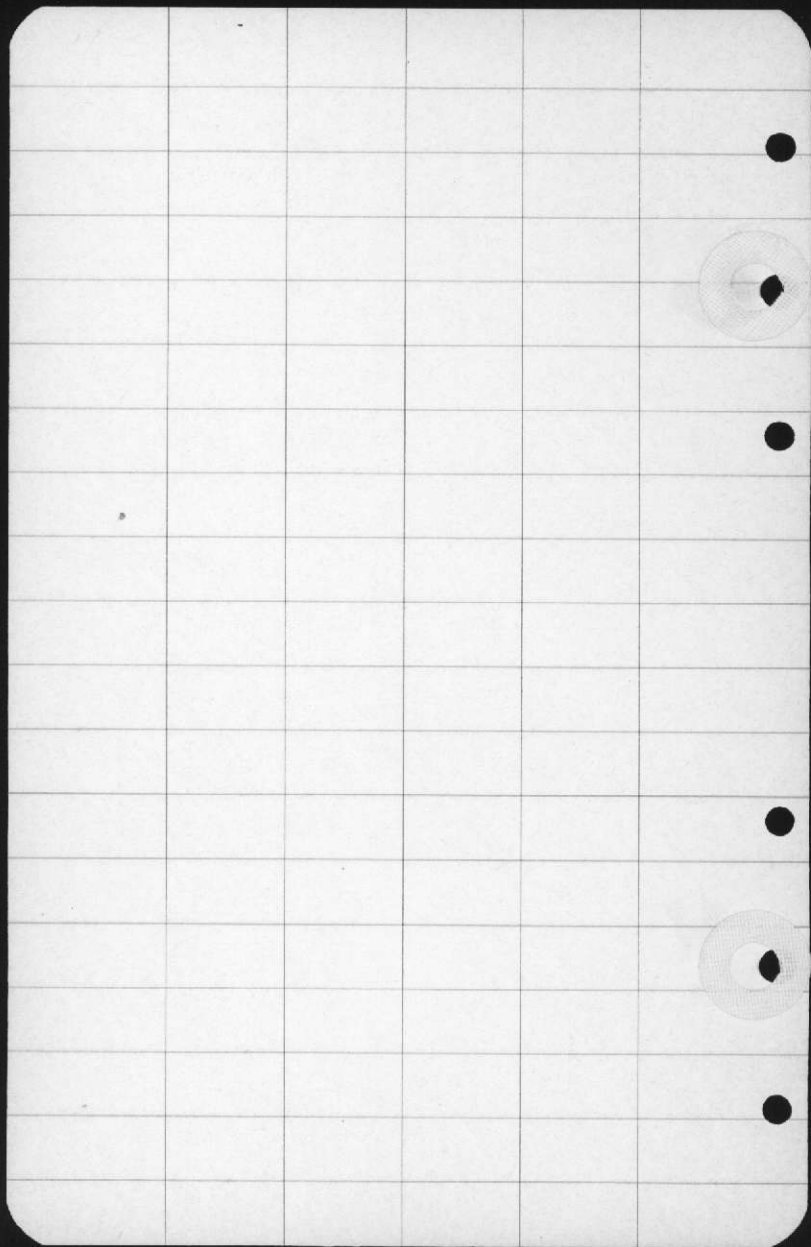


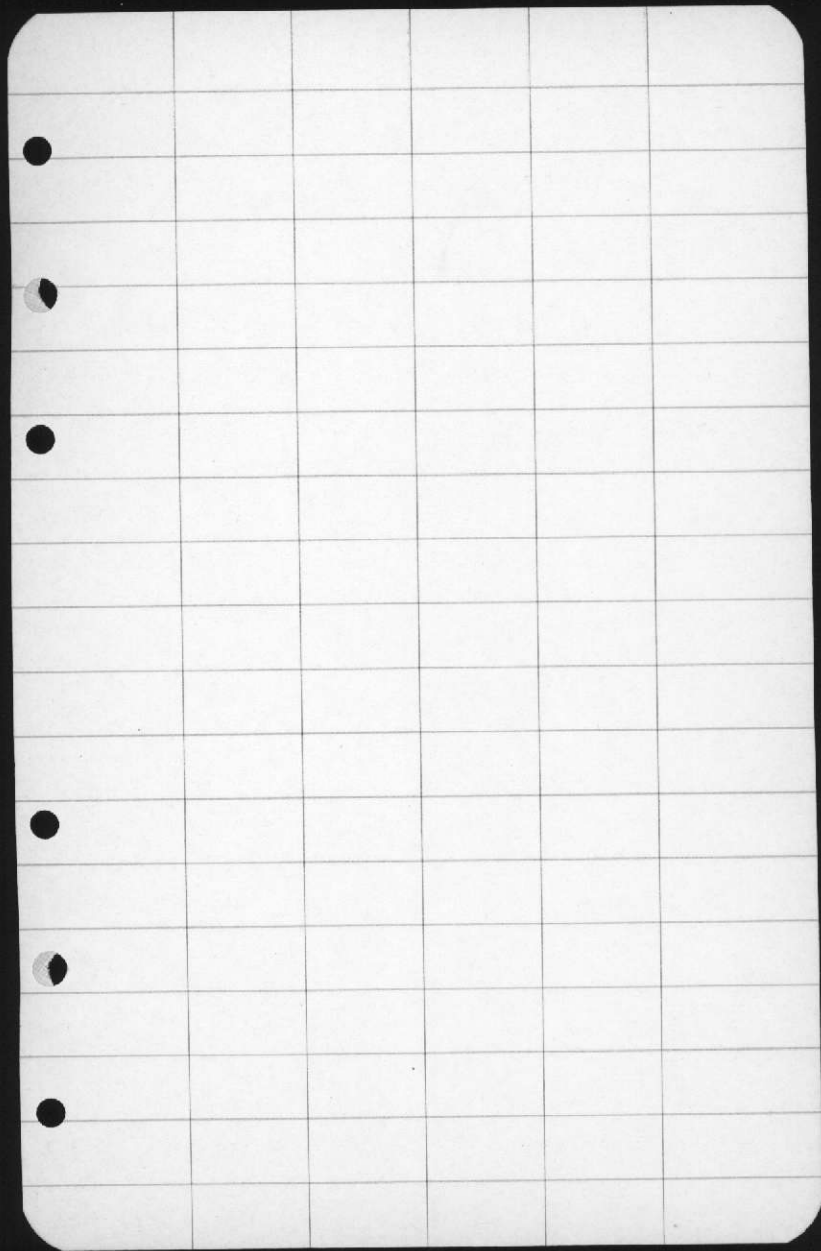

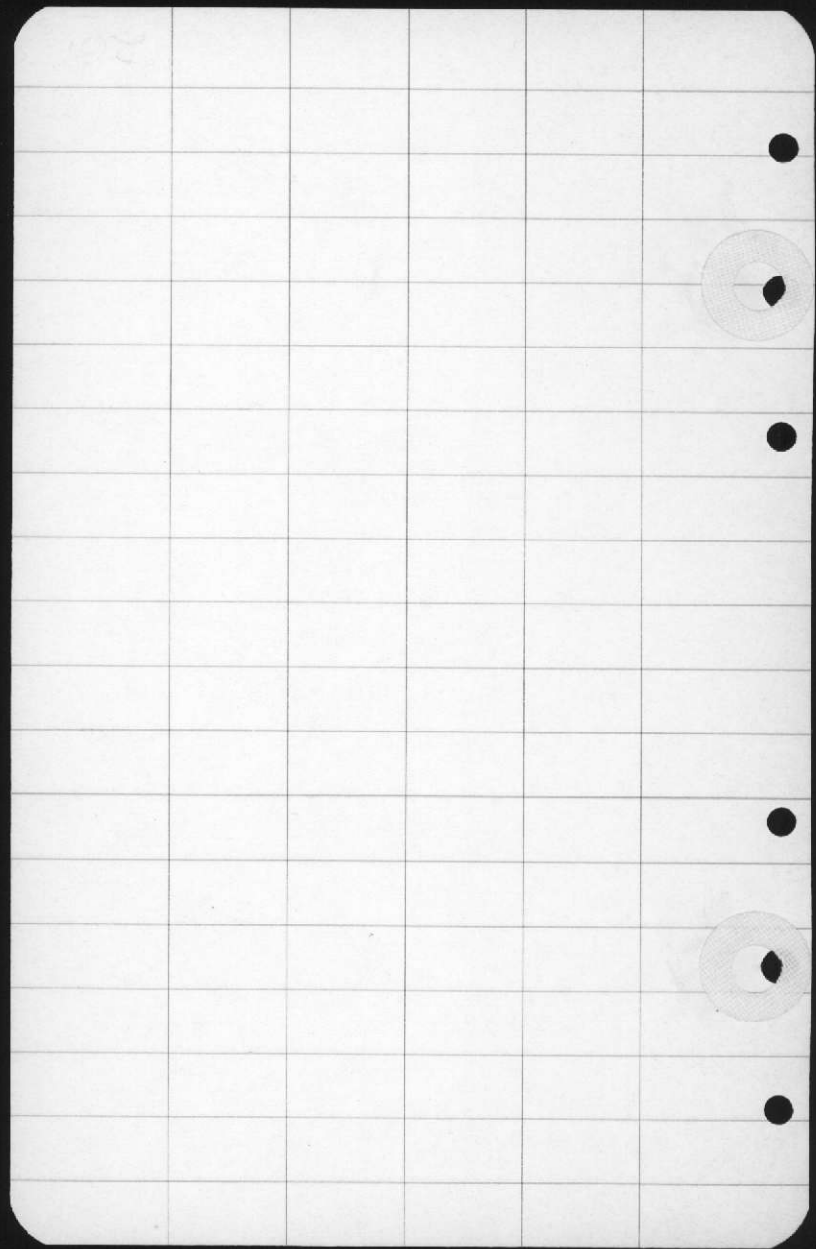


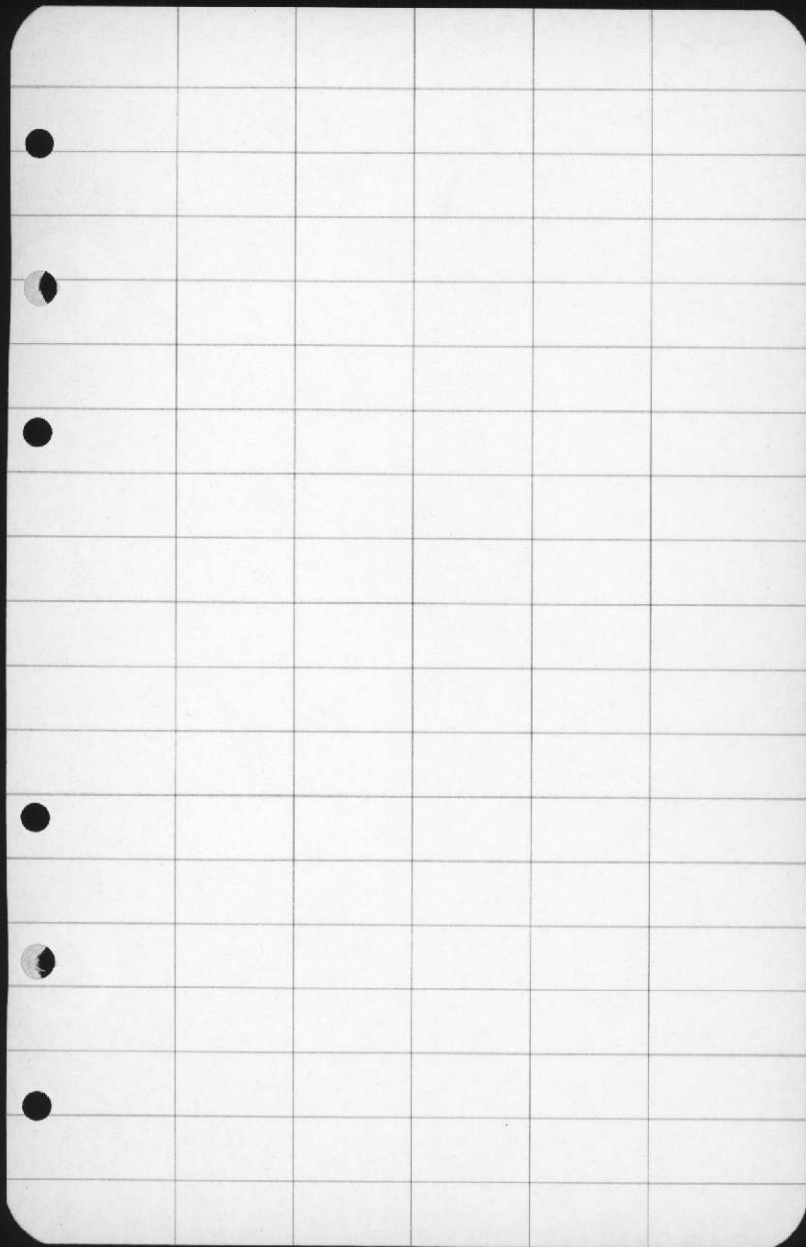

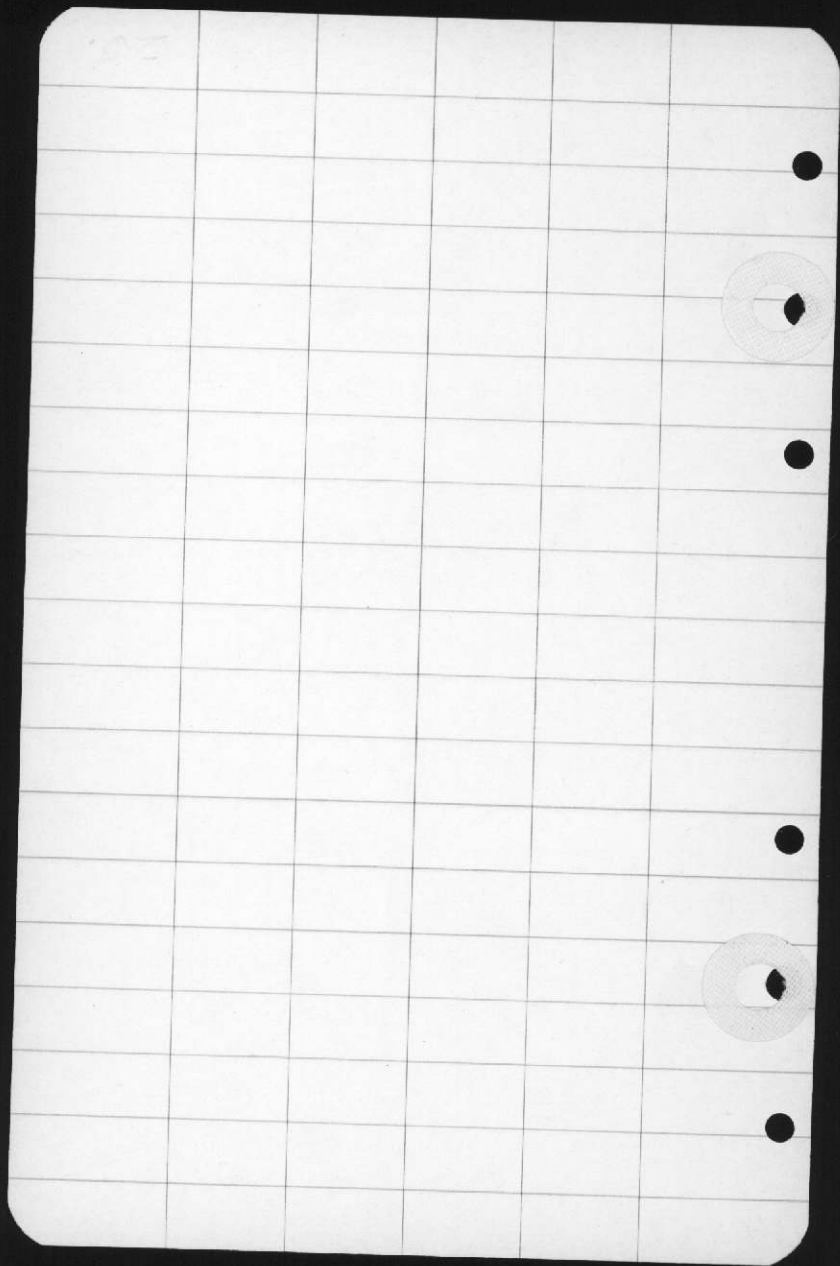


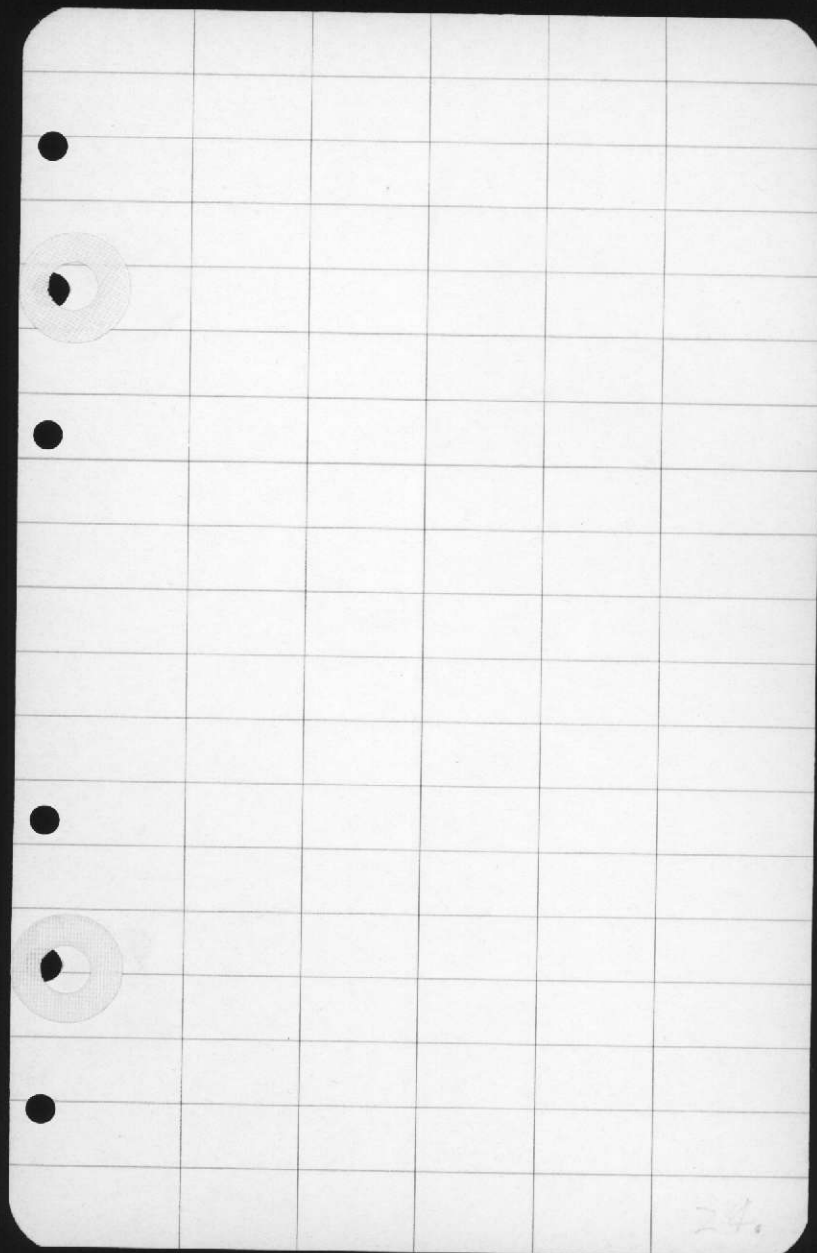



24.

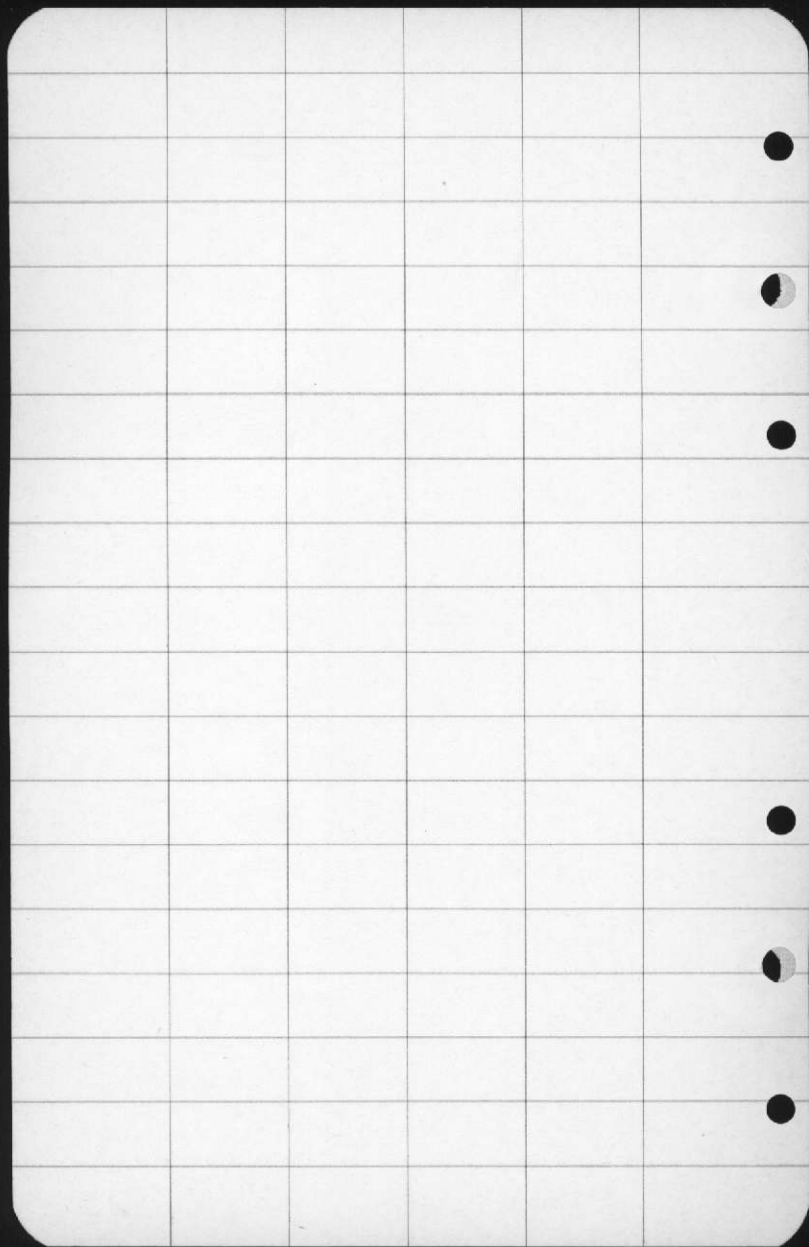





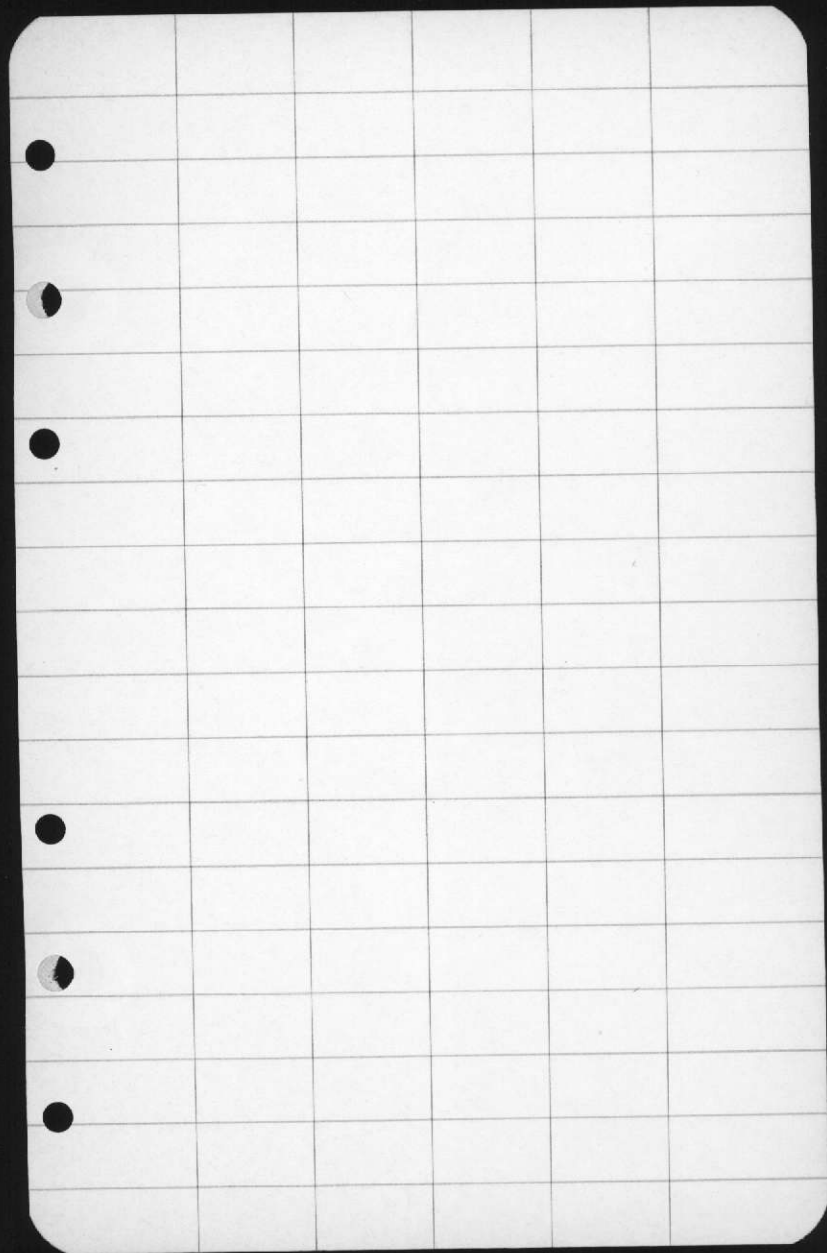


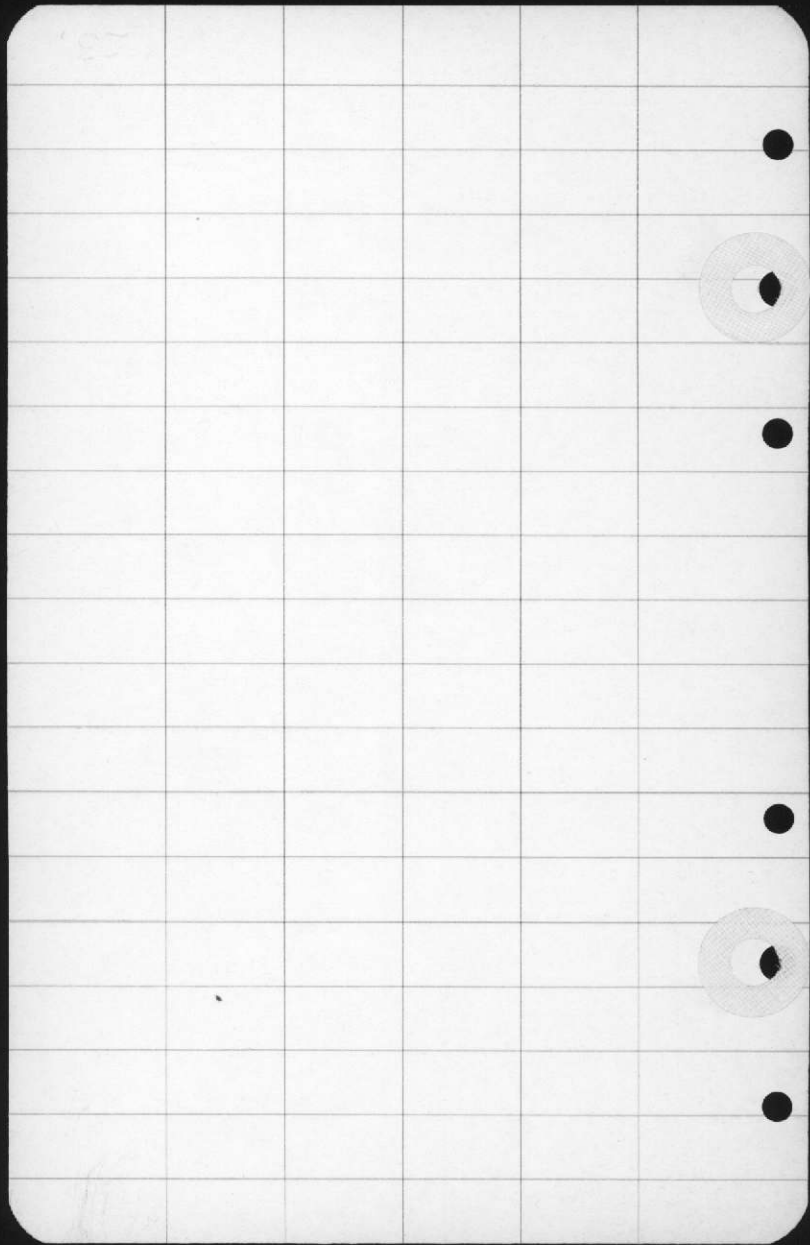


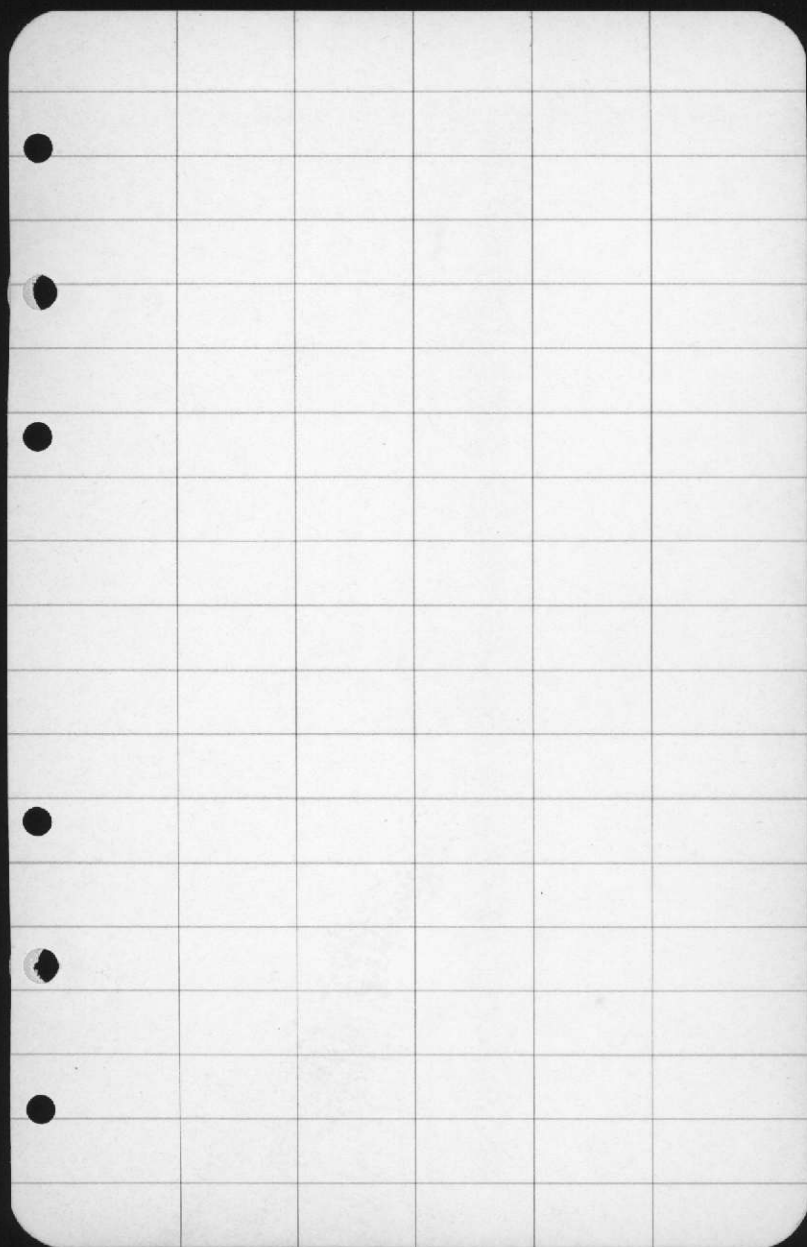


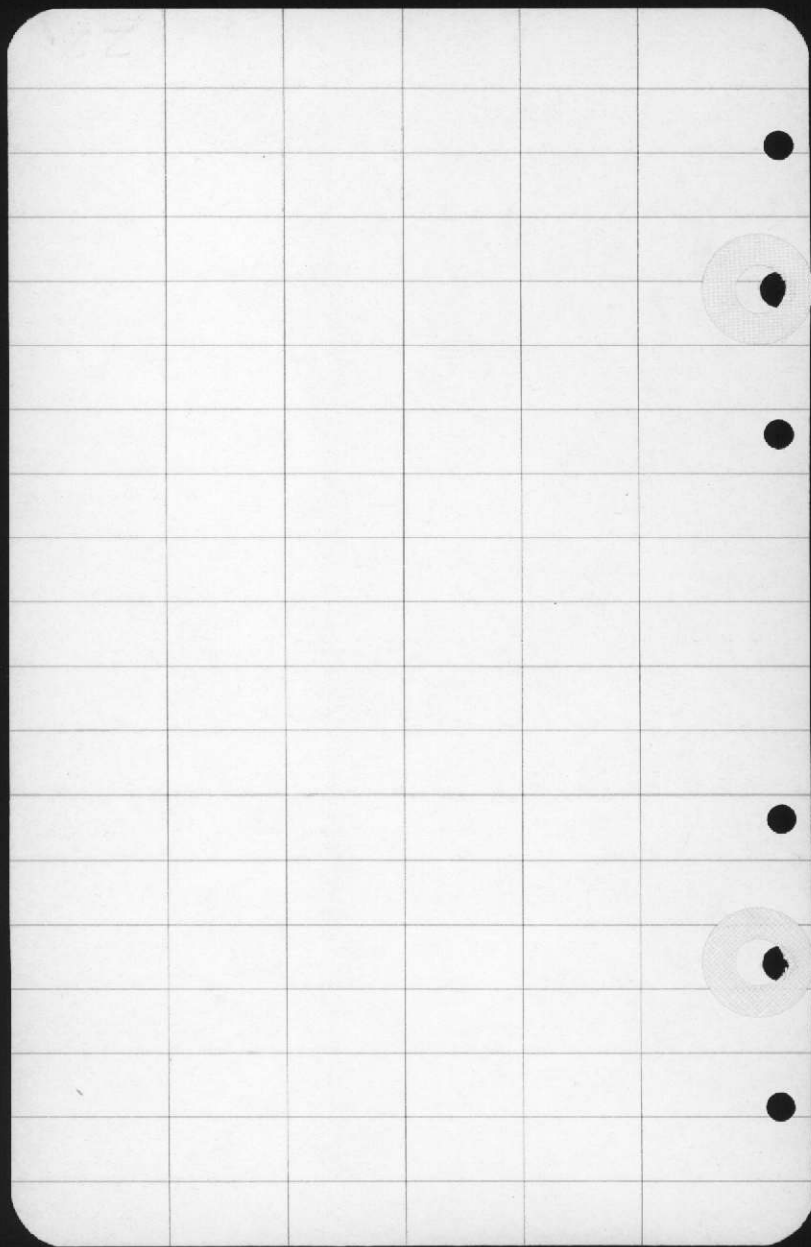

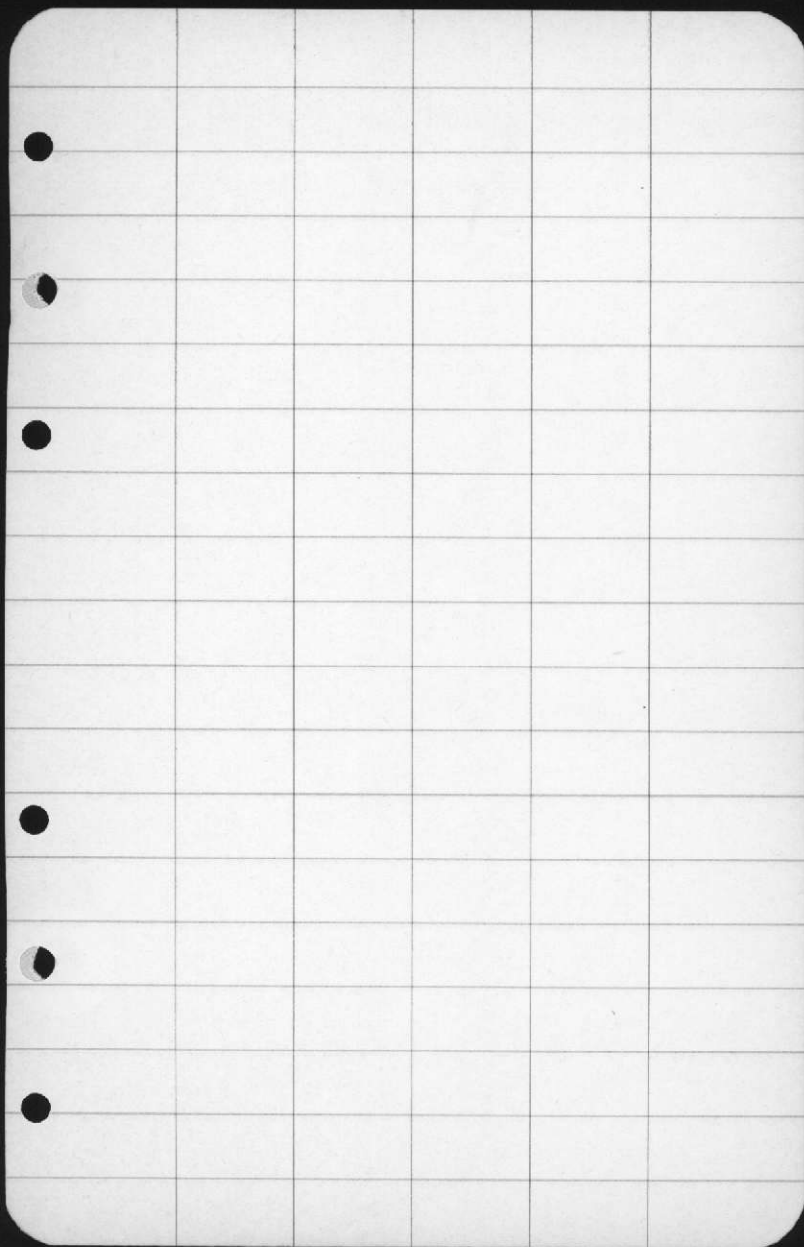


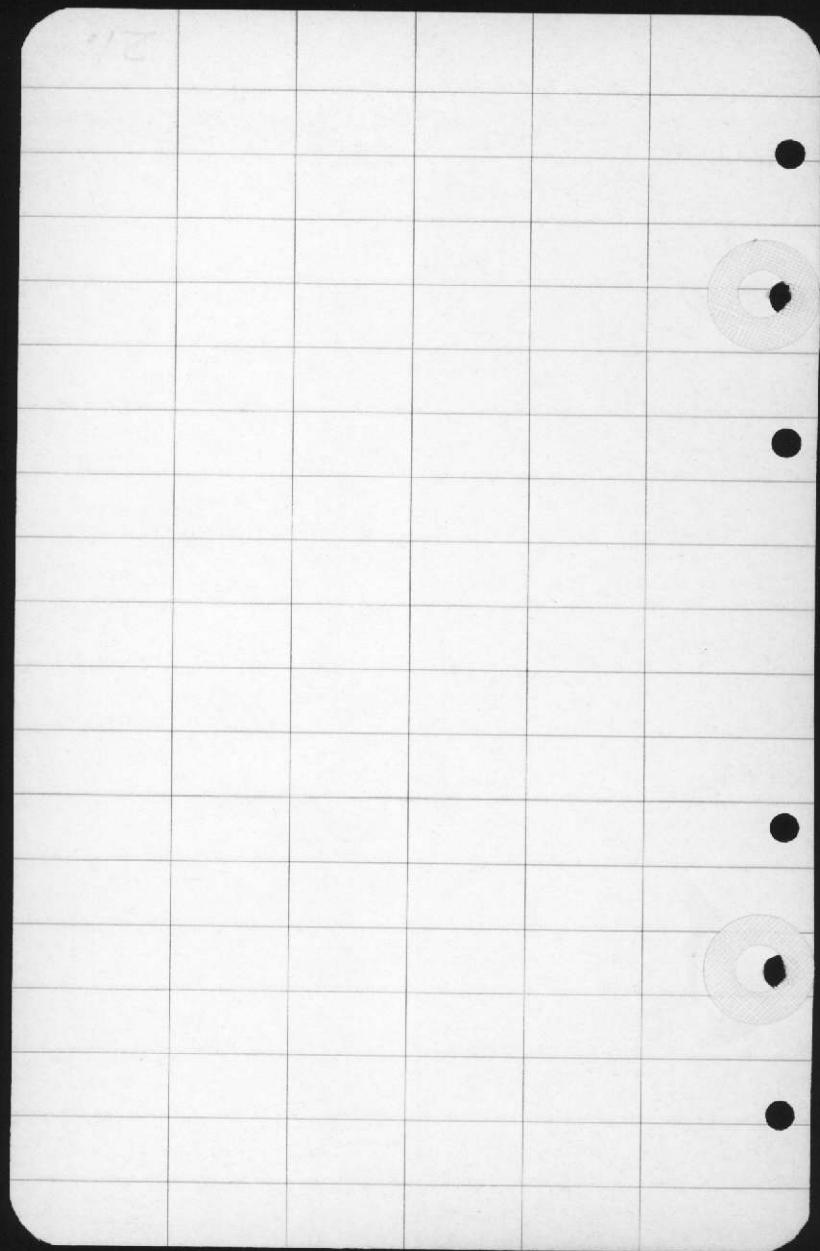


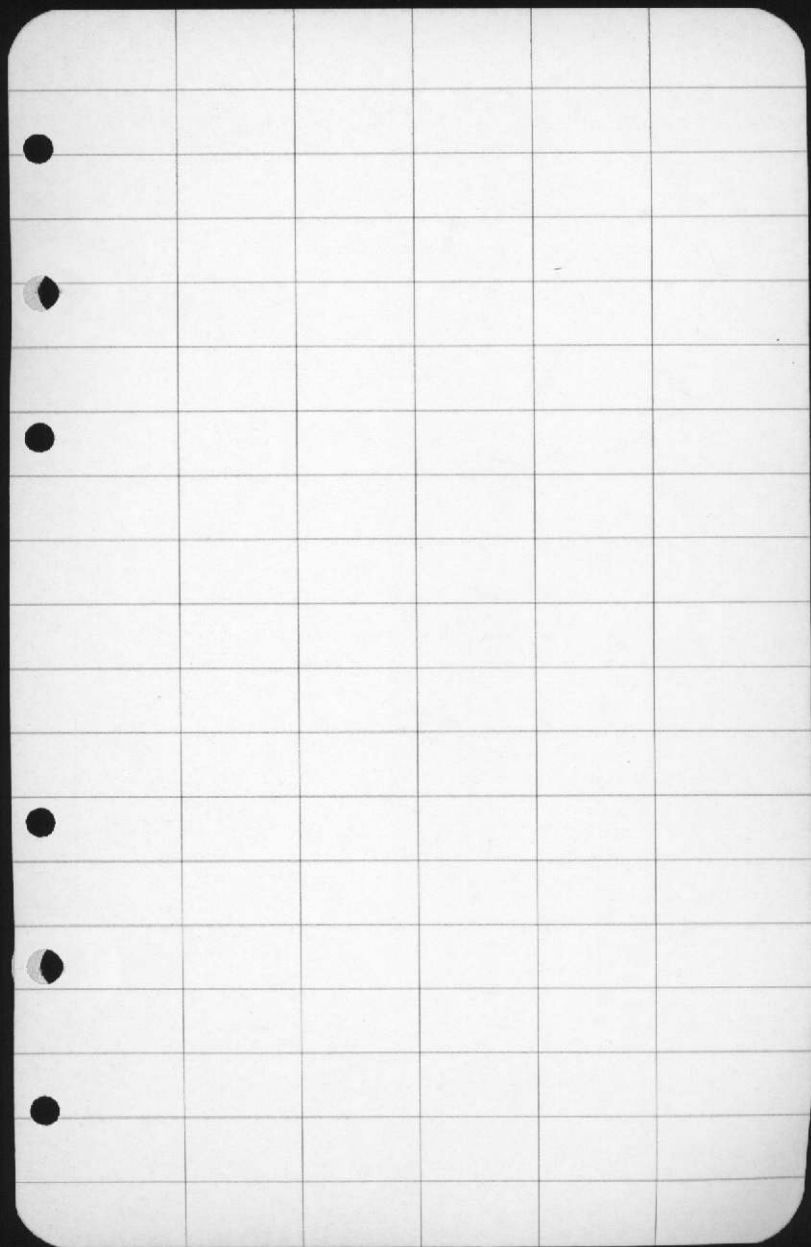


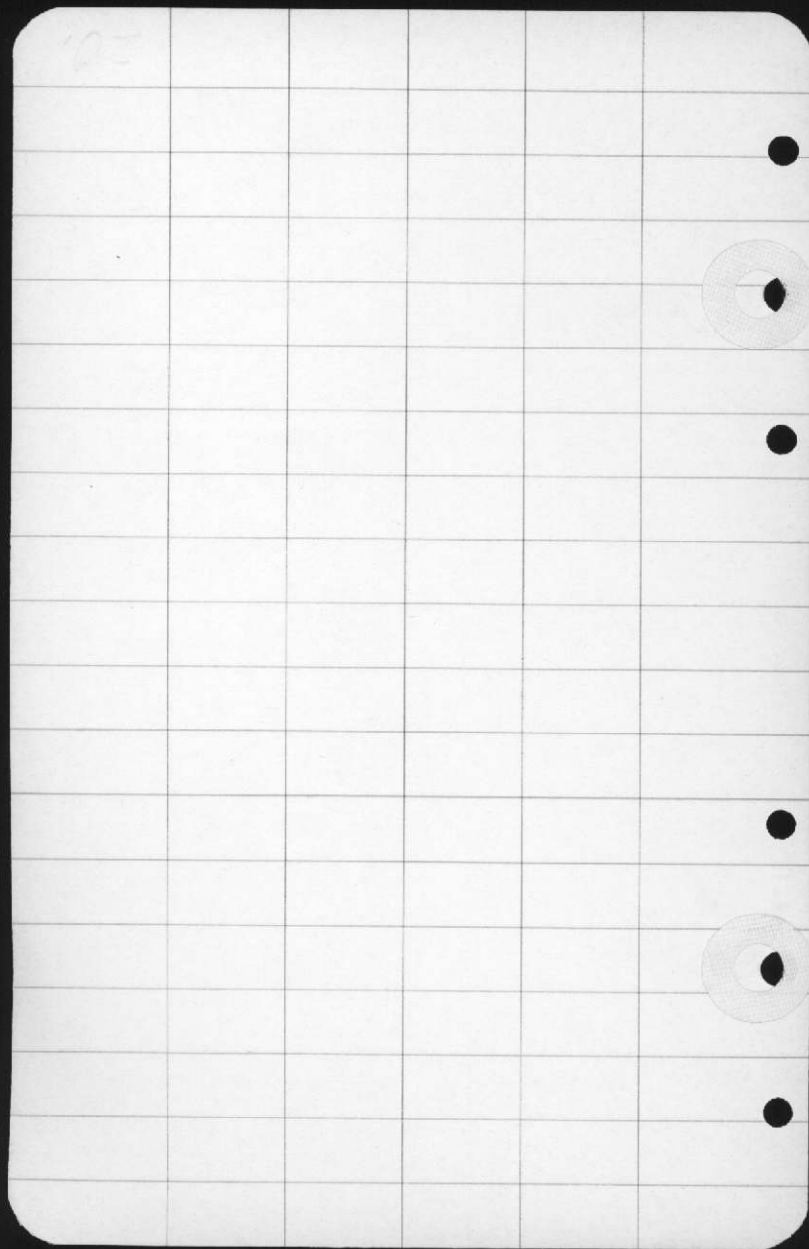




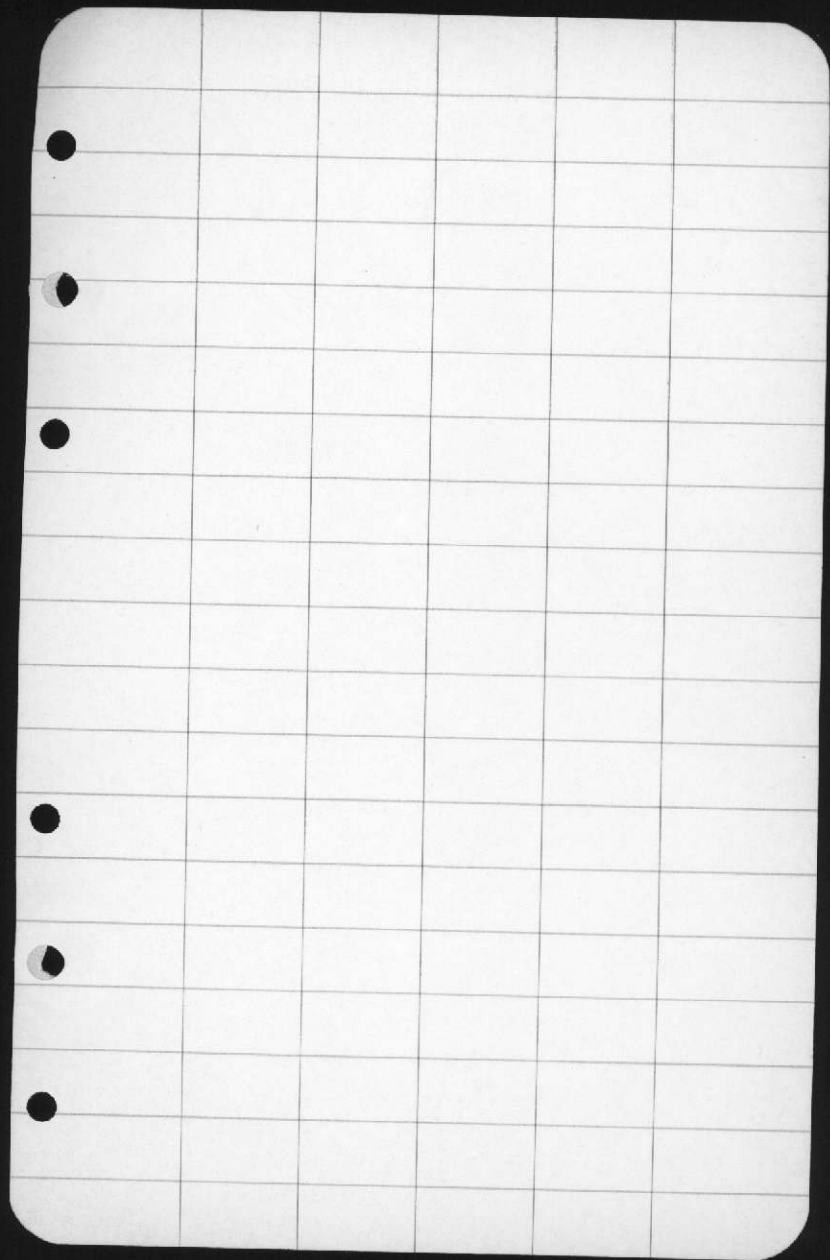


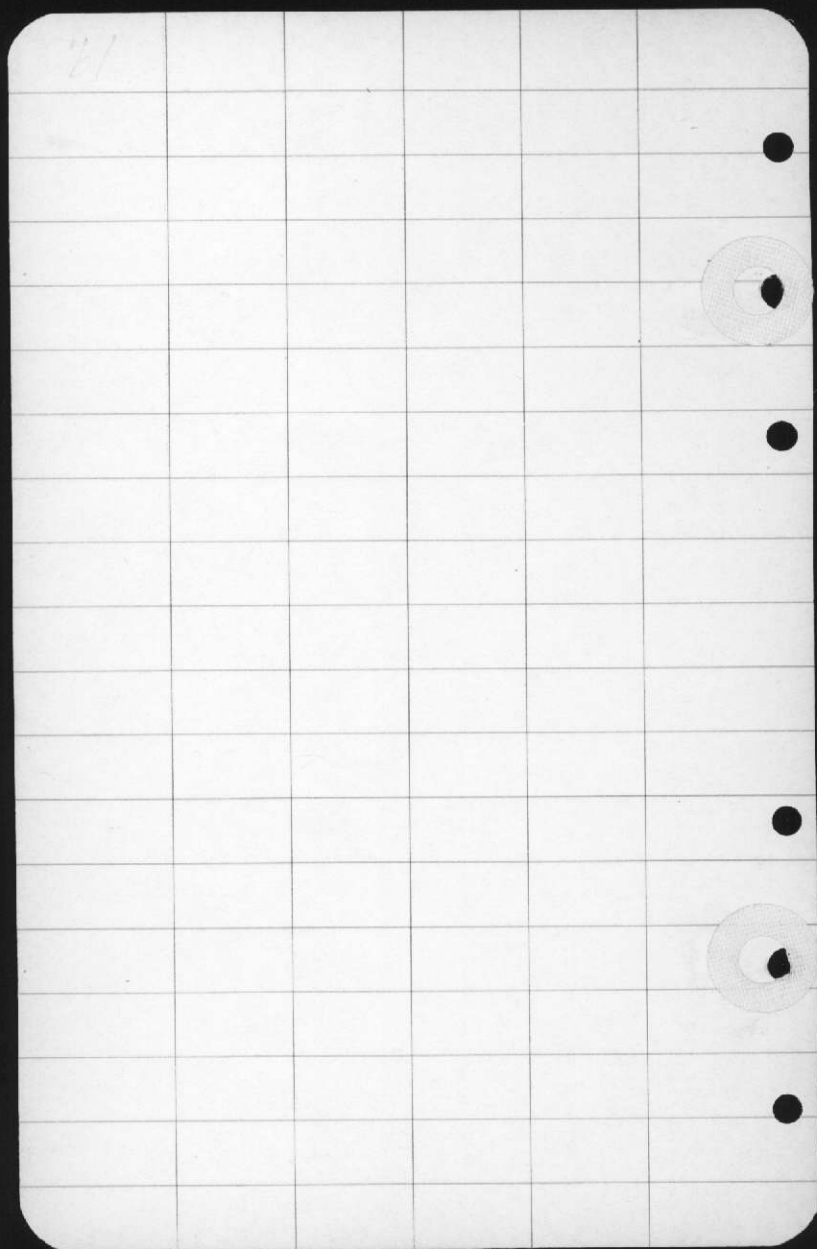


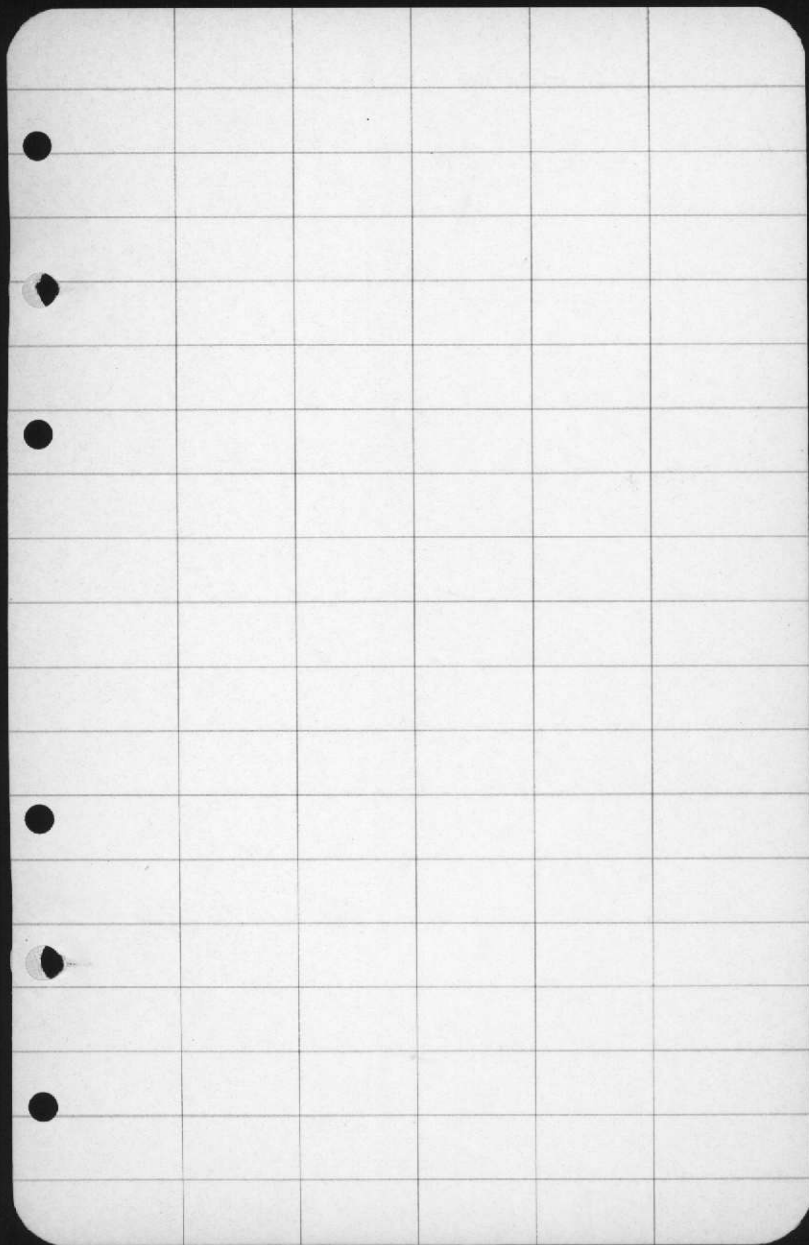




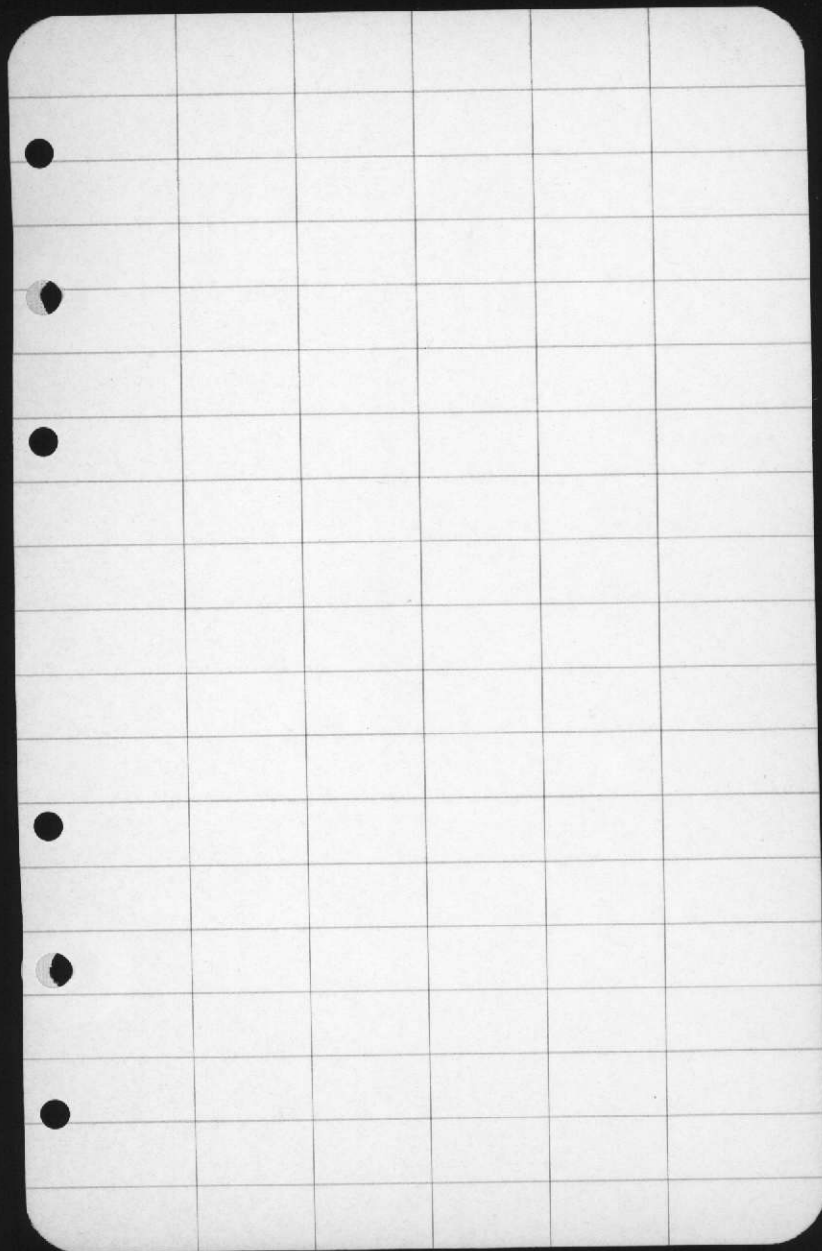


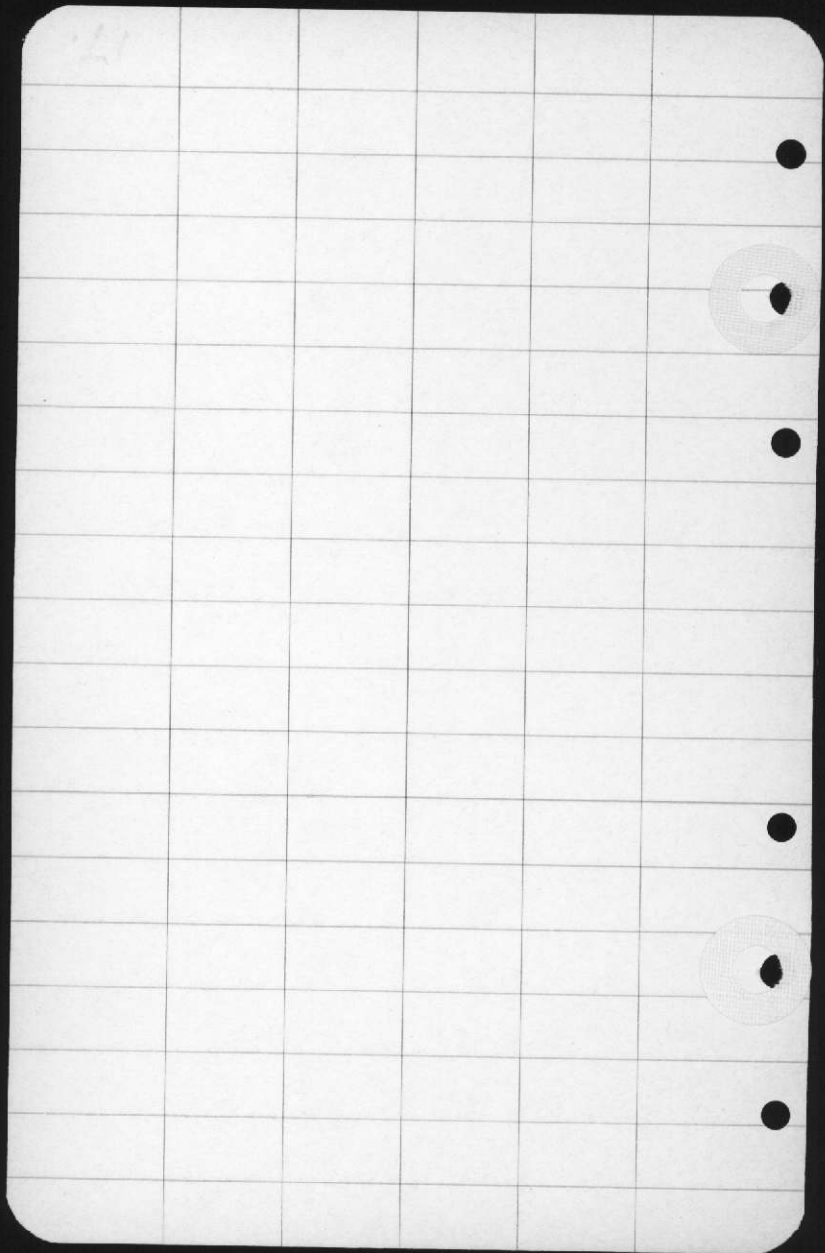


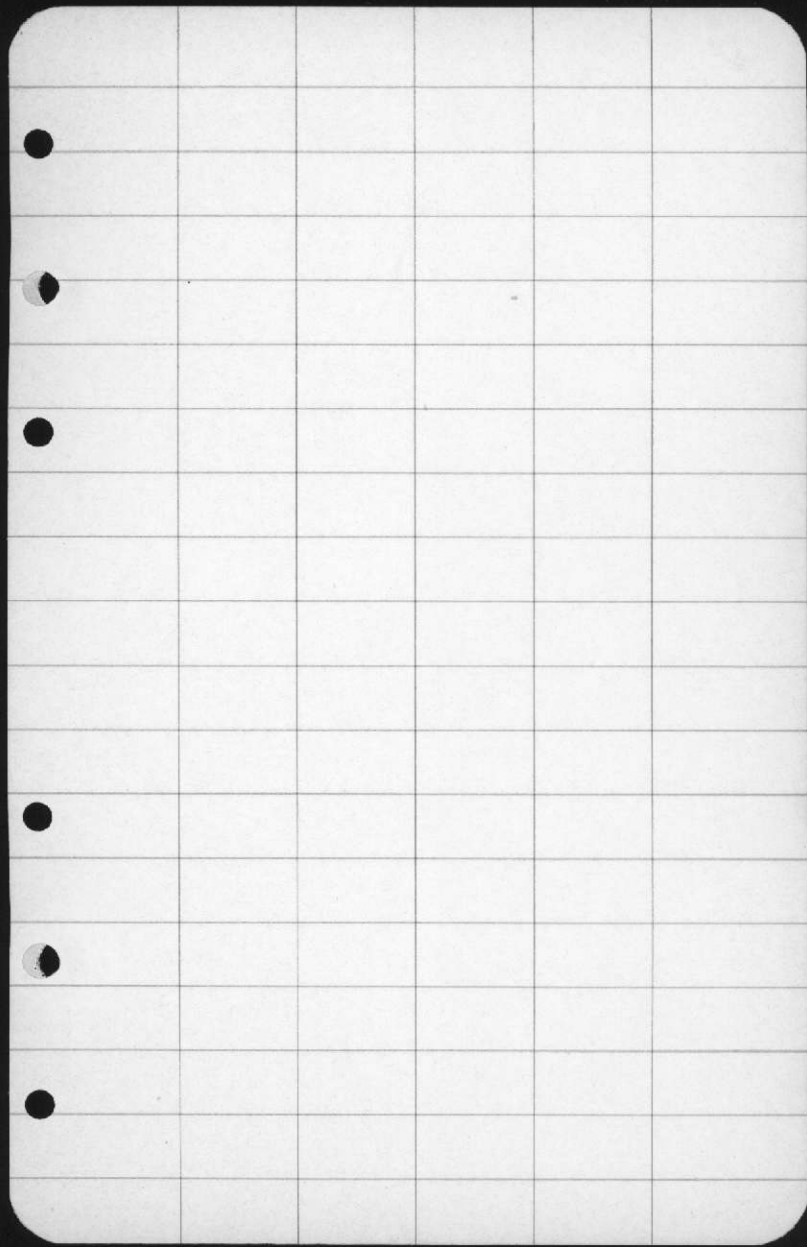


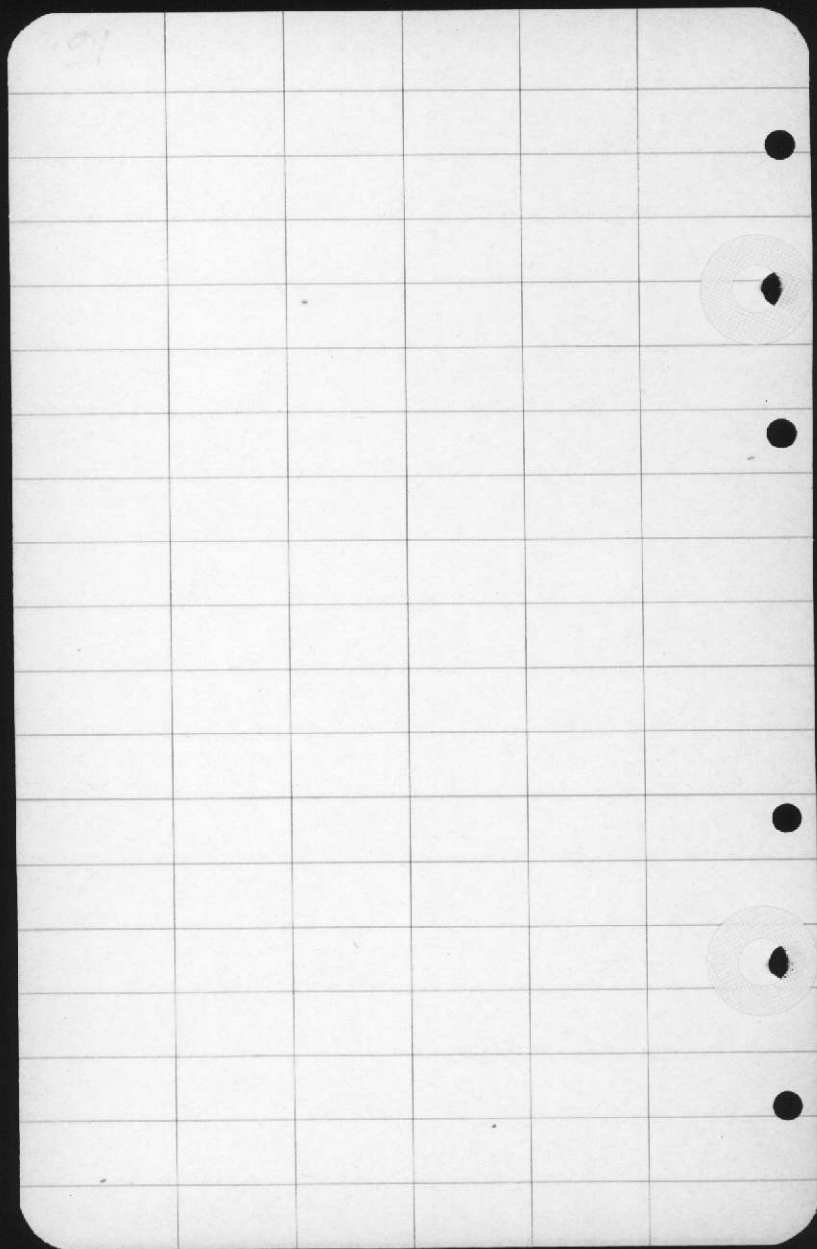




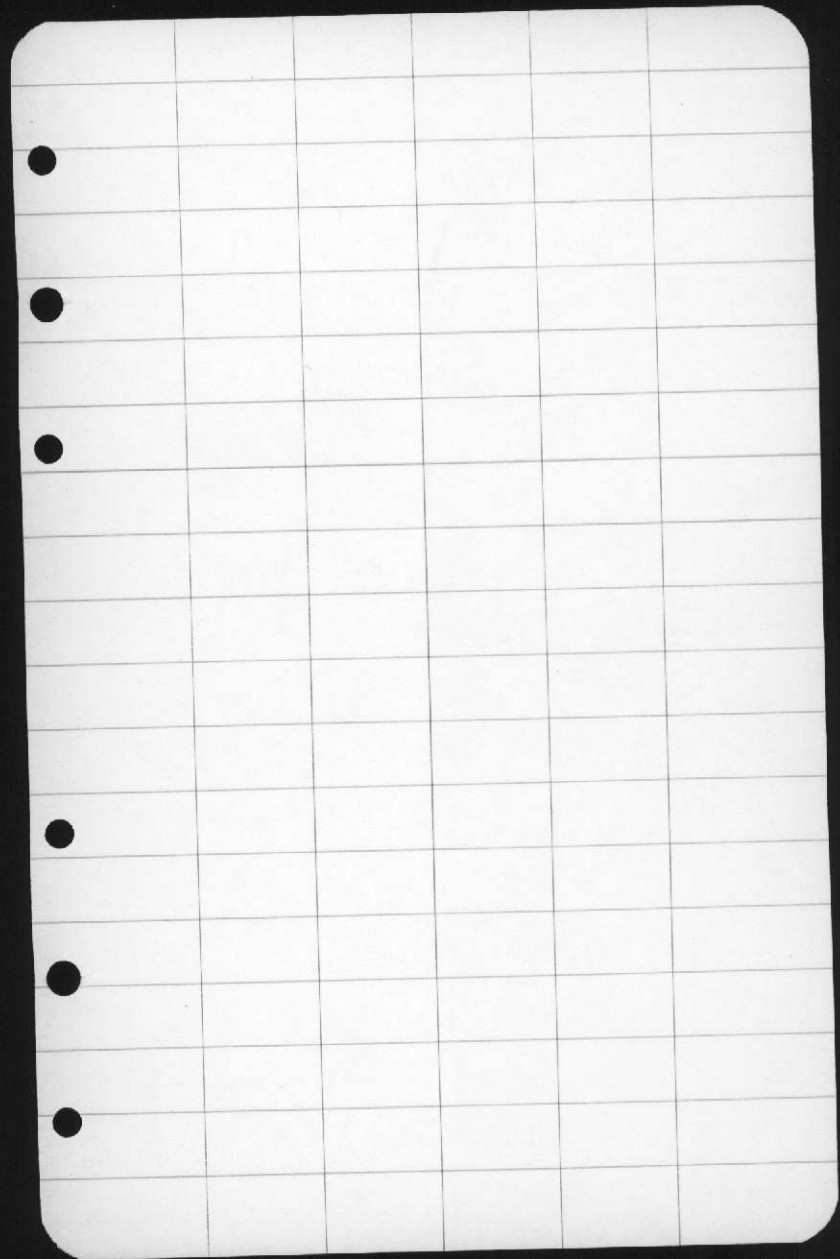


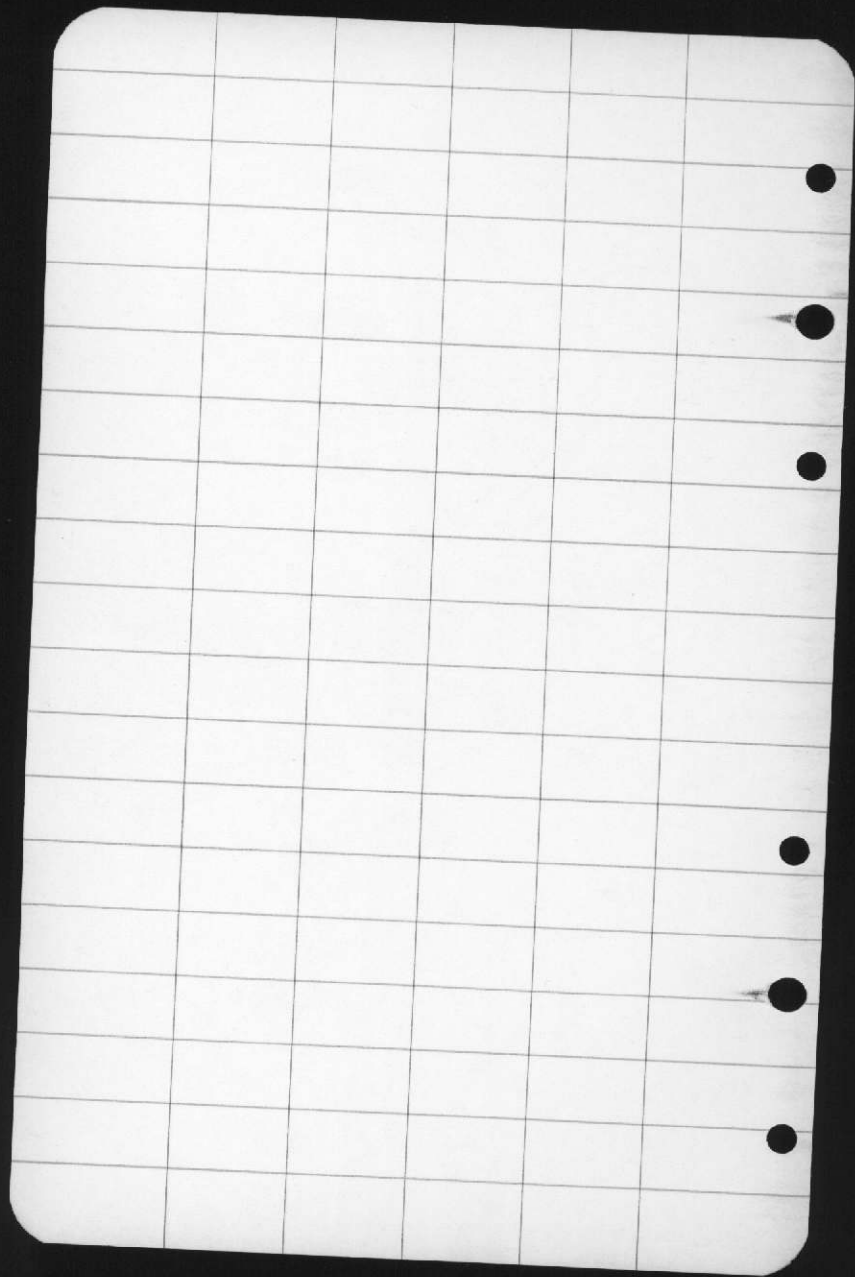


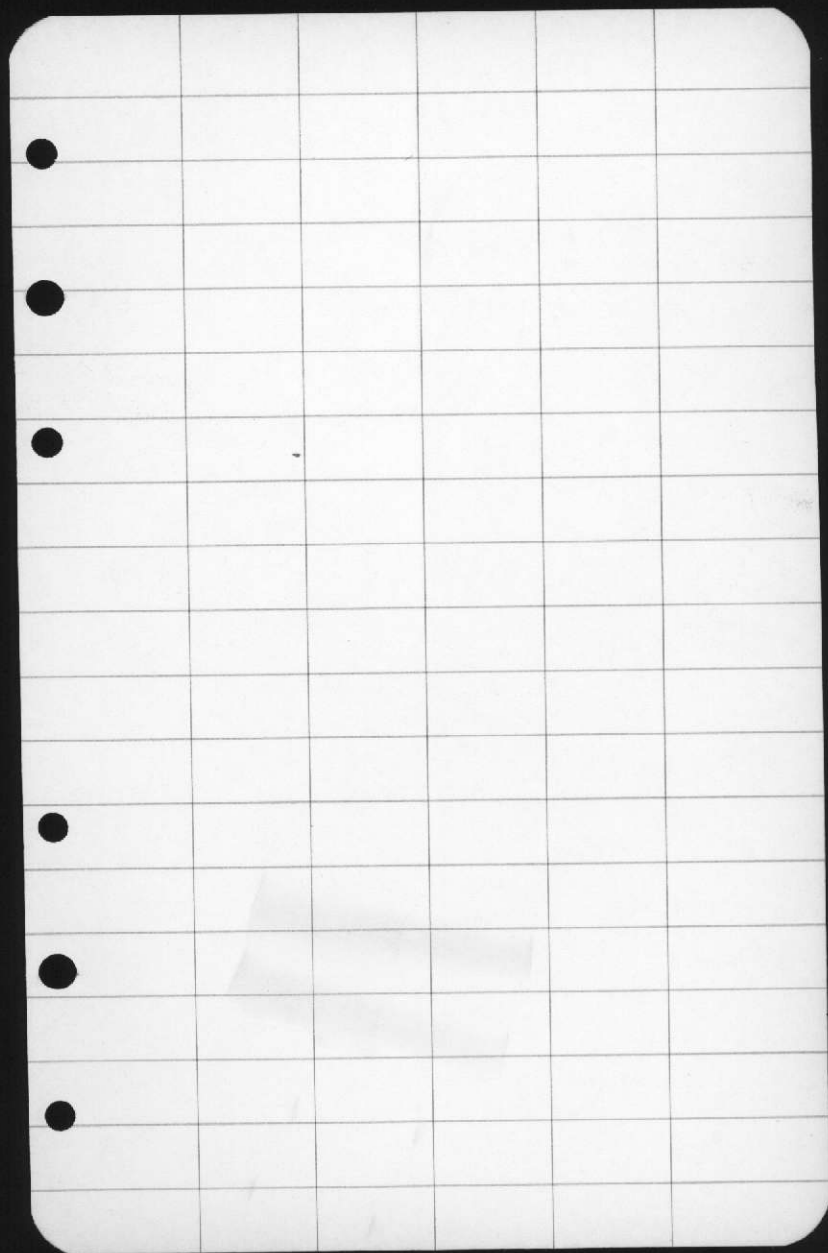




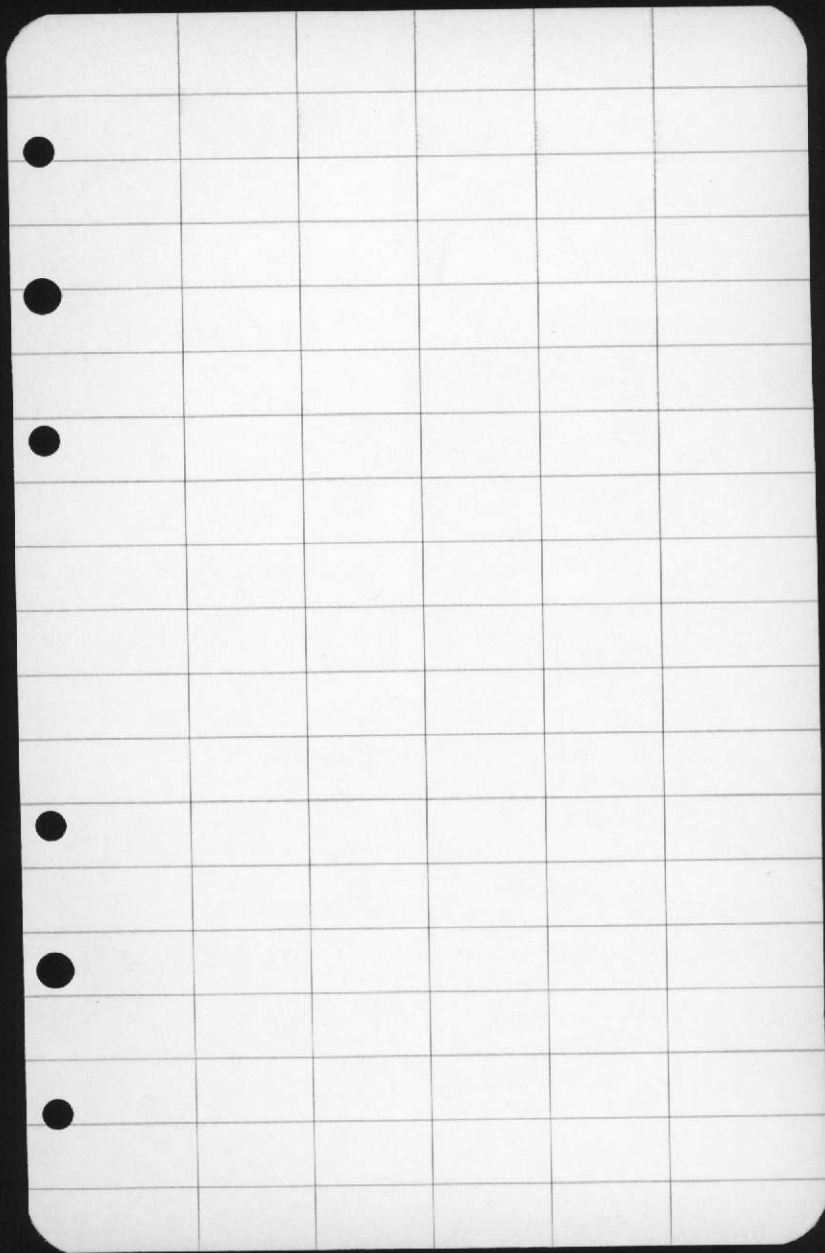


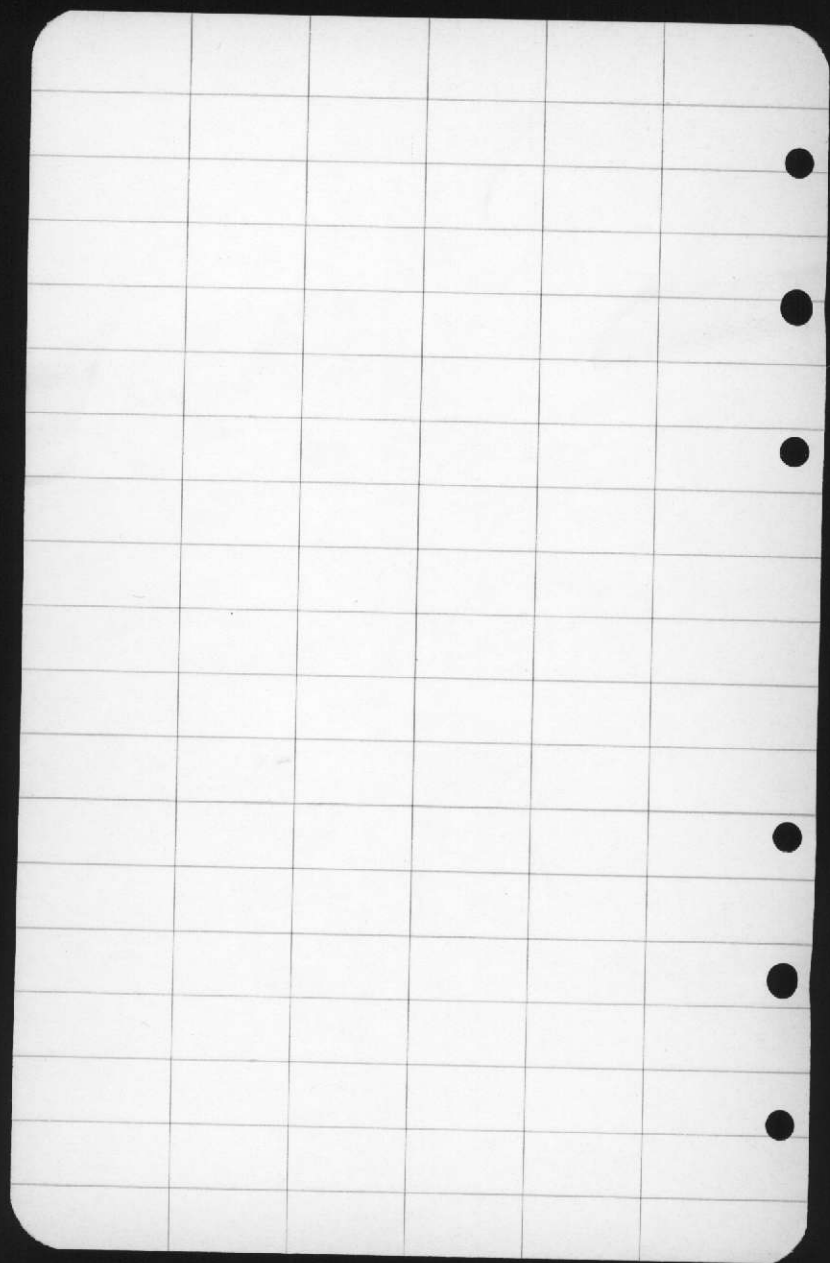


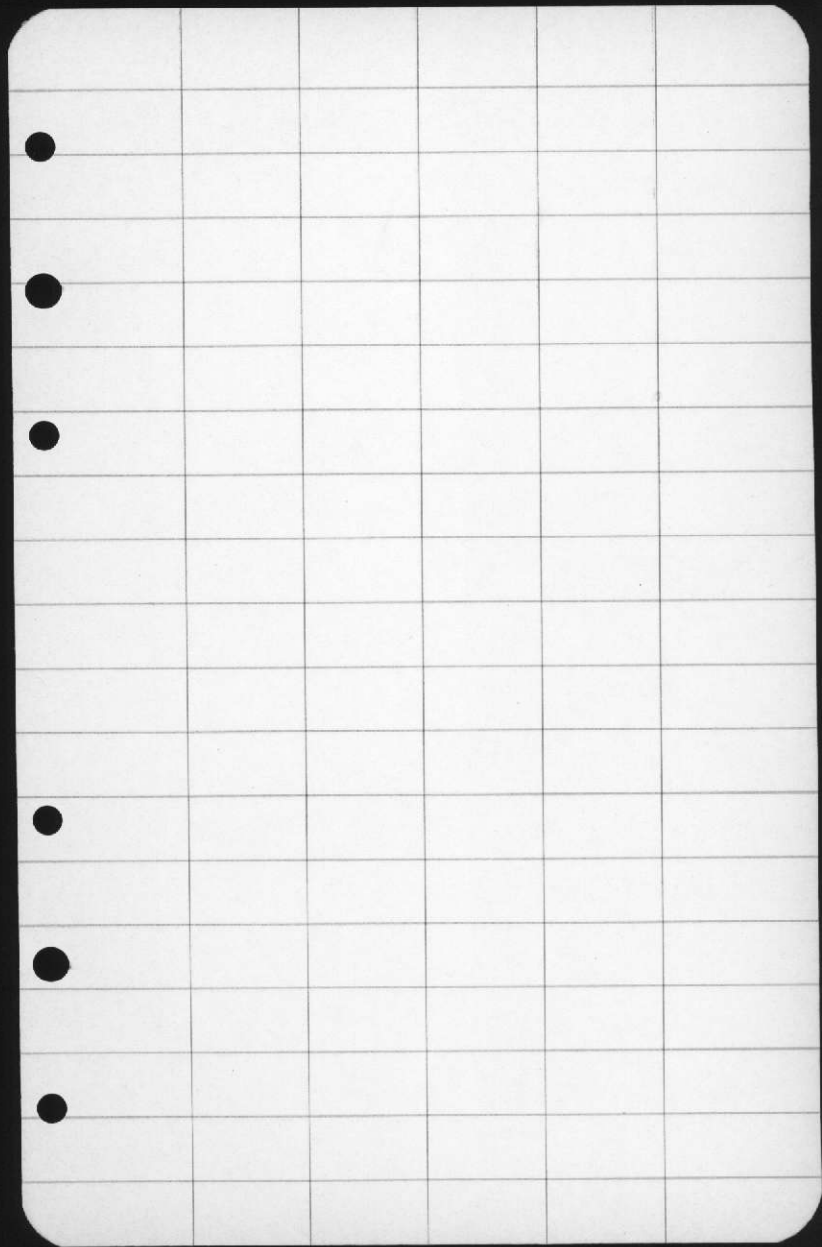


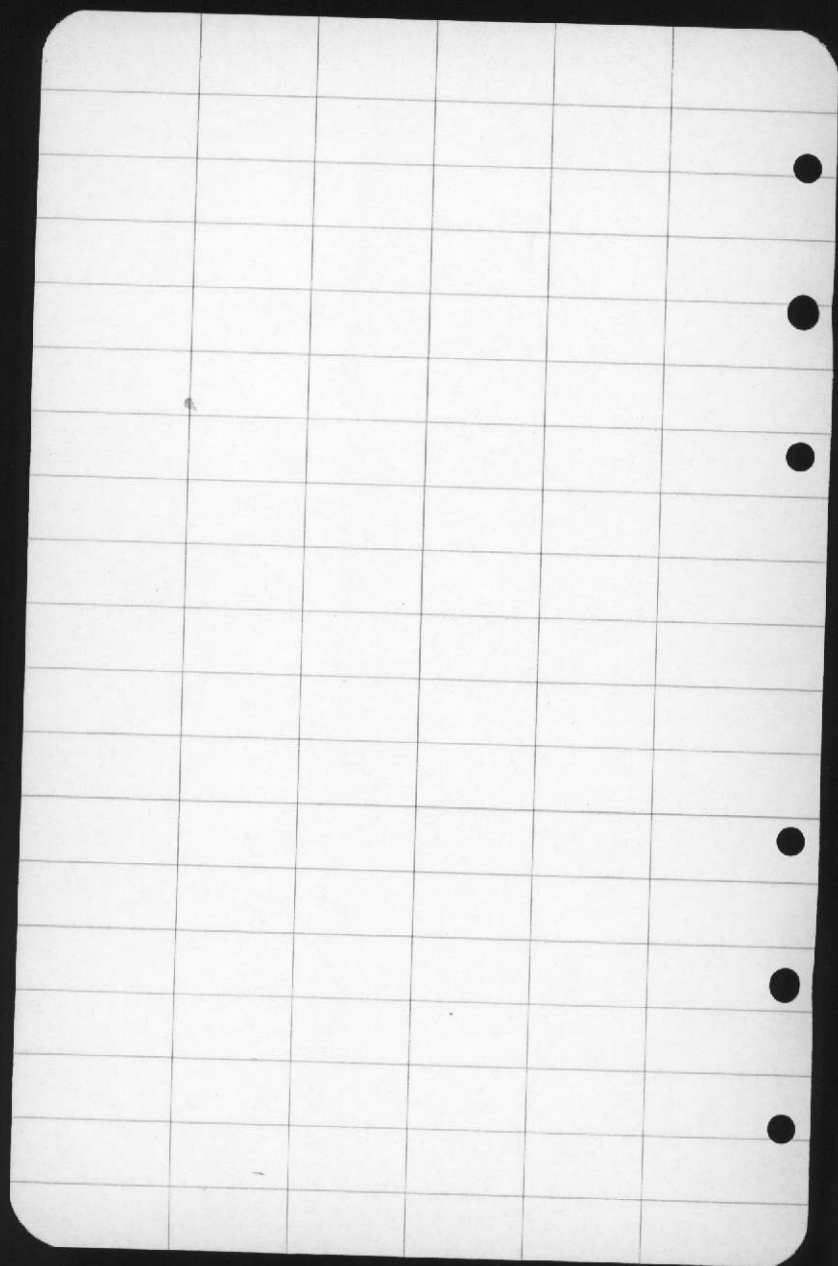





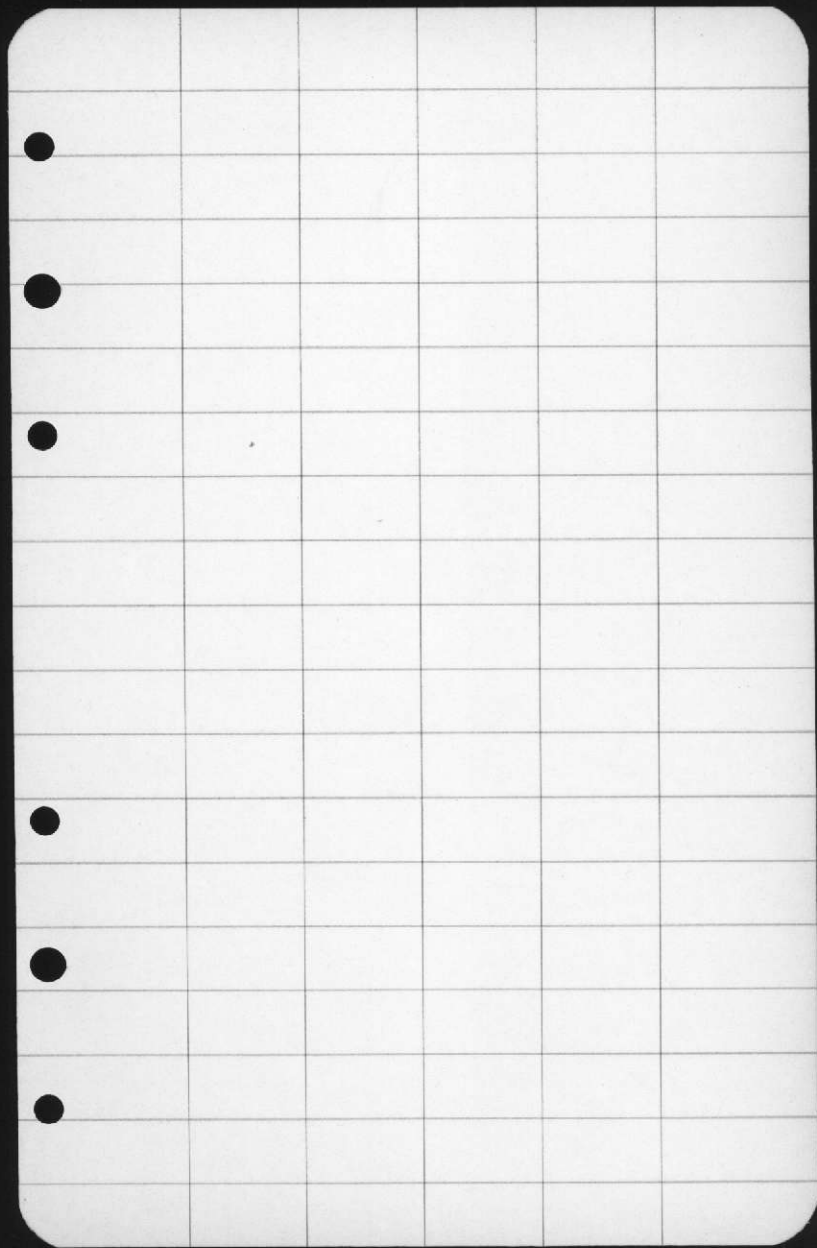


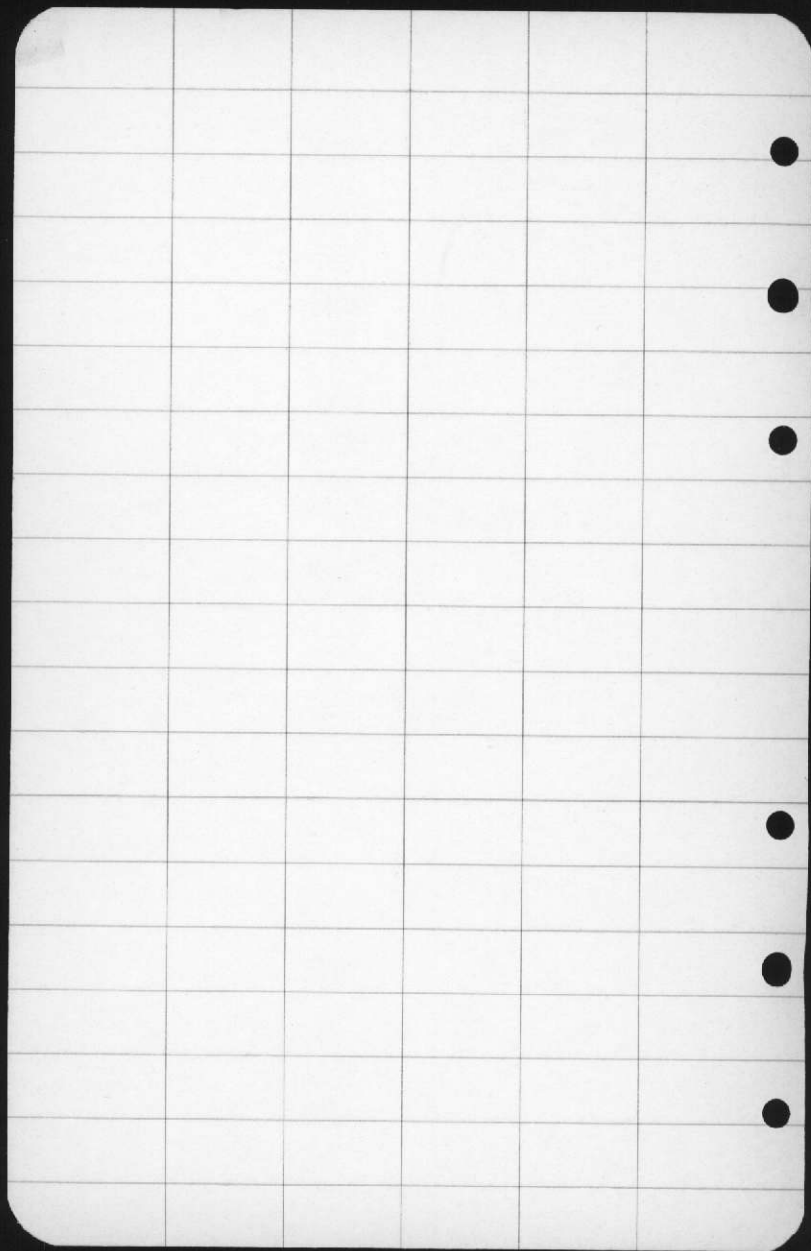


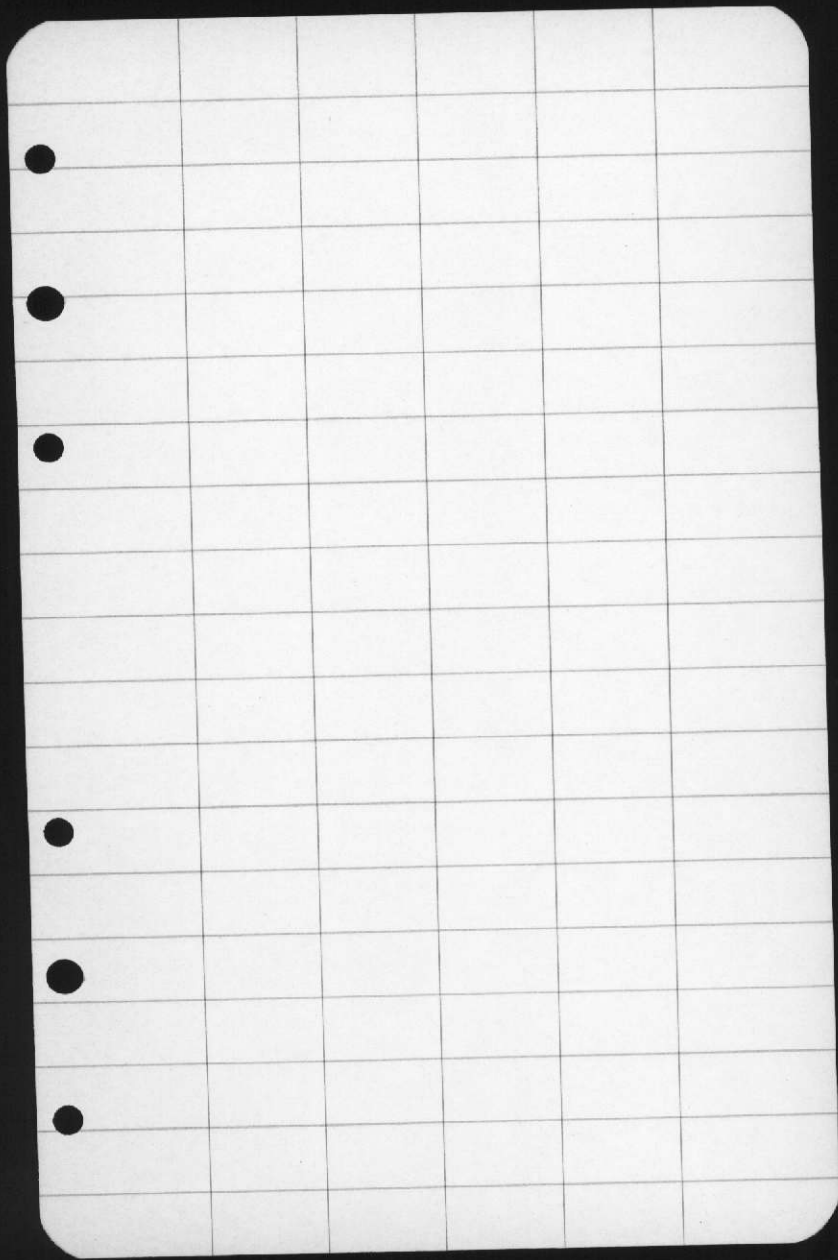


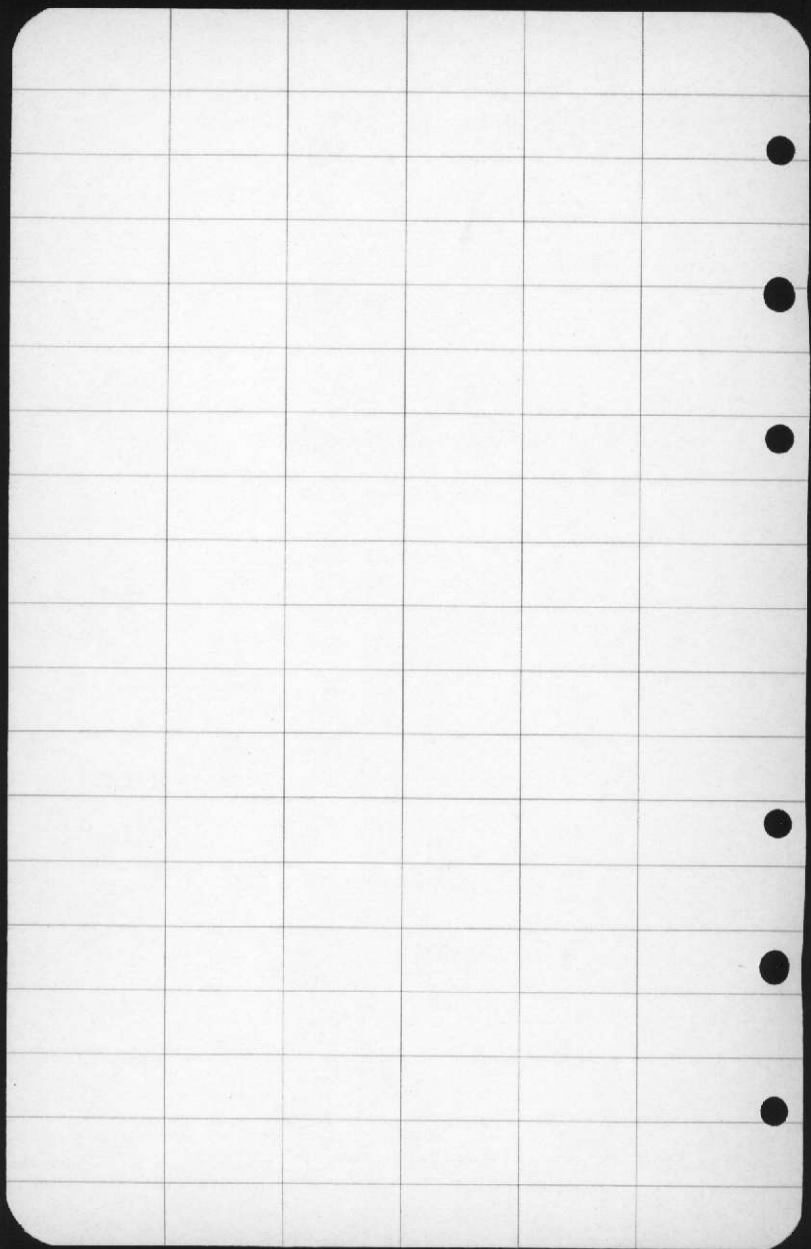

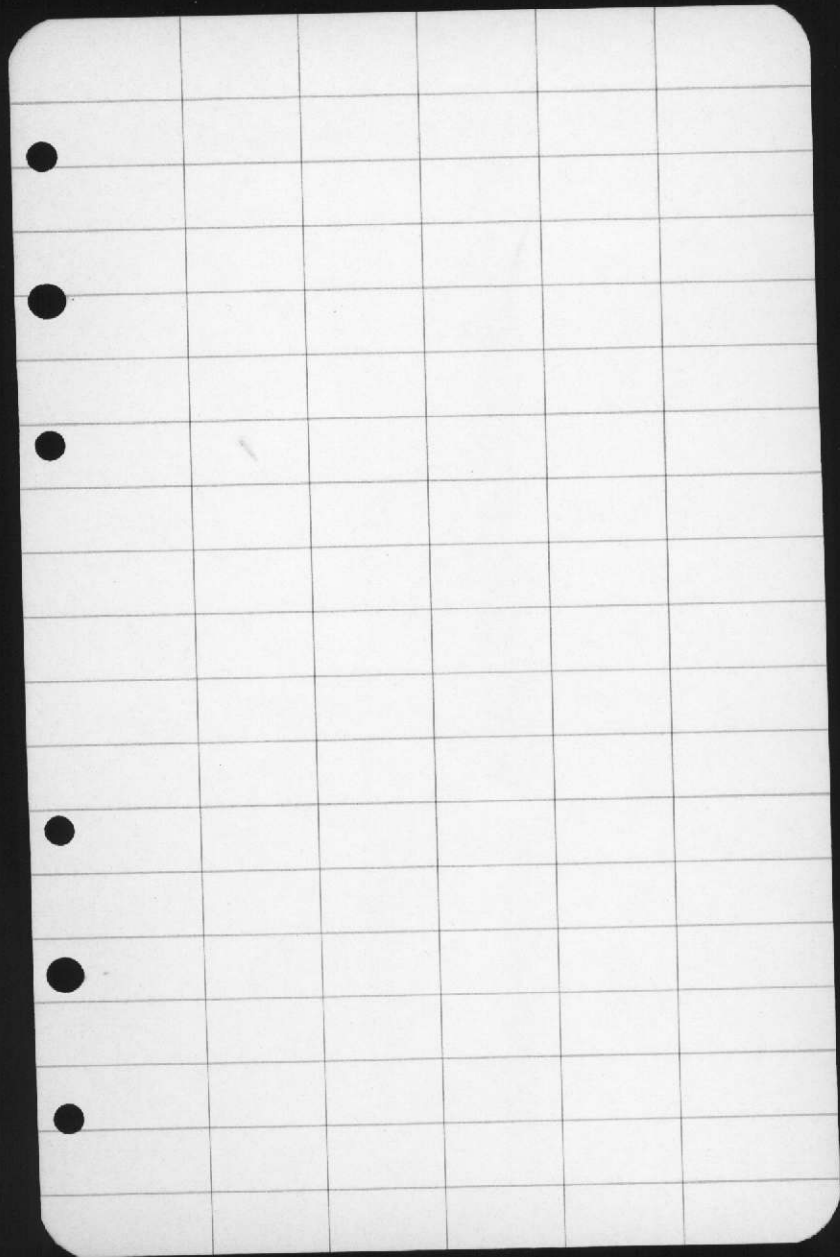


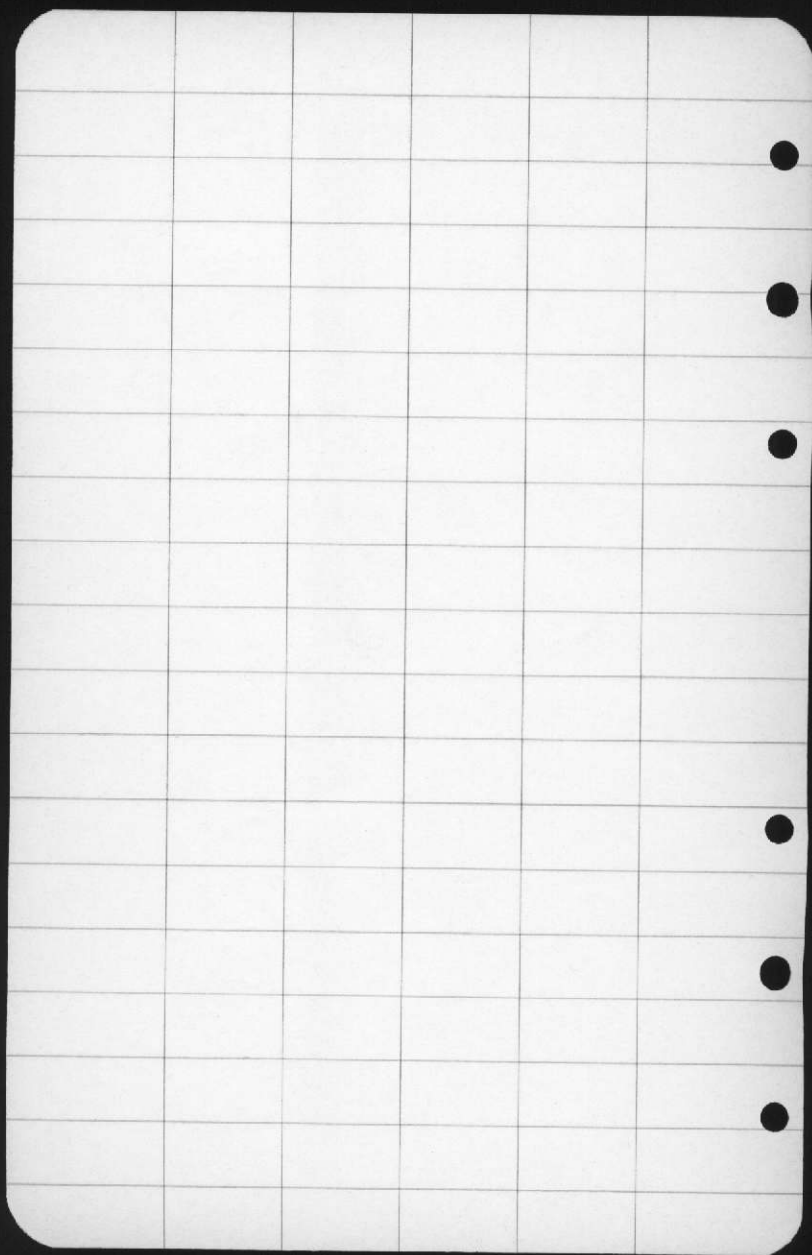


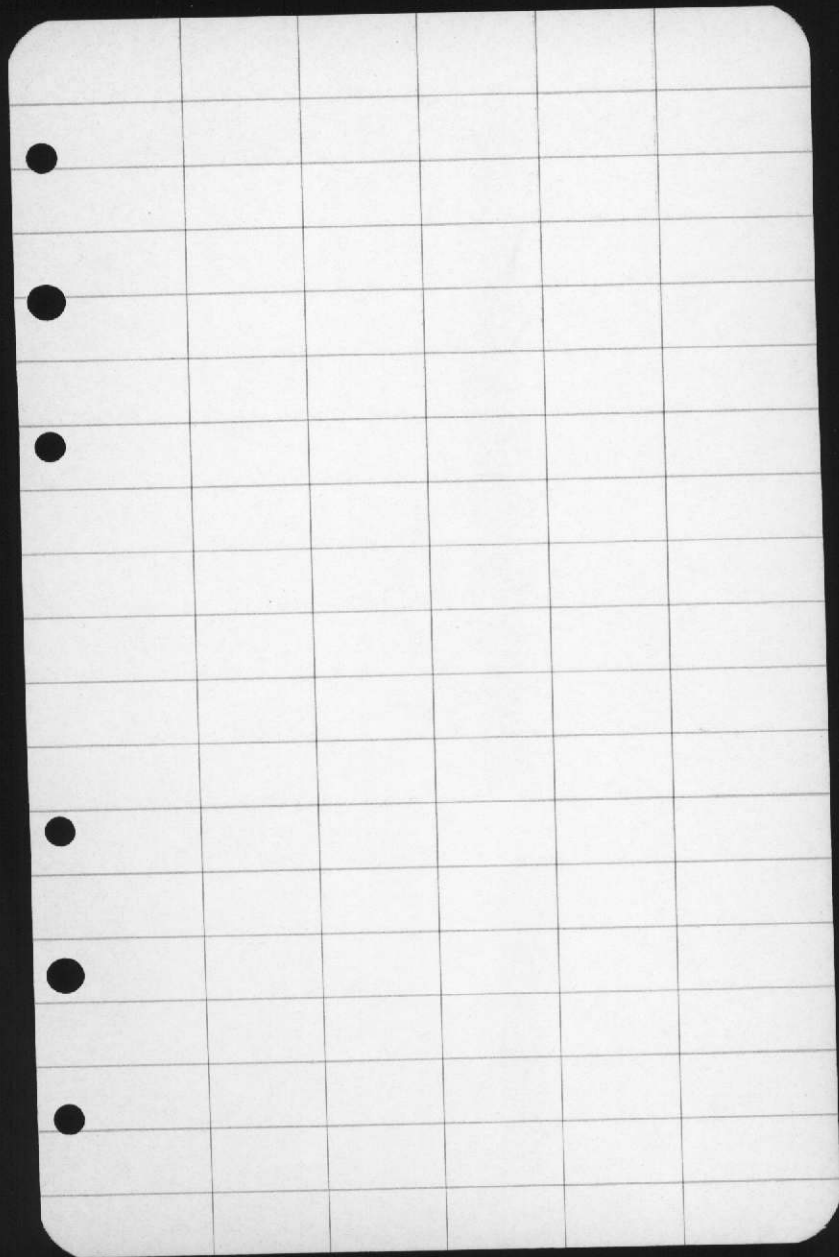


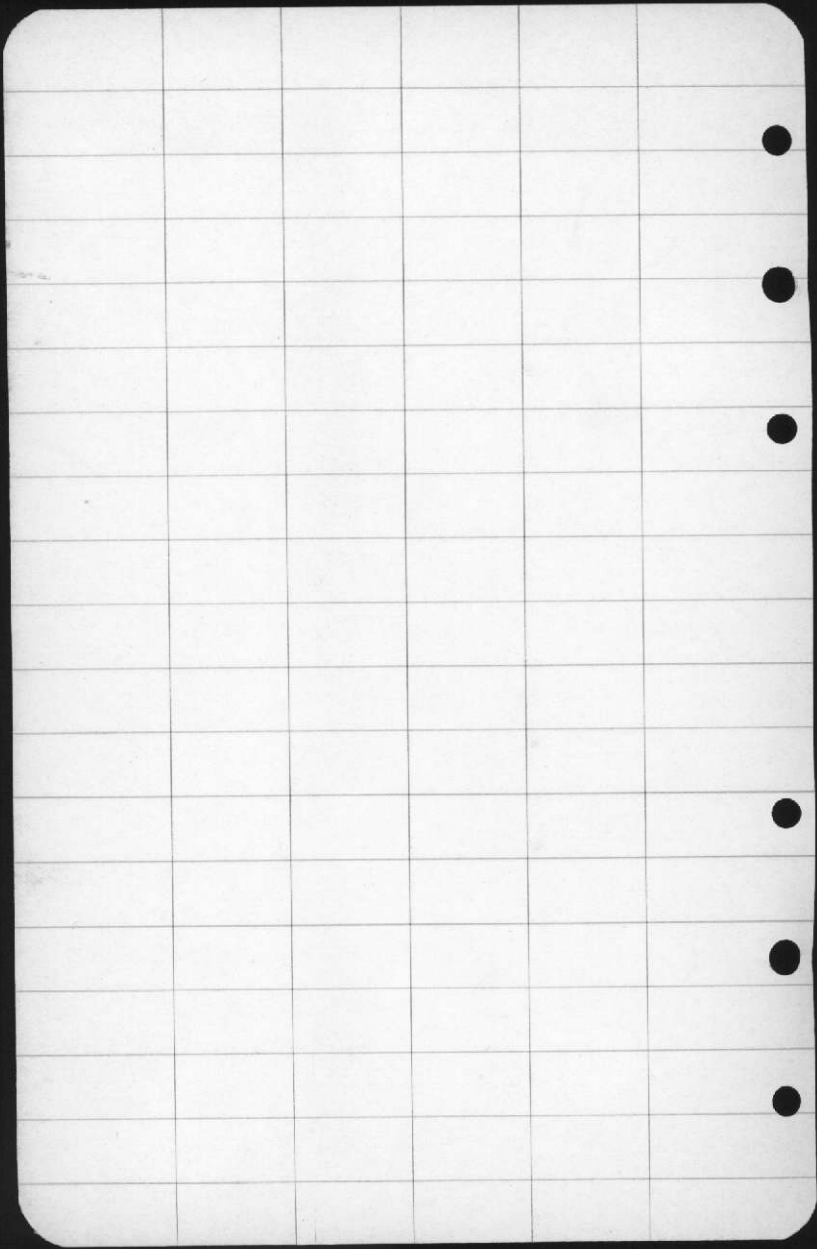





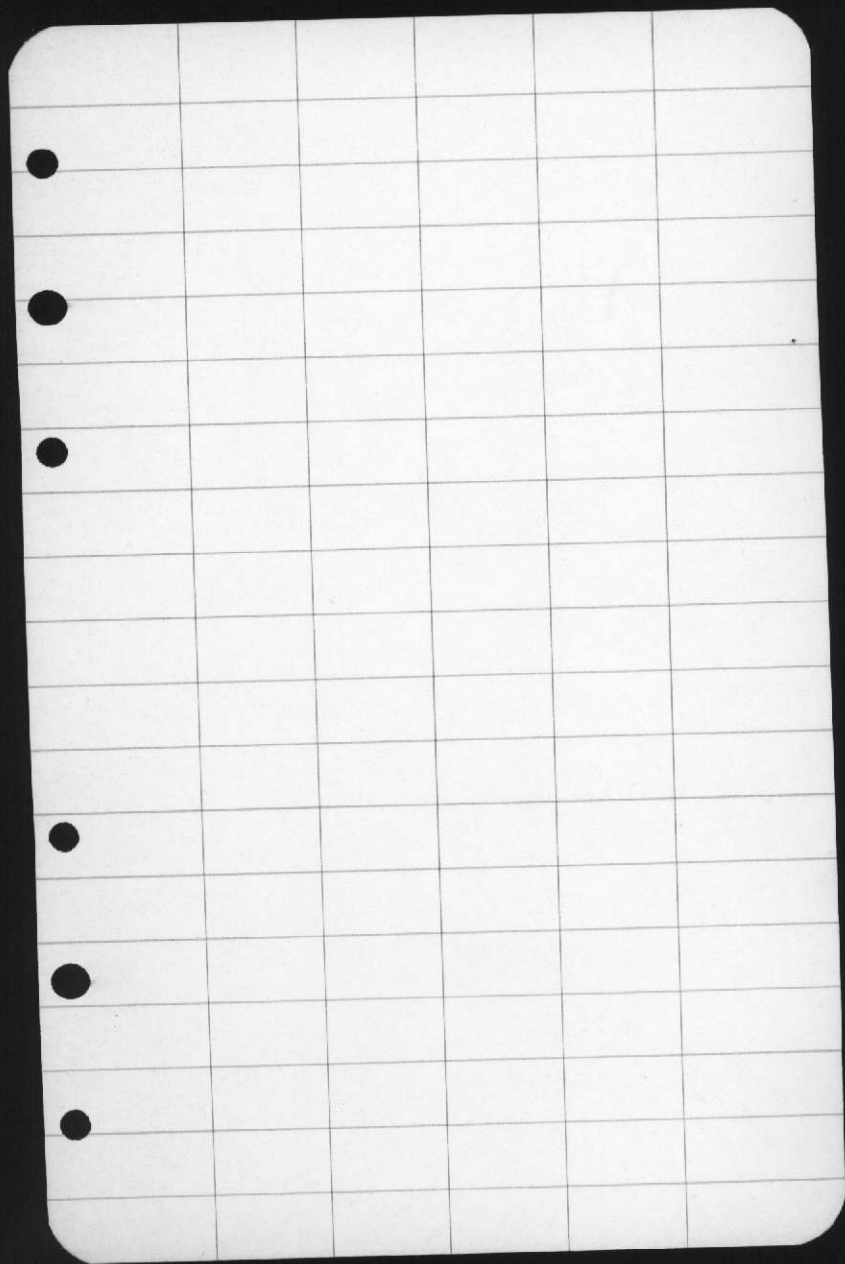


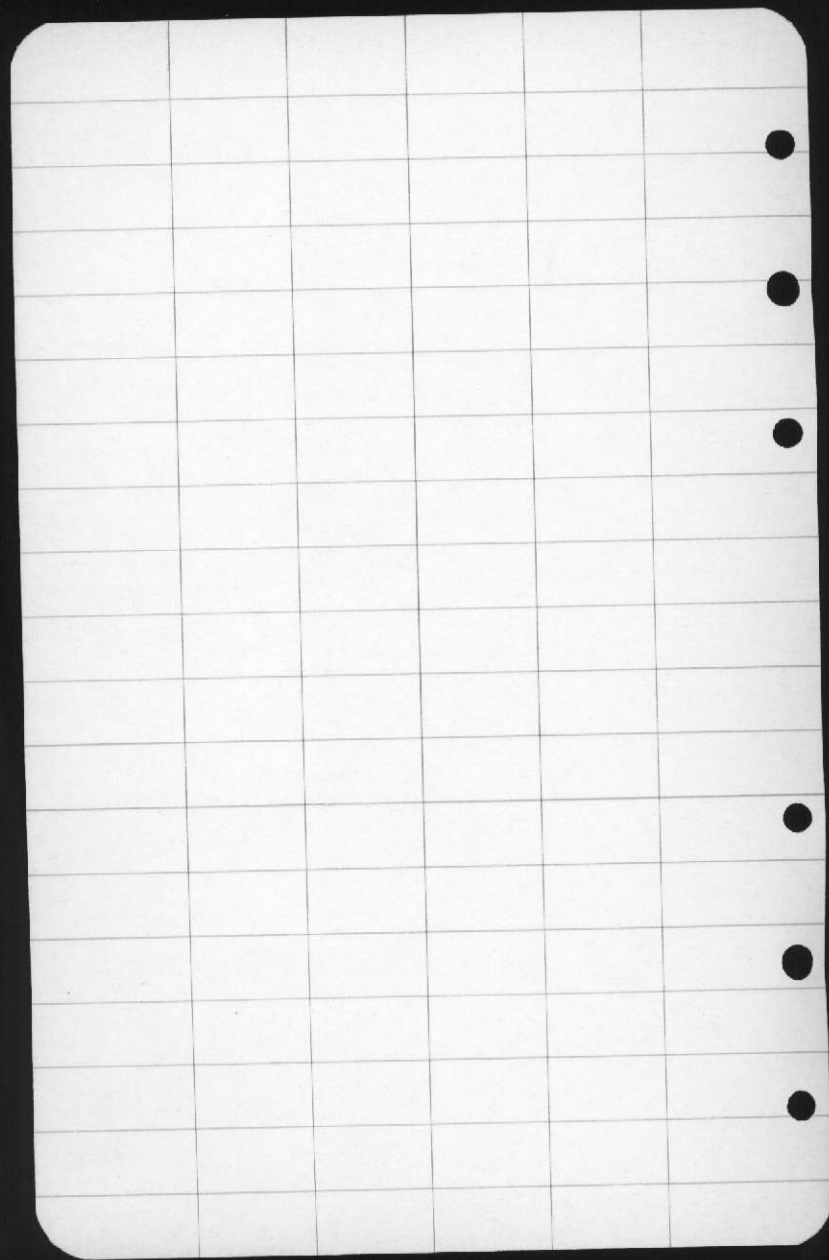


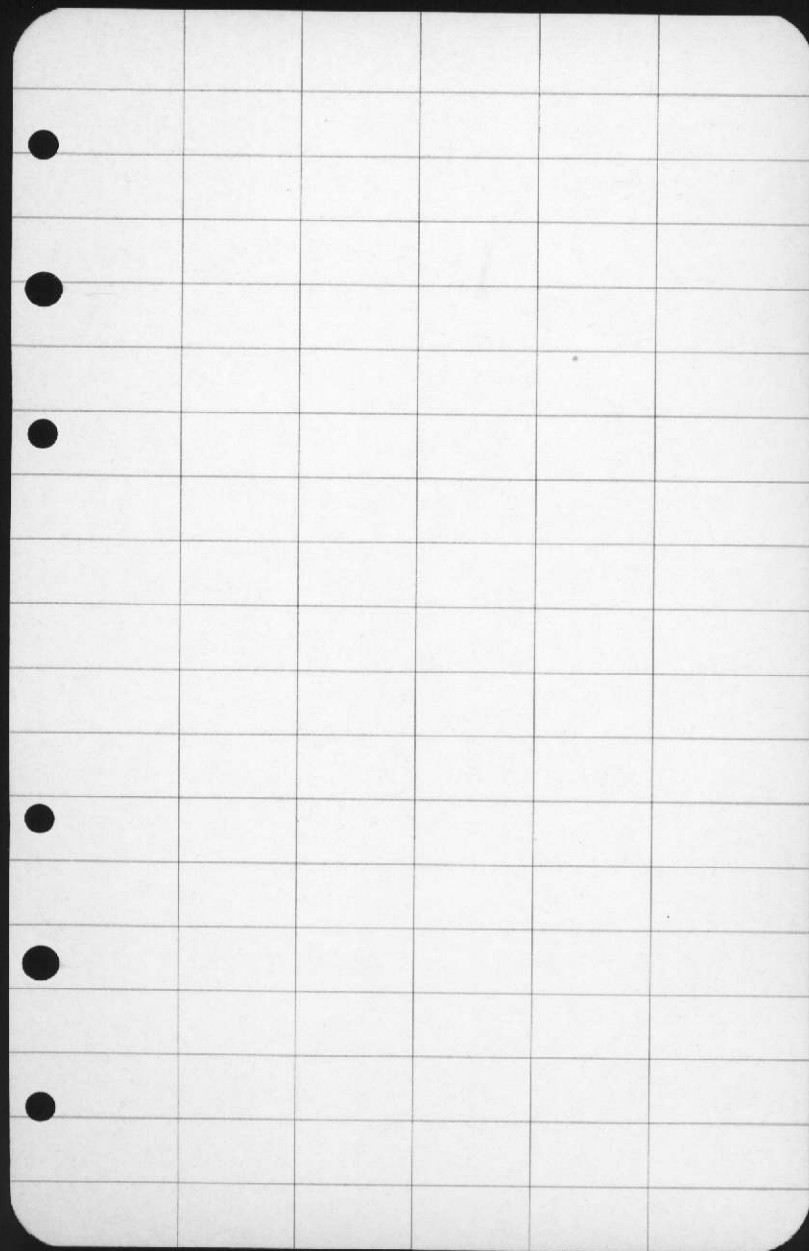


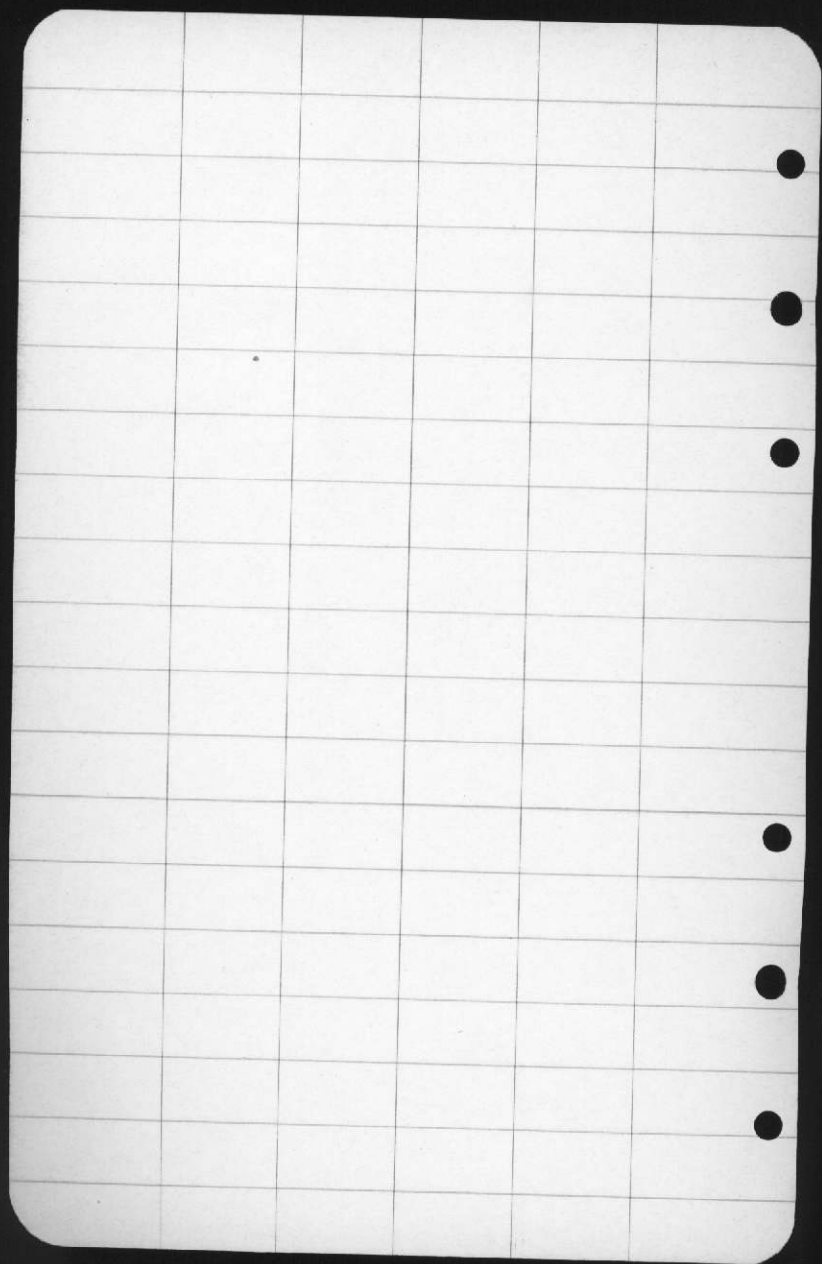

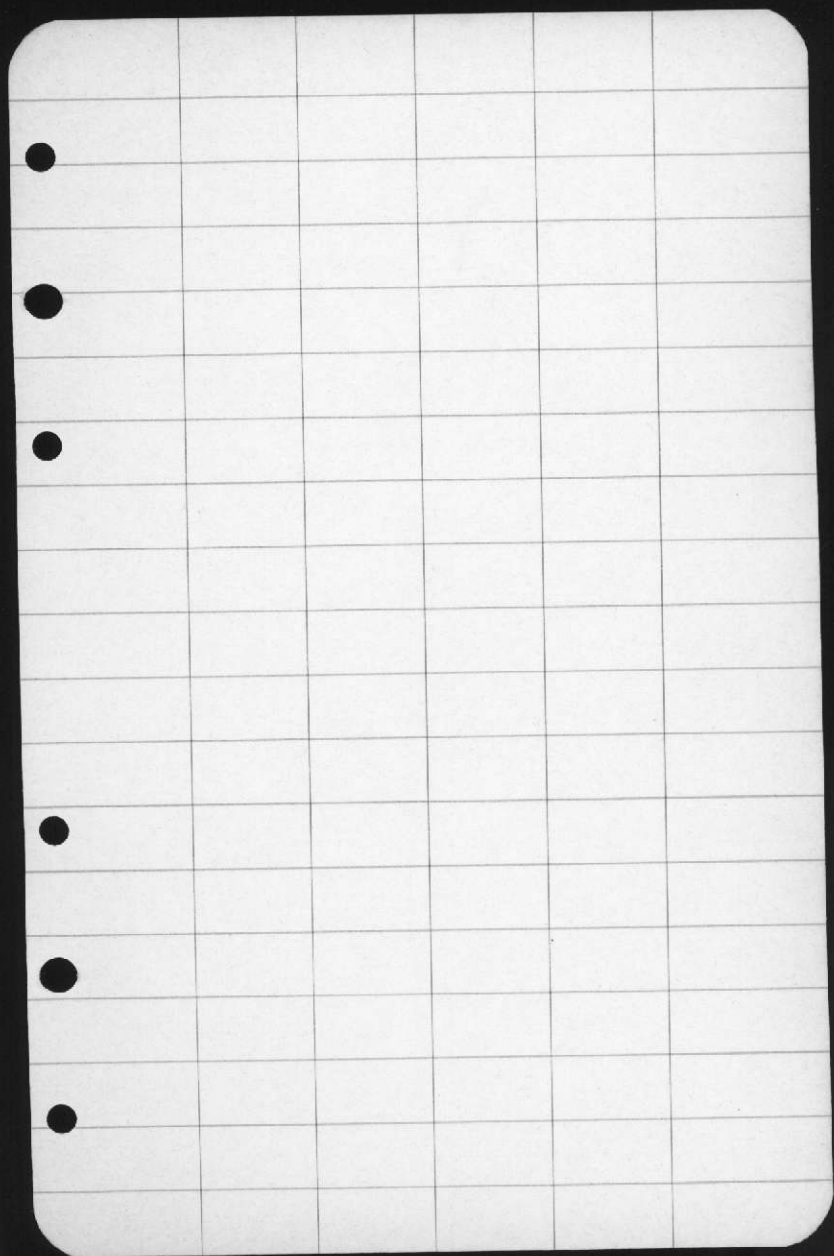


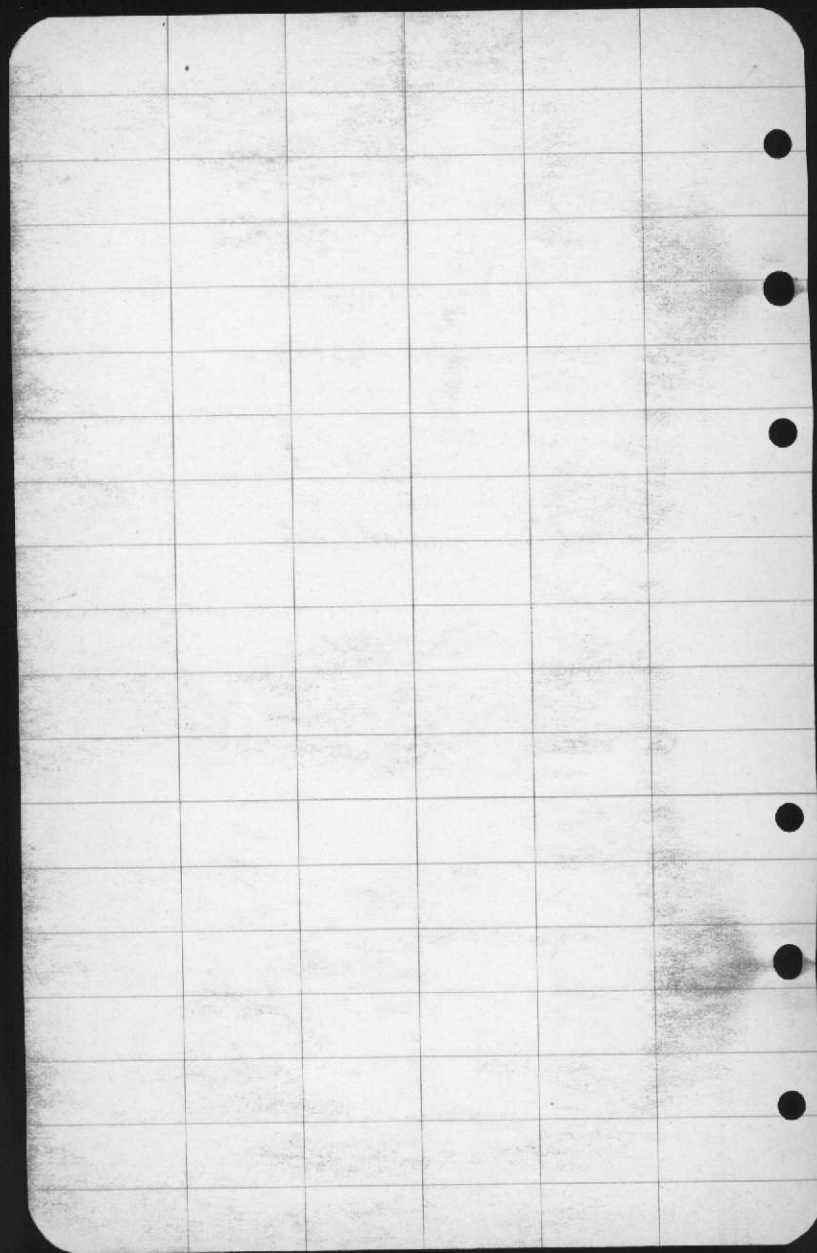


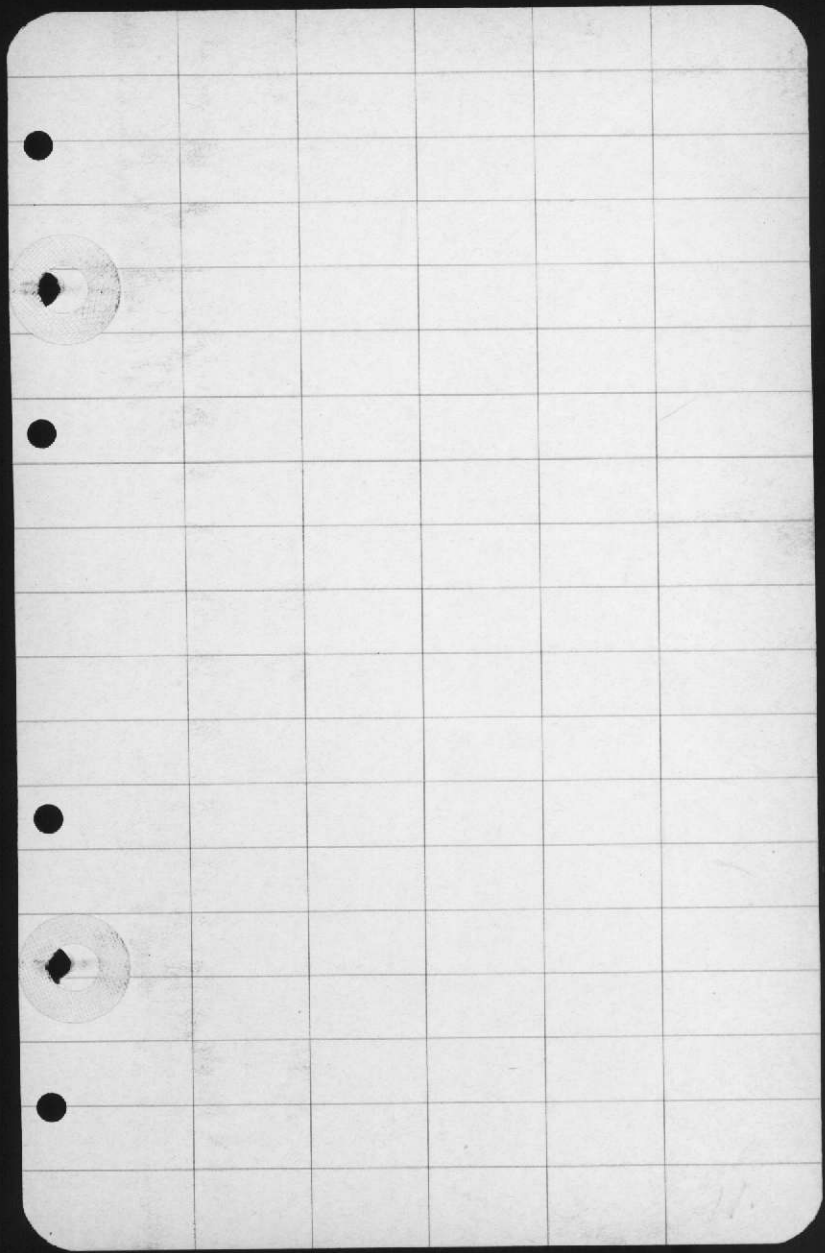


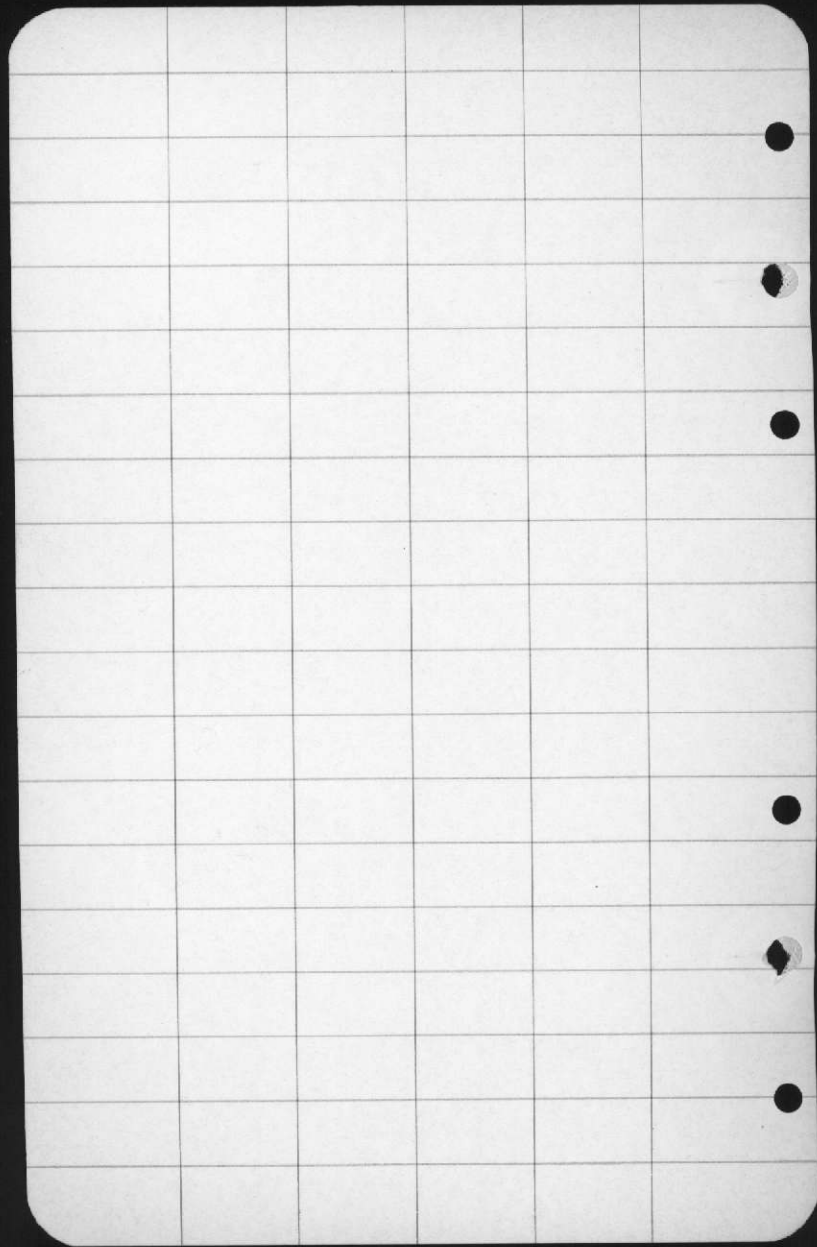





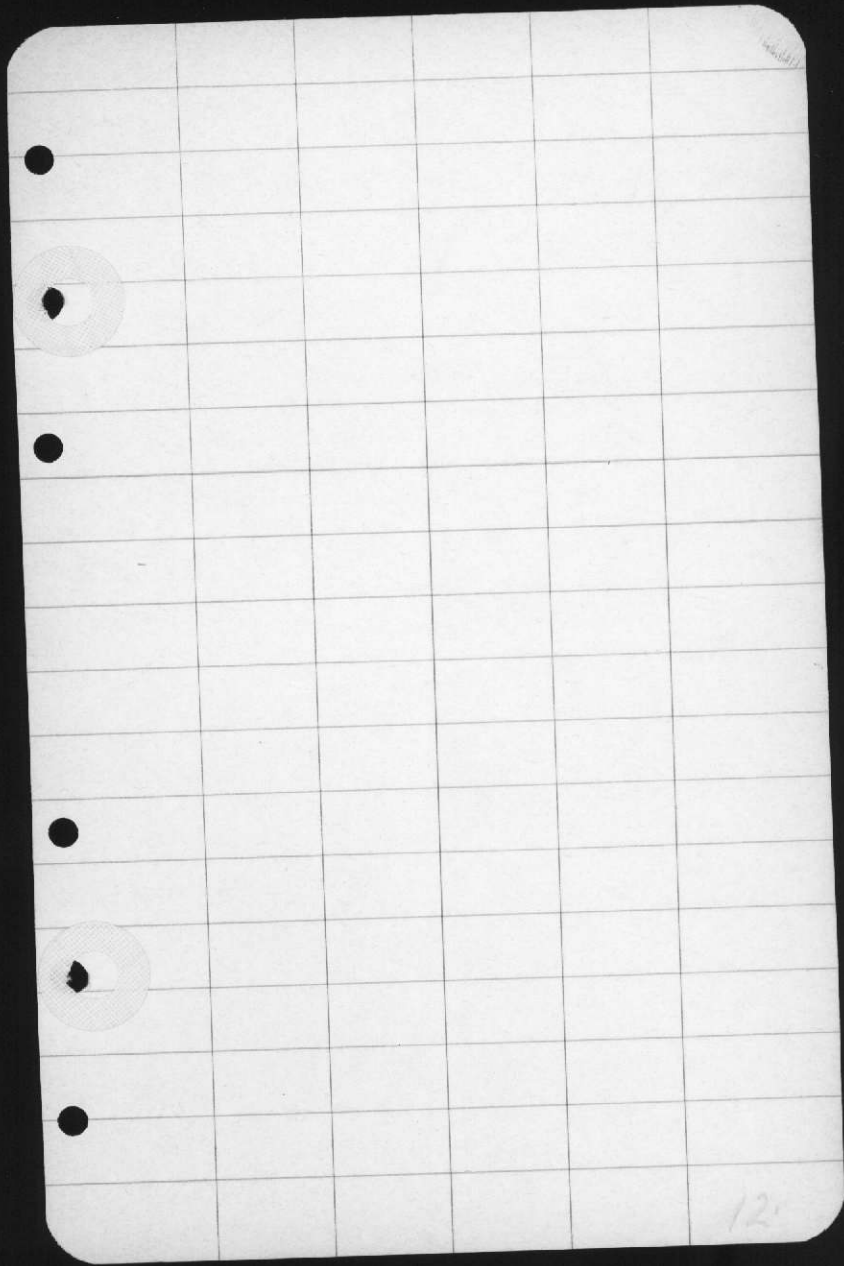

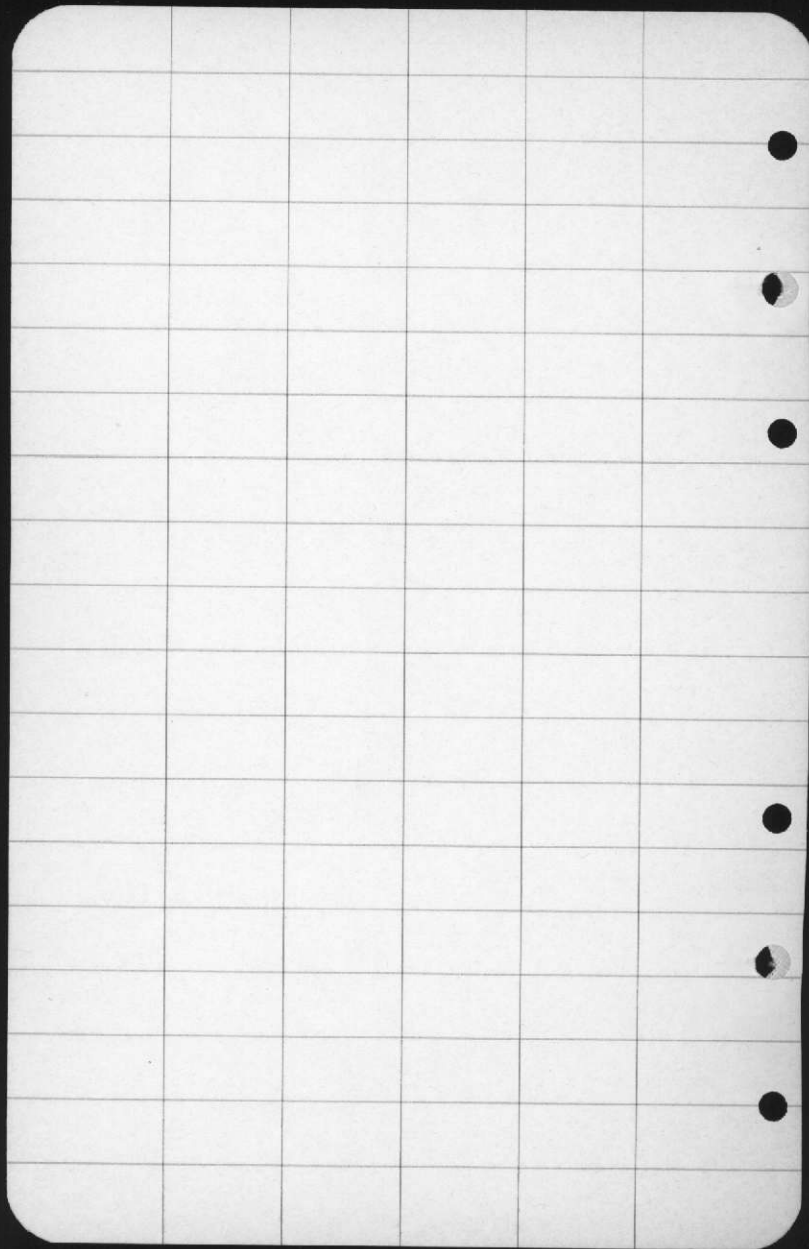


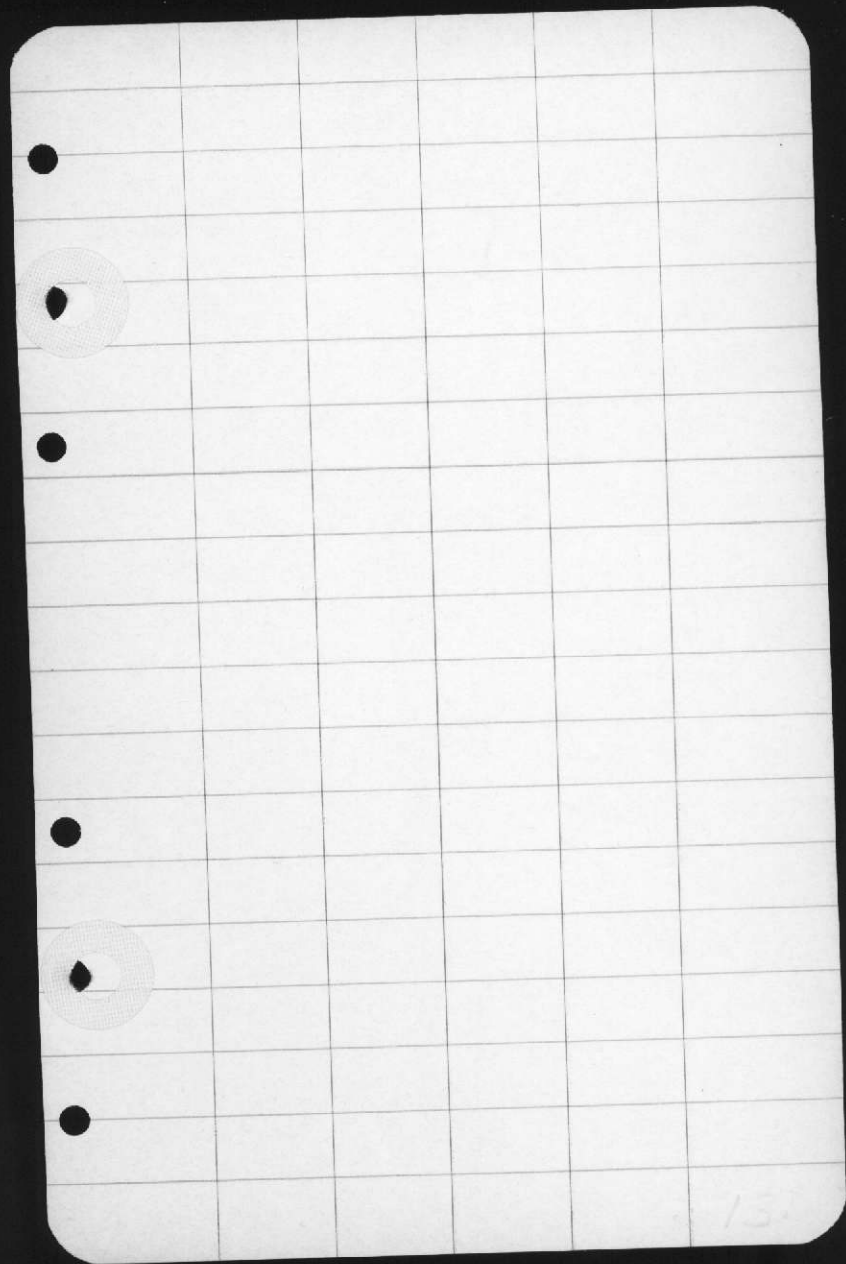


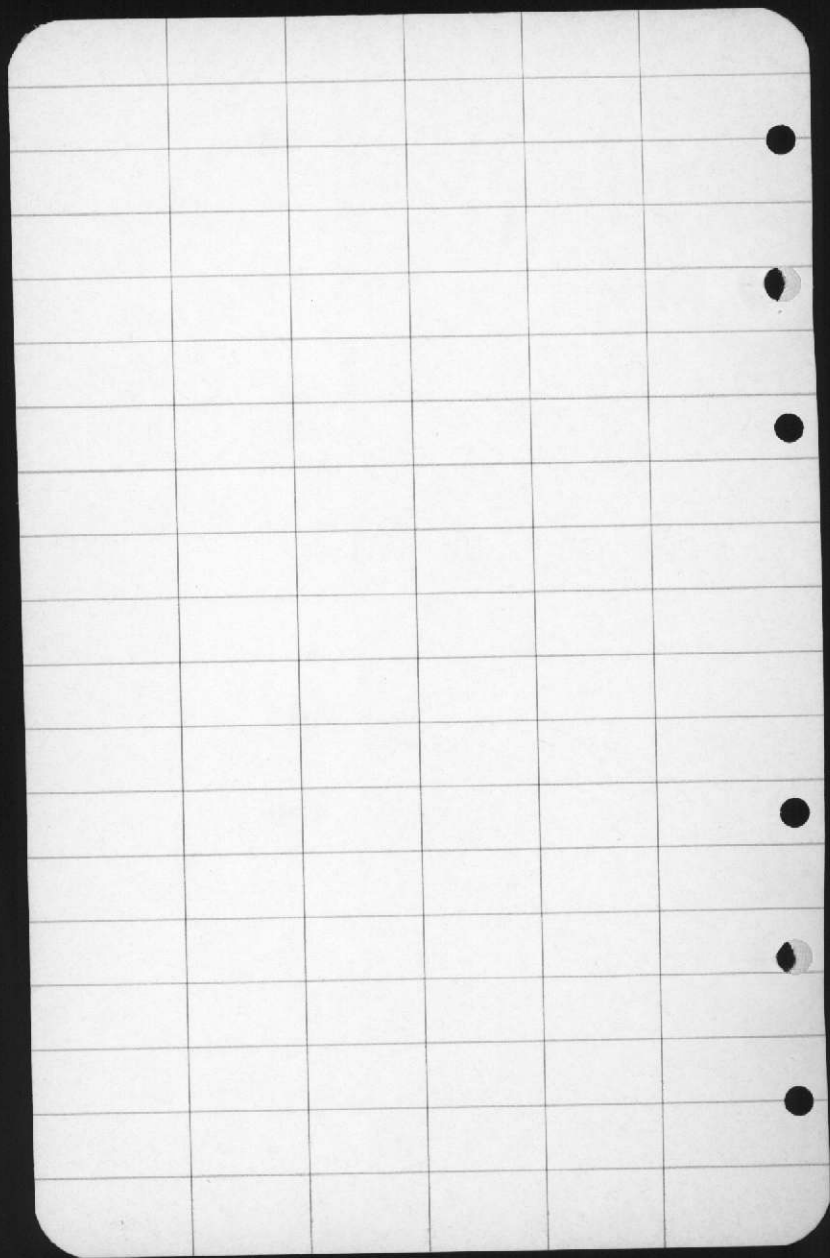

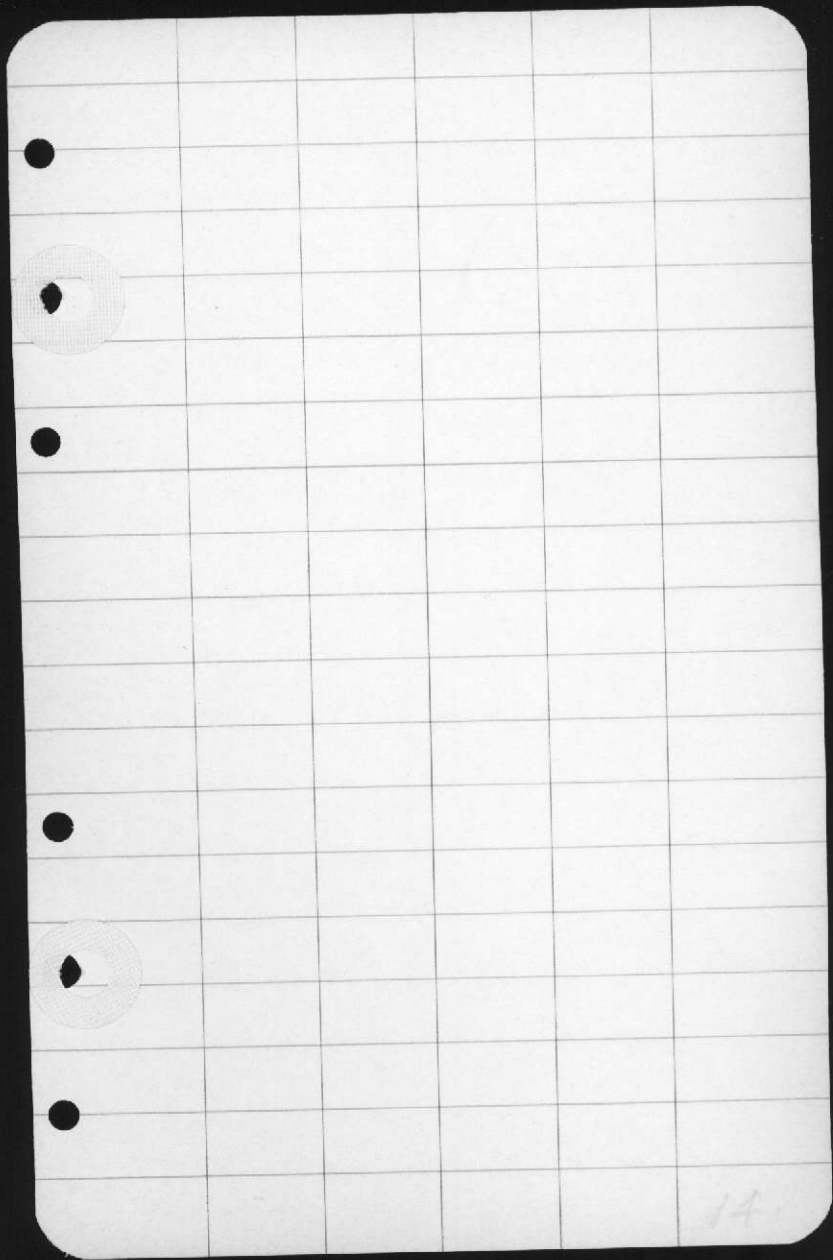


14.

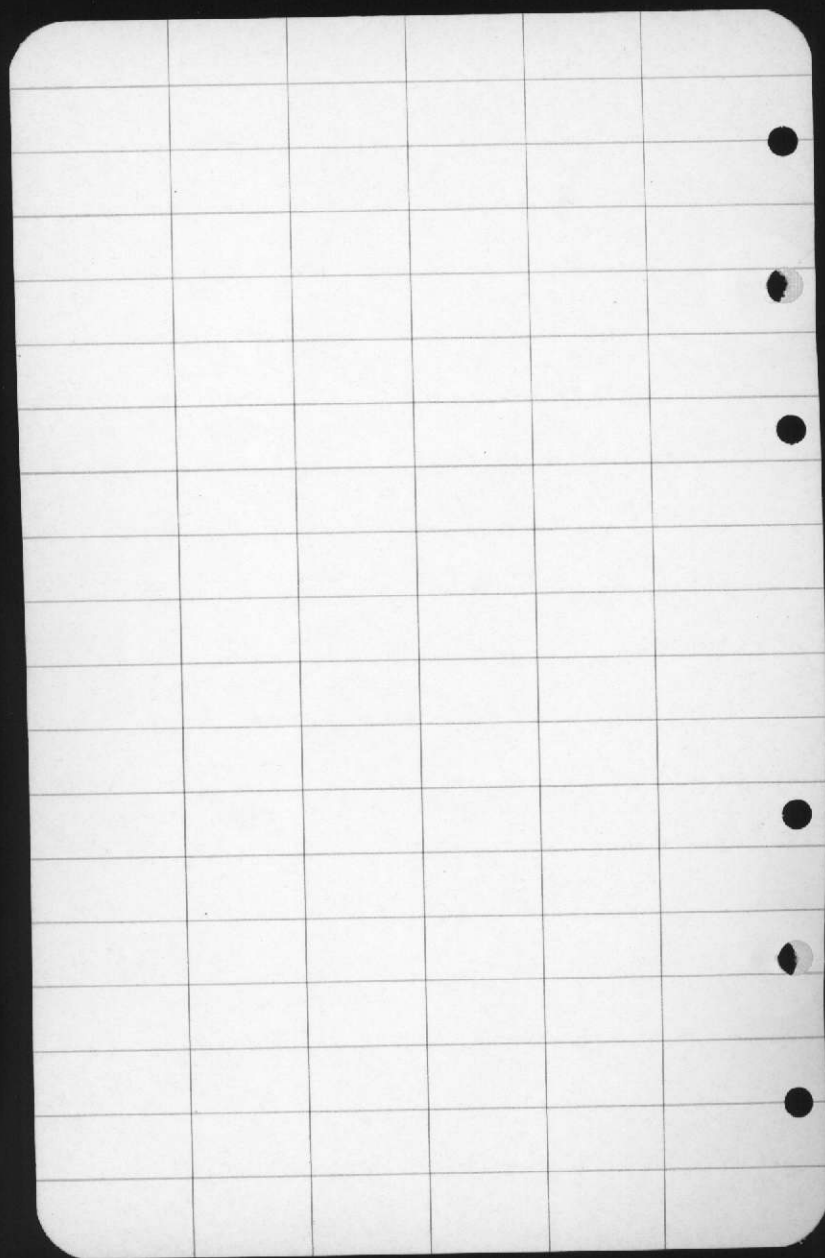

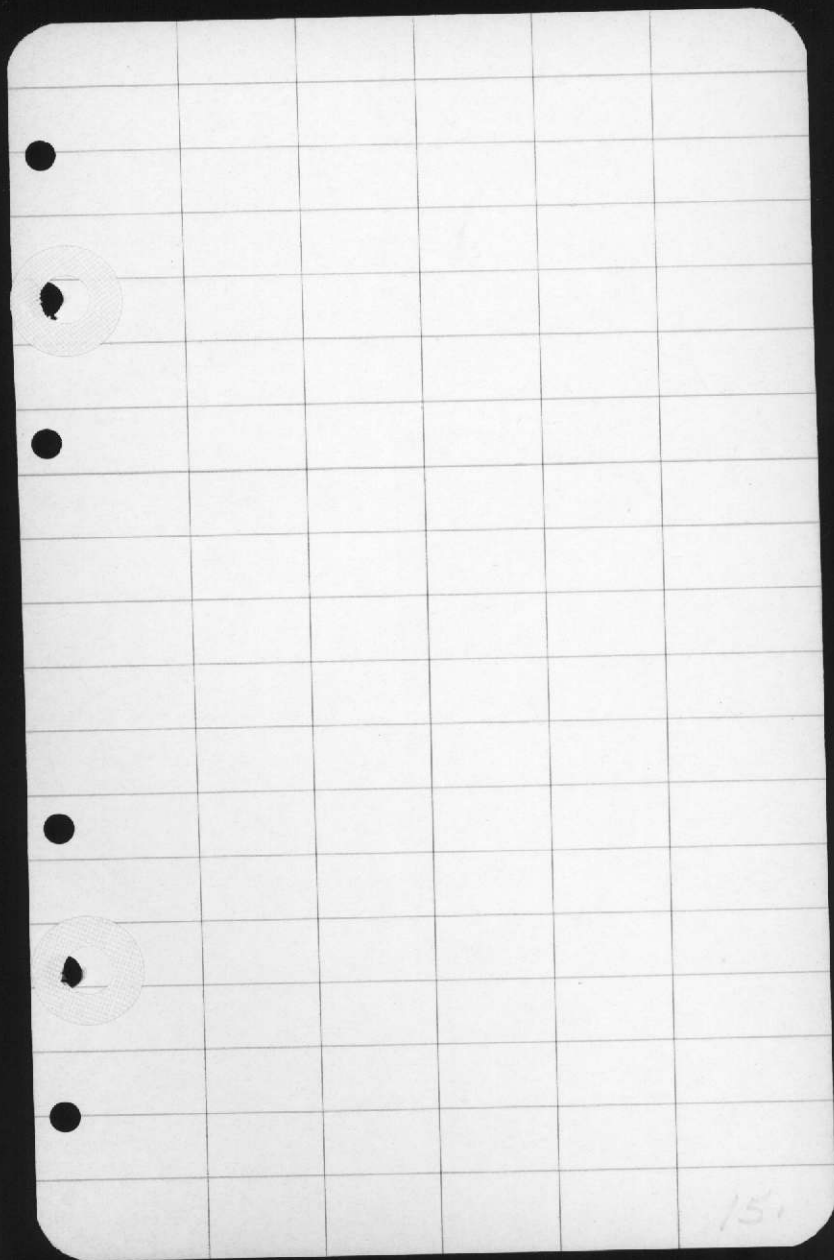

15

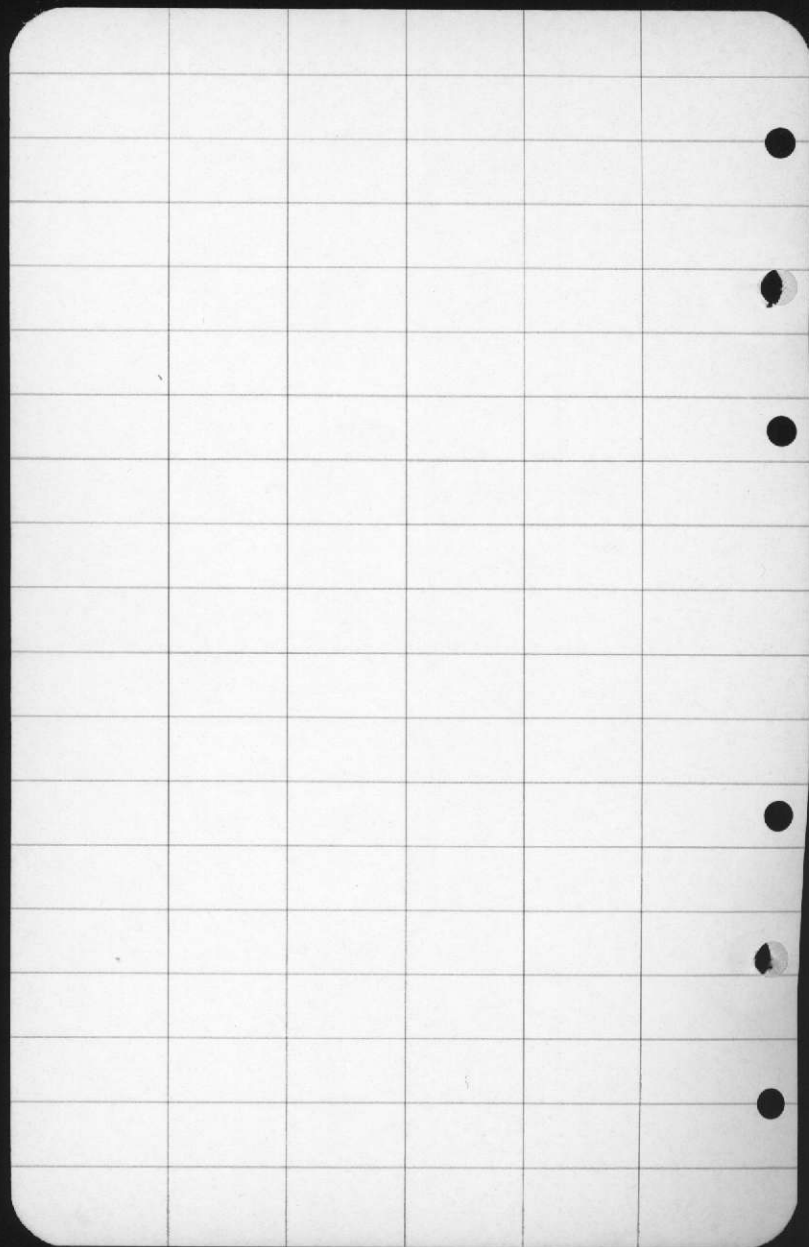





Tarawa Terrace



15 May 1951

Tarawa Terrace

Temporary 4" Well.

0-70' Sand & Clay

70'-100' Shell rock with  
streaks of fine  
gray sand.

100'-185' Fine grained green  
Limestone (very soft)

185'-200' Green limestone  
with much sand &  
black material.

200'-265' Sand & Green lime  
(much black material)

265'-270' Sand & Green lime  
(some shell and fine  
bones.)

270'-280' Fine sand with  
much fine shell, bone  
and black material.

Temporary  
4" Well

280'-294'? Fine green  
Limestone with much  
fine shell, bone and  
black material.

Temporary  
4<sup>th</sup> Well

21 May 1951

4" casing down 268'  
Driller tried blowing  
at 10:45 A.M. with air  
line down to 294'.


No water flowed.

Air line at 261' with  
75 lbs. pressure.


Water came out in short  
spurts for about 15 min.  
Thick green water.

Air line at 205', 75 lbs.  
pressure. Water clearing  
but strong odor of  
 $H_2S$  present. Approx.

30 gpm. Gallon sample  
taken for analysis at 3:30 P.M.

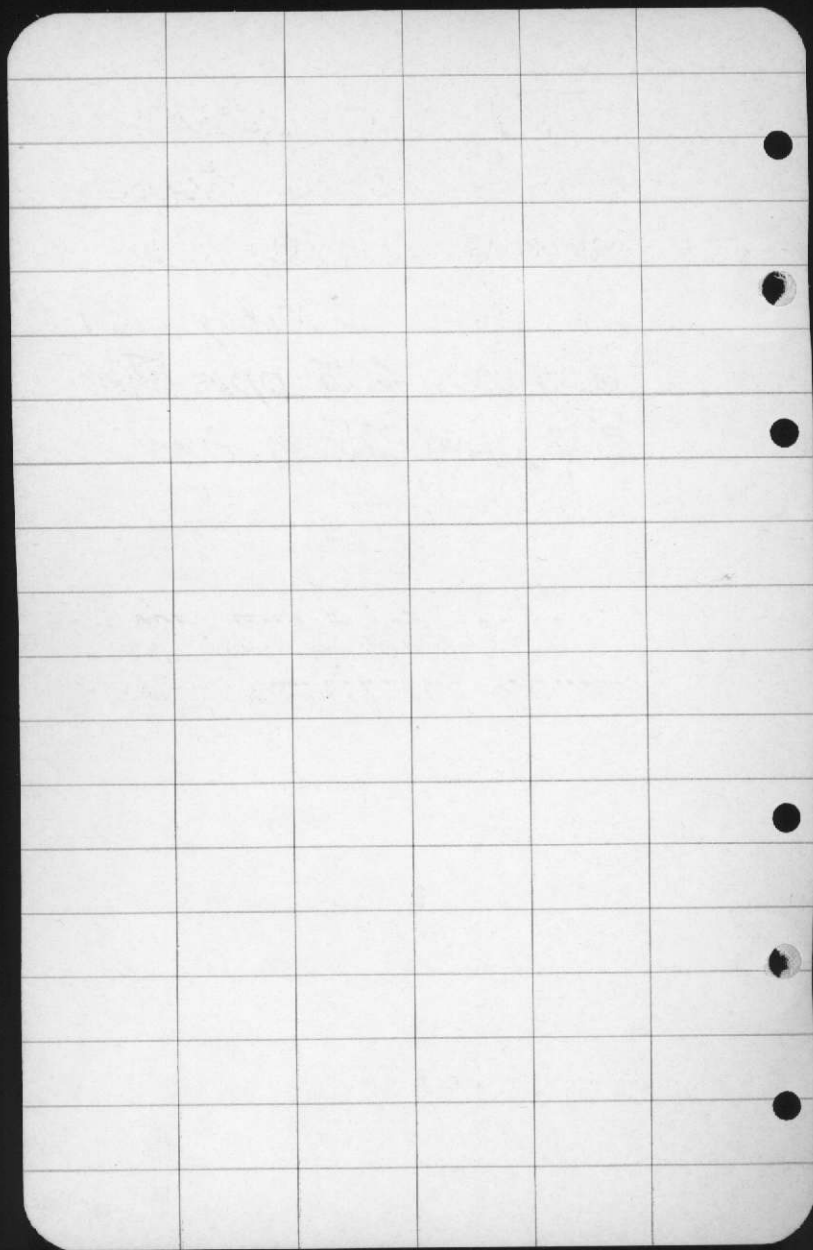

Analysis of water  
taken from Temporary  
Well (4") at Trawa  
Terrace 21 May 1951  
showed 415 ppm chlorides,  
0.7 ppm. Iron and  
strong odor of  $H_2S$ .

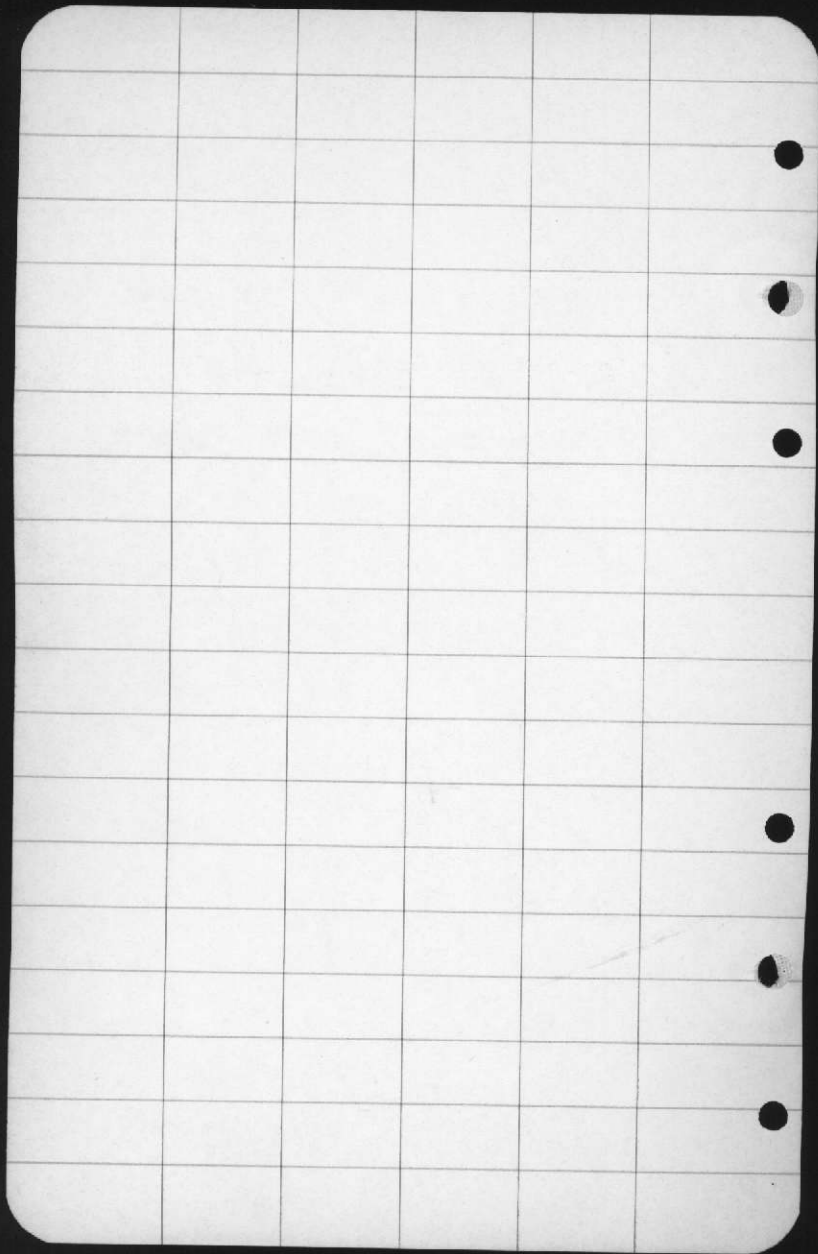



16 May 1951

Tarawa Terrace - Well No. 1

0'-20' Sand + Clay

20'-70' Fine gray sand

70'-85' Soft shell rock  
(Much water)

85'-87' Fine gray sand

87'-108' Hard shell rock

108'-125' Fine gray sand

125'-145' Fine grained  
blue-green limestone

145'-180' Coarse sand  
(some shell)

8" Casing to 91'

Static level 20' (below surface)

Surface El. =

#

1

1.

#1

1  
+

~~4~~  
67215  
228

2 3.8

179  
58  
35  
57  
33  
19  
33  
490  
6  
13  
33  
71

Driller started pumping  
with gasoline engine  
at 10:30 A.M. 18 May.


Pumped approx. 200 GPM  
for 5 hours drawing a  
large volume of fine sand.  
Pump pulled after 5 hrs.  
and well filled with  
coarse gravel up to  
86' level.

19 May 1951

After pumping continuously  
for approx. 24 hrs. water  
was clear. No sample  
taken at this time for  
Analysis.

Pumping Rate 215 GPM  
Drawdown 57'

2.

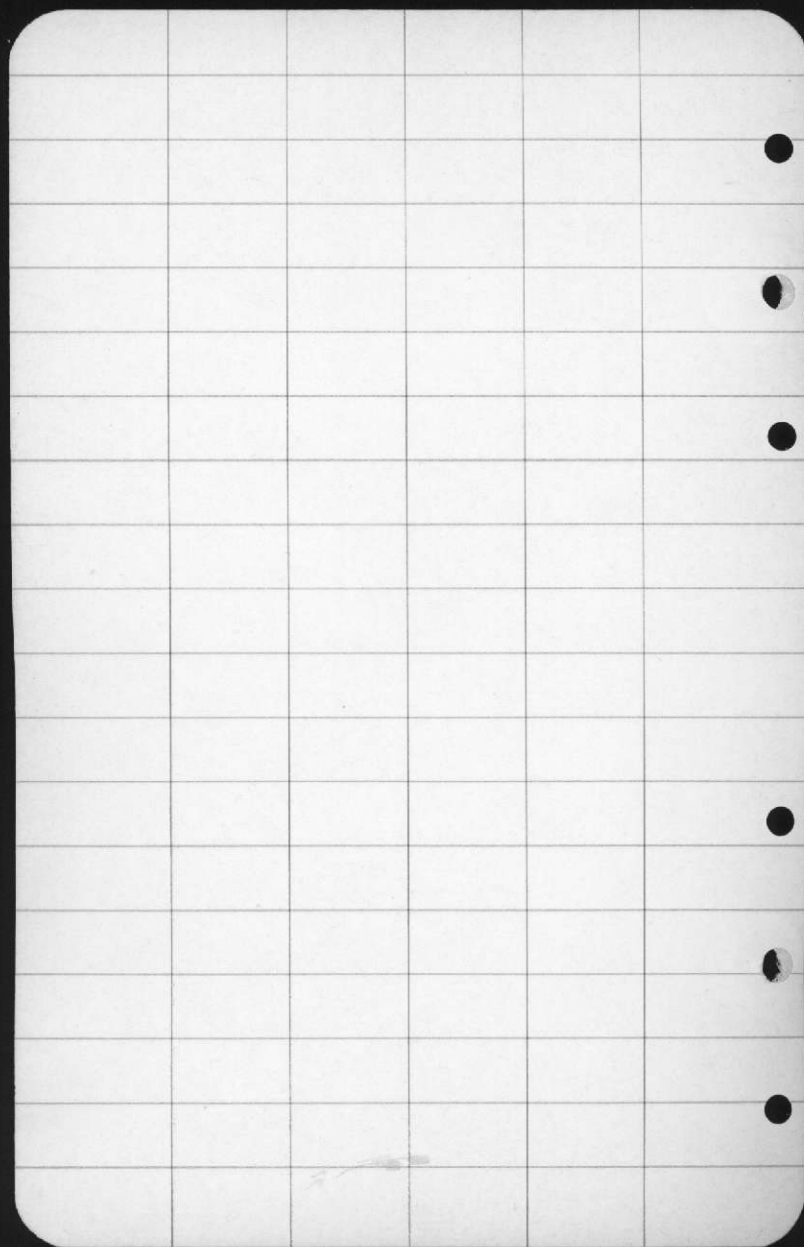


The pumping rate and drawdown were not checked by this organization but merely as stated by the driller.

R. E. Peterson  
Public Works

Sample of water taken from this well for analysis  
31 May 1951.

R.E.P.

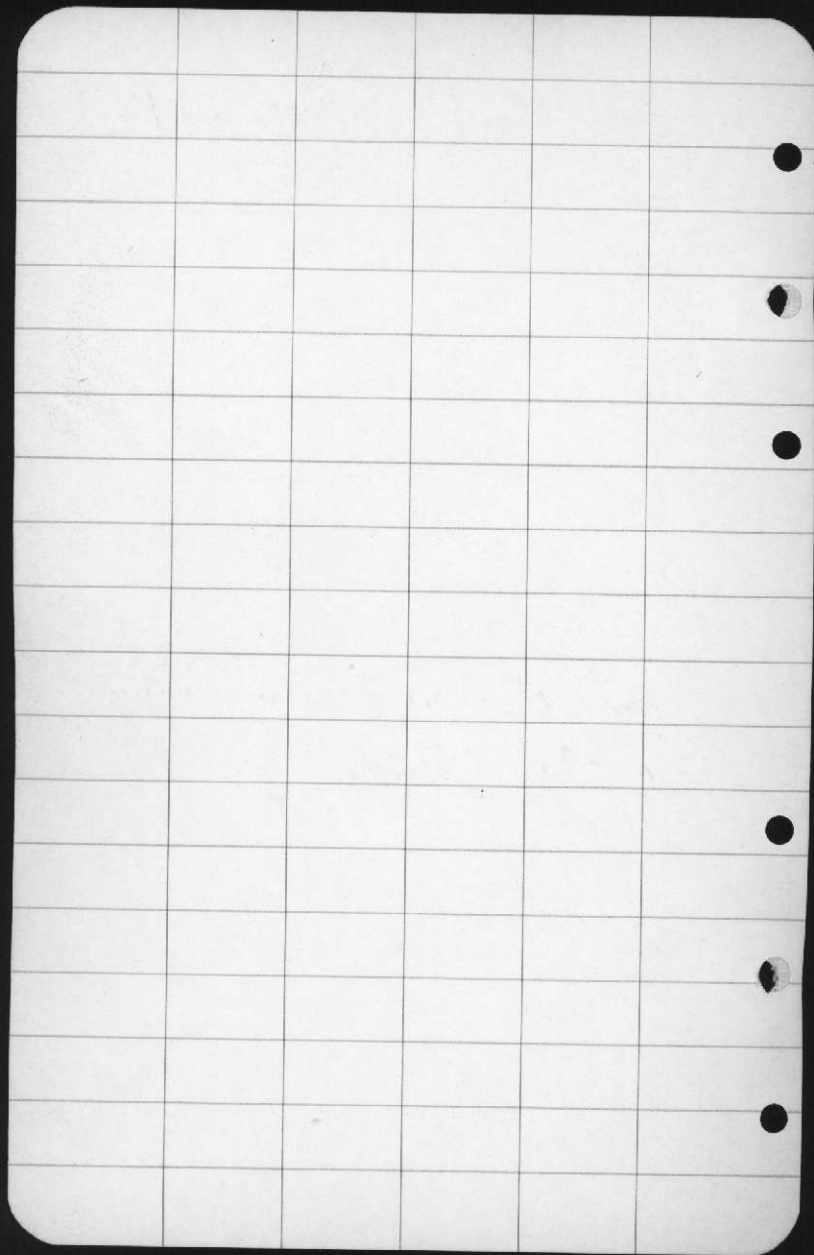

22 May 1951

Tarawa Terrace-Well No. 2(a)

0'-12' Sand & clay

12'-18' Fine gray sand

18'-21' Sand & yellow clay

21'-50' Fine gray sand

23 May 50'-65' Fine gray sand  
(some shell)

65'-68' Soft shell rock

68'-72' Fine gray sand  
(some shell)

72'-85' Soft shell rock  
(much water)

85'-92' Hard shell rock

92'-125' Fine grained green  
Limestone. (very soft)

← Casing at 73' below  
surface. 4.

# 2(a)





24 May 1951

Driller started pumping  
with gasoline engine  
at 11:30 A.M. with gravel  
in well to approx. 80' level.

Sample taken for  
analysis at 3:00 P.M.

Water did not clear up  
after pumping all night.

Drawing large volume  
of fine sand.

25 May 1951

9:30 A.M. Driller is  
driving 8" casing deeper  
as he thinks sand is  
coming from above.

5.


29 May 1951

Driller drove 8" casing  
to 93' and drilled well  
on down to 130.'

He commenced pumping  
26 May and continued  
for 48 hrs. drawing  
large volumes of fine  
gray sand and approx.  
200 G.P.M. At this  
date (29 May) driller  
was given permission to  
move this well approx.  
150' north along railroad  
R.O.W. and drill into the  
first strata of shell rock  
encountered. Upon reaching  
the first strata of shell rock

it is the driller's intention to set a 10" pipe, containing a precast screen, into said strata and try to develop 200 GPM of sand-free water.

If no water can be developed in this manner he intends to go deeper with the 10" pipe and screen, stopping at frequent intervals to attempt pumping an adequate supply of sand-free water.

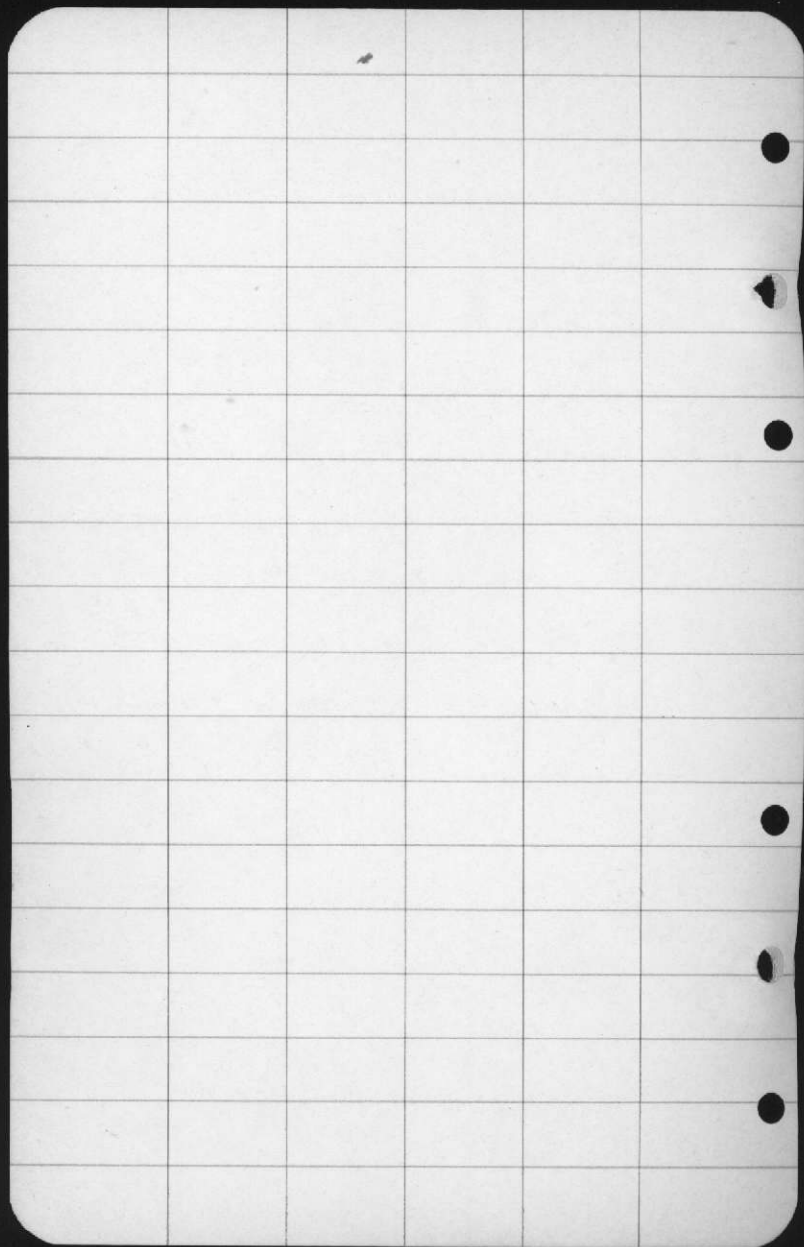

30 May 1951

Tarawa Terrace-Well No. 2(b)

0'-15' Sand & clay

15'-30' White sand & clay

30'-42' Fine gray sand

42'-65' Fine gray sand  
(some fine shell)

65'-73' Soft shell rock

73'-75' Fine gray sand

75'-78' Soft shell rock

78'-84' Hard shell rock

#2(b)

U/Fa 10" casing


#2(b)

With 10" casing down  
to 77' and well to 90',  
driller pumped 100 GPM  
of "crystal clear" water  
for about 5 hours.

This was not observed  
by the writer but  
as stated by the  
driller. It should  
be noted that no person  
from this organization  
was present during  
the drilling (from 0' - 90')  
or the pumping of  
this well on 30 May 1951.

31 May 1951

Driller pulled pump and  
8.

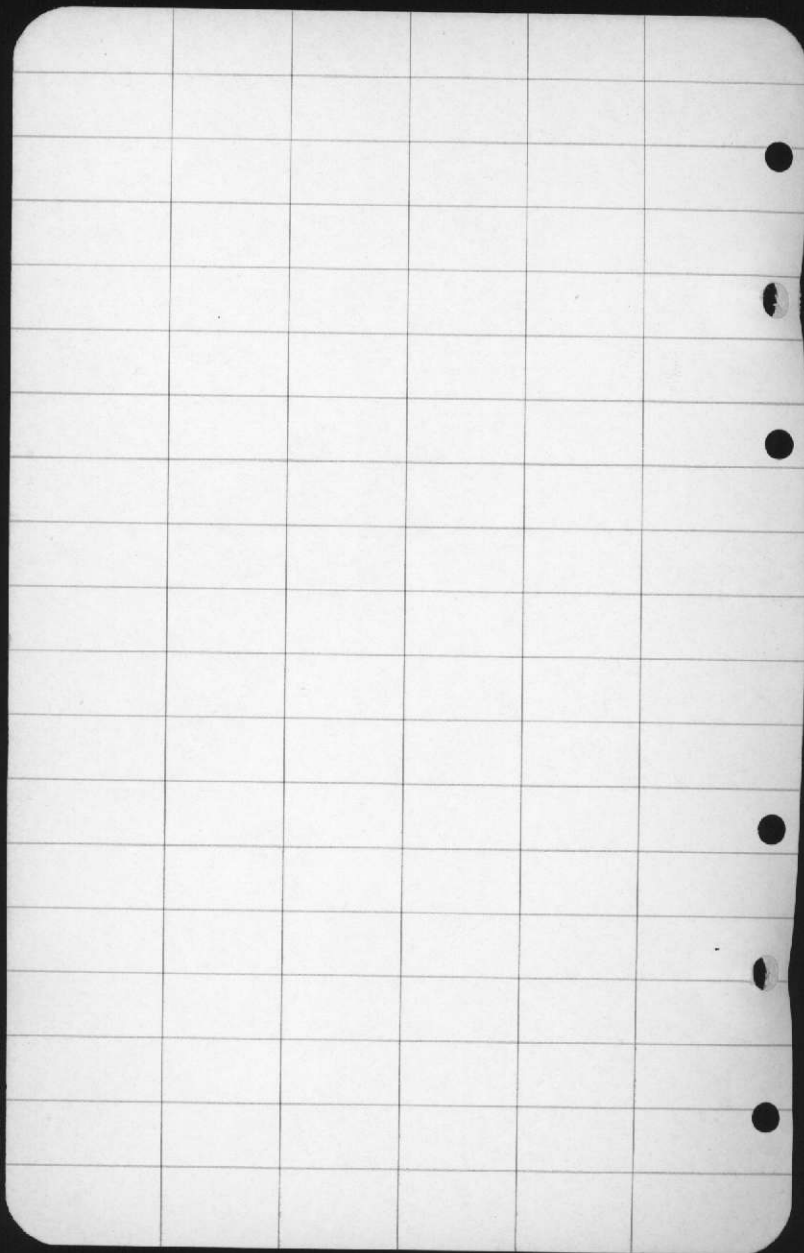



is drilling deeper.

10" pipe down to 77'

Driller stated this A.M.

that at 84' he broke

through the hard Coquina

Limestone ("shell rock")

and into the stratum

of soft, fine grained,

green limestone. (Questionable)

The green limestone contains

large amounts of clay

and very fine sand.

At this time the


driller has not put

a screen in the 10"

pipe as originally

intended nor did he

9.

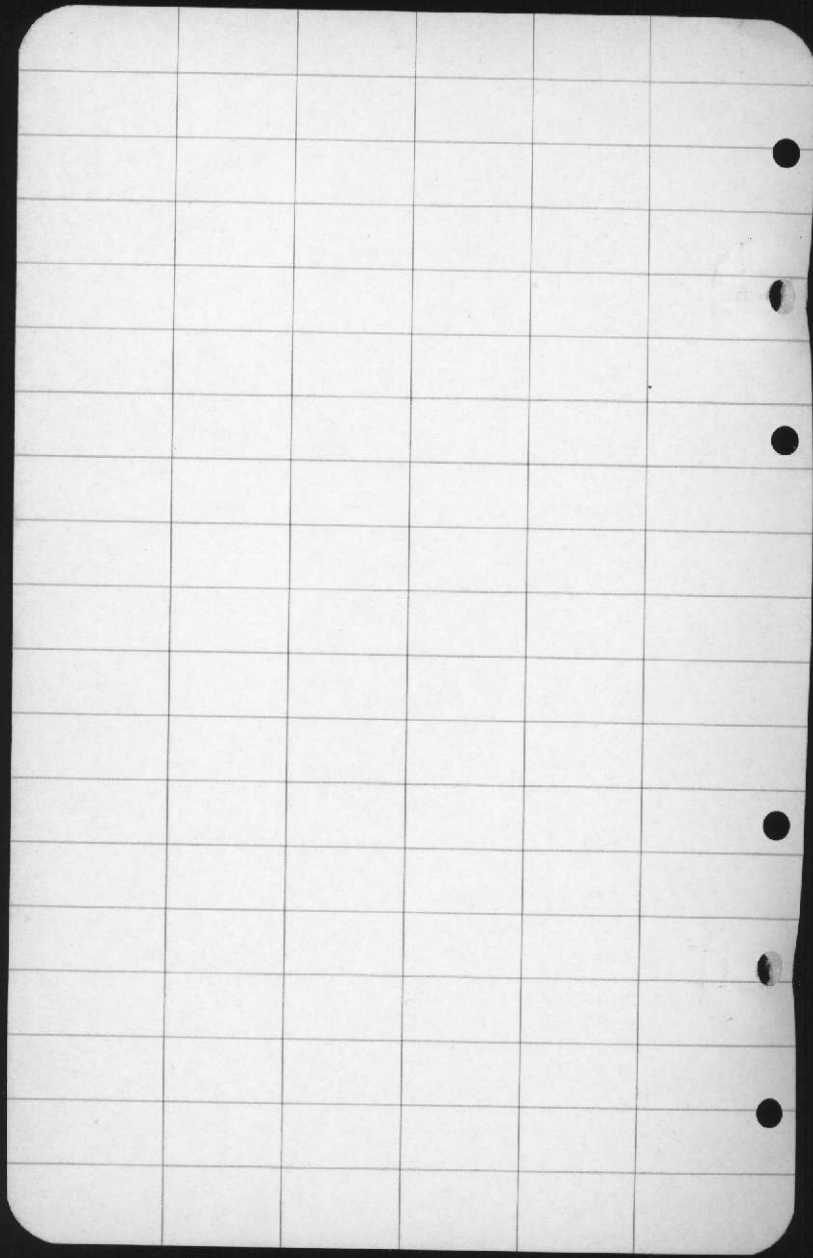

have a screen in while  
pumping on 30 May.

At 4.00 P.M. this date  
(31 May) the well has  
been drilled to depth  
of 150' and the stratum  
at this level is still  
the fine-grained green  
lime encountered (as  
stated by driller) at the  
84' level.

1 June 1950

No work was done  
this date by driller.

