



LOCATION OF PROPOSED NEW 3 ϕ POWER LINE (REA)
ON MILITARY RESERVATION - CAMP LEJEUNE - JAN. 13, 1956

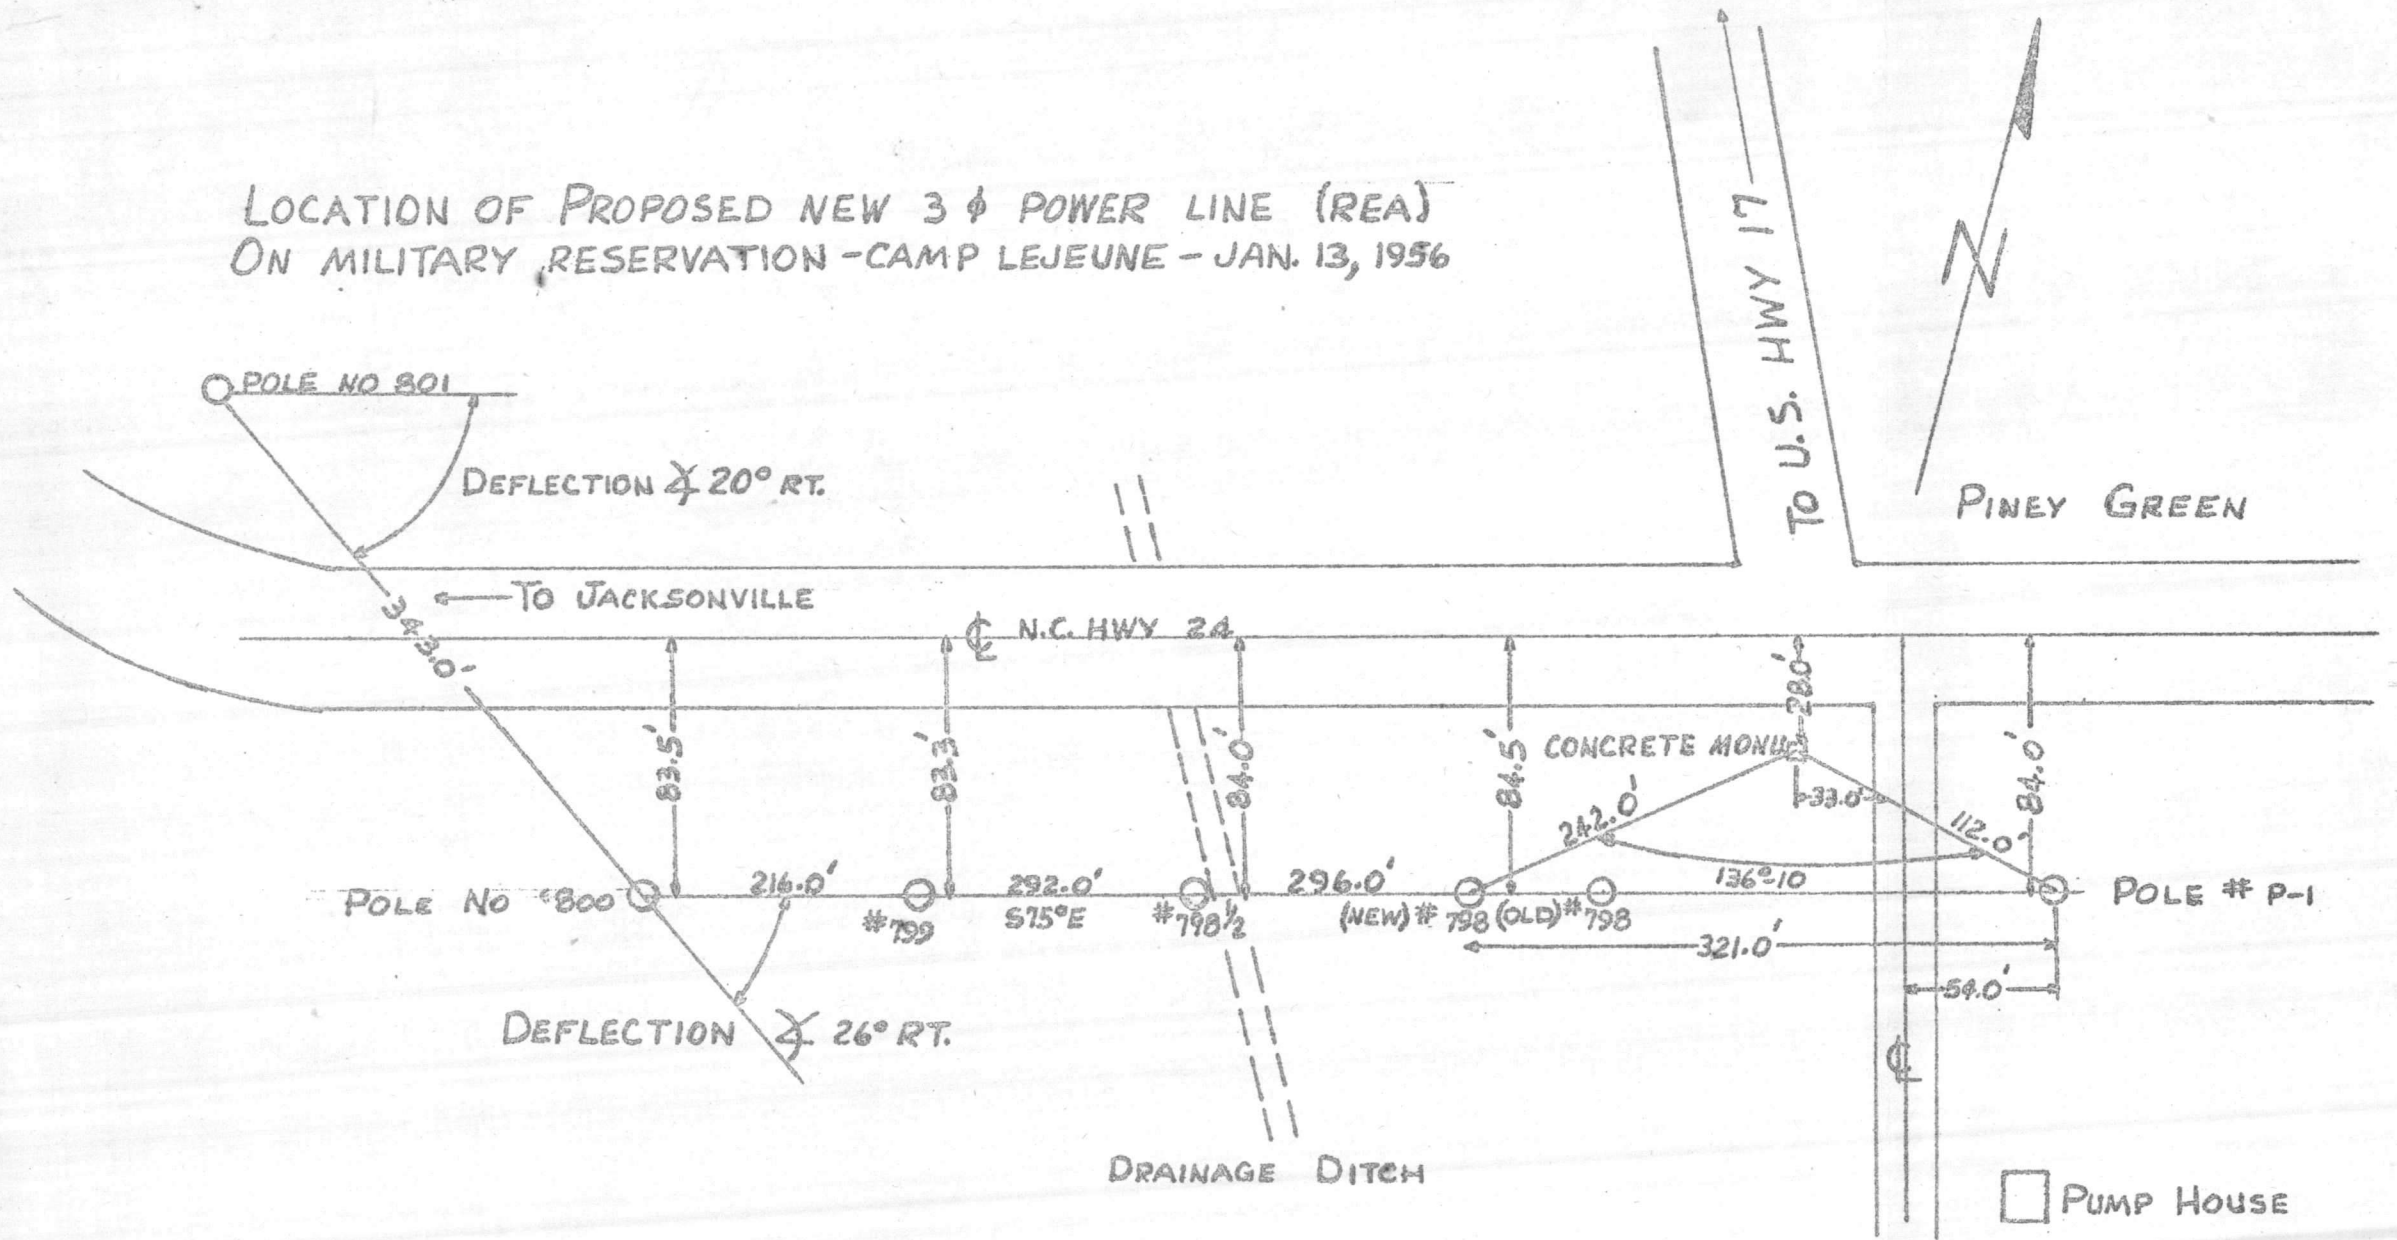

NOT TO SCALE


 

