

VALUABLE

RETURN TO
PUBLIC WORKS
OFFICE
CAMP LEJEUNE
NORTH CAROLINA

SUBJECT FLOOR ELEV. BLDG'S
CIA & LIS STONE ST.
EXT. AREA.

FIELD PARTY
DENNIS IN CHARGE
INSTRUMENT _____
NOTES _____
TAPE READ _____
TAPE OR ROD _____
TAPE OR ROD _____
INSTRUMENT NO. _____
TAPE NO. _____

WEATHER
CLEAR _____
CLOUDY _____
WINDY _____
RAIN _____
FAIR _____
SNOW _____
HOT _____
MODERATE _____
COLD _____
FOG _____
FIGURED BY _____
NOTES CHECKED BY _____
PLOTTED BY _____

FILE No. 120 6cm
FLDR. No. _____
SHEET 1 of 2
DATE 5-23-55

Quad. No. _____

STATION	DIST.	ANGLE ° ' "	+	H. I. BEARING	VER: ANG. DIFF.	ELEVATION
B.m.	687		3.43			31.35
				34.78		
T.P.			4.92	✓	4.59	30.19
				35.11		
T.P.			4.45	✓	4.22	30.89
				35.34		
T.P.			4.40	↓	4.42	30.92
				35.32		
T.P.			4.34	✓	4.14	31.18
				35.52		
T.P.			3.50	✓	4.15	31.37
				34.87		
B.m.			3.34	✓	2.84	32.03
				35.37		
T.P.			5.05	✓	5.12	30.25
				35.30		
			4.43	✓	4.02	31.29
				35.71		
T.P.			4.84	✓	4.80	30.91
				35.75		
T.P.			4.22	✓	4.58	31.17
				35.39		

? ← Assumed to be Bench Mark at Well # 615 - Next Sheet.


Also checks as 31.34 on 2/7/61

In error
Stop checks as 31.33
Floor must be 31.42
FL. ELEV. (CONCRETE) WELL # CIA
No



STATION
DATE
TIME

STATION
DATE
TIME

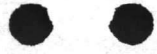

VALUABLE

SUBJECT _____

RETURN TO
PUBLIC WORKS
OFFICE
CAMP LEJEUNE
NORTH CAROLINA

FIELD PARTY

IN CHARGE

INSTRUMENT

NOTES

TAPE READ

TAPE OR ROD

TAPE OR ROD

INSTRUMENT No. _____

TAPE No. _____


WEATHER

CLEAR
CLOUDY
WINDY
RAIN
FAIR
SNOW
HOT
MODERATE
COLD
FOG
FIGURED BY _____
NOTES CHECKED BY _____
PLOTTED BY _____

FILE No. _____
FLDR. No. _____
SHEET _____
DATE _____ 19__

Quad. No. _____

STATION	DIST.	ANGLE		+	H. I. BEARING	VER: ANG. DIFF.	ELEVATION
		°	"				
					35.39		
T.P.	4.25				35.53	4.11	31.48
					35.43		
	3.21				34.08	4.66	30.77
					33.98		
B.M.# 5							31.33
						2.75	31.23

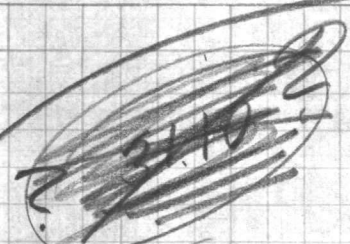

Change to
Elev. 31.11

FL. FL. (CONCRETE) WELL # 615

~~Assumed to be wrong description
and should be at Well # 615~~

RETURN TO




DATE



VALUABLE

SUBJECT

Check Levels

Stone St. Well # 614

(31.33)

31-18

RETURN TO
PUBLIC WORKS
OFFICE
CAMP LEJEUNE
NORTH CAROLINA

FIELD PARTY

Perrow

IN CHARGE

INSTRUMENT

NOTES

TAPE READ

TAPE OR ROD

TAPE OR ROD

INSTRUMENT NO.

TAPE NO.

WEATHER

CLEAR
CLOUDY
WINDY
RAIN
FAIR

SNOW
HOT
MODERATE
COLD
FOG

FILE No. _____

FLDR. No. _____

FIGURED BY _____

SHEET _____

NOTES CHECKED BY _____

PLOTTED BY _____

DATE *2/7/* 19*61*

Quad. No. _____

STATION	DIST.	ANGLE ° ' "	+	H. I. BEARING	VER: ANG. DIFF.	ELEVATION	
<i>B.M.</i>				<i>274 33 89</i>		<i>31.15</i>	<i>R/W MARKER N.E. COR. JUNIOR SENIOR HIGH SCHOOL</i>
<i>T.P.</i>				<i>467 34.61</i>	<i>3.95</i>	<i>29.94</i>	
<i>T.P.</i>				<i>470 35 37</i>	<i>3.94</i>	<i>30.67</i>	
<i>B.M.</i>				<i>403 31 34</i>	<i>(31.33)</i>	<i>STOOD ON WELL # C14</i>	













