

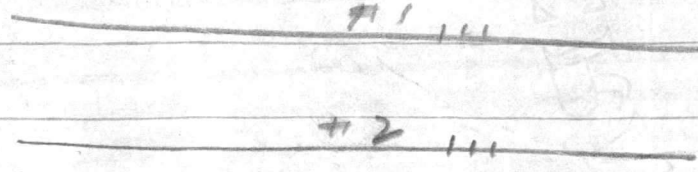


Laundry - 2"

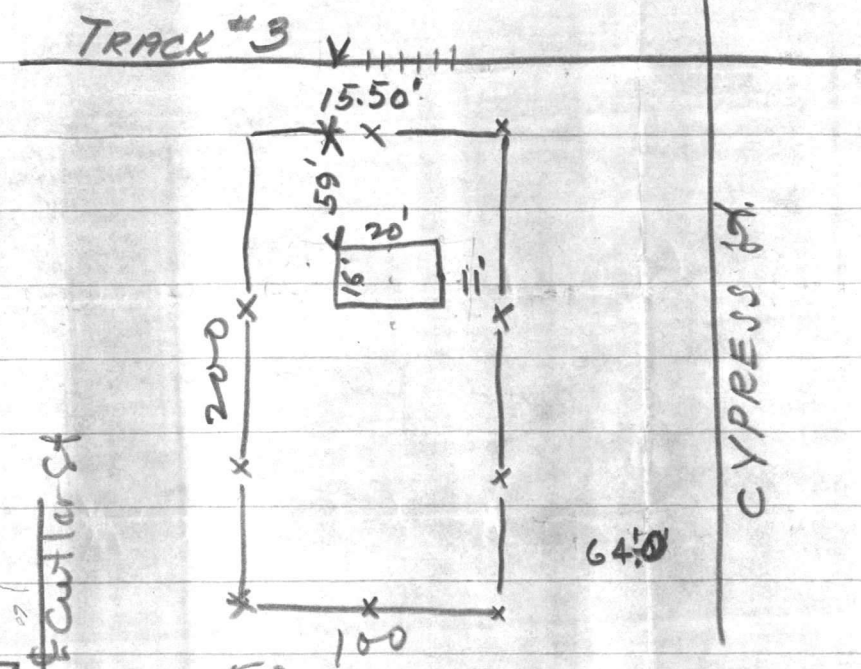

Cutter St

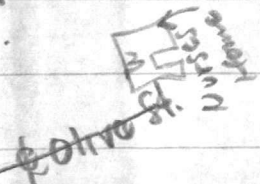

45' 6"  
60 12  
15' 6"

21-0  
10  
11'

PROPANE GAS STOR.  
Yd & Pump House

64' 0"

