

2

131 165
248-11-45

82-43-55

VALUABLE

RETURN TO
PUBLIC WORKS
OFFICE
CAMP LEJEUNE
NORTH CAROLINA

SUBJECT Floor Elevation of
F-11 Range Bldg.
Also New Well House on S. F. Rd.
Opposite Warehouse #904

FIELD PARTY

Dillon IN CHARGE
INSTRUMENT _____
NOTES _____
TAPE READ _____
TAPE OR ROD _____
TAPE OR ROD _____
INSTRUMENT No. _____
TAPE No. _____

WEATHER

CLEAR
CLOUDY
WINDY
RAIN
FAIR
SNOW
HOT
MODERATE
COLD
FOG

FILE No. _____

FLDR. No. _____

SHEET #2 of 2

DATE 3/11/1960

FIGURED BY _____

NOTES CHECKED BY _____

PLOTTED BY _____

Quad. No. _____

| STATION | DIST. | ANGLE | | | H. I. BEARING | VER. ANG. DIFF. | ELEVATION |
|--------------------------|-------|-------|---|------|------------------|--------------------|-----------|
| | | ° | ' | " | | | |
| B.M. | | | | | | | 30.49 |
| Fl. Elev. | | | | 5.06 | 35.55 | | 30.52 |
| Door stoop, outside Door | | | | | | 5.05 | 30.50 |
| T.P. | | | | | | 5.21 | 30.34 |
| Fl. Elev. | | | | 3.84 | 34.18 | 5.08 | 29.10 |

Spike in P.P. # A F-16 opposite Bldg. #904
New Well at Entrance Road to F-11 Range
F-11 Range Bldg.



















PUBLIC WORKS DEPARTMENT
Camp Lejeune, North Carolina
Survey Department

File 140-X
Quadrangle _____
Date 3/1/60
Sheet # 1 of 1

Traverse Computation
Description

Location of F-11 Pistol Range and Range Bldg.

| Station | Distance | Bearing | Cosine | Sine | Latitude | Departure | Y Coordinate North | X Coordinate East |
|-------------------------------|----------|-------------|--------------------------|--------|----------|-----------|--|--|
| U.S.M.C. Mon. # 369 | | N88°22'24"W | from U.S.M.C. Mon. # 116 | | | | 341, 724.67 ^{723.14} | 2,502, 757.41 ^{964.40} |
| P.I. "A" | 810.63 | S55°38'29"E | 995157 | 098302 | 806.70 | 79.69 | 340,917.97 | 2,503,046.90 |
| P.I. "B" | 492.36 | N67°27'51"E | 383261 | 923640 | 188.70 | 454.76 | 341,106.67 | 2,503,501.66 |
| Mon. "X" on Cor. Pistol Range | 192.4? | N5°19'E | 99570 | 09286 | 191.6 | 17.8 | 341,298.3 | 2,503,519.5 |
| Mon. "Y" " " " " | 76.2 | N9°34'E | 94225 | 33490 | 71.8 | 25.5 | 341,178.5 | 2,503,527.2 |
| Pole "A" | 61.5 | N35°-11'E | 81731 | 57619 | 50.3 | 35.4 | 341,157.0 | 2,503,537.1 |
| Pole "B" | 125.6 | S54°-41'E | 57810 | 81597 | 72.6 | 102.5 | 341,034.1 | 2,503,604.3 |
| ① Cor. Parking | 35' | N8°-07'E | 98998 | 14119 | 34.6 | 4.9 | 341,441.3 | 2,503,506.6 |
| ② " " | 139' | N4°-13'W | 99729 | 07353 | 138.6 | 10.2 | 341,245.3 | 2,503,491.5 |
| ③ " " | 145' | N31°-47'W | 85005 | 52671 | 123.3 | 76.4 | 341,130.0 | 2,503,485.3 |
| ④ | 58' | N88°-28'W | 02676 | 99964 | 1.6 | 58.0 | 341,108.3 | 2,503,443.7 |

100
50
5000
50
25000




VALUABLE

RETURN TO
PUBLIC WORKS
OFFICE
CAMP LEJEUNE
NORTH CAROLINA

SUBJECT

Location of Concrete
Wash, Grease, and Steam Cleaning Rack
@ M. Warehouse Area on Sneed's Ferry Rd.
Near of Warehouse #902

FIELD PARTY

Allen IN CHARGE
INSTRUMENT
NOTES
TAPE READ
TAPE OR ROD
TAPE OR ROD
INSTRUMENT NO.
TAPE NO.

WEATHER

CLEAR
CLOUDY
WINDY
RAIN
FAIR
SNOW
HOT
MODERATE
COLD
FOG
FIGURED BY
NOTES CHECKED BY
PLOTTED BY

FILE No. 140-X


FLDR. No. _____

SHEET #1 of 1

DATE 7/15/1960

Quad. No. _____

| STATION | DIST. | ANGLE ° ' " | + | H. I. BEARING | VER: ANG. DIFF. | ELEVATION |
|---------|-------|----------------|---|------------------|--------------------|-----------|
|---------|-------|----------------|---|------------------|--------------------|-----------|

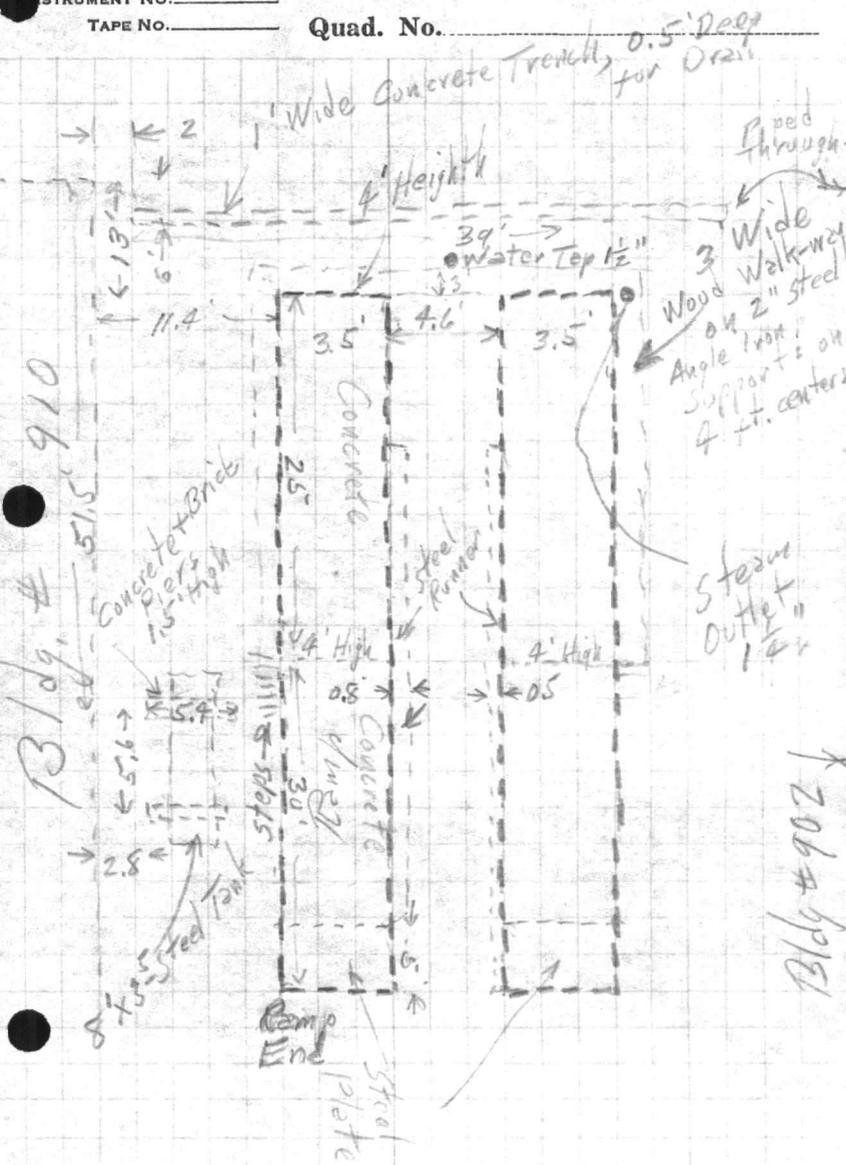

Bldg. # 910

Bldg #902

VALUABLE


Return To
Public Works
Office
Camp Lejeune
North Carolina

SUBJECT SKETCH SHOWING AS
BUILT WATER SYSTEM
INDUSTRIAL AREA EXPANSION

FIELD PARTY
KELHAM In Charge
Instrument _____
Notes _____
Tape Read _____
Tape or Rod _____
Tape or Rod _____
Instrument No. _____
Tape No. _____

WEATHER
Clear _____
Cloudy _____
Windy _____
Rain _____
Fair _____
Snow _____
Hot _____
Moderate _____
Cold _____
Fog _____
Figured By _____
Notes Checked By _____
Plotted By _____

FILE No. 140-8
Fldr. No. _____
Sheet 5-0/F
Date 5-1-19 17

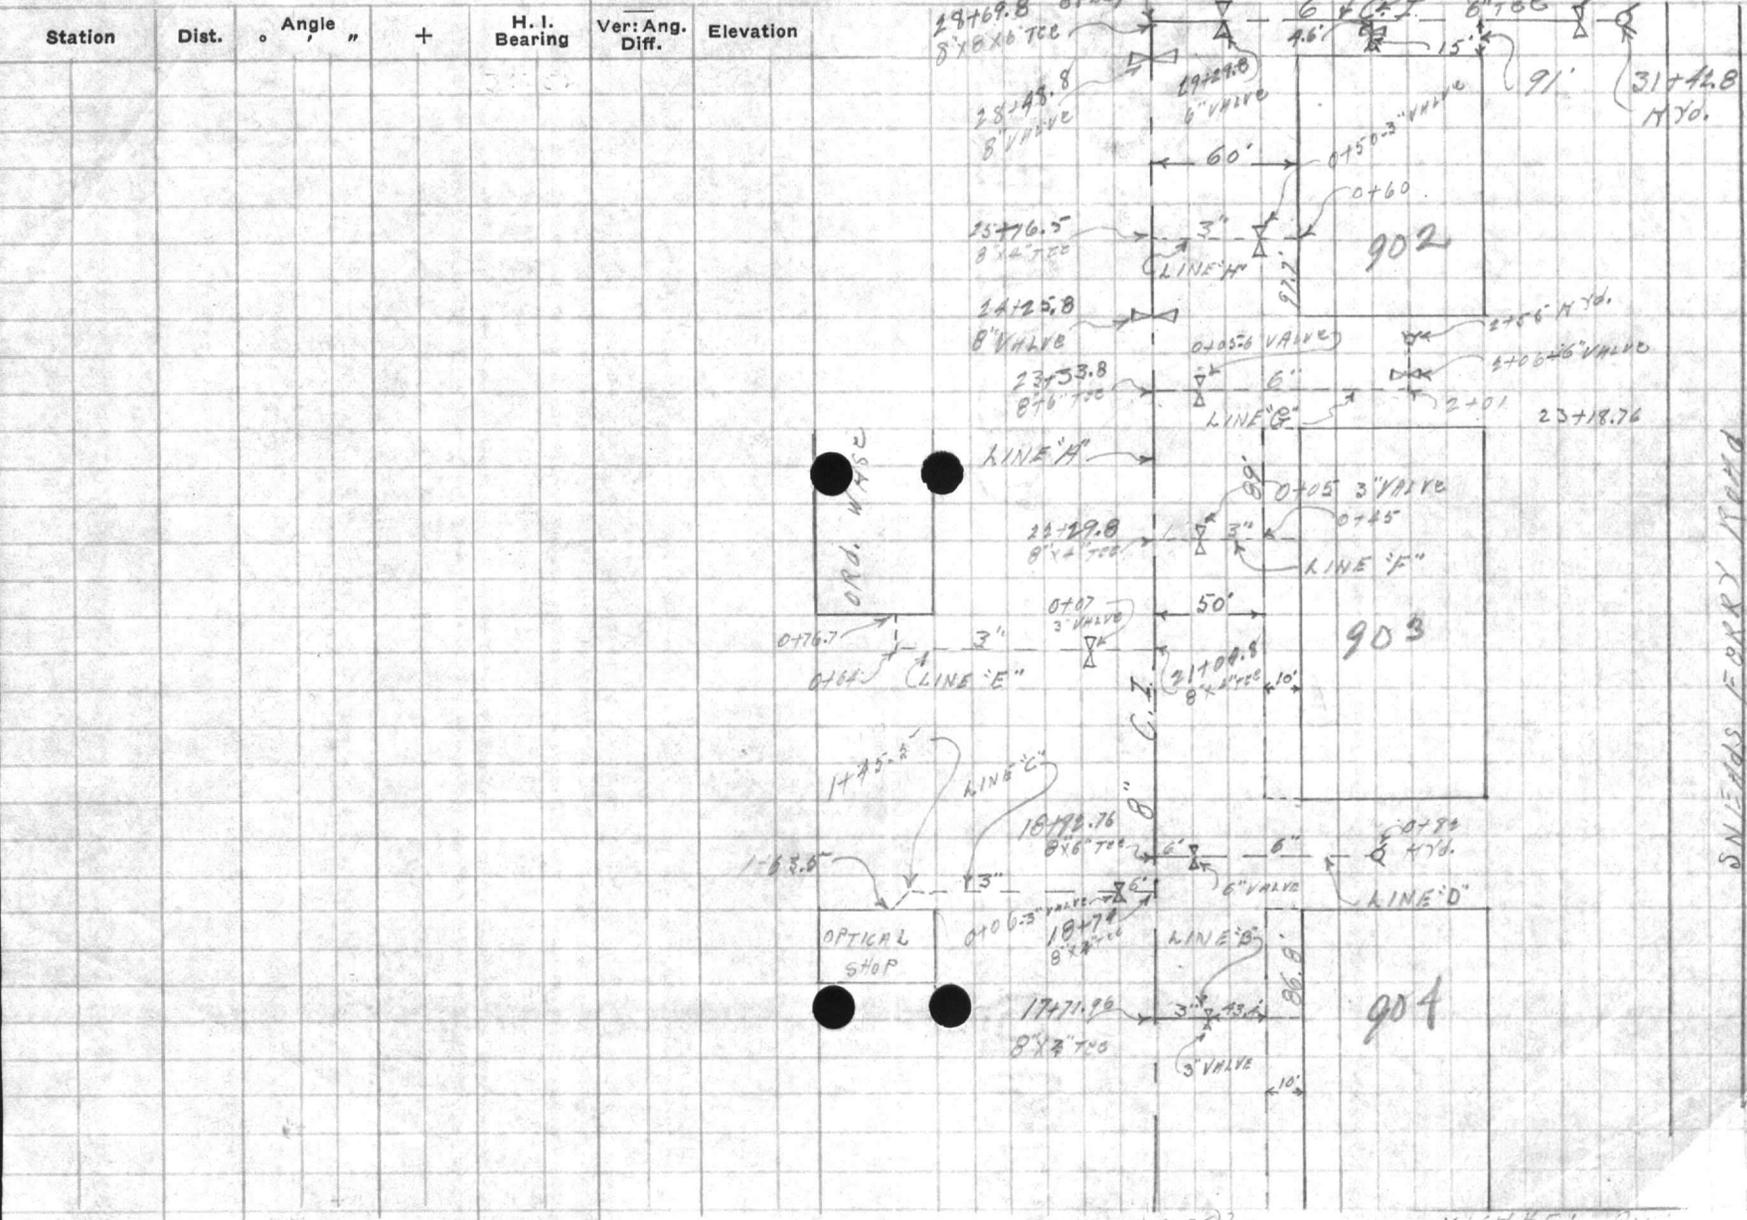

VALUABLE

SUBJECT PROFILE ON WATER SYSTEM
INDUSTRIAL AREA EXPANSION
SEE SKETCH SHEET #5

Return To
 Public Works
 Office
 Camp Lejeune
 North Carolina

FIELD PARTY
WELLS In Charge
 Instrument _____
 Notes _____
 Tape Read _____
 Tape or Rod _____
 Tape or Rod _____
 Instrument No. _____
 Tape No. _____

WEATHER
 Clear _____
 Cloudy _____
 Windy _____
 Rain _____
 Fair _____
 Snow _____
 Hot _____
 Moderate _____
 Cold _____
 Fog _____
 Figured By _____
 Notes Checked By _____
 Plotted By _____

FILE No. _____
 Fldr. No. _____
 Sheet 6-0F.
 Date 8-1- 19 97

Quad. No. _____

| Station | Dist. | Angle " " | + | H. I. Bearing | Ver: Ang. Diff. | Elevation | |
|--------------------------------|-------|--------------|------|------------------|--------------------|-----------|--------------------------|
| B.M. | | | 3.81 | 34.05 | | 30.24 | MAIL IN TELEPHONE POLICE |
| 18+74.6 LINE "A" | | | | | 11.16 | | |
| 0+00 LINE "C" | | | | | | | |
| 1+25.5 LINE "C" | | | | | 5.40 | | |
| 0+76.7 LINE "E" | | | | | 6.95 | | |
| 0+06 LINE "F" | | | | | 9.45 | 24.60 | |
| T.P. | | | 3.91 | 33.79 | 4.17 | 29.88 | |
| 23+33.8 LINE "A" | | | | | 10.54 | | |
| 0+00 LINE "B" | | | | | | | |
| 1+01 LINE "B" | | | | | 6.18 | | |
| 2+55 LINE "B" | | | | | 5.59 | | |
| 0+51 LINE "H" | | | | | 6.60 | | |
| T.P. | | | 4.20 | 33.92 | 4.07 | 29.72 | |
| 29+69.9 LINE "A" | | | | | 8.34 | | |
| 15+70 AT STA. 29+48.8 LINE "A" | | | | | 8.78 | | |
| 31+42.8 LINE "H" | | | | | 8.0 | | |
| T.P. | | | 5.26 | 34.52 | 3.86 | 30.26 | |
























VALUABLE

SUBJECT WATER LINE PROFILE
CONTINUED,

Return To
 Public Works
 Office
 Camp Lejeune
 North Carolina

FIELD PARTY

KELLY In Charge
 _____ Instrument
 _____ Notes
 _____ Tape Read
 _____ Tape or Rod
 _____ Tape or Rod
 _____ Instrument No.
 _____ Tape No.

WEATHER

Clear _____
 Cloudy _____
 Windy _____
 Rain _____
 Fair _____
 Snow _____
 Hot _____
 Moderate _____
 Cold _____
 Fog _____
 Figured By _____
 Notes Checked By _____
 Plotted By _____

FILE No. _____
 Fldr. No. _____
 Sheet 7-01-
 Date 5-1- 19 47

Quad. No. _____

| Station | Dist. | Angle " | + | H. I. Bearing | Ver: Ang. Diff. | Elevation | |
|---------|-------|---------|---|---------------|-----------------|-----------|------------------------|
| | | | | 35.52 | | | |
| T.P. | | 6.81 | | 30.39 | 5.34 | 30.18 | |
| B.M. | | | | 6.12 | 30.27 | | NAIL IN TELEPHONE POLE |
| | | | | 30.24 | | | |



















































VALUABLE

Return To
Public Works
Office
Camp Lejeune
North Carolina

SUBJECT PROFILE ON WATER
LINE - SIGNAL SUPPLY
WASE. INDUSTRIAL AREA
EXPANSION. SEE SHEET
A 1

FIELD PARTY
KELVIN In Charge
Instrument _____
Notes _____
Tape Read _____
Tape or Rod _____
Tape or Rod _____
Instrument No. _____
Tape No. _____

WEATHER
Clear _____
Cloudy _____
Windy _____
Rain _____
Fair _____
Snow _____
Hot _____
Moderate _____
Cold _____
Fog _____
Figured By _____
Notes Checked By _____
Plotted By _____

FILE No. 140-X
Fldr. No. _____
Sheet 2-02-1
Date 5-27-19 43

Quad. No. _____

| Station | Dist. | Angle " | + | H. I. Bearing | Ver: Ang. Diff. | Elevation |
|---------------|-------|---------|------|---------------|-----------------|-----------|
| B.M. | | | 2.06 | 34.53 | | 32.19 |
| 0+10 | | | | | 10.5 | 21.0 |
| 2+13 = 2+00 | | | | | 8.2 | 26.3 |
| 0+43 LINE "B" | | | | | 6.9 | 27.6 |
| 5+2-3 | | | | | 9.1 | 26.4 |
| 6+05 | | | | | 7.7 | 26.8 |
| B.M. | | | 2.06 | 32.19 | | |

NAIL IN TELEPHONE POLE AT MICHAEL Rd. & S.F. Rd.

NAIL IN TELEPHONE POLE AT MICHAEL Rd. AND SNEAS FERRY Rd. INTERS.

VALENTINE

Return to
Public Works
Office
Camp Lejeune
North Carolina

FIELD PARTY
Name _____
Date _____
Time _____
Weather _____
Map _____
Scale _____
Notes _____
Checked By _____
Plotted By _____
Date _____

Station _____
Dist. _____
Angle _____
Bearing _____
Elevation _____

28+70
17+72
10+98

600

1098
600
498

11

2

17+71.96
13+70.75
4+15.21

2869.80
1771.96
1097.84

2870
1772
1098
1600
498

VALUABLE

SUBJECT

Location & Elevation of B Water
Line Industrial Area Cross Connection
Wht. 902 to Holcomb Blvd. of S.F.R.

RETURN TO
PUBLIC WORKS
OFFICE
CAMP LEJEUNE
NORTH CAROLINA

FIELD PARTY

Caulk IN CHARGE
____ INSTRUMENT
____ NOTES
____ TAPE READ
____ TAPE OR ROD
____ TAPE OR ROD
____ INSTRUMENT NO.
____ TAPE NO.

WEATHER

CLEAR
CLOUDY
WINDY
RAIN
FAIR

SNOW
HOT
MODERATE
COLD
FOG

FILE No. 140-X

FLDR. No. _____

FIGURED BY _____

SHEET 1 of 1


NOTES CHECKED BY _____

DATE 6-25 19 53

PLOTTED BY _____

Quad. No. _____

| STATION | DIST. | ANGLE ° ' " | + | H. I. BEARING | VER: ANG. DIFF. | ELEVATION |
|-----------------------------------|-------|----------------|---|------------------|--------------------|------------------|

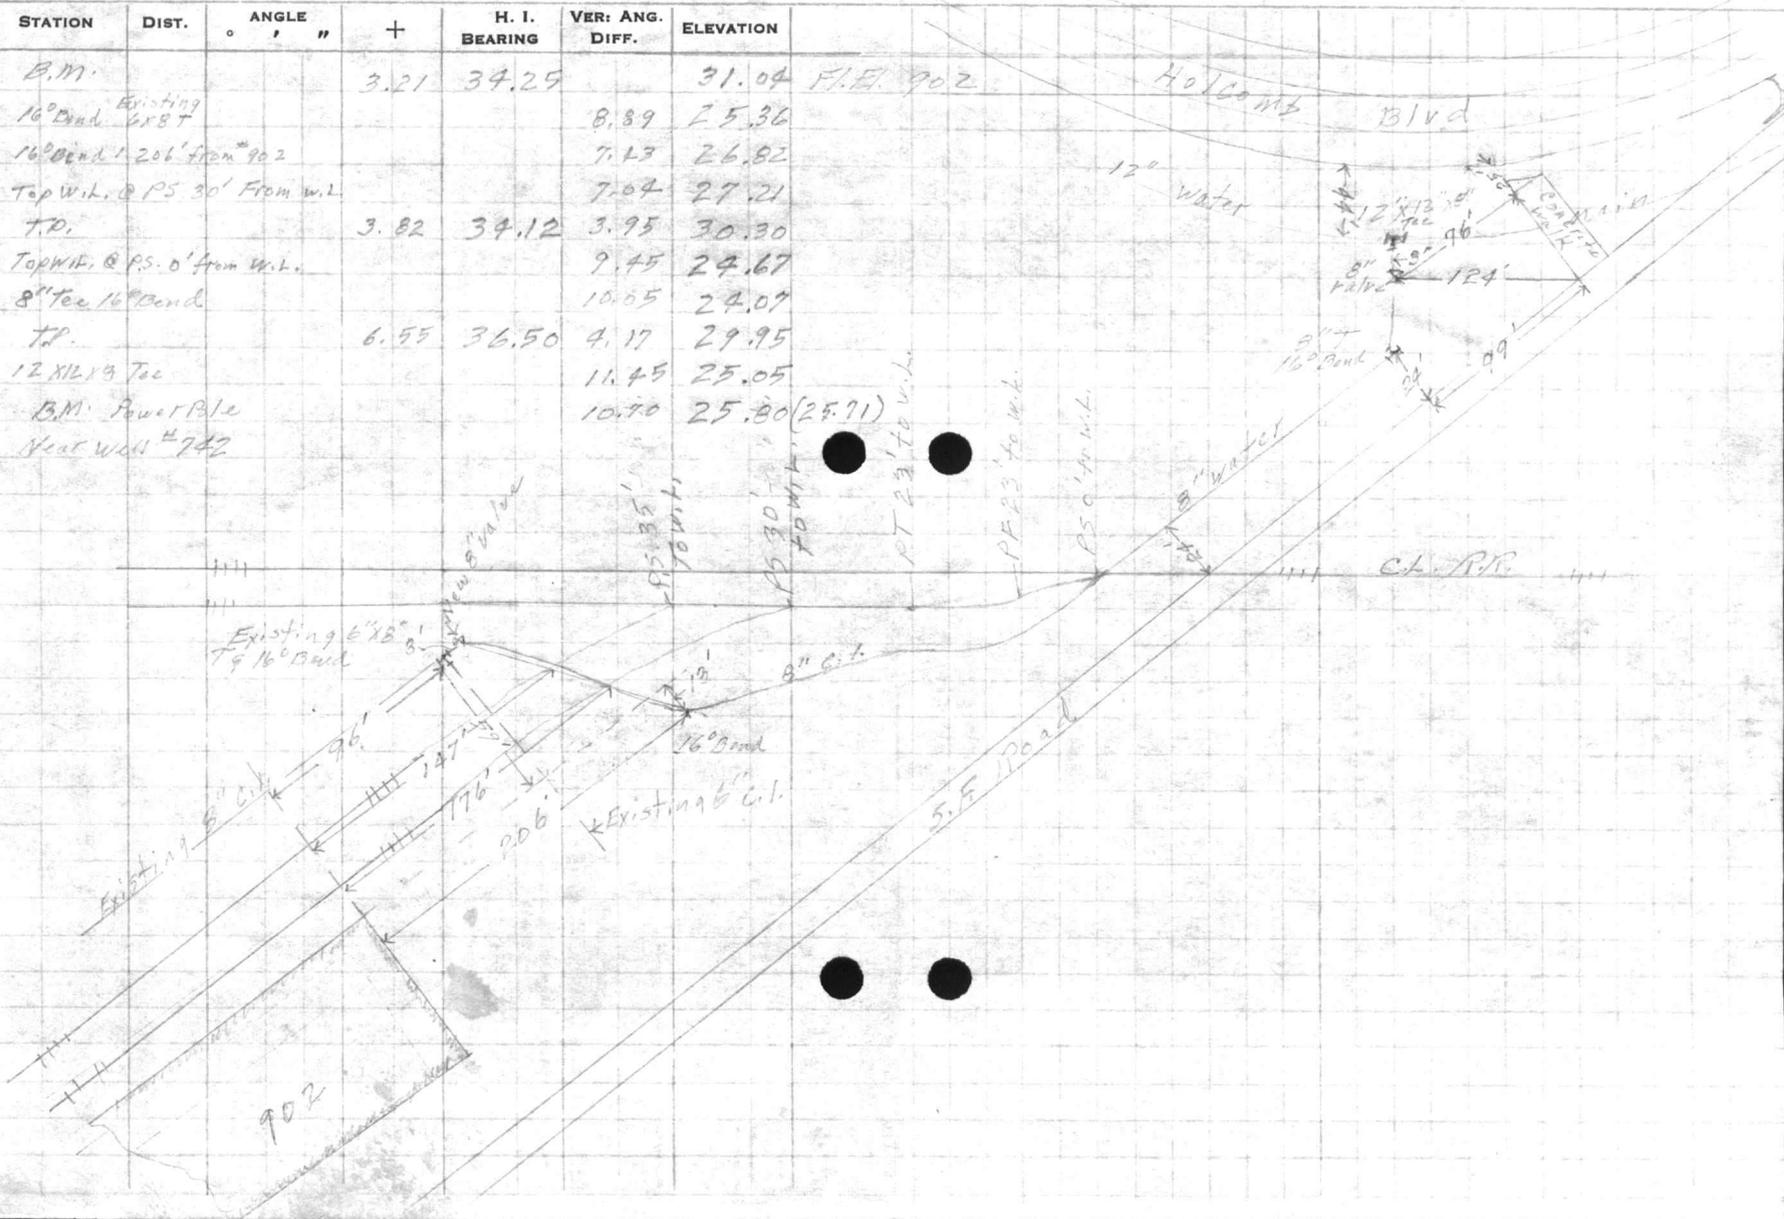






VALUABLE

Return To
Public Works
Office
Camp Lejeune
North Carolina


SUBJECT PROFILE ON 8" WATER LINE
INDUSTRIAL AREA

FIELD PARTY
KEITH In Charge
Instrument _____
Notes _____
Tape Read _____
Tape or Rod _____
Tape or Rod _____
Instrument No. _____
Tape No. _____

WEATHER
Clear _____
Cloudy _____
Windy _____
Rain _____
Fair _____
Snow _____
Hot _____
Moderate _____
Cold _____
Fog _____
Figured By _____
Notes Checked By _____
Plotted By _____
Quad. No. 140-160

FILE No. 140-X
Fldr. No. _____
Sheet 1-014
Date 6-19 1946

| Station | Dist. | Angle " | + | H. I. Bearing | Ver: Ang. Diff. | Elevation |
|---------|-------|---------|---|---------------|-----------------|-----------|
| B.M. | | 6.75 | | 36.75 | | 30.00 |
| 0+00 | | | | | 9.82 | 26.93 |
| 0+52 | | | | | 10.01 | 26.74 |
| 1+00 | | | | | 9.80 | 26.95 |
| 1+50 | | | | | 9.64 | 27.11 |
| 2+00 | | | | | 8.18 | 28.57 |
| 2+50 | | | | | 7.95 | 28.80 |
| 3+00 | | | | | 7.10 | 28.65 |
| 3+50 | | | | | 8.37 | 28.38 |
| 4+00 | | | | | 8.38 | 28.34 |
| 4+50 | | | | | 10.07 | 26.68 |
| T.P. | 7.67 | 34.44 | | | 9.98 | 26.77 |
| 5+00 | | | | | 9.39 | 25.05 |
| 5+36 | | | | | 9.55 | 24.89 |
| | | | | | 9.69 | 24.75 |
| | | | | | 9.26 | 25.18 |

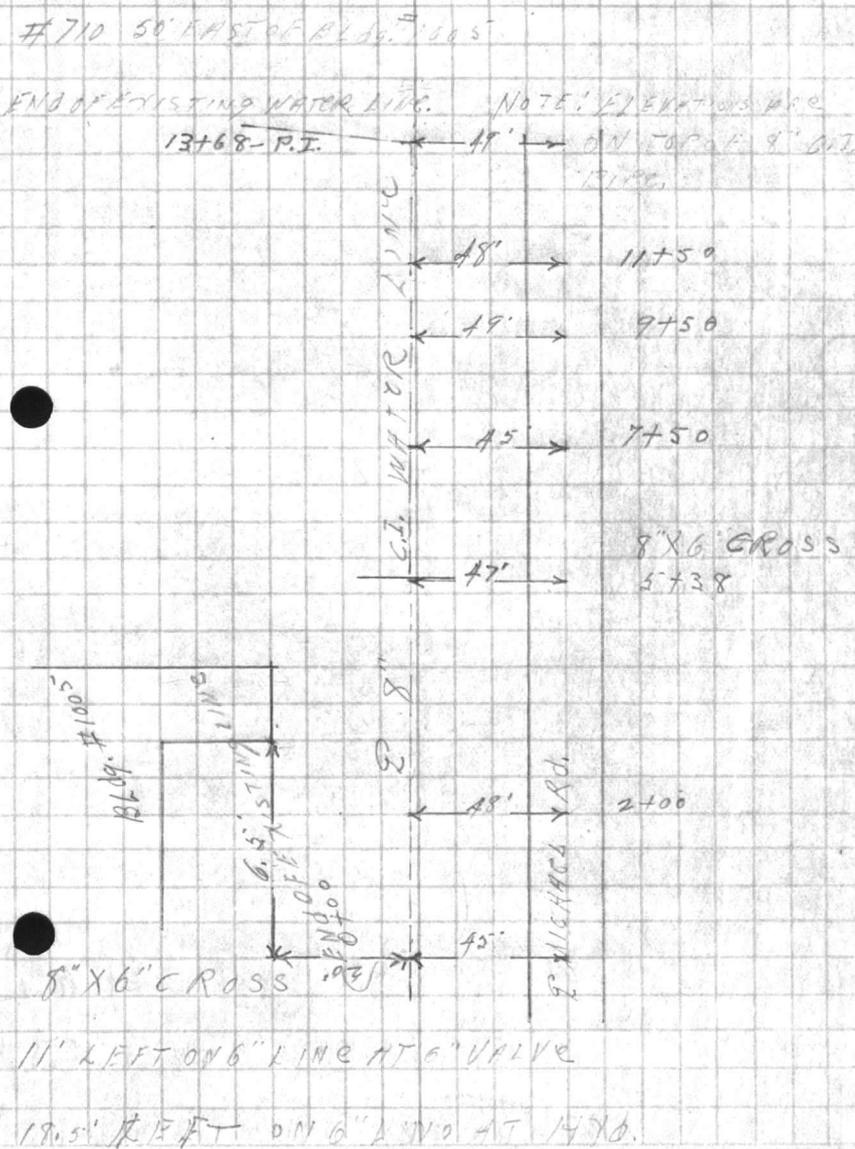







VALUABLE

SUBJECT WATER LINE PROFILE CONT.Return To
Public Works
Office
Camp Lejeune
North Carolina

FIELD PARTY

K. ALLEN In Charge
 _____ Instrument
 _____ Notes
 _____ Tape Read
 _____ Tape or Rod
 _____ Tape or Rod
 _____ Instrument No.
 _____ Tape No.

WEATHER

Clear _____
 Cloudy _____
 Windy _____
 Rain _____
 Fair _____

Snow _____
 Hot _____
 Moderate _____
 Cold _____
 Fog _____

FILE No. 140-X

Fldr. No. _____

Figured By _____ Sheet 2-0154

Notes Checked By _____

Plotted By _____ Date 6-19 1966Quad. No. 140-160

| Station | Dist. | Angle " " | + | H. I. Bearing | Ver: Ang. Diff. | Elevation | |
|---------|-------|--------------|---|------------------|--------------------|-----------|--------------------------------------|
| | | | | 34.42 ✓ | 9.39 | 25.05 | 11' TO R104 TONG 6" LINE AT 6" VALVE |
| 5749 | | | | | 9.99 | 24.45 | 8" TEMPORARY VALVE |
| 6700 | | | | | 9.49 | 24.95 | |
| 6750 | | | | | 9.75 | 24.69 | |
| 7400 | | | | | 9.40 | 25.04 | |
| 7750 | | | | | 8.74 | 25.70 | |
| 8700 | | | | | 9.90 | 24.54 | |
| 8750 | | | | | 10.23 | 24.21 | |
| 9700 | | | | | 10.97 | 23.47 | |
| 9750 | | | | | 10.51 | 23.93 | |
| 10700 | | | | | 10.01 | 24.43 | |
| T.P. | | 4.82 | | 35.11 ✓ | 4.16 | 30.28 ✓ | |
| 10750 | | | | | 9.57 | 25.54 | |
| 11400 | | | | | 9.16 | 25.95 | |
| 11750 | | | | | 9.27 | 25.84 | |

Station
Date
Time
Name

SUBJECT

Station
Date
Time
Name

Altitude
Dip
Magnetic

FIELD PARTY

Instrument
Notes
Tape head
Tape of Red
Tape of Blue
Tape No.
Tape No.

WEATHER

Clear
Partly
Cloudy
Windy
Misty
Rain
Fog
Thunder
Other

Form No.

Date
Time
Name

Form No.

VALUABLE

SUBJECT WATER LINE PROFILE
CONTD.

Return To
 Public Works
 Office
 Camp Lejeune
 North Carolina

FIELD PARTY

KELUM In Charge
 Instrument _____
 Notes _____
 Tape Read _____
 Tape or Rod _____
 Tape or Rod _____
 Instrument No. _____
 Tape No. _____

WEATHER

Clear _____
 Cloudy _____
 Windy _____
 Rain _____
 Fair _____

Snow _____
 Hot _____
 Moderate _____
 Cold _____
 Fog _____

FILE No. 140-X

Fldr. No. _____

Sheet 3-0134

Notes Checked By _____

Plotted By _____ Date 6-19 1946Quad. No. 140-160

| Station | Dist. | Angle " | + | H. I. Bearing | Ver: Ang. Diff. | Elevation | |
|---------|-------|---------|---|---------------|-----------------|-----------|-----------------------------------|
| | | | | 35.11 ✓ | | | |
| 12+00 | | | | 9.31 | | 25.80 | |
| 12+50 | | | | 10.23 | | 24.88 | |
| 13+00 | | | | 10.71 | | 24.40 | |
| 13+50 | | | | 11.11 | | 24.00 | |
| 13+68 | | | | 10.99 | | 24.12 | 8" X 8" TEE - (P. I.) |
| T. P. | 5.18 | | | 35.53 ✓ | 4.76 | 30.35 ✓ | |
| 13+80 | | | | 11.33 | | 24.20 | TEMPORARY 8" VALVE |
| 14+00 | | | | 11.03 | | 24.50 | |
| 14+50 | | | | 9.99 | | 25.54 | |
| 15+00 | | | | 9.77 | | 25.76 | |
| 15+06 | | | | 9.66 | | 25.87 | 8" X 6" TEE |
| | | | | 9.28 | | 26.25 | 11' TO LEFT ONE" LINE AT 6" VALVE |
| | | | | 8.75 | | 26.78 | 24' LEFT ONE" LINE AT END. |
| 15+50 | | | | 9.39 | | 26.14 | |
| 16+00 | | | | 8.40 | | 27.07 | |

VALUABLE

SUBJECT

Return To
Field Works
Office
Camp Station
North Carolina

Station Dist. Angle

Mag. Dip. Vert. Ang. Elevation

FIELD PARTY

Name _____
In Charge _____
Attendance _____
Notes _____
Time Read _____
Time for Rod _____
Time for Rod _____
Instrument No. _____
Face No. _____

WEATHER

Clear _____
Snow _____
Hot _____
Cloudy _____
Moderate _____
Windy _____
Cold _____
Rain _____
Fog _____

Plotted By _____

Notes Checked By _____

Checked By _____

Date _____

Sheet _____

File No. _____

VALUABLE

SUBJECT WATER LINE PROFILE
CONTS.

Return To
 Public Works
 Office
 Camp Lejeune
 North Carolina

FIELD PARTY
KELLM In Charge
 _____ Instrument
 _____ Notes
 _____ Tape Read
 _____ Tape or Rod
 _____ Tape or Rod
 _____ Instrument No.
 _____ Tape No.

WEATHER
 Clear _____
 Cloudy _____
 Windy _____
 Rain _____
 Fair _____
 Snow _____
 Hot _____
 Moderate _____
 Cold _____
 Fog _____
 Figured By _____
 Notes Checked By _____
 Plotted By _____
 FILE No. 140-X
 Fldr. No. _____
 Sheet A-0 F
 Date 6-19 1946
 Quad. No. 140-160

| Station | Dist. | ° Angle " | + | H. I. Bearing | Ver: Ang. Diff. | Elevation | |
|---------|-------|-----------|---|---------------|-----------------|-----------|--|
| | | | | 36.53 | ✓ | | |
| 16+50 | | | | 9.54 | | 26.99 | |
| 17+00 | | | | 9.57 | | 25.96 | |
| 17+38 | | | | 9.53 | | 26.00 | TEMPOR 5" VALVE - AS FAR AS LINE IS IT PRESENT |
| B.M. | | | | 4.21 | 21.32 ✓ | | NO. 115 |
| | | | | | (21.34) | | |
| | | | | | ERROR 02 | | |
| B.M. | | | | 3.57 | 33.81 | 30.19 | ON TOP PLANE P.L. 4 |
| 18+15 | | | | | 10.29 | | 8x3 TCC |
| | | | | | 10.48 | | 53' TO RIGHT END OF 3" L. LINE |
| 18+50 | | | | | 10.17 | | |

Return To
Public Works
Office
Camp Lejeune
North Carolina

SUBJECT

Station Dist. Angle + Bearings Hgt. Vertical Elevation

FIELD PARTY
Type of Trip
Notes
Instrument No.
Type No.

WEATHER
Clear
Cloudy
Hazy
Windy
Cold
Fog
Fogged By
Notes Checked By
Plotted By

FIELD No.
Field No.
Date

OFFICE OF THE
ENGINEER
CAMP LEJEUNE
NORTH CAROLINA

VALUABLE

SUBJECT

Power Line
To whse.
Ordnance Area

Return To
Public Works
Office
Camp Lejeune
North Carolina

FIELD PARTY

Turlington In Charge
Instrument
Notes
Tape Read
Tape or Rod
Tape or Rod
Instrument No.
Tape No.

WEATHER

Clear
Cloudy
Windy
Rain
Fair

Snow
Hot
Moderate
Cold
Fog

FILE No.

140-X

Fldr. No.

Sheet

#1 of 1

Notes Checked By

Figured By


Plotted By

Date

8/5 1946

Quad. No.

140

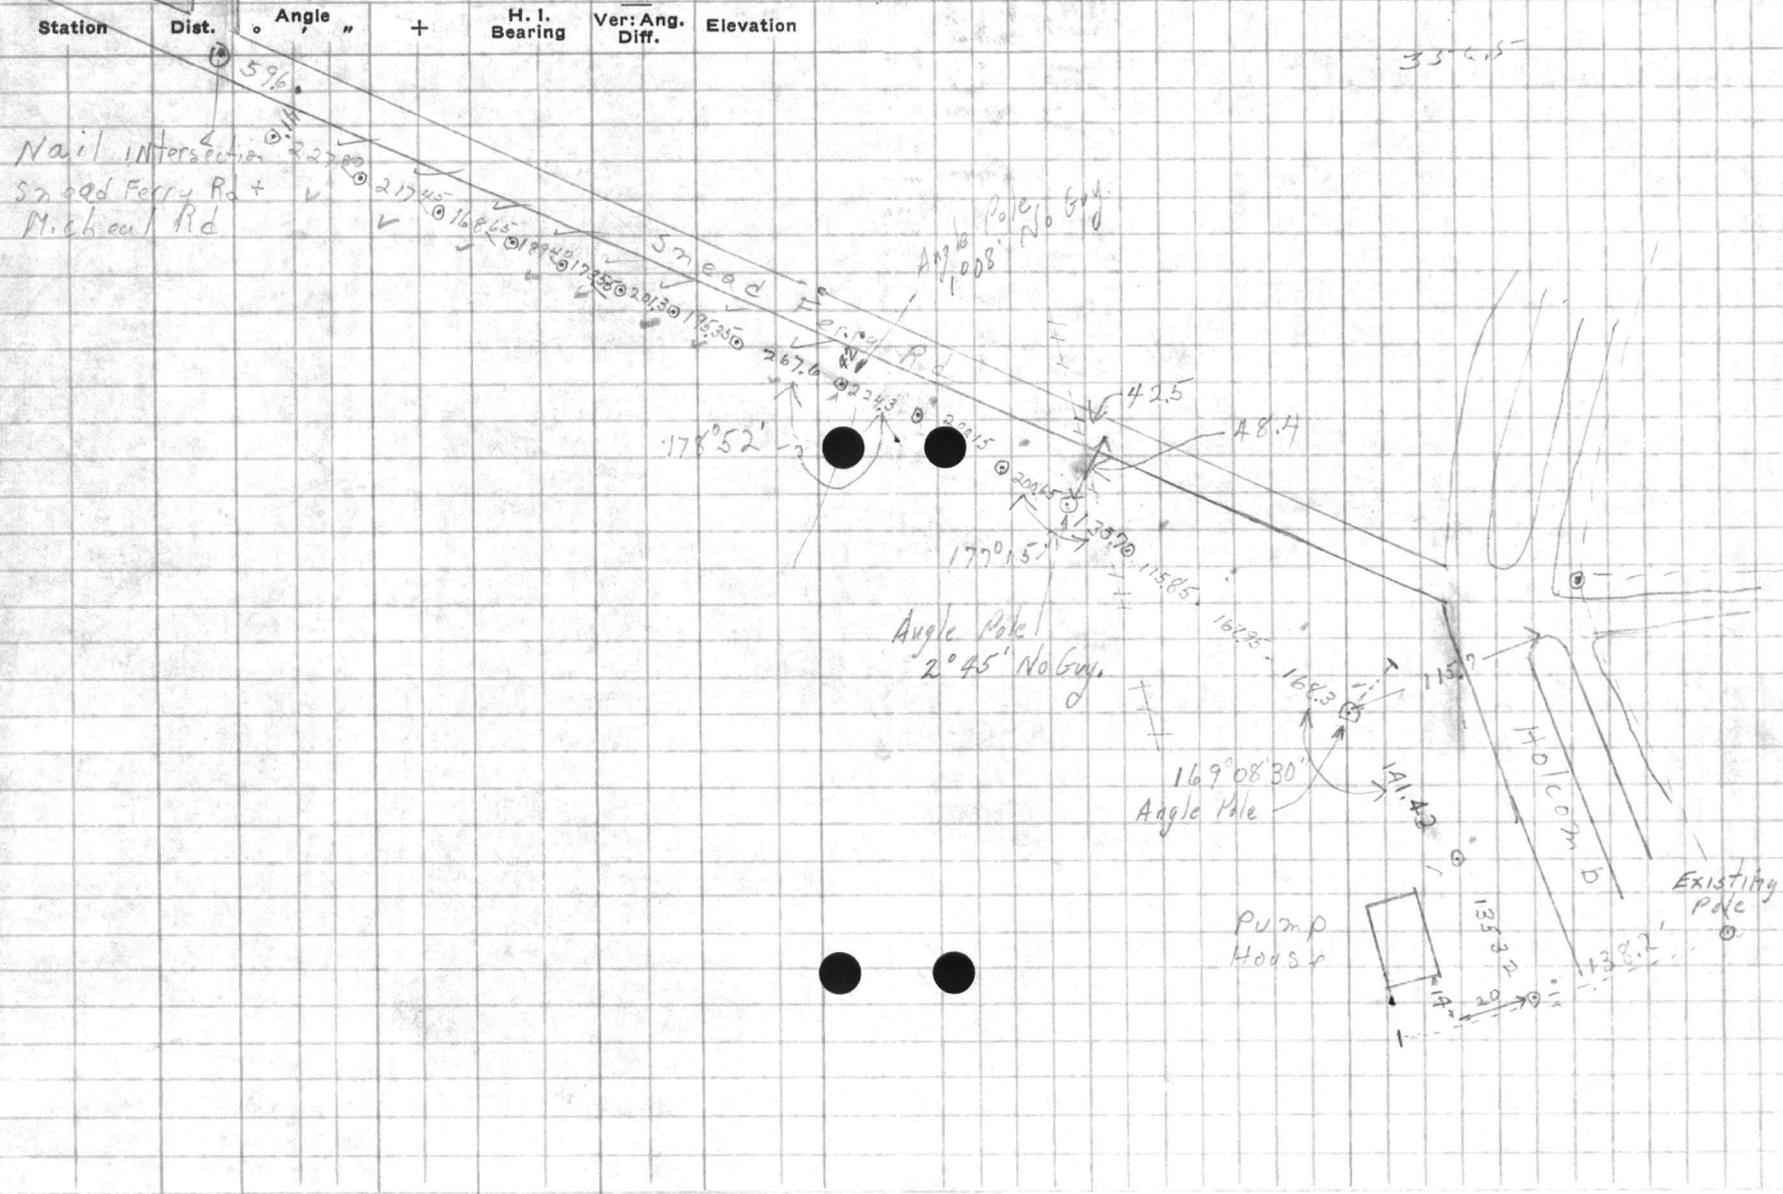

Nail Intersection
Smead Ferry Rd +
Michael Rd

Smead Ferry Rd
Angle Pole
178° 52'

Angle Pole
2° 45' No Guy.

Angle Pole
169° 08' 30"

Pump
House

Existing
Pole

3365

VALUABLE

RETURN TO
PUBLIC WORKS
OFFICE
CAMP LEJEUNE
NORTH CAROLINA

SUBJECT BENCH MARK FOR
WELL SITE ACROSS ST.
FROM BLDG. # 904
Well T-2

FIELD PARTY
DENNIS IN CHARGE
INSTRUMENT _____
NOTES _____
TAPE READ _____
TAPE OR ROD _____
TAPE OR ROD _____
INSTRUMENT NO. _____
TAPE NO. _____

WEATHER
CLEAR SNOW
CLOUDY HOT
WINDY MODERATE
RAIN COLD
FAIR FOG
FIGURED BY _____
NOTES CHECKED BY _____
PLOTTED BY _____

FILE No. 140-X
FLDR. No. _____
SHEET 1 of 1
DATE 11-4 1958

Quad. No. _____

| STATION | DIST. | ANGLE | | | H. I. | VER. ANG. | ELEVATION | |
|---------|-------|-------|------|---|-------|-----------|------------|--|
| | | ° | ' | " | | | | |
| B.M. | | | 5 24 | | 35.64 | ✓ | 30 40 | ON ENDS SPILLWAY NEAR WEST COR. BLDG. # 904 |
| B.M. | | | 4 94 | | 35.43 | ✓ | 5 15 30 49 | SPIKE IN P.P.M.A.F-12 ACROSS ST. N. COR. 904 |
| B.M. | | | | | 5.03 | ✓ | 30 40 | (30-40) |

VALUABLE

RETURN TO
PUBLIC WORKS





























