REVISIONS			
SYM	DESCRIPTION	DATE	APPROVED
1	AS BUILT REVISIONS	1/7/85	

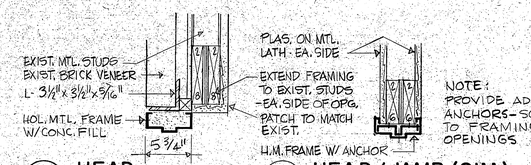

NOTE: PROVIDE ADJUSTABLE ANCHORS - SCREW APPLY TO FRAMING - TYP. @ FRAMED OPENINGS

J **HEAD** SCALE 1½" = 1'-0"

K **HEAD / JAMB (SIM.)** SCALE 1½" = 1'-0"

G **JAMB** SCALE 1½" = 1'-0"

H **JAMB** SCALE 1½" = 1'-0"

E **JAMB** SCALE 1½" = 1'-0"

F **THRESHOLD** SCALE 1½" = 1'-0"

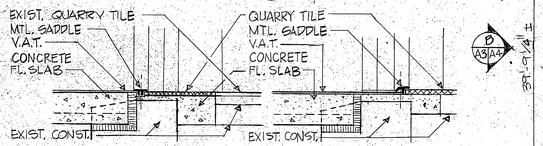

C **THRESHOLD** SCALE 1½" = 1'-0"

D **THRESHOLD** SCALE 1½" = 1'-0"

NOTE - ALL MATERIALS ARE NEW UNLESS OTHERWISE INDICATED

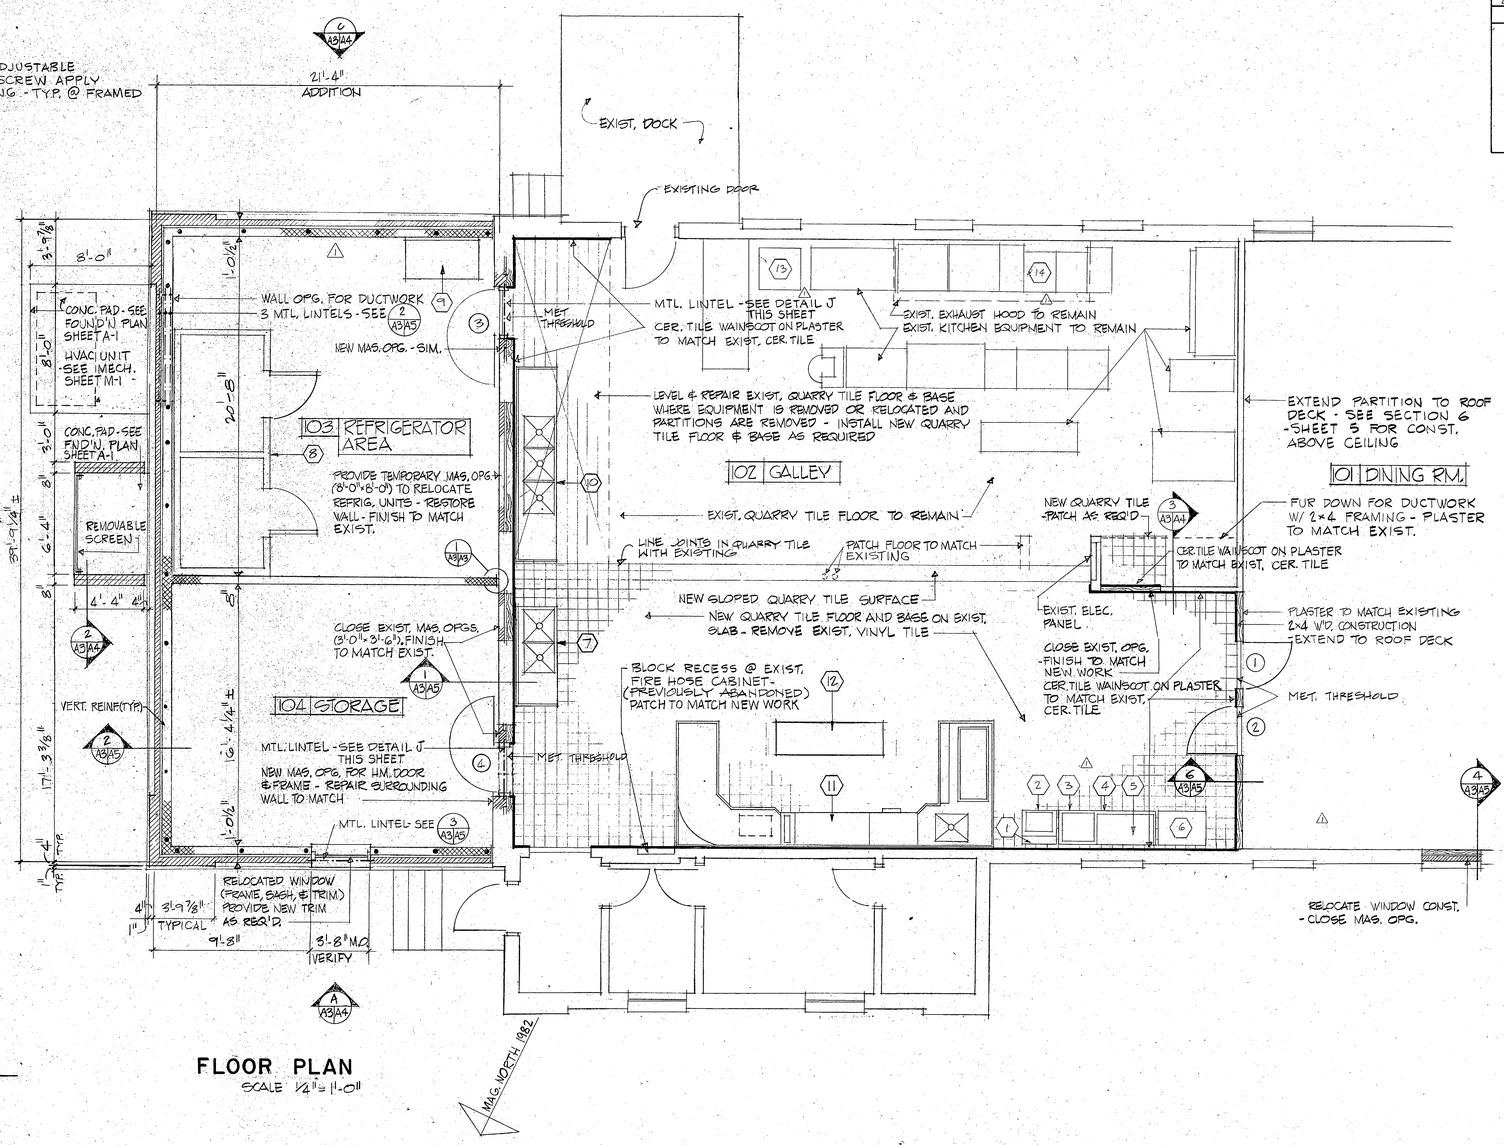

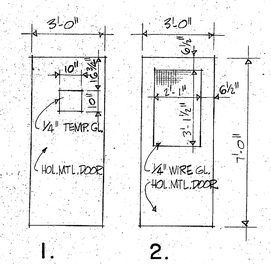

A **DOOR ELEVS.** SCALE 3/8" = 1'-0"

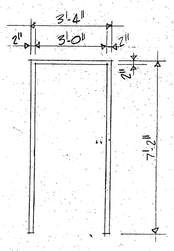

B **FRAME ELEV.** SCALE 3/8" = 1'-0"

A A3/A4 **FLOOR PLAN** SCALE ¼" = 1'-0"

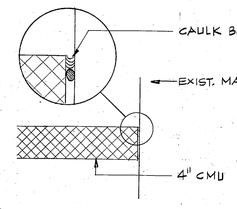

1 A3/A3 **DETAIL** 1½" = 1'-0"

NEW EQUIPMENT SCHEDULE (CONTRACTOR FURNISHED)

MK	DESCRIPTION	MANUFACTURER	CATALOG NO.	SIZE LENGTH	SIZE DEPTH	SIZE HEIGHT	REMARKS
10	TRIPLE COMP. POT & PAN SINK	DUKE	243C-2DB	120"	27½"	44⅝"	S.S. W/ COVED CORNERS, 14539 FAUCET
11	SCULLERY SYSTEM	HOBART (KNOWN SOURCE)	CPW-90	102⅜"	33⅞"	68⅝"	SEE ISOMETRIC ON SHEET P-1

RELOCATED EQUIPMENT SCHEDULE

MK	DESCRIPTION	REMARKS
1	WATER STATION	
2	ICE STORAGE STATION	
3	COFFEE MAKER	
4	UTILITY STAND	
5	PASTRY CASE	
6	ROLL WARMER	
7	POT SINK	
8	REFRIGERATOR & FREEZER	
9	ICE MACHINE	
12	GET-UP & DISH TABLE	
13	CONV. OVEN	
14	DEEP FAT FRYER	

DOOR SCHEDULE

MK	DOOR WIDTH	DOOR HEIGHT	DOOR THK.	DOOR TYPE	DOOR MAT'L.	DOOR FINISH	FRAME TYPE	FRAME MAT'L.	FRAME FINISH	FRAME HEAD	FRAME JAMB	GLAZING	THRESHOLD MAT'L.	THRESHOLD DETAIL	NOTES	MK
1	3'-0"	7'-0"	1¾"	1	H.M.	PAINT	1	H.M.	PAINT	K	H,K	¼" TEMP.	METAL	F		1
2	3'-0"	7'-0"	1¾"	1	H.M.	PAINT	1	H.M.	PAINT	K	H,K	¼" TEMP.	METAL	F		2
3	3'-0"	7'-0"	1¾"	2	H.M.	PAINT	1	H.M.	PAINT	J	E,G	¼" WIRE GL.	METAL	C		3
4	3'-0"	7'-0"	1¾"	2	H.M.	PAINT	1	H.M.	PAINT	J	E,G	¼" WIRE GL.	METAL	D		4

NOTES
1.

ROOM FINISH SCHEDULE

MK	ROOM NO.	ROOM NAME	FLOOR	BASE (3½")	WALLS	CEILING	CEILING HEIGHT	NOTES	ROOM NO.
1	101	DINING ROOM	NO WORK	WOOD	PLASTER TO MATCH EXIST.	NO WORK	-	1, 3	101
2	102	GALLEY	QUARRY TILE	Q.T.	PLASTER W/ CER. TILE WAINS.	ACOUS. TILE LAY-IN	9'-6"	2, 4	102
3	103	REFRIG. AREA	V.A.T.	RUBBER	PAINT	ACOUS. TILE LAY-IN	9'-6"		103
4	104	STORAGE	V.A.T.	RUBBER	PAINT	ACOUS. TILE LAY-IN	9'-6"		104
5									
6									
7									
8									
9									
12									
13									
14									

NOTES
1. SALVAGE 20 LINEAR FT. W'D. BASE, CAP, & SHOE FROM DEMOLITION
2. EXIST. WAINSCOT IS 6'-6" ± HIGH
3. EXIST. PLASTER IS COVERED W/ VINYL WALL FABRIC
4. EXIST. PLASTER IS PAINTED

GRAPHIC SCALES

SCALE 1-1/2" = 1'-0"
12" 6" 0 1' 2'

SCALE 3/8" = 1'-0"
1' 0 5'

SCALE 1/4" = 1'-0"
1' 0 5' 10'

322

AS BUILT

A-3

ALPHA DESIGN GROUP, INC.
Architectural Planning
P. O. Box 6578
RALEIGH, NORTH CAROLINA 27628

DES. CB | DR. CB | CHK. RLC
PROJ. MGR. | CH. ENGR.
SUBMITTED BY: RONALD L. COLLIER DATE: 11/19/82
FIRM MEMBER PRINCIPAL
EFD: FP-10A RVD
HD DIR
APPROVED DATE
ACTIVITY - SATISFACTORY TO
APPROVED DATE
FOR EFD COMMANDER NAVFAC

RONALD L. COLLIER REGISTERED NO. 1984 ARCHITECT NORTH CAROLINA

DEPARTMENT OF THE NAVY NAVAL FACILITIES ENGINEERING COMMAND
ATLANTIC DIVISION
NAVAL STATION NORFOLK, VIRGINIA
MARINE CORPS BASE CAMP LEJEUNE, N.C.
GALLEY ADDITION/RENOVATION
BUILDING 322 HADNOT POINT
FLOOR PLAN

SIZE F | CODE IDENT. NO. | NAVFAC DRAWING NO. 4088260
CONSTR. CONTR. NO. N62470-81-B-1390
SCALE NOTED | SPEC 05-81-1390 | SHEET 3 OF 9
EFD DWG. NO. 188260