

PETERFIELD POINT
MARINE CORPS AIR FACILITIES


NUMBER	LOCATION	USE
LF-1	OUTLYING	AIR FIELD
LF-2	16-M	OPERATIONS BUILDING
LF-3	16-M	ADMINISTRATION BUILDING
LF-4	16-M	TRANSFORMER BUILDING
LF-5	16-M	PAINT-AND-PIPE-STORAGE-GHED
LF-6	16-M	UTILITY SHOP
LF-7	16-M	WOODEN STORAGE HANGER
LF-8	16-M	UTILITY SHOP
LF-9	16-M	HEATING PLANT
LF-10	16-M	CARBURETOR-TEST-SHOP
LF-11	16-M	TRANSFORMER BUILDING
LF-12	16-M	GUN-AIR INSTRUCTOR
LF-13	16-M	PAINT SHOP
LF-14	16-M	OIL-AND-GAS-HOUSE
LF-15	16-M	WAREHOUSE
LF-16	16-M	WAREHOUSE
LF-17	16-M	WAREHOUSE
LF-18	16-M	BEACON TOWER
LF-19	16-M	TEMPORARY ADMINISTRATION BUILDING

EXPLANATION

- BUILDINGS
- ASPHALT SURFACED
- SHELL ROCK SURFACED
- RAILROADS

NUMBER	LOCATION	USE
TB-101	3-J	TANK BATTALION CAMP
S-TB-102	3-J	PUMP HOUSE AND WELL'S
		WATER PRESSURE TANK

MAP OF
CAMP GEIGER-PETERFIELD POINT
AND VICINITY
CAMP LEJEUNE, NORTH CAROLINA
SHOWING CONDITIONS ON
30 JUNE 1952

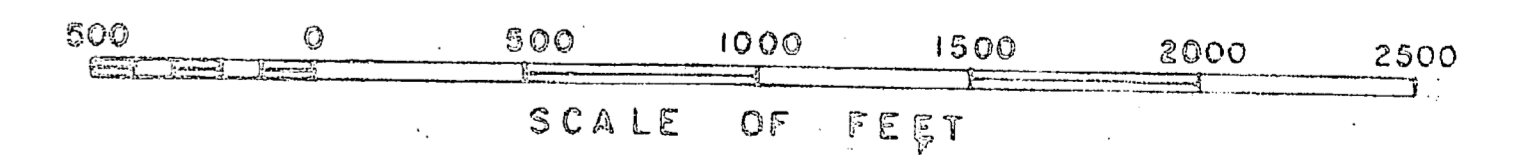

SCALE OF FEET
Stephen Papan
COMMANDER (C) C 1 USM
PUBLIC WORKS OFFICER

FOR LEGEND REFER TO SHEET 7-C

SHEET 7 OF 14

RESTRICTED P. LEJEUNE, N. C.

