

REVISIONS			
NO.	DESCRIPTION	DATE	APPROVED
1	CLARIFICATION	7/1/85	AY

# NALCOMIS REPAIRABLES MANAGEMENT MODULE (NRMM) PROJECT

## MCAS (H) NEW RIVER

### JACKSONVILLE, NORTH CAROLINA

NALCOMIS  
6386

**INDEX OF DRAWINGS**

- T-1 TITLE SHEET
- E-1 DUCTWORK PLAN
- E-2 DETAILS AND BUILDING AS 4120
- E-3 ONE LINE DIAGRAM AND HANGER AS 4108
- E-4 HANGAR AS 4106
- E-5 HANGARS AS 4100 & AS 504
- E-6 BUILDING AS 4110
- E-7 BUILDING AS 4141
- E-8 BUILDING AS 4146
- E-9 HANGAR AS 518
- E-10 HANGAR AS 515
- E-11 BUILDING AS 424
- E-12 BUILDING AS 425
- E-13 HANGAR AS 504

**LEGEND**

- MANHOLE WITH IDENTIFICATION NUMBER
- DUCTBANK SYSTEM WITH DATA TRANSMISSION CABLE
- LATERAL SERVICE WITH DATA TRANSMISSION CABLE
- PRIMARY LINE 12.5KV WITH NEUTRAL
- SECONDARY LINE 120/208 VOLT QUADRUPLEX
- UNDERGROUND ELECTRICAL SERVICE 120/208 VOLTS
- EXISTING WOOD POLE
- EXISTING WOOD POLE TO BE REMOVED
- WOOD POLE
- EXISTING OVERHEAD TRANSFORMER BANK
- OVERHEAD TRANSFORMER BANK
- EXISTING GUY WIRE AND ANCHOR
- EXISTING ELECTRICAL PANEL
- ELECTRICAL PANEL
- FUSED DISCONNECT SWITCH
- HOME RUN TO PANEL
- EXISTING BUS DUCT
- ENCLOSED CIRCUIT BREAKER
- EXISTING DRY TYPE TRANSFORMER
- TWO DUPLEX RECEPTACLE
- TWO DUPLEX RECEPTACLE WEATHERPROOF
- INTERNAL TERMINAL CABINET
- EXTERNAL TERMINAL CABINET - SEE LATERAL SVC DETAIL SHEET E-9.
- INTERNAL TERMINAL OUTLET
- EXTERNAL TERMINAL OUTLET WEATHERPROOF
- JUNCTION BOX - SEE LATERAL SVC DETAIL SHEET E-9.
- CONDUIT AND DATA TRANSMISSION CABLE INSIDE
- CONDUIT AND DATA TRANSMISSION CABLE OUTSIDE EXPOSED

**ABBREVIATIONS**

- MH MANHOLE
- BKR BREAKER
- A AMPERE
- SVC SERVICE
- C CONDUIT
- TER TERMINAL
- V VOLTS
- N NEUTRAL
- GR GROUND
- RECEPT RECEPTACLE
- BLDG BUILDING
- CKT CIRCUIT
- JB JUNCTION BOX
- EXIST EXISTING
- ELECT ELECTRICAL
- Ø PHASE
- W WIRE
- MLO MAIN LUG ONLY
- P POLE
- NTS NOT TO SCALE

*CHGIM DATES ON DRG'S  
17, 19, 20, 28 FEB  
4, 5, 7, MAR*

T-1	
DIBBLE & ASSOCIATES, P.A. PO BOX 1801 WASHINGTON, NC 27889 DESIGNED BY: [Signature] DRAWN BY: [Signature] CHECKED BY: [Signature] DATE: 7/25/85	DEPARTMENT OF THE NAVY - NAVAL FACILITIES ENGINEERING COMMAND <b>MARINE CORPS BASE</b> CAMP LEJEUNE, NORTH CAROLINA NALCOMIS REPAIRABLES MANAGEMENT MODULE (NRMM) MCAS (H) NEW RIVER JACKSONVILLE, NORTH CAROLINA TITLE SHEET NAVFAC DRAWING NO. 4126643 CODE IDENT. NO. 80091 SCALE: CON. I.C. SPEC. 05-05-6386   SHEET 1 OF 14

LT KERRA

*[Handwritten signature]*


85-6386

NALCOMIS

10

10

REVISIONS			
SYMBOL	DESCRIPTION	DATE	APPROVED
△	Revised	7/2/88	

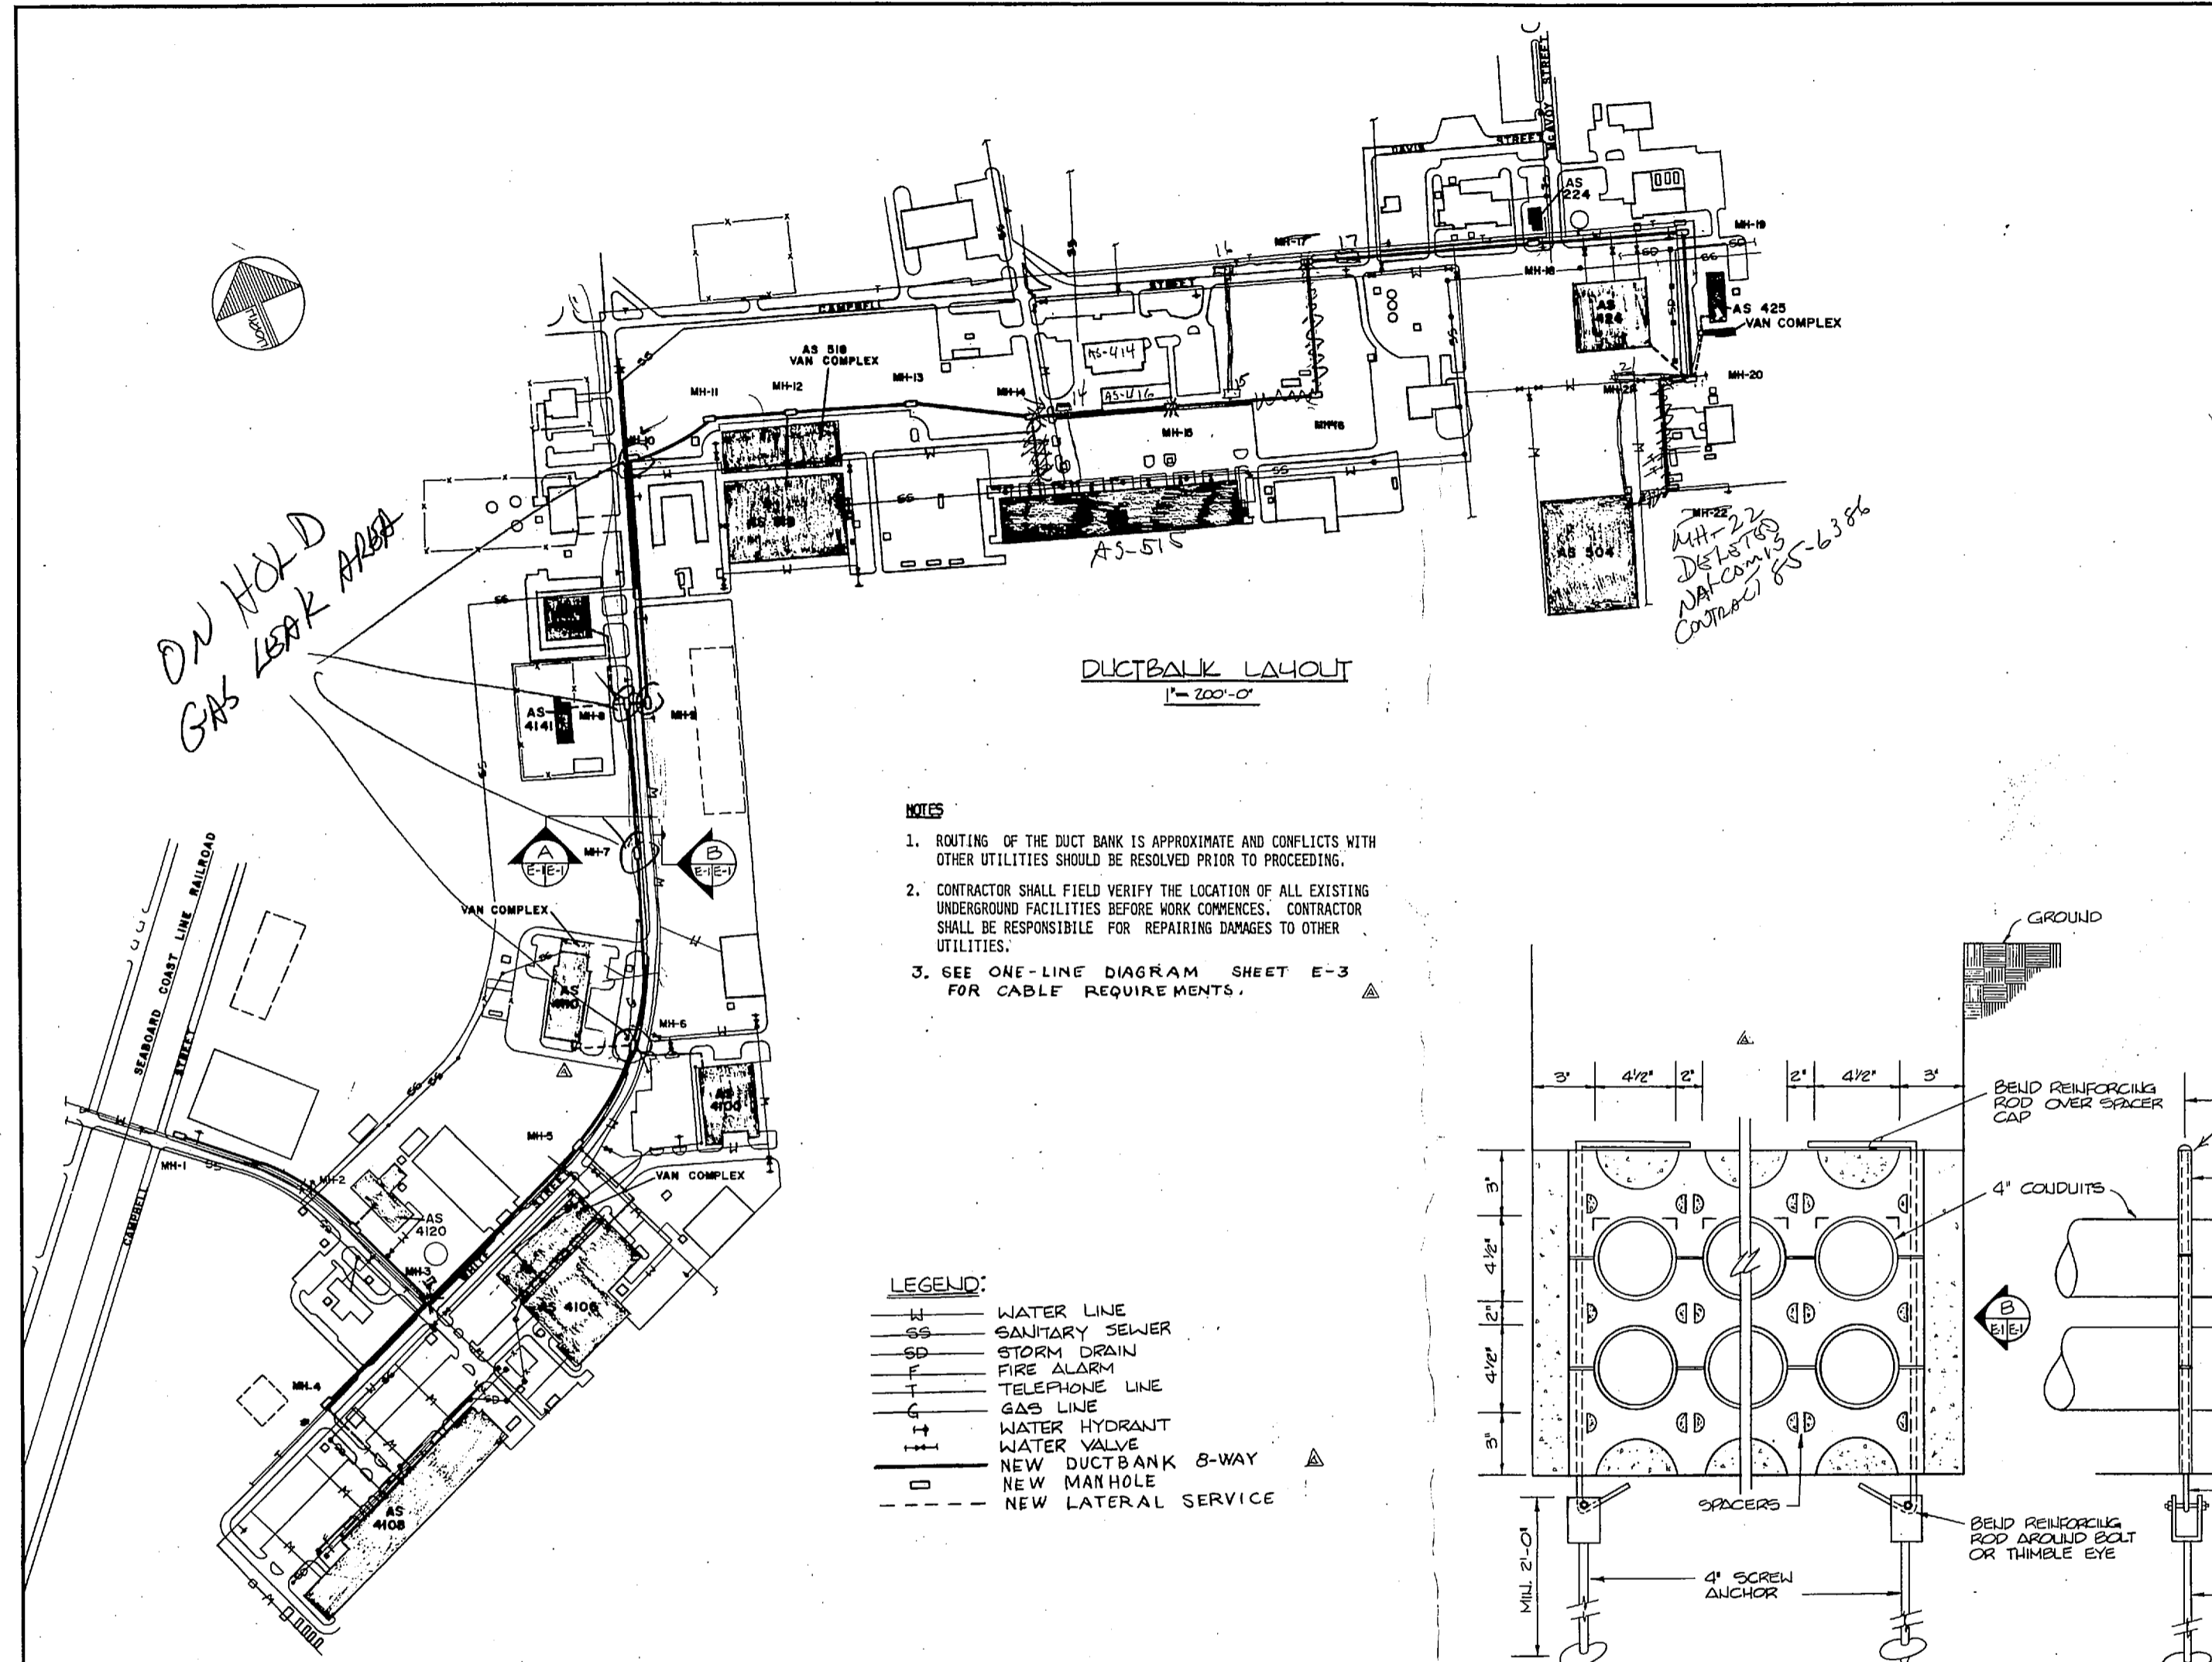


**DUCTBANK LAYOUT**  
1" = 200'-0"

- NOTES**
- ROUTING OF THE DUCT BANK IS APPROXIMATE AND CONFLICTS WITH OTHER UTILITIES SHOULD BE RESOLVED PRIOR TO PROCEEDING.
  - CONTRACTOR SHALL FIELD VERIFY THE LOCATION OF ALL EXISTING UNDERGROUND FACILITIES BEFORE WORK COMMENCES. CONTRACTOR SHALL BE RESPONSIBLE FOR REPAIRING DAMAGES TO OTHER UTILITIES.
  - SEE ONE-LINE DIAGRAM SHEET E-3 FOR CABLE REQUIREMENTS.


**LEGEND:**

— W —	WATER LINE
— SS —	SANITARY SEWER
— SD —	STORM DRAIN
— F —	FIRE ALARM
— T —	TELEPHONE LINE
— G —	GAS LINE
— H —	WATER HYDRANT
— V —	WATER VALVE
— D —	NEW DUCTBANK 8-WAY
— M —	NEW MANHOLE
— L —	NEW LATERAL SERVICE


- GENERAL NOTES:**
- ALL JUNCTION BOXES AT VAN COMPLEX WEATHERPROOF WITH GASKETED SCREW COVERS.
  - SEE LATERAL SERVICE SECTION SHEET E-9.
  - SEE ONE-LINE DIAGRAM, SHEET E-8, FOR TYPICAL BLDG/AREA LAYOUT.
  - PROVIDE 3000 FT OF 3 PAIR CABLE & 1000 FT OF 1 1/2" FLEXIBLE WEATHER SEAL CONDUIT & TURN OVER TO GOVERNMENT.

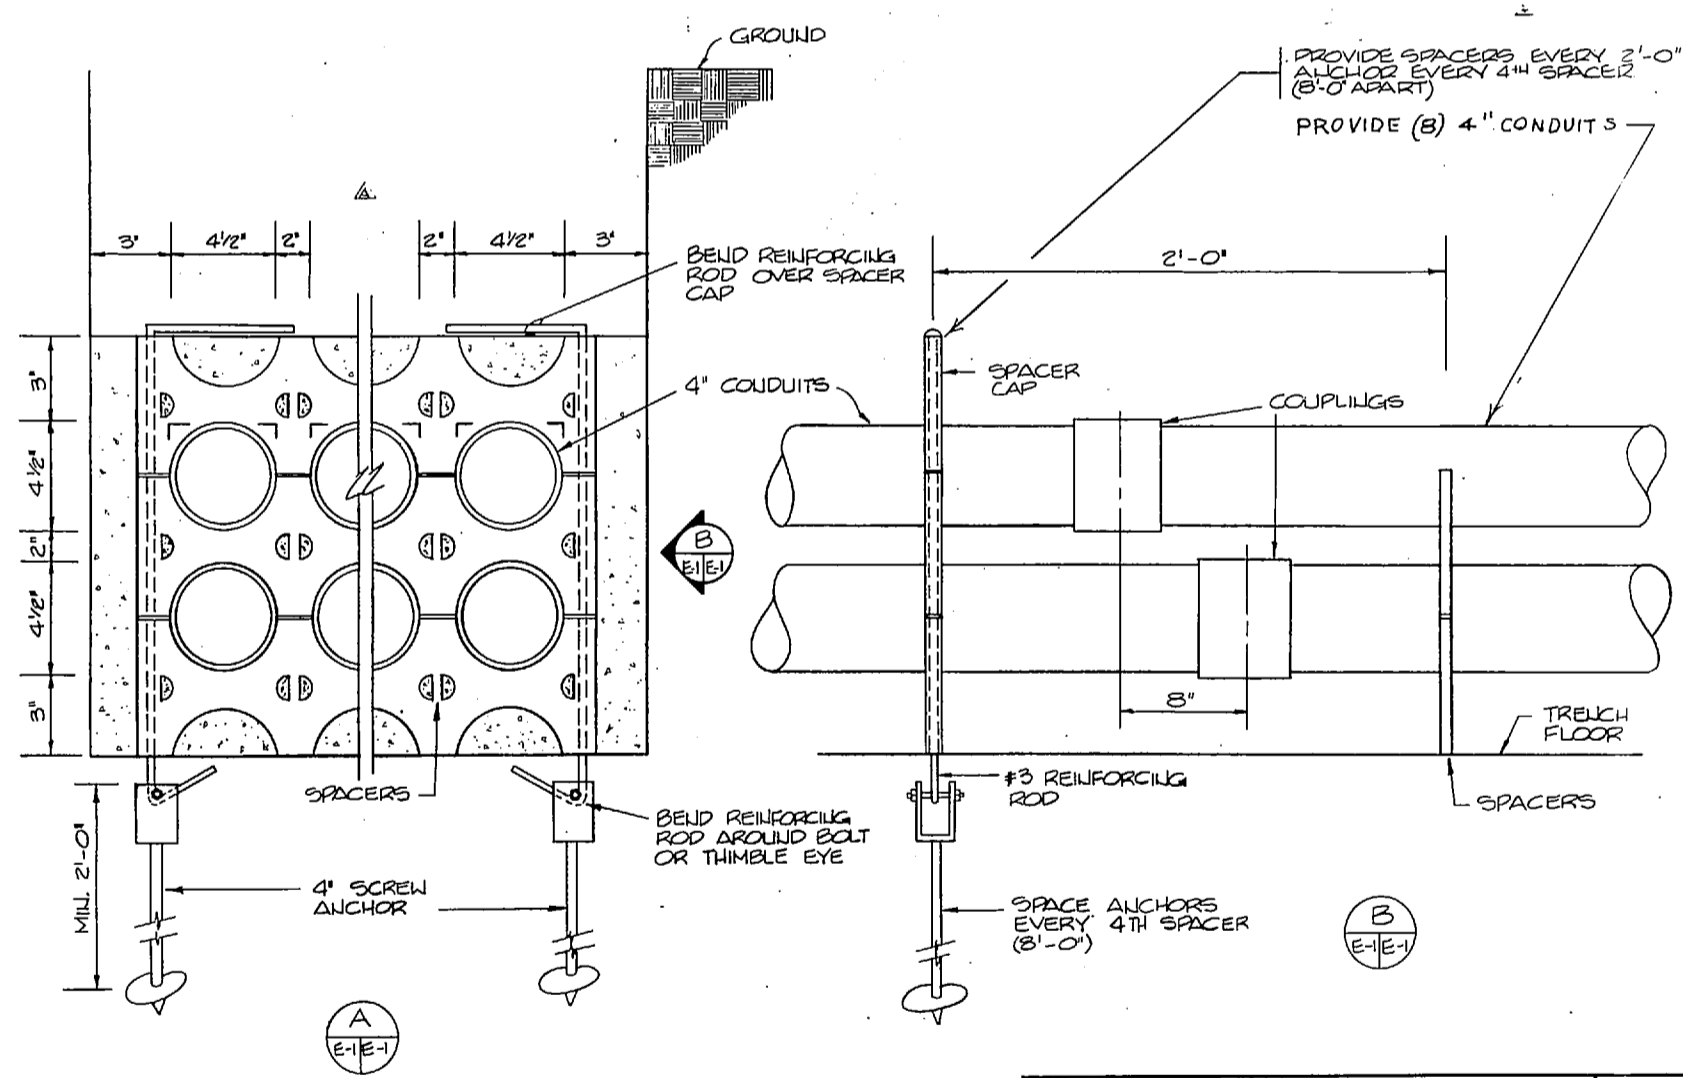

**SECTION - DUCTBANK SYSTEM (TYPICAL)**  
1" = 200'-0"


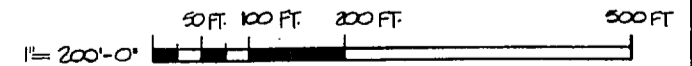


DEBLE & ASSOCIATES, P.A. PO BOX 1801 WASHINGTON, NC 27889		DEPARTMENT OF THE NAVY NAVAL FACILITIES ENGINEERING COMMAND <b>MARINE CORPS BASE</b> CAMP LEJEUNE, NORTH CAROLINA	
DES. 2/10/88	DR. REH. JH. IG. 2/10/88	LALCOMS PERMANIBLE MANAGEMENT MODULE (LPM) NEAS (4), NEW RIVER JACKSONVILLE, NORTH CAROLINA	
CHK. 2/10/88	DATE 7/2/88	DUCTBANK PLAN	
APPROVED: [Signature]	DATE 7/2/88	SIZE F	CODE IDENT. NO. 80091
DESIGN NO. 412644	DATE 7/2/88	NAVFAC DRAWING NO. 412644	
SATISFACTORY TO: [Signature]		CONTRACTOR: NO. 142710-05-B-0206	
SCALE: (AS SHOWN)		SPEC: 05-85-0306	

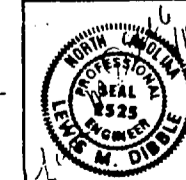





REVISIONS			
SYM.	DESCRIPTION	DATE	APPROVED
Δ	REVISED		

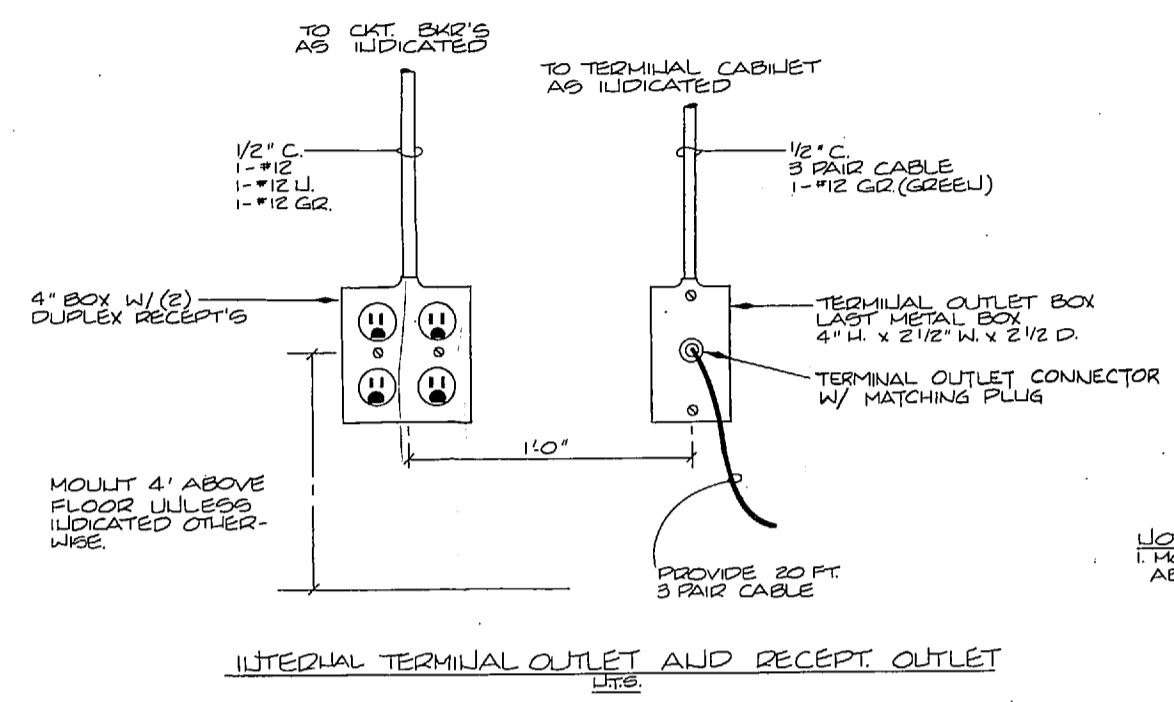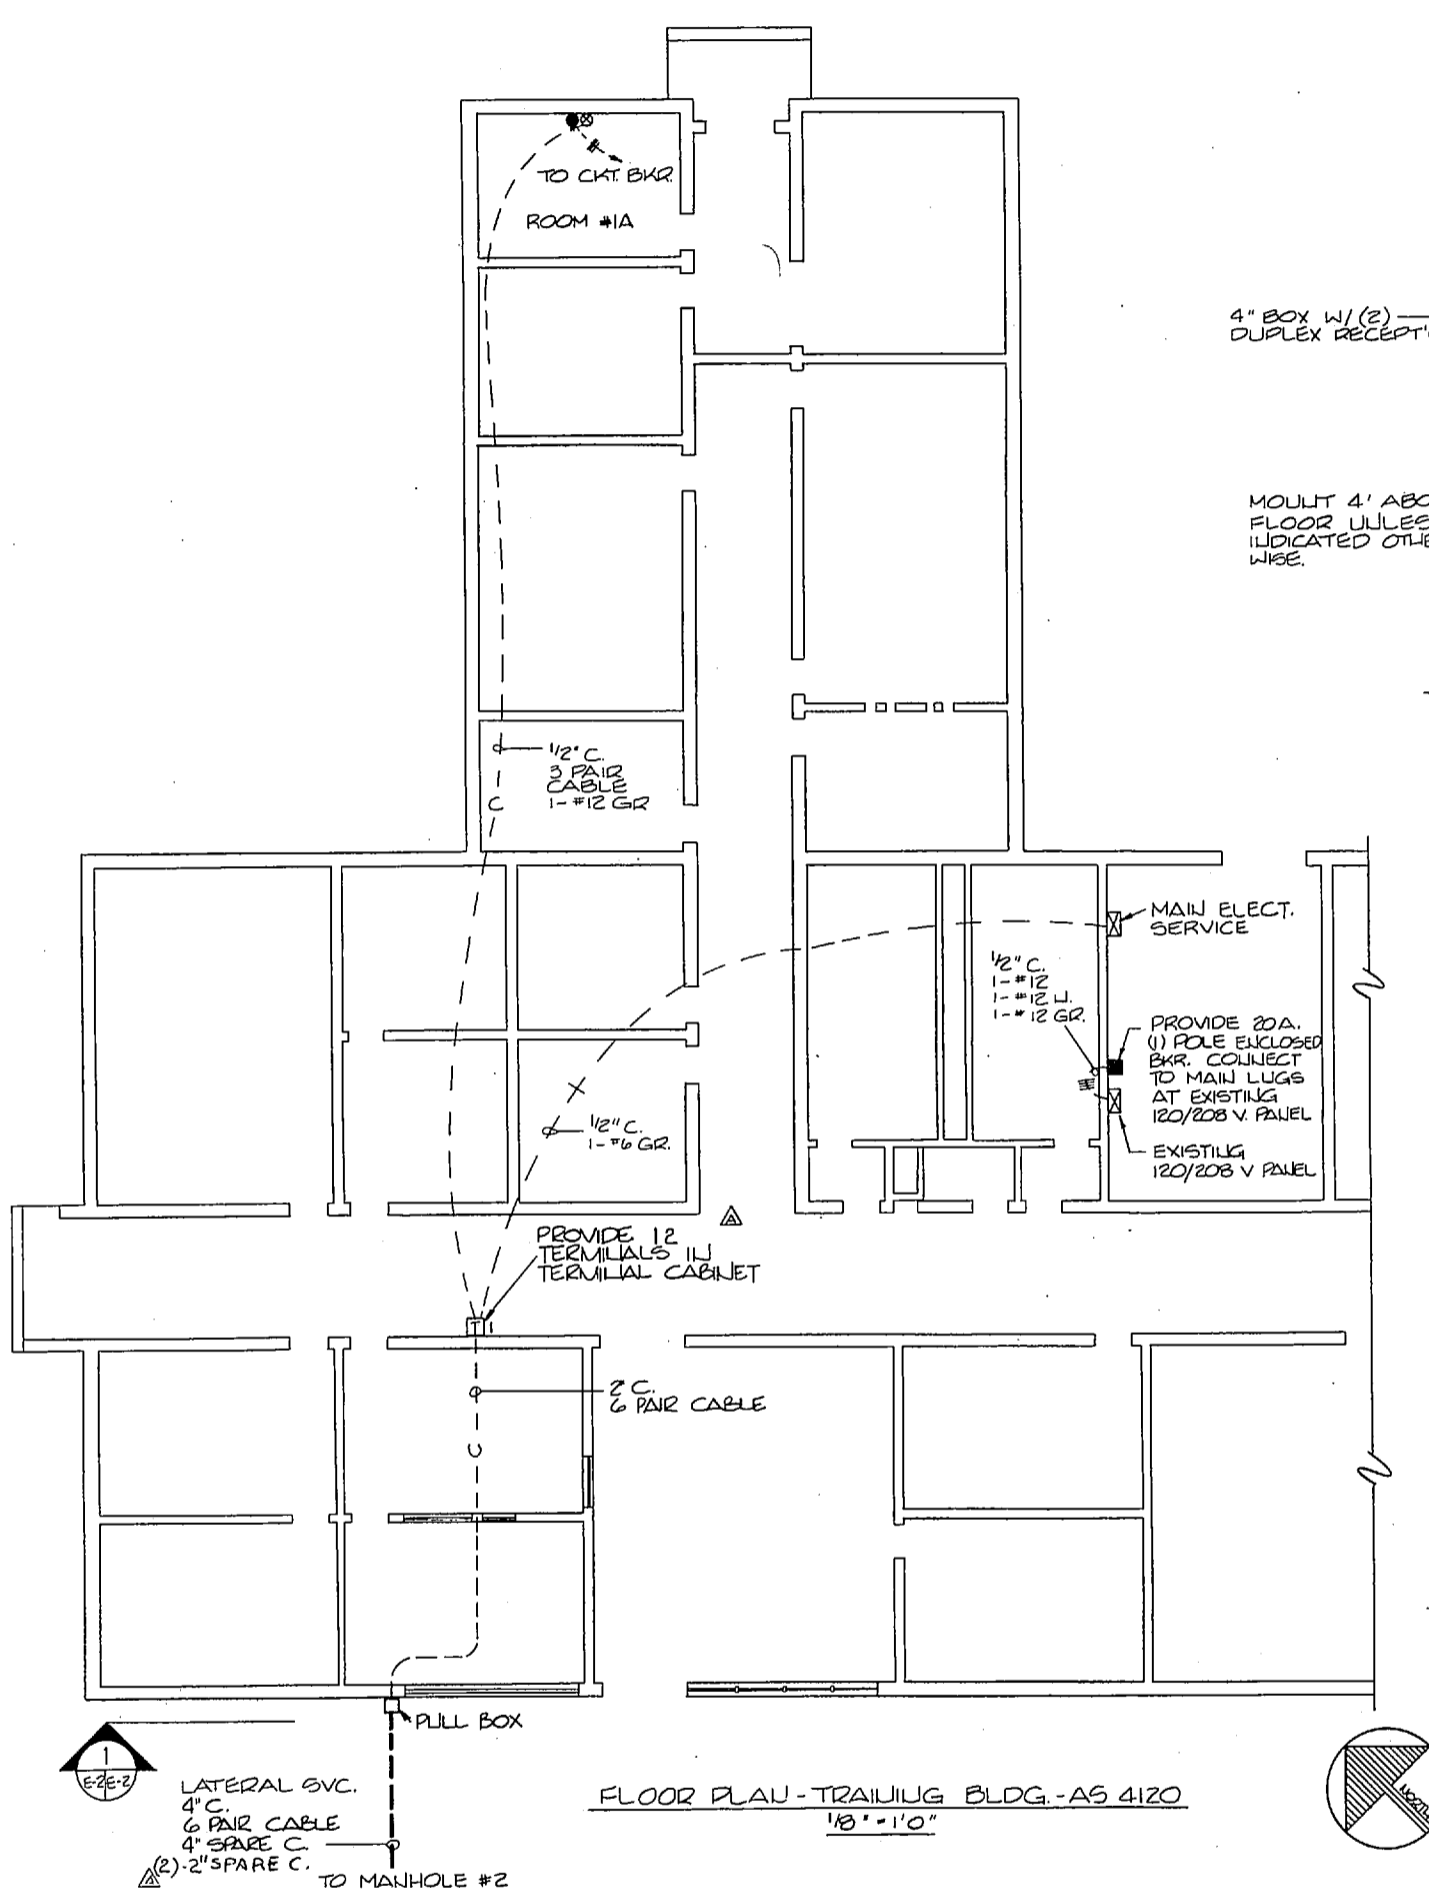


INTERNAL TERMINAL OUTLET AND RECEPT. OUTLET  
LTS

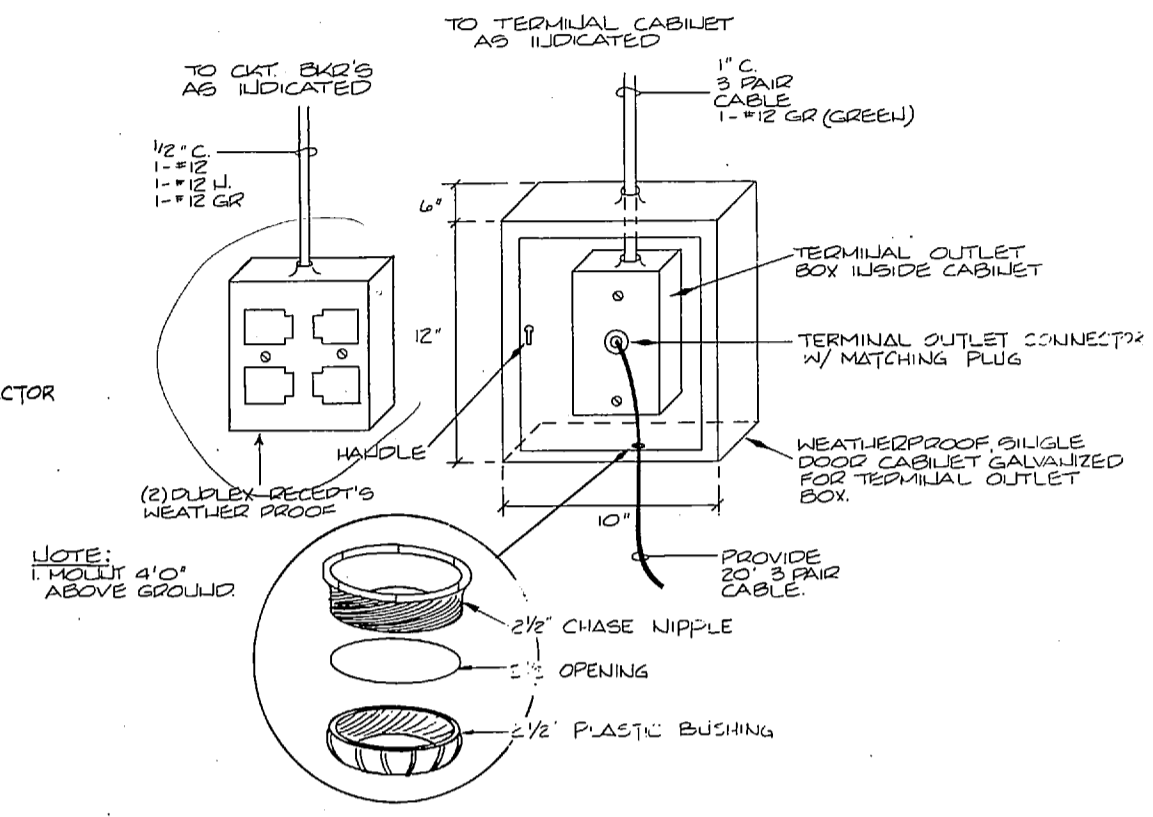


EXTERNAL TERMINAL OUTLET AND RECEPTACLE OUTLET  
N.T.S.

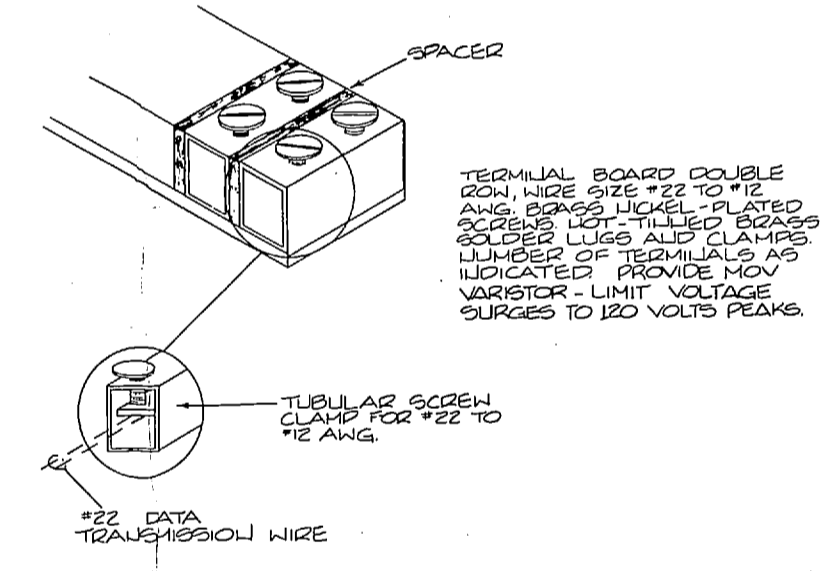


DETAIL - TERMINAL BOARD  
LTS

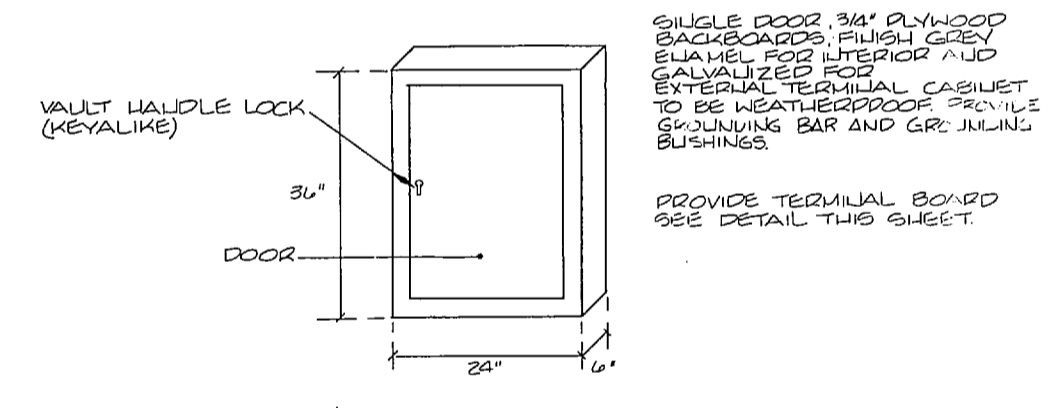


DETAIL - TERMINAL CABINETS (TYPICAL)  
LTS

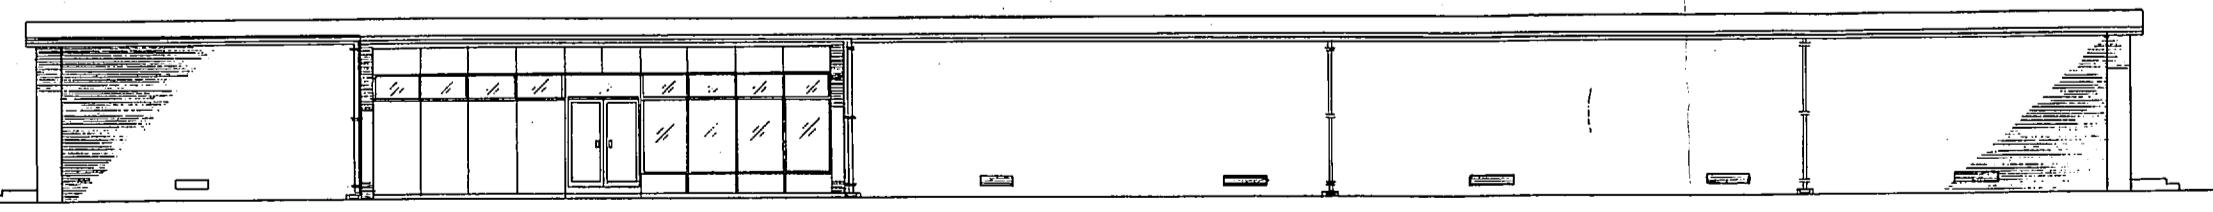

SOUTH ELEVATION-AS BLDG. 4120  
1/8\"/>

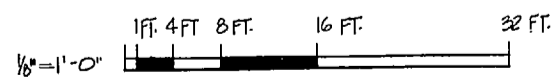


<b>I-E-2</b>	
DIEBLE & ASSOCIATES, P.A. P.O. BOX 1881 WASHINGTON, LLC 27889	
<b>MARINE CORPS BASE</b> CAMP LEJEUNE, NORTH CAROLINA	
DES. <i>[Signature]</i> / <i>[Signature]</i> DR. JH / TS CHK. <i>[Signature]</i> / <i>[Signature]</i>	
SUBMITTED BY: <i>[Signature]</i> DESIGN DIR. <i>[Signature]</i>	
APPROVED: PWD OR GWT / DATE <i>[Signature]</i> / <i>[Signature]</i>	
SATISFACTION: <i>[Signature]</i> / <i>[Signature]</i>	
DEPARTMENT OF THE NAVY NAVAL FACILITIES ENGINEERING COMMAND CAMP LEJEUNE, NORTH CAROLINA	
<b>MARINE CORPS BASE</b> CAMP LEJEUNE, NORTH CAROLINA	
LALCOMB PERFORMABLES MANAGEMENT MODULE (LPM) MCAS (H) LEWIS RIVER JACKSONVILLE, NORTH CAROLINA	
DETAILS & BUILDING AS-4120	
SIZE: <b>F</b>	CODE IDENT. NO.: 80091
NAVFAC DRAWING NO.: 4120645	CONSTR. CONTR. NO. 1162470-05-0-6384
SCALE: GRAPHIC SPEC. 05-05-6386 1 SHEET 3 OF 14	

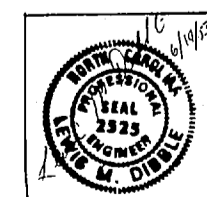





REVISIONS			
SYM.	DESCRIPTION	DATE	APPROVED
△	REVISED	AY	7/24/68

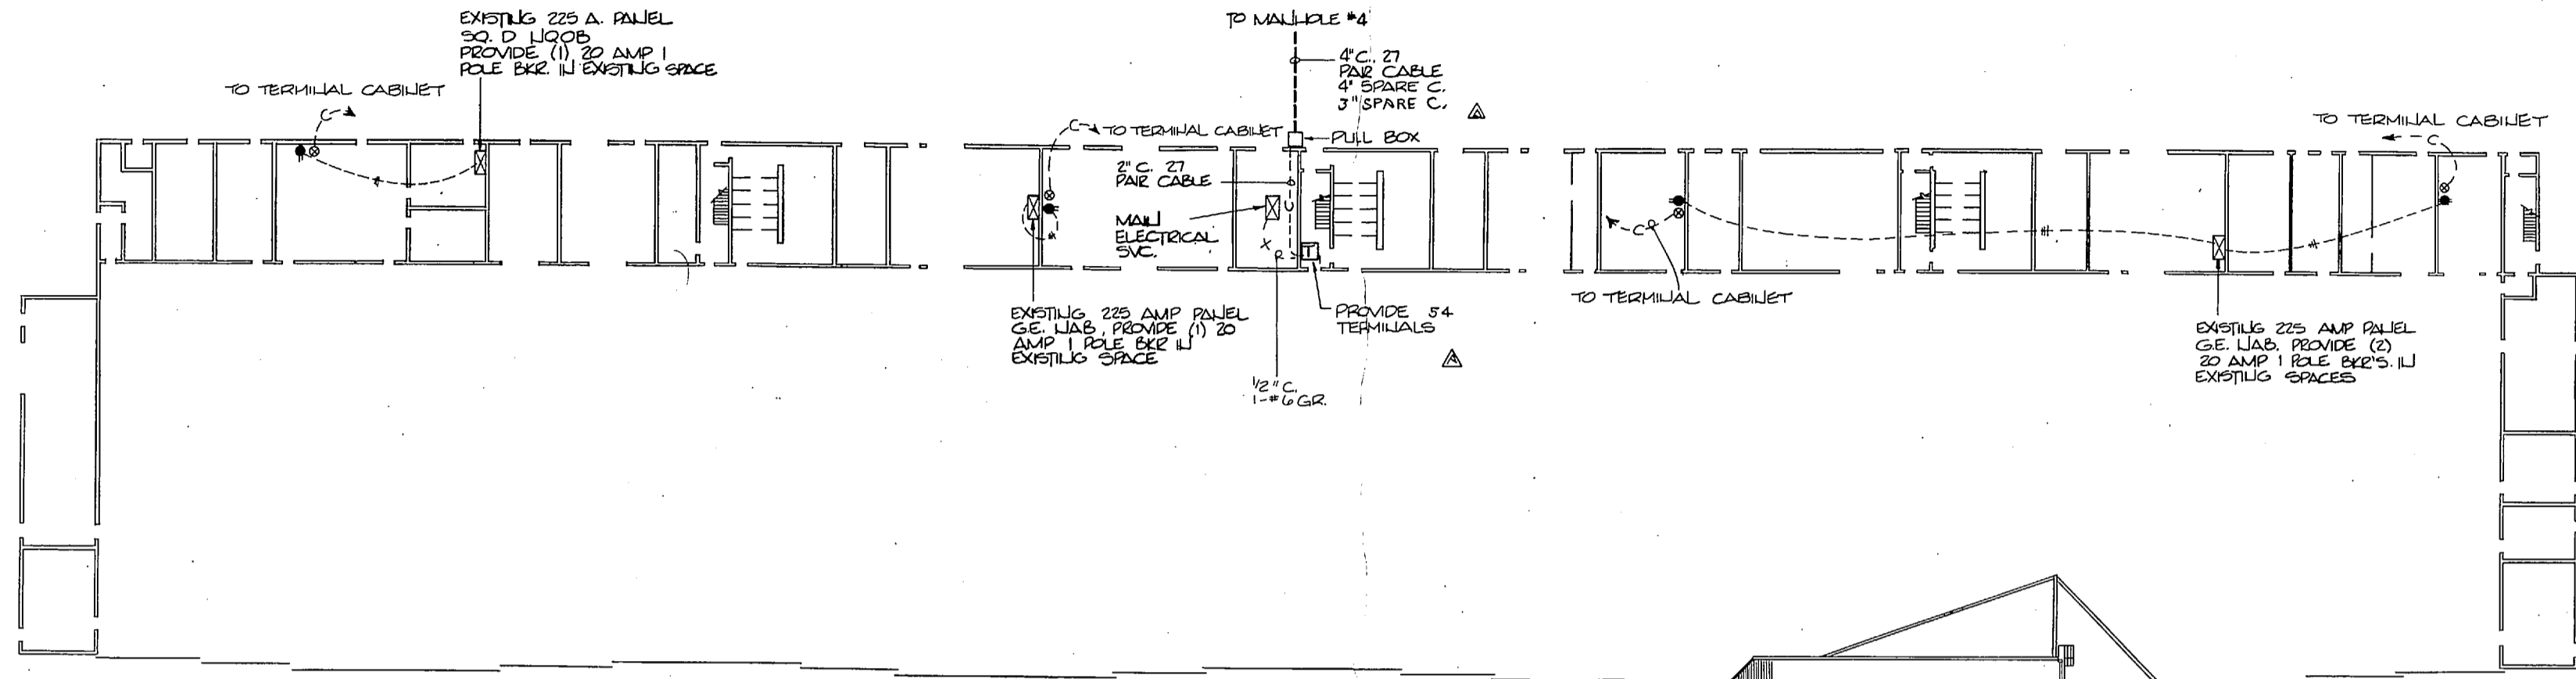

FLOOR PLAN - HANGAR AS 410B  
1" = 20'-0"

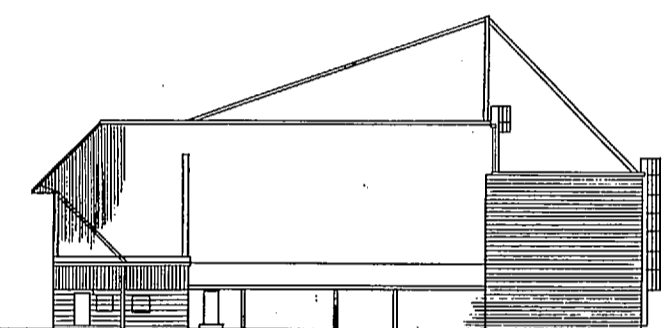

2 EAST ELEVATION - AS HANGAR 410B  
1" = 20'-0"


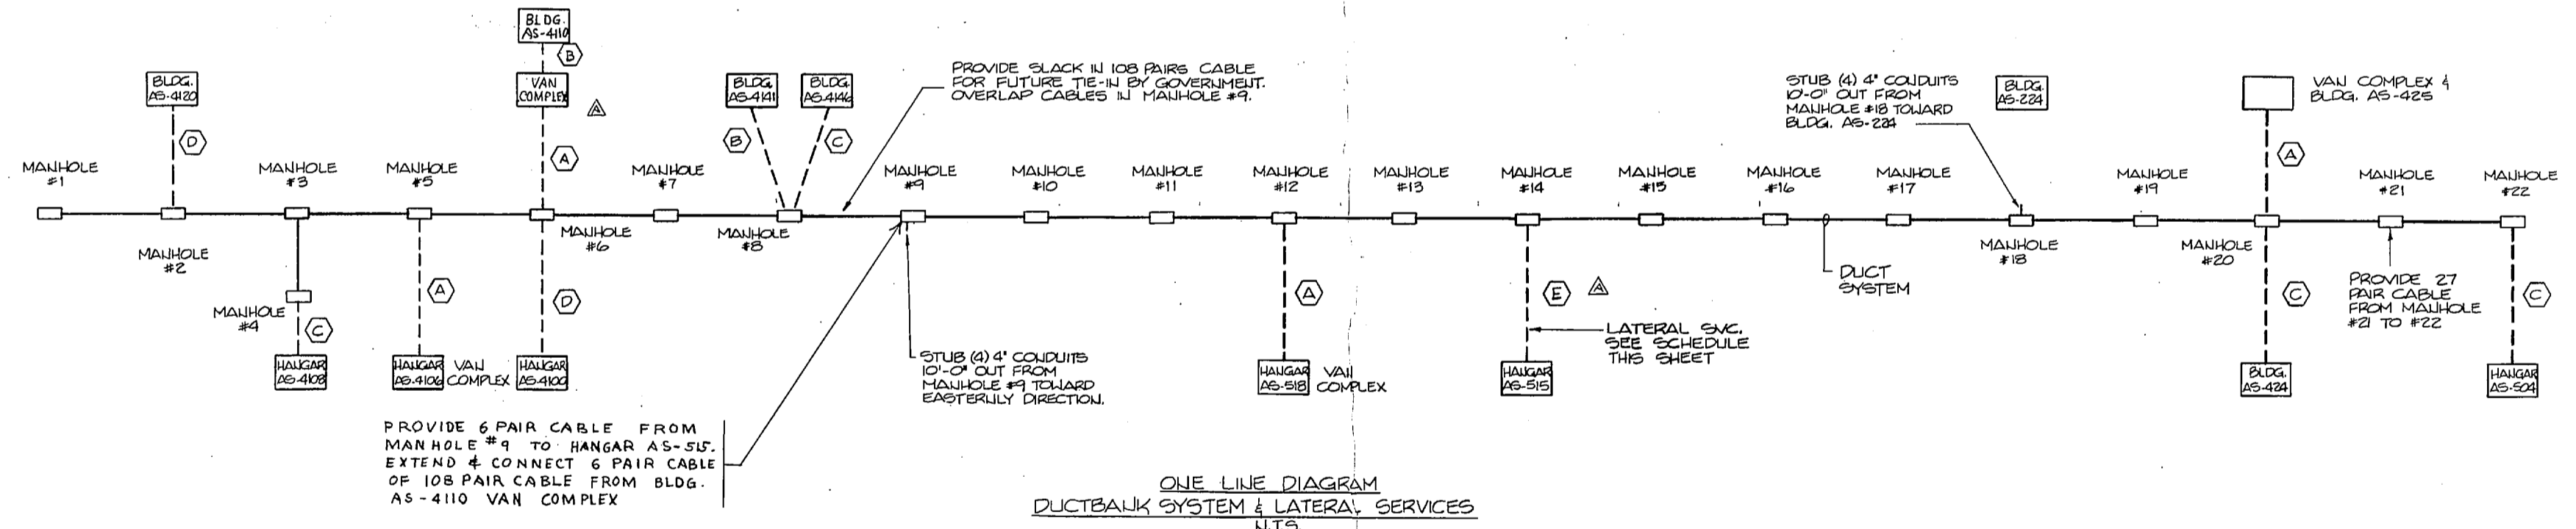


ONE LINE DIAGRAM  
DUCTBANK SYSTEM & LATERAL SERVICES  
LTS.

- △ LATERAL SERVICE SCHEDULE
- (A) 4" C. 108 PAIR CABLE  
4" C. #2 - 2" C. SPARES
  - (B) 4" C. 54 PAIR CABLE  
4" C. #3 - 2" C. SPARES
  - (C) 4" C. 27 PAIR CABLE  
4" C. #2 - 2" C. SPARES
  - (D) 4" C. 6 PAIR CABLE  
4" C. #2 - 2" C. SPARES
  - (E) 4" C. 27 PAIR CABLE  
4" C. 6 PAIR CABLE  
4" C. #2 - 2" C. SPARES

NOTE:  
PROVIDE DUCTBANK SYSTEM FROM  
MANHOLE #1 TO #22 (B) - 4"  
CONDUIT ENCASED IN CONCRETE.  
SEE SHEET E-1 OF 4 FOR DETAIL.

△  
PROVIDE 108 PAIRS CABLE FROM  
MANHOLE #1 TO #9.  
PROVIDE 108 PAIRS CABLE FROM  
MANHOLE #9 TO #22.

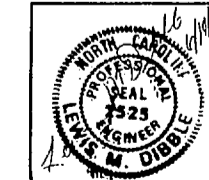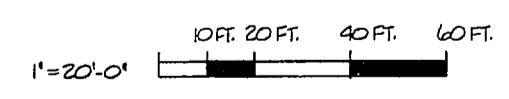








DEBLE & ASSOCIATES, P.A. P.O. BOX 1861 WASINGTON, NC 27889		DEPARTMENT OF THE NAVY NAVAL FACILITIES ENGINEERING COMMAND	
DR. REH CHK. SUBMITTED BY DESIGN DIR. APPROVED: PWO OR PTC SATISFACTION TO		MARINE CORPS BASE CAMP LEONARD, NORTH CAROLINA HALCOMB DEPENDABLES MALLACEMENT MODULE (HBM) MCAF (L) NEW RIVER JACKSONVILLE, NORTH CAROLINA	
DATE: 7-25-68		HALGAR AS-410B	
SIZE: F		NAVFAC DRAWING NO. 410646	
CODE IDENT. NO. 80091		CONSTR. CONTR. NO. 1162470-85-B-6386	
SCALE: GRAPHIC SPEC. 05-85-6386		SHEET 4 OF 14	

E-3





REVISIONS			
SYM.	DESCRIPTION	DATE	APPROVED
Δ	REVISED	7-19-85	
Δ	REVISED	7-24-85	

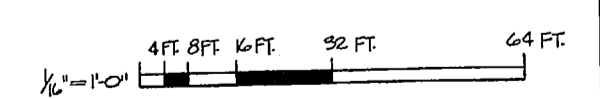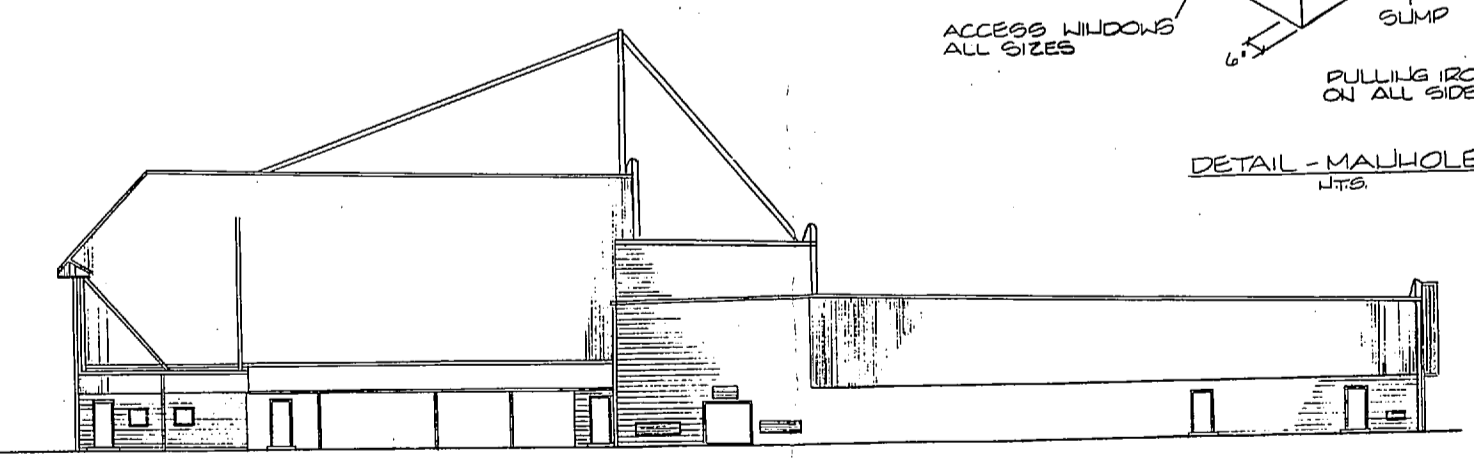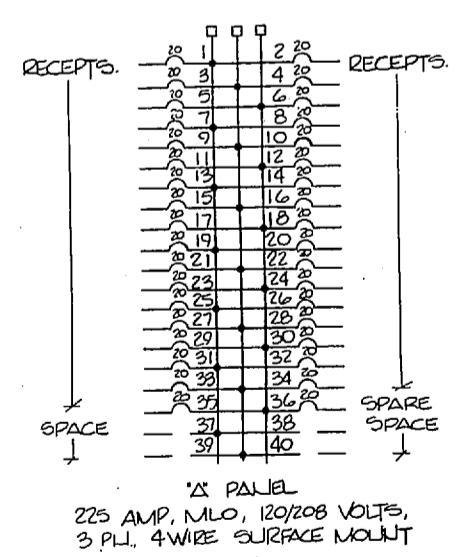
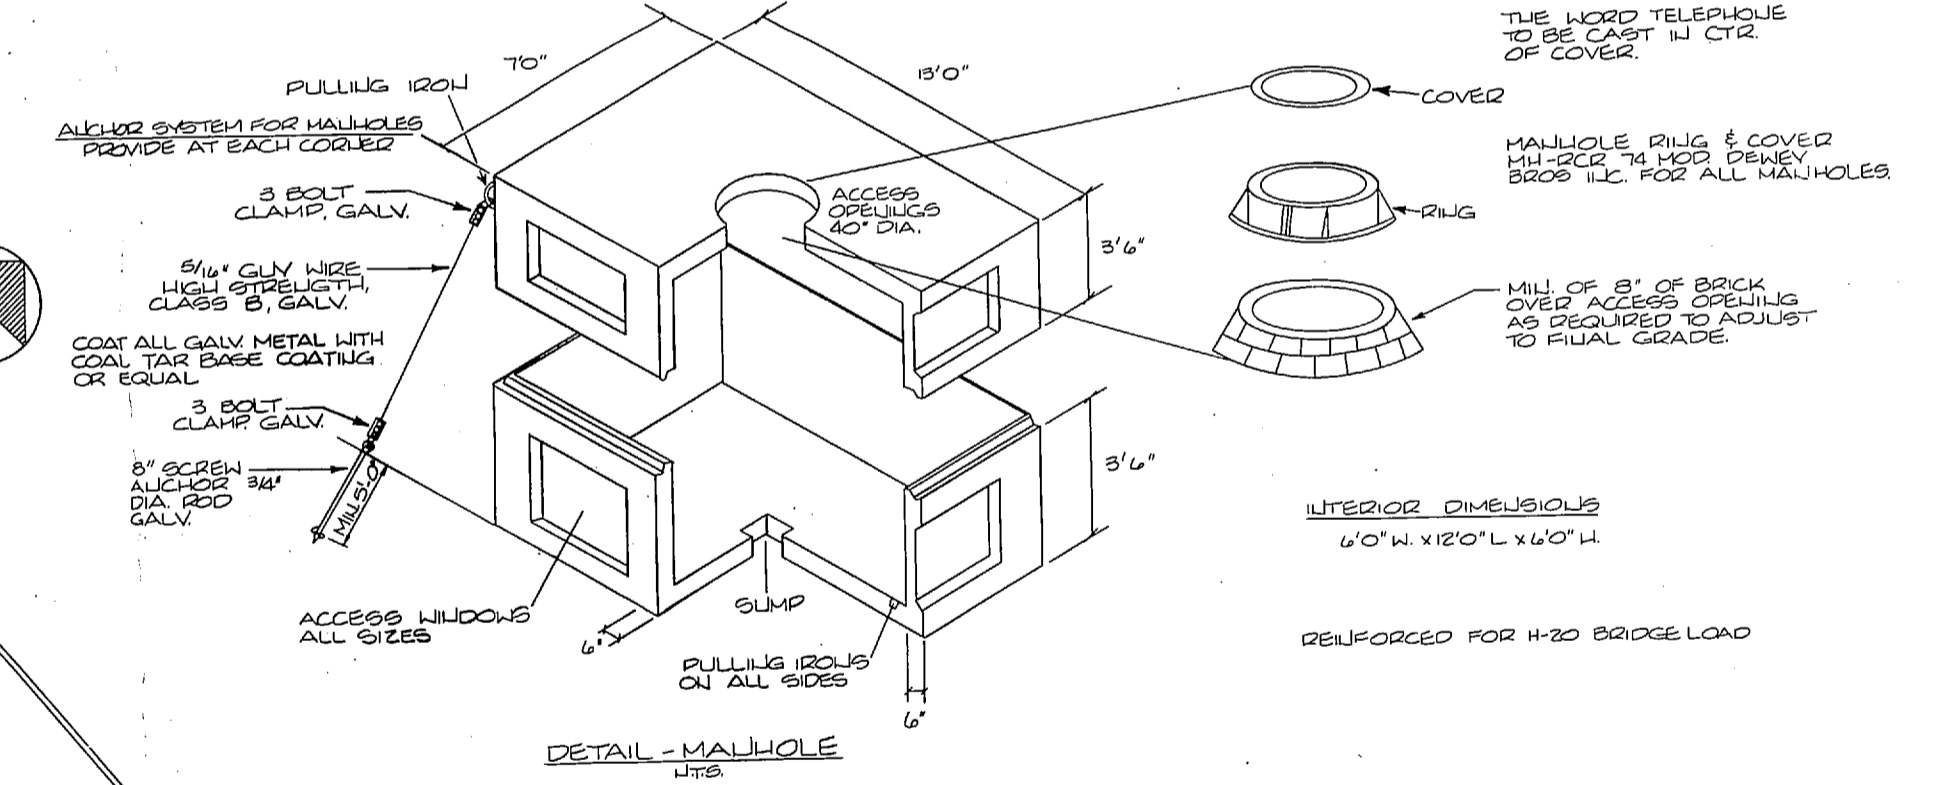
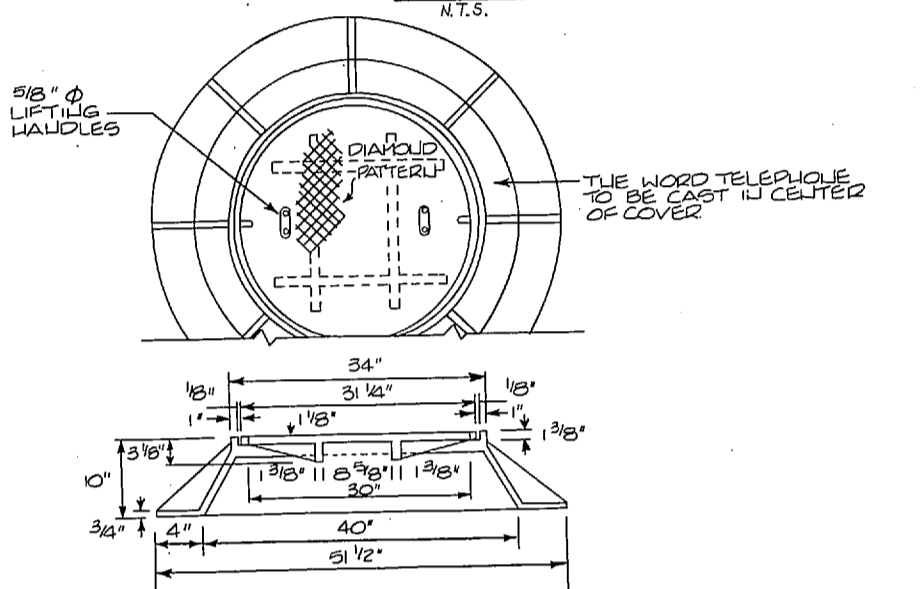
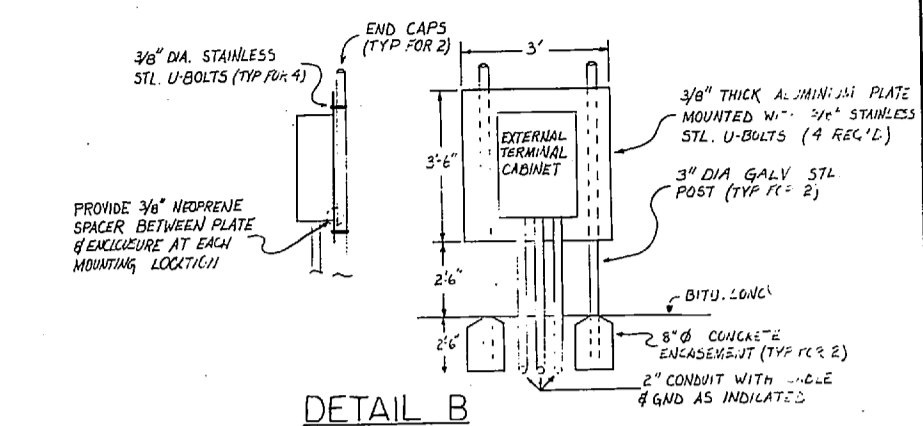
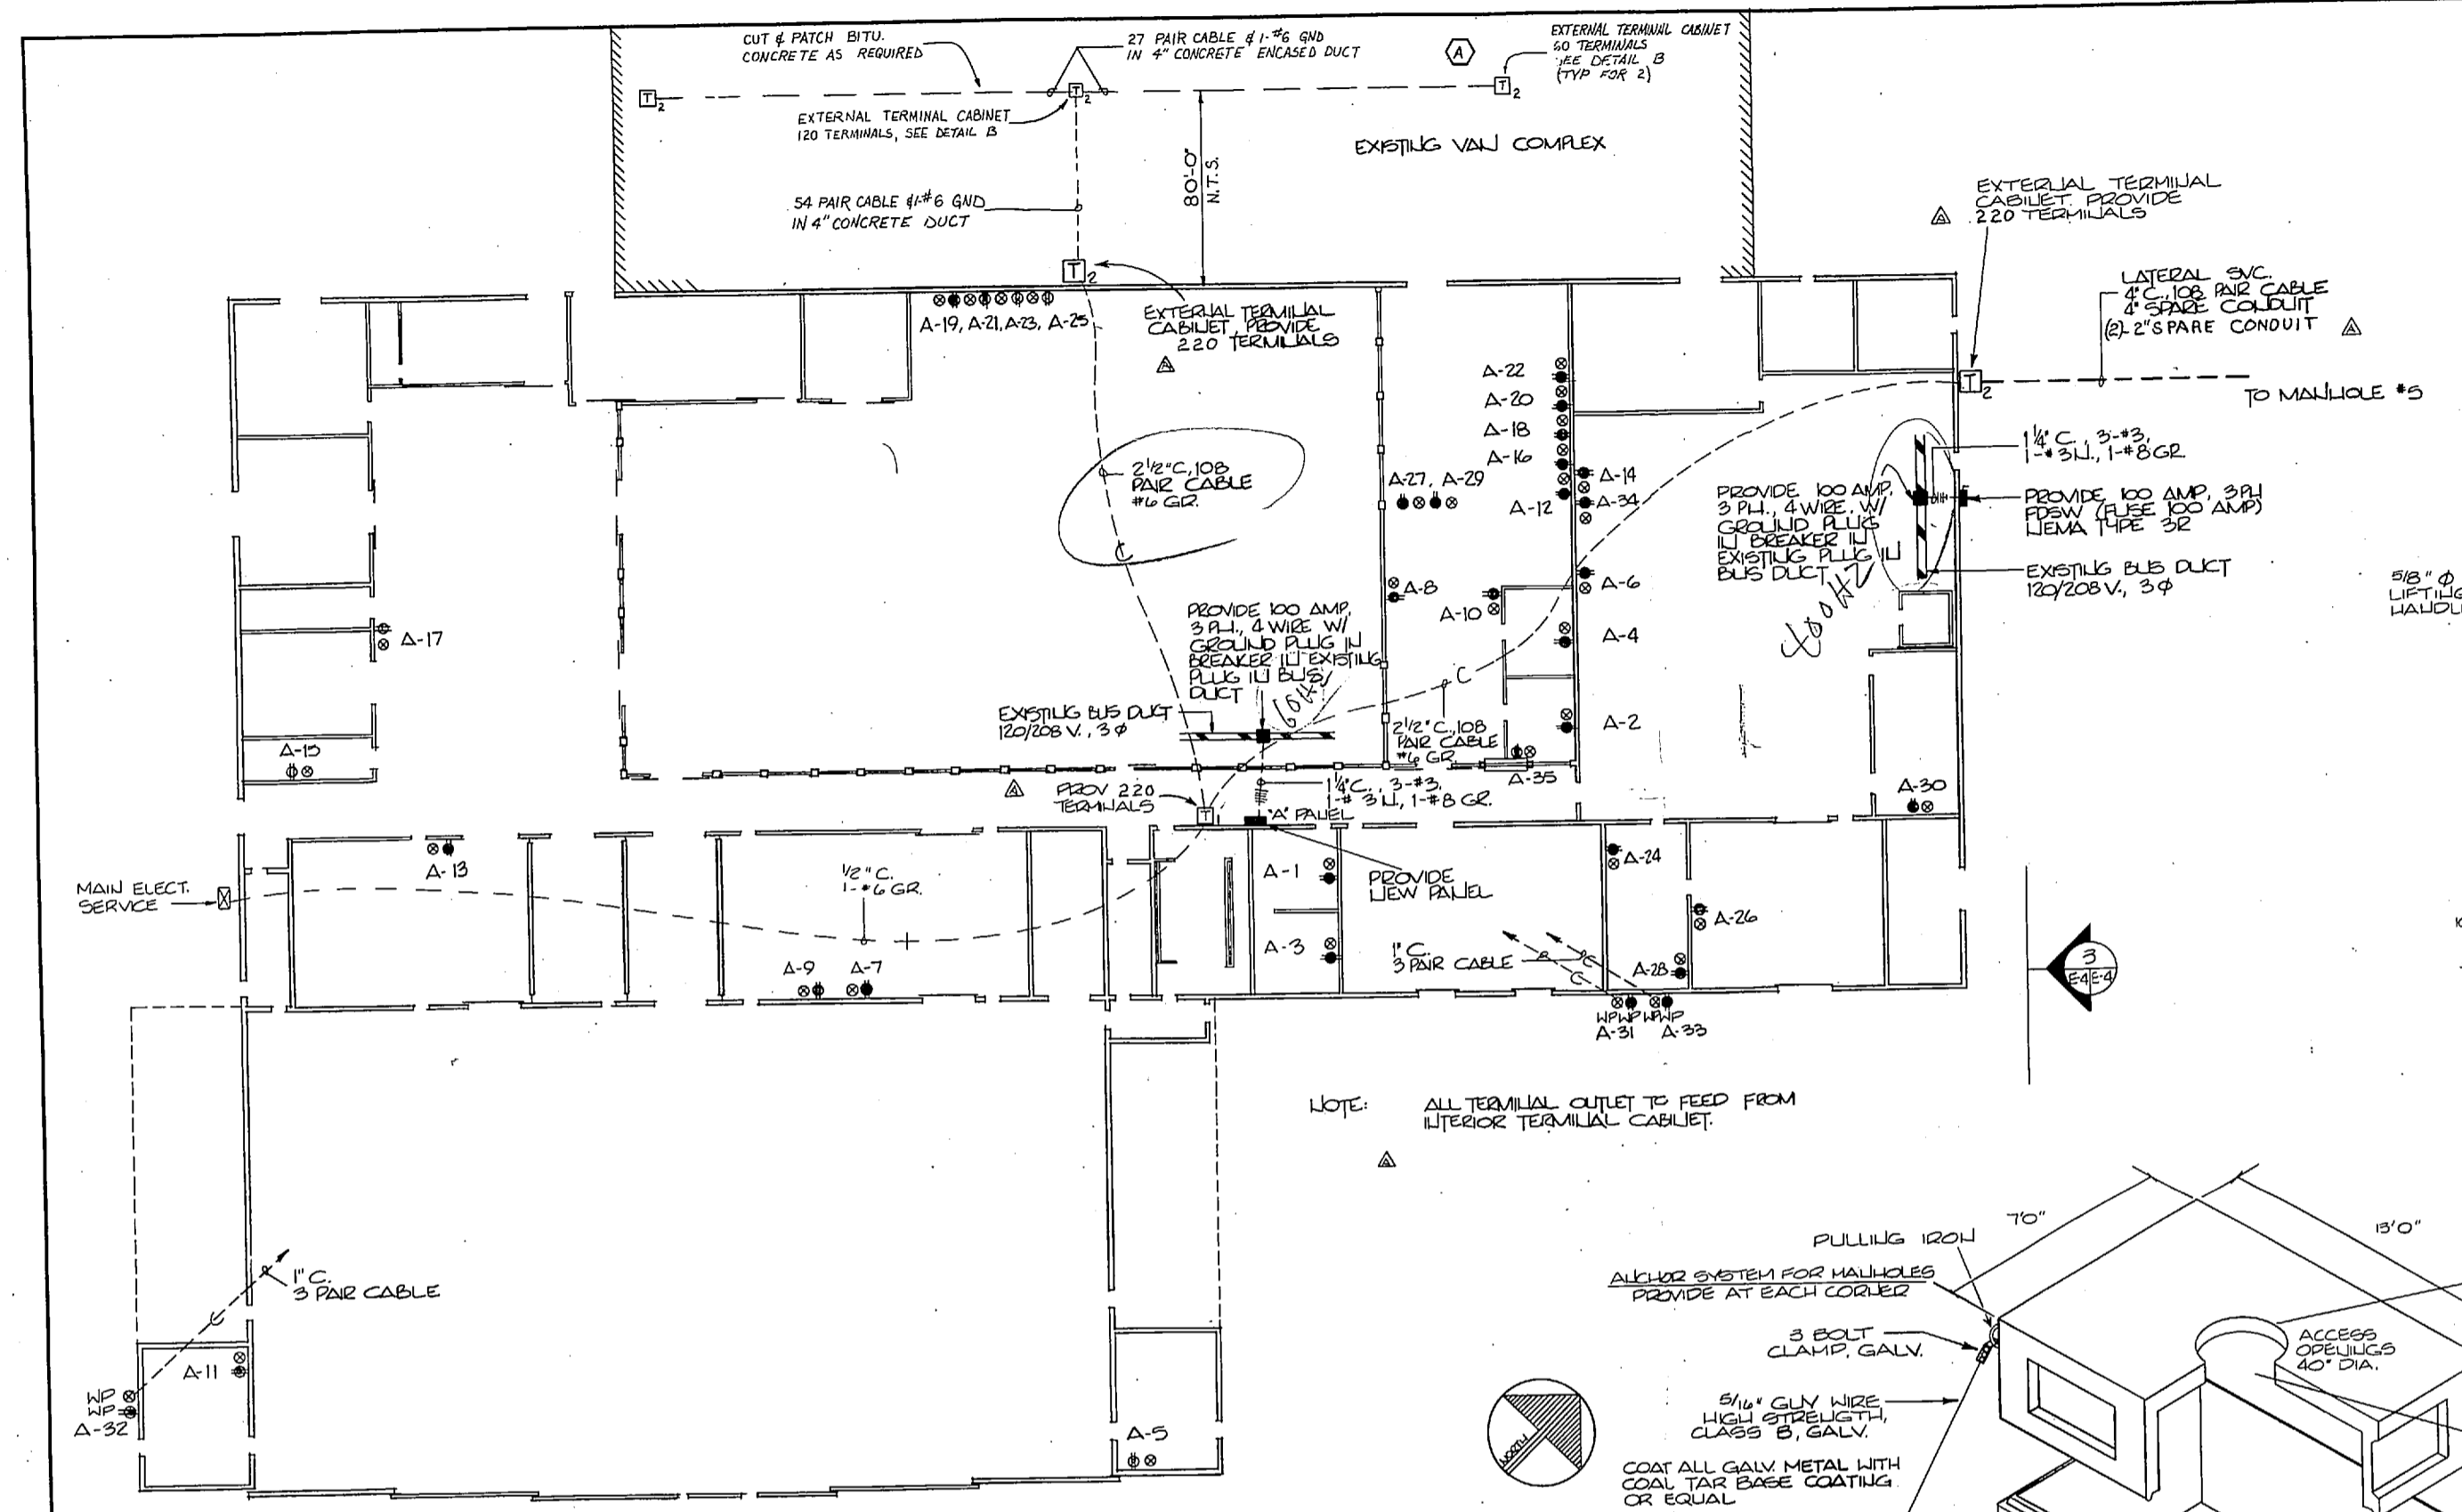



--	--	---	--





REVISIONS			
SYM.	DESCRIPTION	DATE	APPROVED
Δ	REVISED	7/7/85	

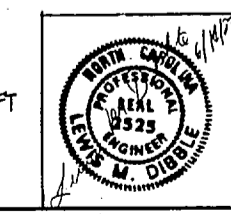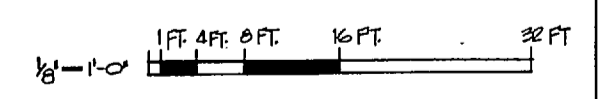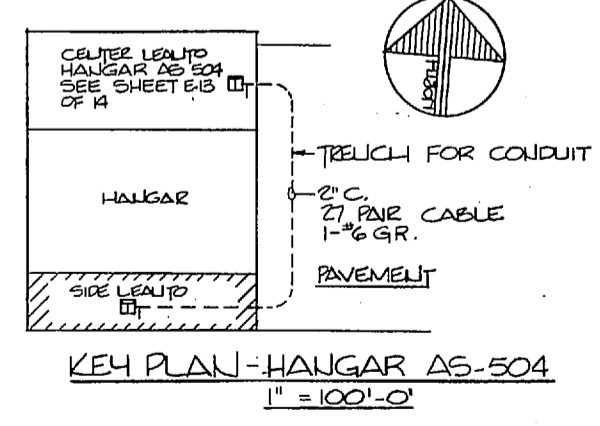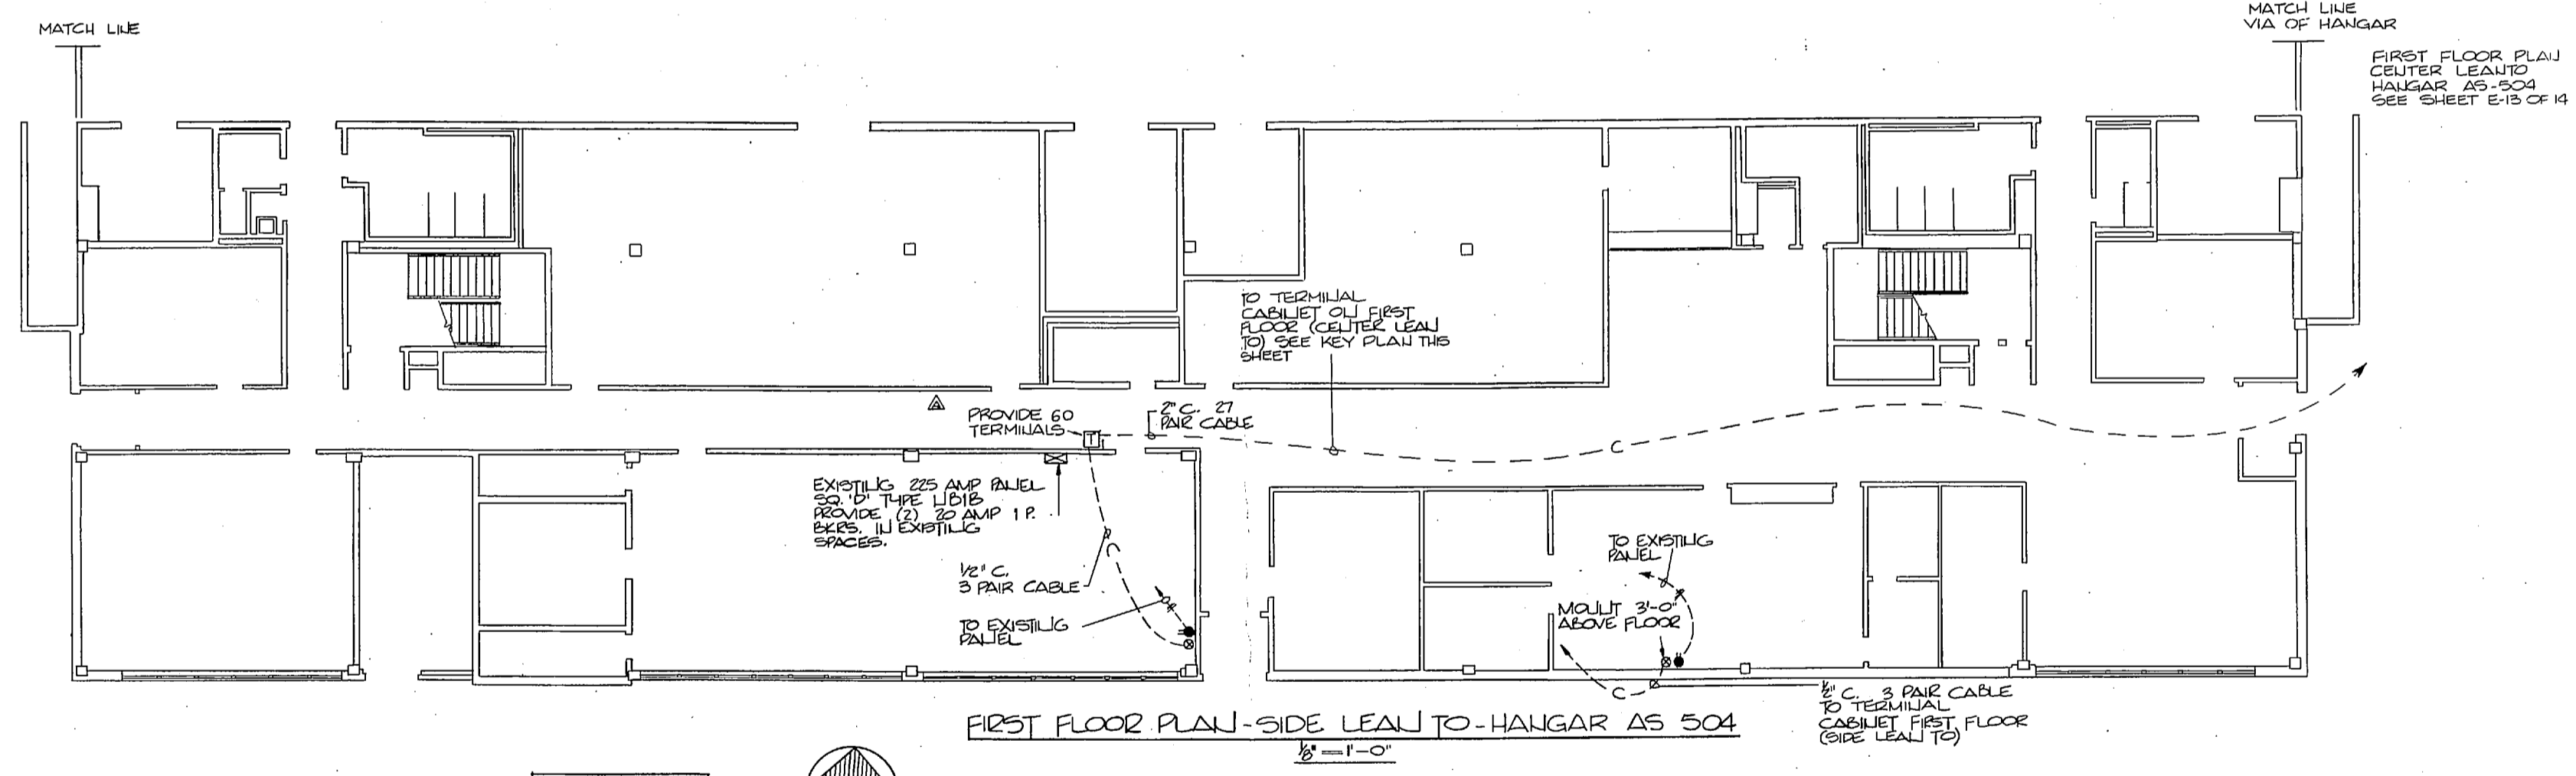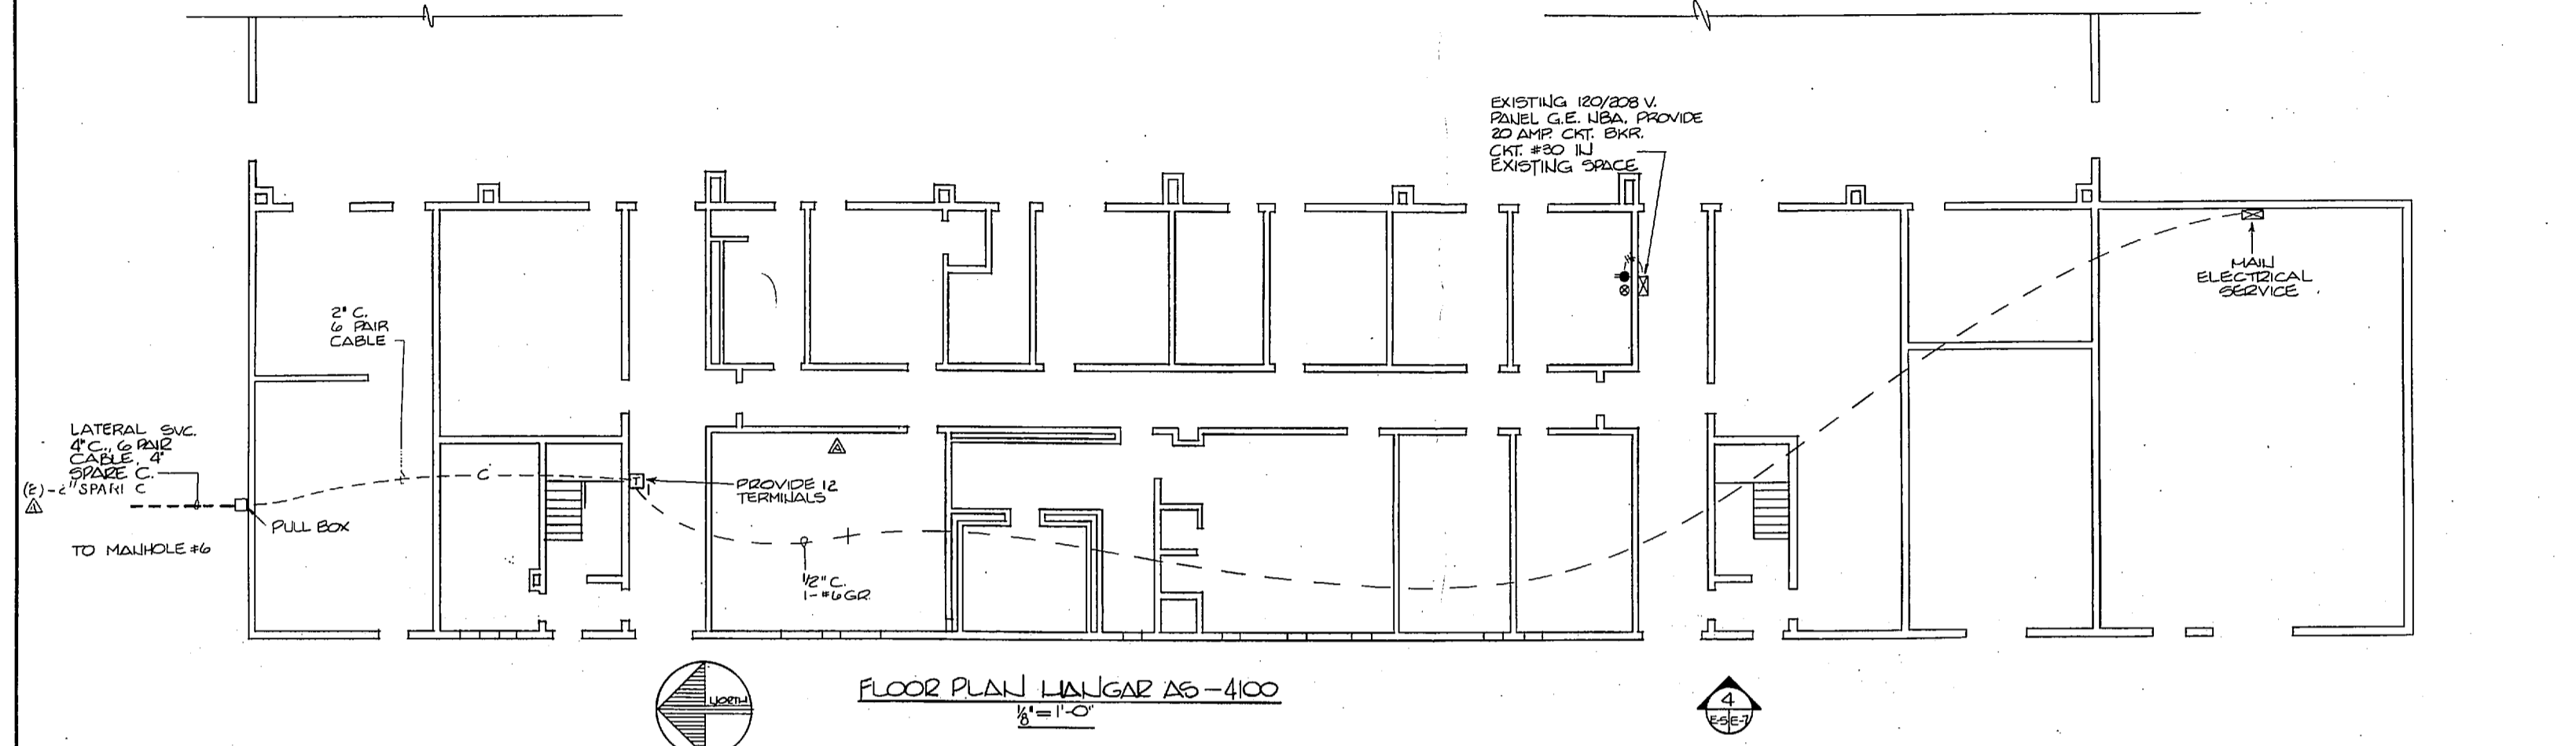

DIBBLE & ASSOCIATES, P.A. P.O. BOX 1881 WASHINGTON, N.C. 27889		DEPARTMENT OF THE NAVY NAVAL FACILITIES ENGINEERING COMMAND <b>MARINE CORPS BASE</b> CAMP LEJEUNE, NORTH CAROLINA	
DES. <i>[Signature]</i>	DATE 7/1/85	JALCOMB REPAIRABLES MANAGEMENT MODULE (JEMM) MCAS (H) NEW RIVER JACKSONVILLE, NORTH CAROLINA	
DR. <i>[Signature]</i>	DATE 7/1/85	HANGARS AS-4100 & AS-504	
CHK. <i>[Signature]</i>	DATE 7/1/85	SIZE <b>F</b>	CODE IDENT. NO. 80091
SUBMITTED BY: <i>[Signature]</i>		NAVAFD DRAWING NO. 41268-8	
DESIGN DIR: <i>[Signature]</i>		CONSTR. CONTR. NO. N62470-85-B-6384	
APPROVED: PWO OR OIC <i>[Signature]</i>		SCALE: GRAPHIC SPEC. 05-85-6384-1 SHEET 6 OF 14	
SATISFACTORY: <i>[Signature]</i>			



REVISIONS			
SYM.	DESCRIPTION	DATE	APPROVED
Δ	REVISED	7/24/85	

**POLE SCHEDULE**


**POLE #1**  
 PROVIDE - 40' C3 POLE  
 X-FB, 15 FRD - 11  
 X-FB, TTT (3-50 KVA  
 12.5 KV - 120/208 V.) CONDUIT  
 RISER (4" C.) 4-#600 MCM  
 UNDERGROUND SVC. GROUND

**POLE #2**  
 REM. (2) QUADRIplex SVCS.





**POLE #3**  
 REM. 35 C5 POLE  
 (2) SVC. HEADS  
 (2) 2" CONDUIT W/WIRE ± 20'-0" EA.  
 (2) 200 AMP 3P FDSW  
 GUY & ANCHOR

RECEPTS	2	3	4	6	8	10	12	14	16	17	18	19	21	22	23	24
RECEPTS	2	3	4	6	8	10	12	14	16	17	18	19	21	22	23	24


'A' PANEL  
 120/208 V. MLO 3 PHASE  
 4 WIRE, SURFACE MOUNT

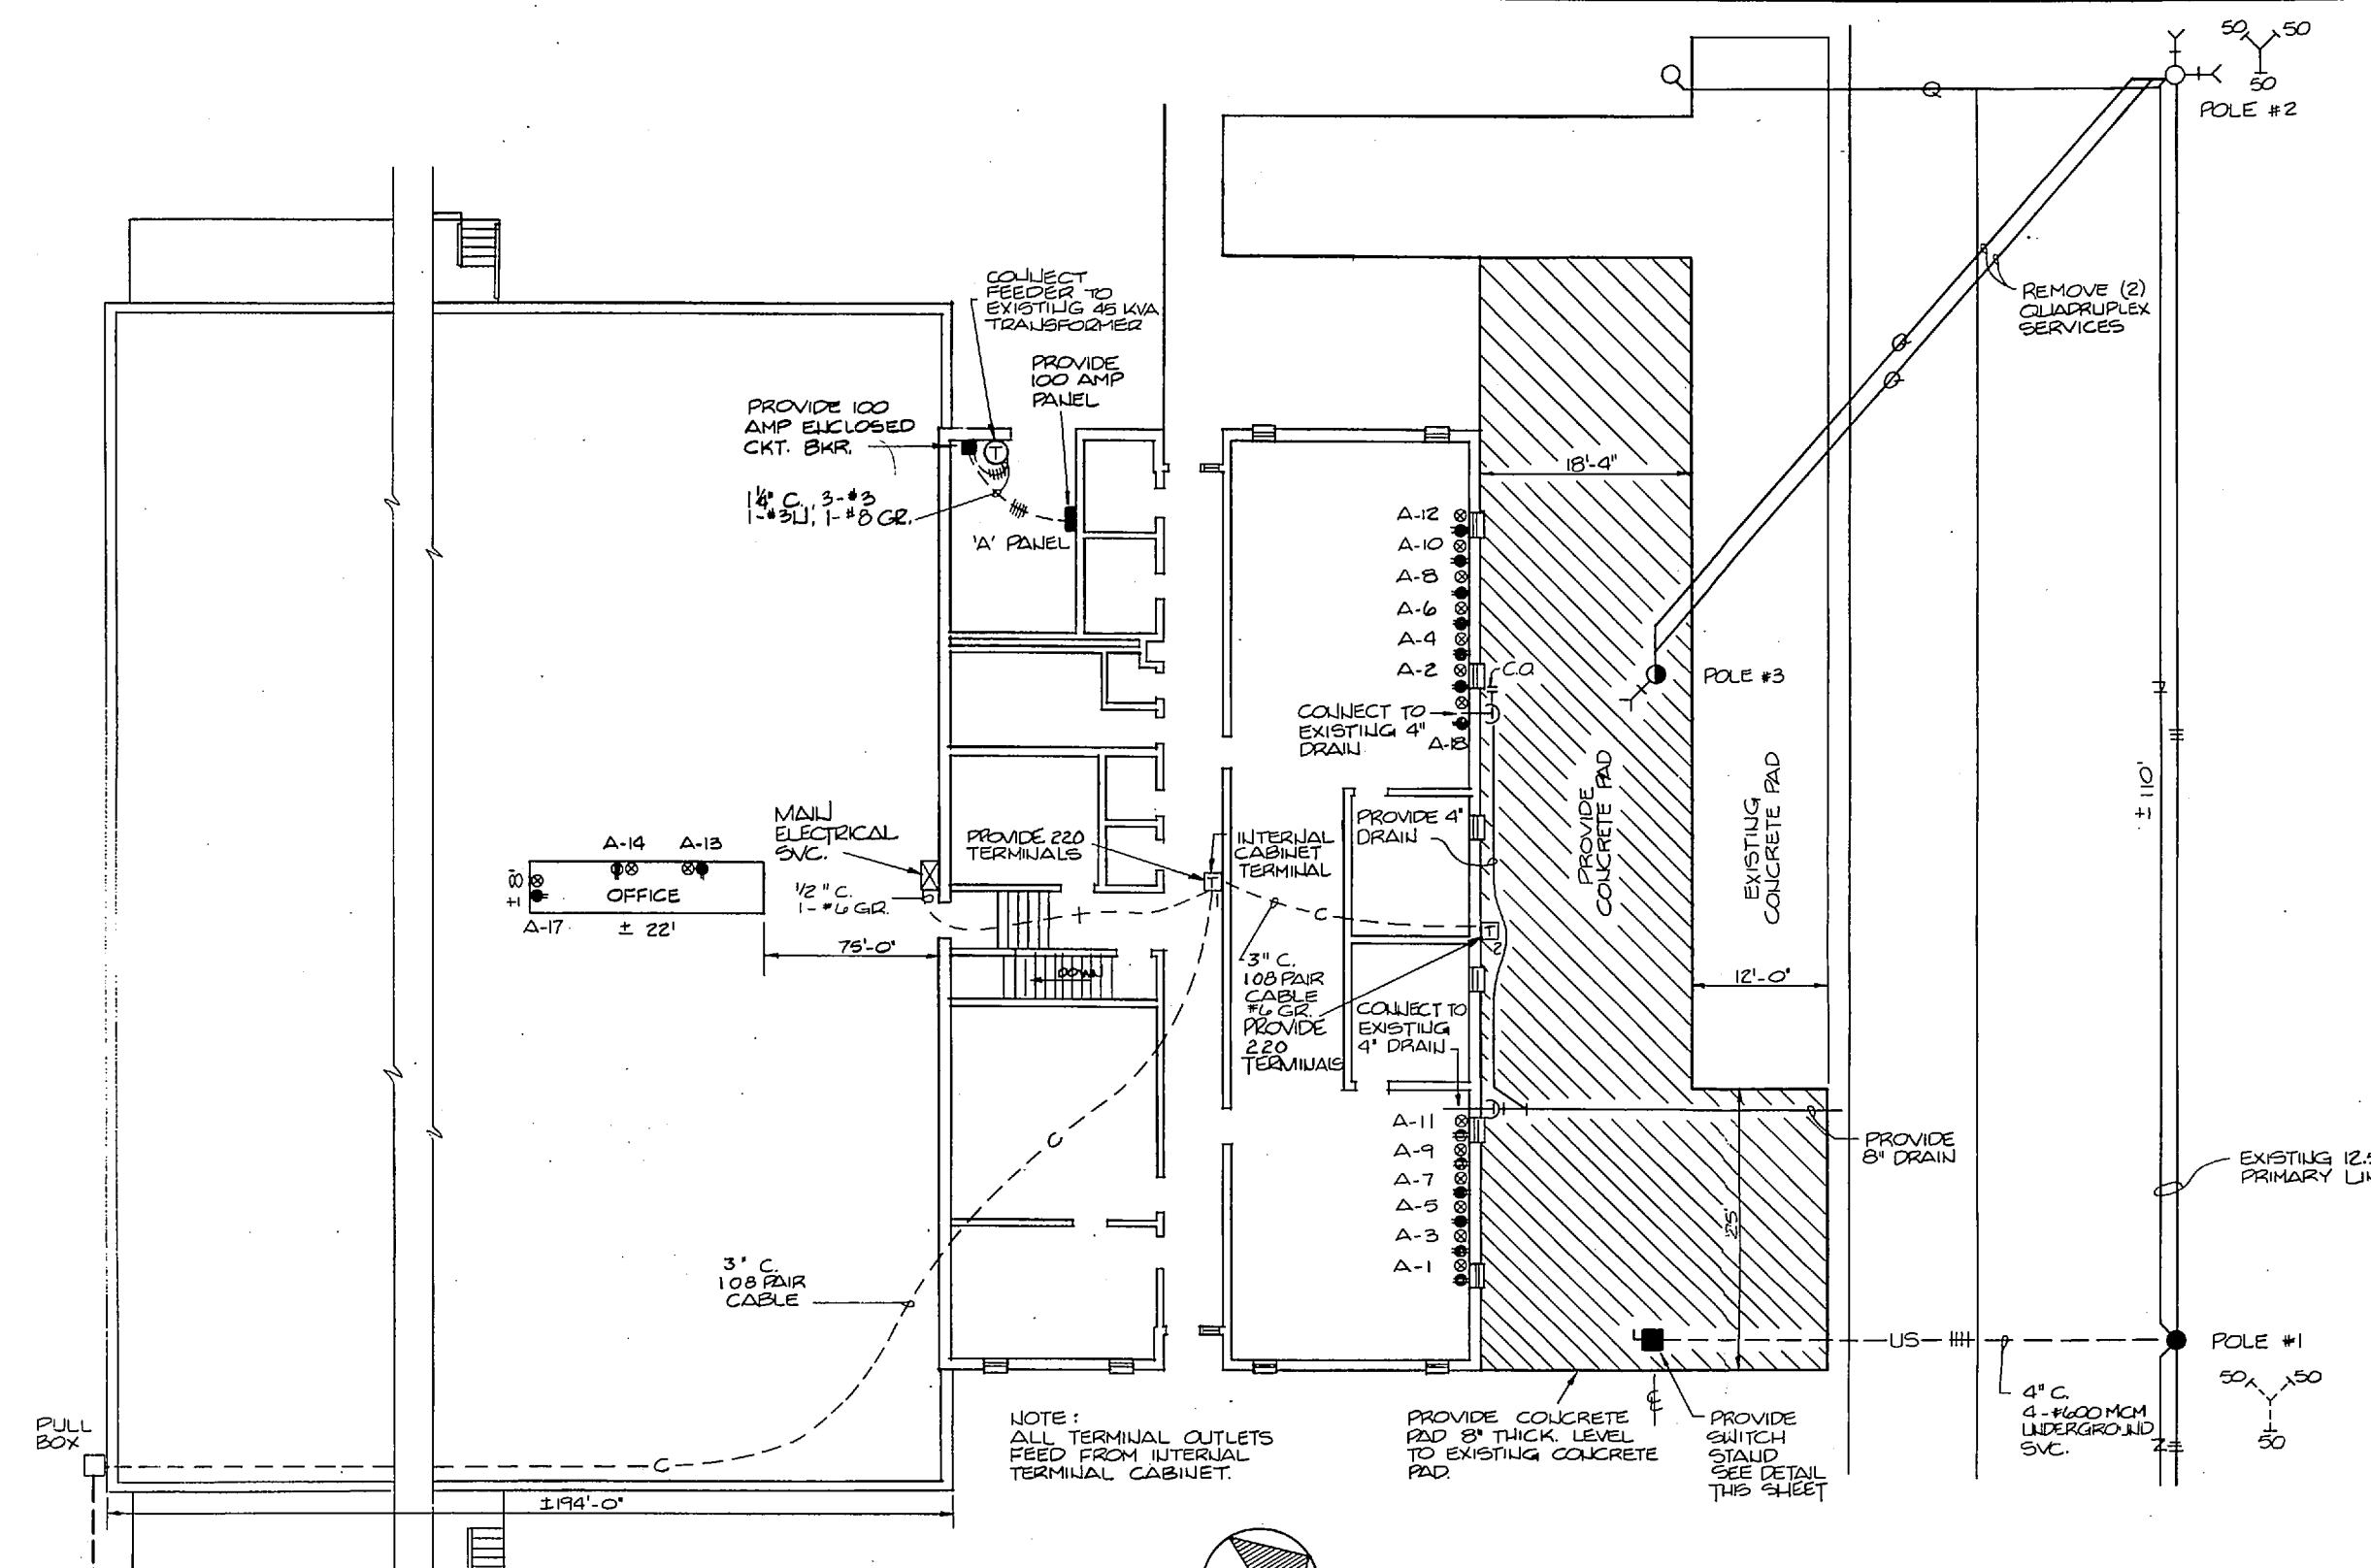

**FLOOR PLAN & OVERHEAD POWER - BLDG. AS 4110**  
 1/8" = 1'-0"

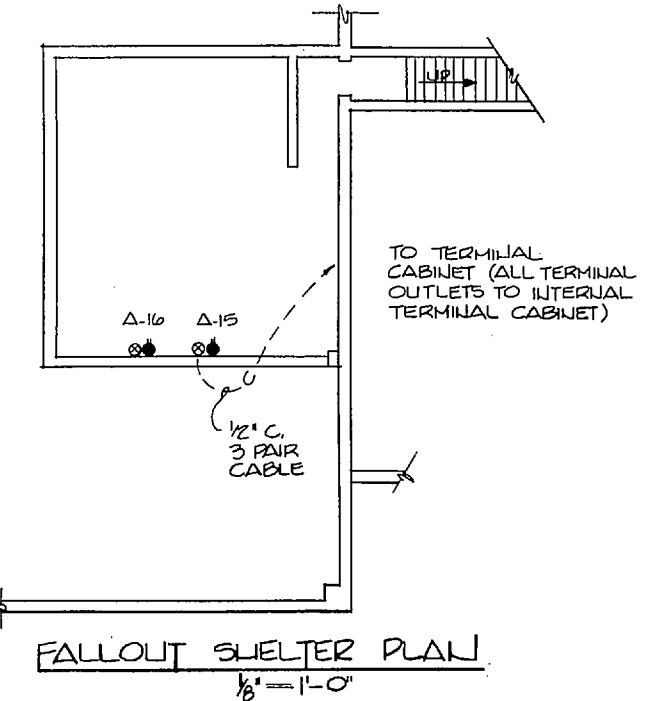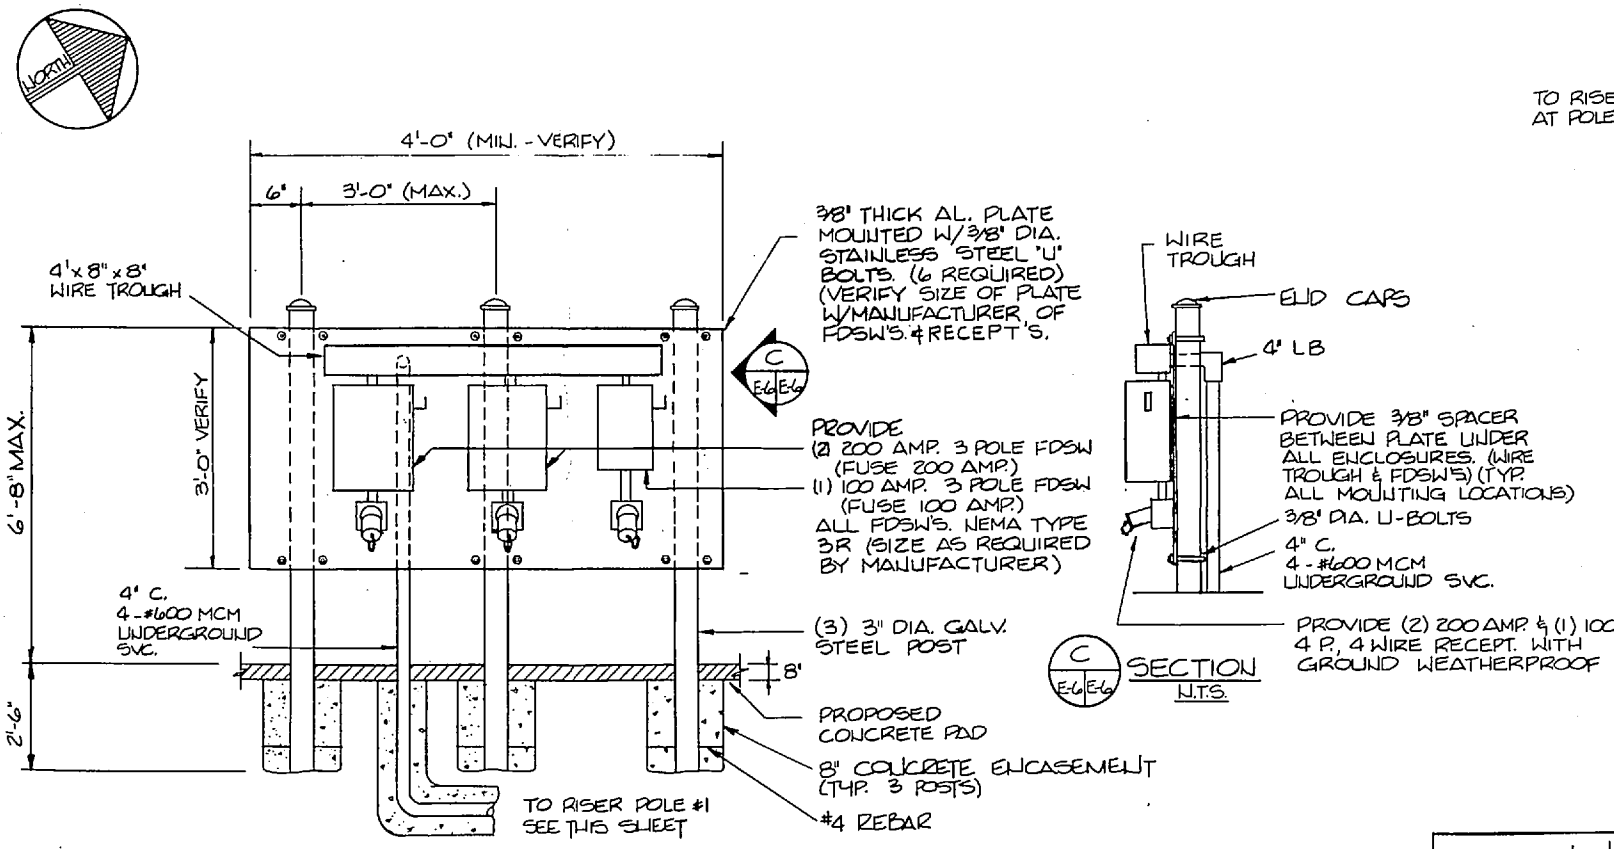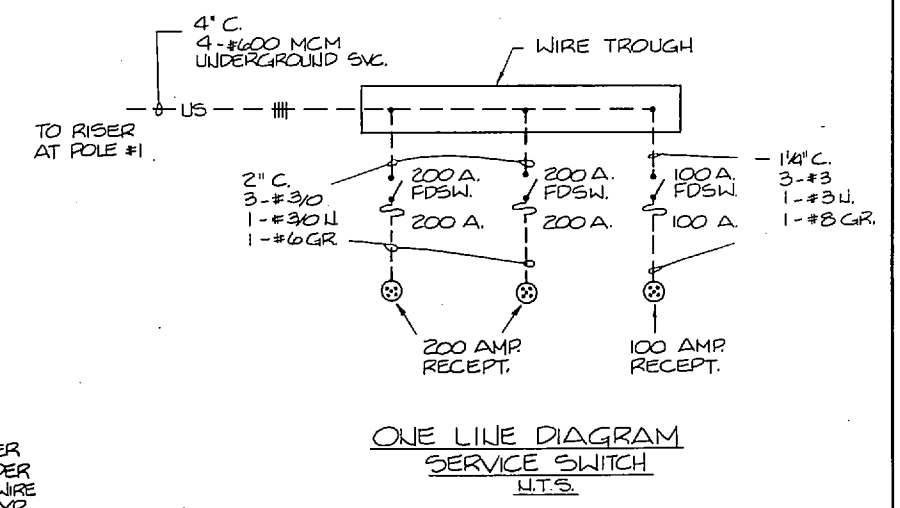
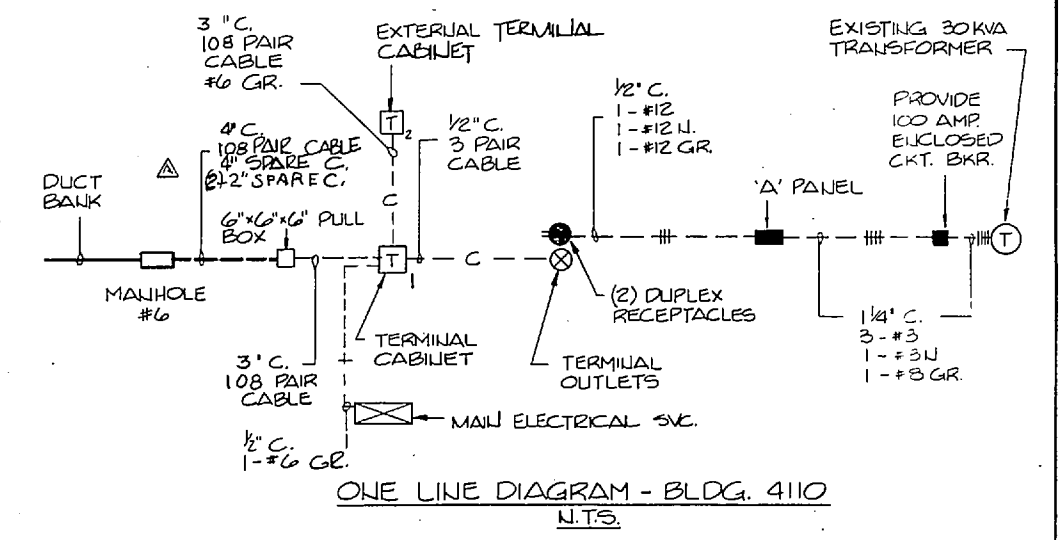


DEBLE & ASSOCIATES, P.A. P.O. Box 1881 WASHINGTON, D.C. 20009 DES. DATE: 7/24/85 NO. REH. TG CHK. DATE: 7/24/85 SUBMITTED BY: [Signature] DESIGN DIR. [Signature] APPROVED: PWD ON [Signature] DATE: 7-24-85 SATISFACTION TO: [Signature] DATE: 7-24-85		<b>I-E-G</b> DEPARTMENT OF THE NAVY NAVAL FACILITIES ENGINEERING COMMAND <b>MARINE CORPS BASE</b> CAMP LEJEUNE, NORTH CAROLINA LINCOLN REPAIRABLES MANAGEMENT MODULE (LRM) MCAS (H) NEW RIVER JACKSONVILLE, NORTH CAROLINA BUILDING AS-4110 NAVFAC DRAWING NO. 4126649 CORE IDENT. NO. 80091 CONSTR. CONTR. NO. 162470-85-B-028 SCALE: GRAPHIC SPEC. 05-85-6386 SHEET 7 OF 14	
--	--	--	--

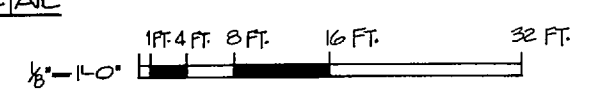





REVISIONS			
BY	DESCRIPTION	DATE	APPROVED
A	REVISED	7/24/41	

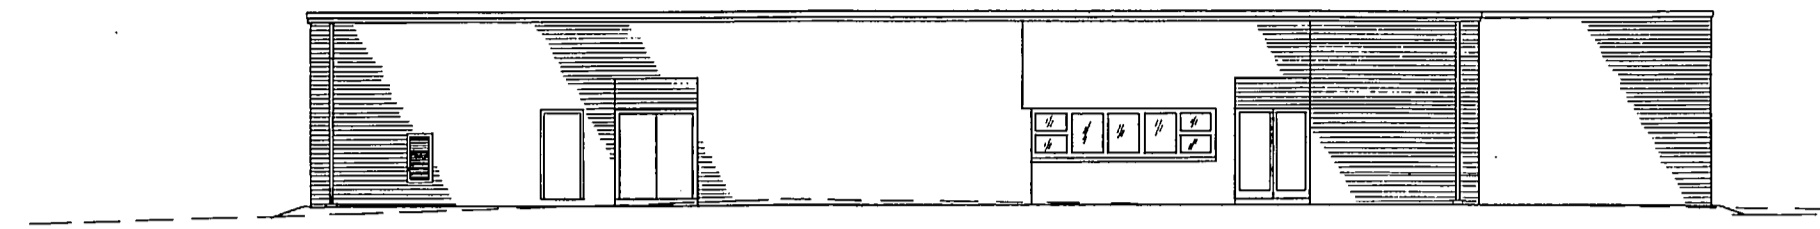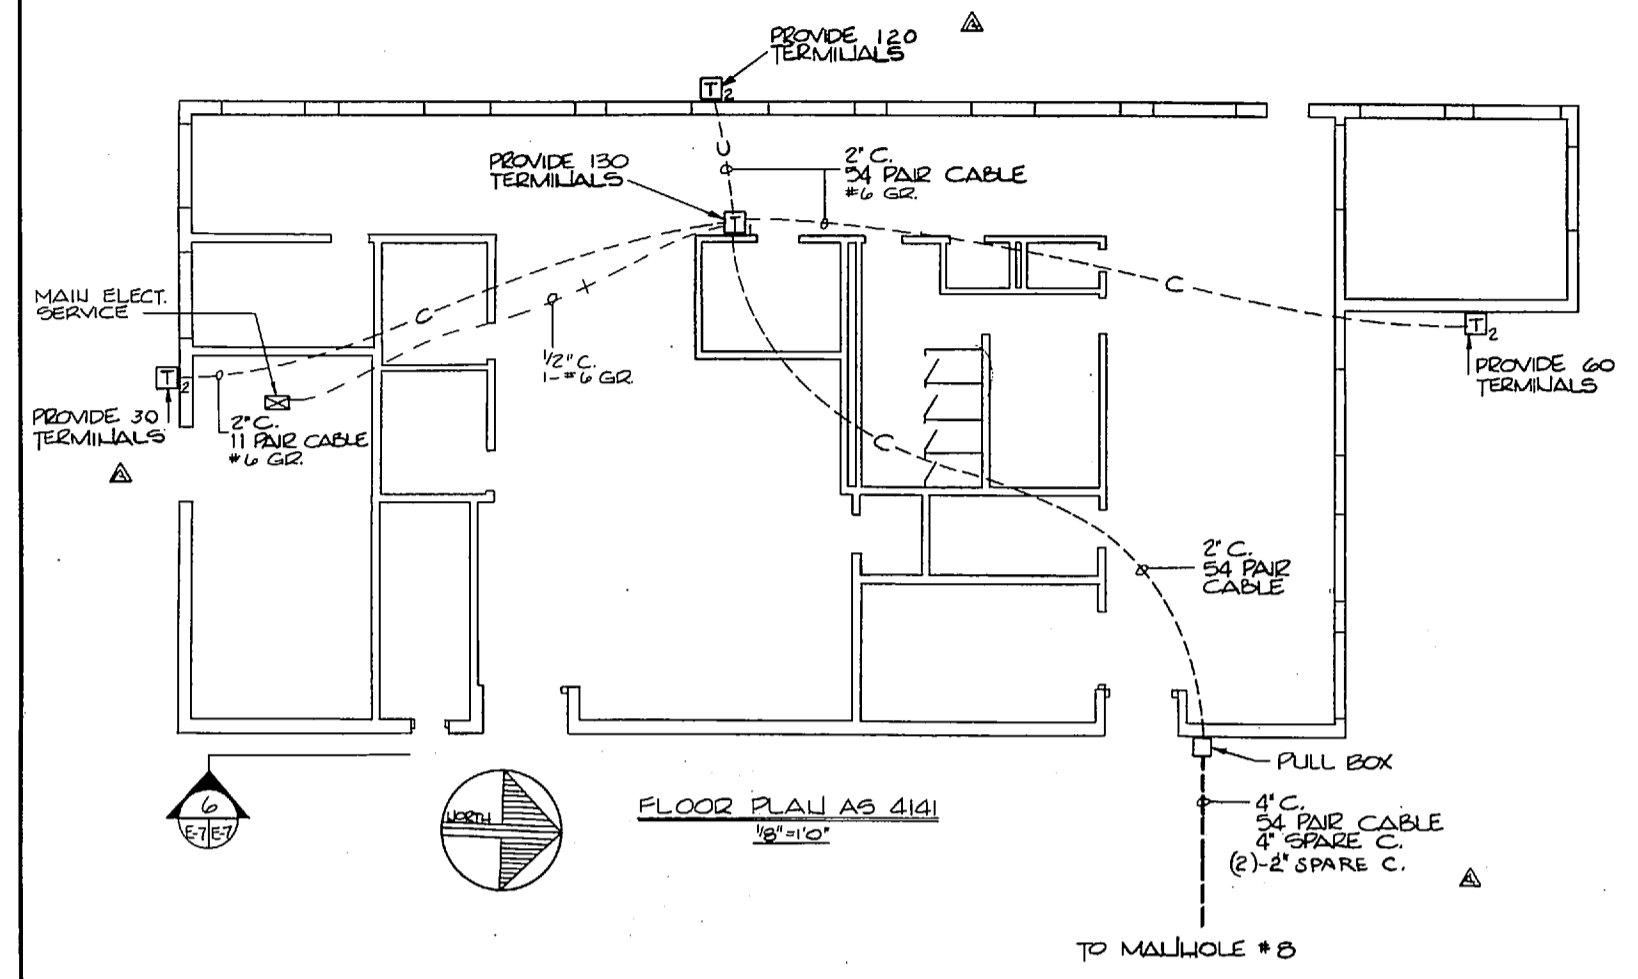


6 EAST ELEVATION - AS BLDG. 4141  
1/8" = 1'-0"

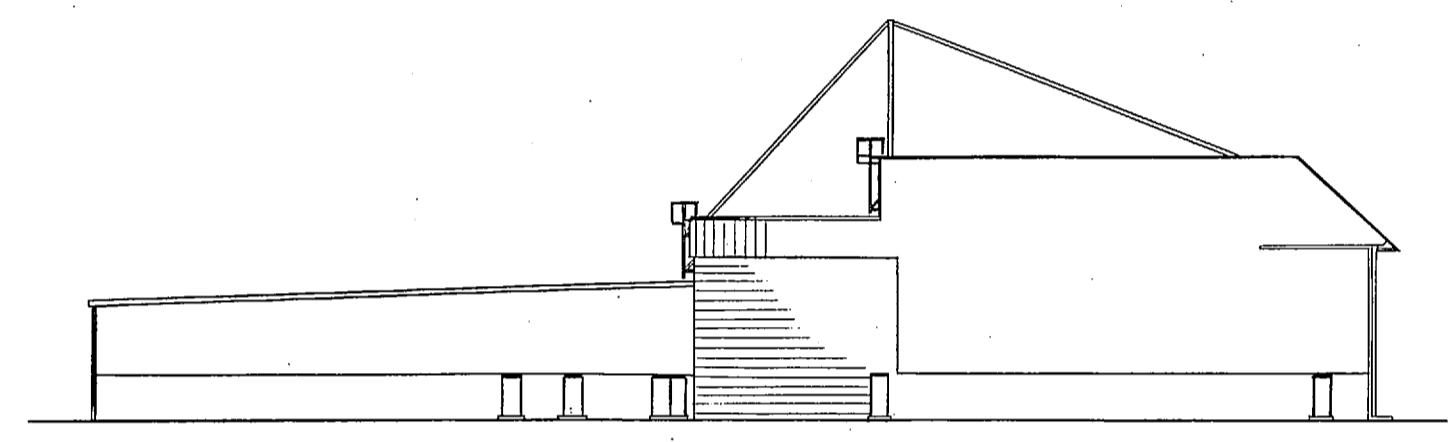

4 WEST ELEVATION - AS BLDG. 4100  
1/16" = 1'-0"

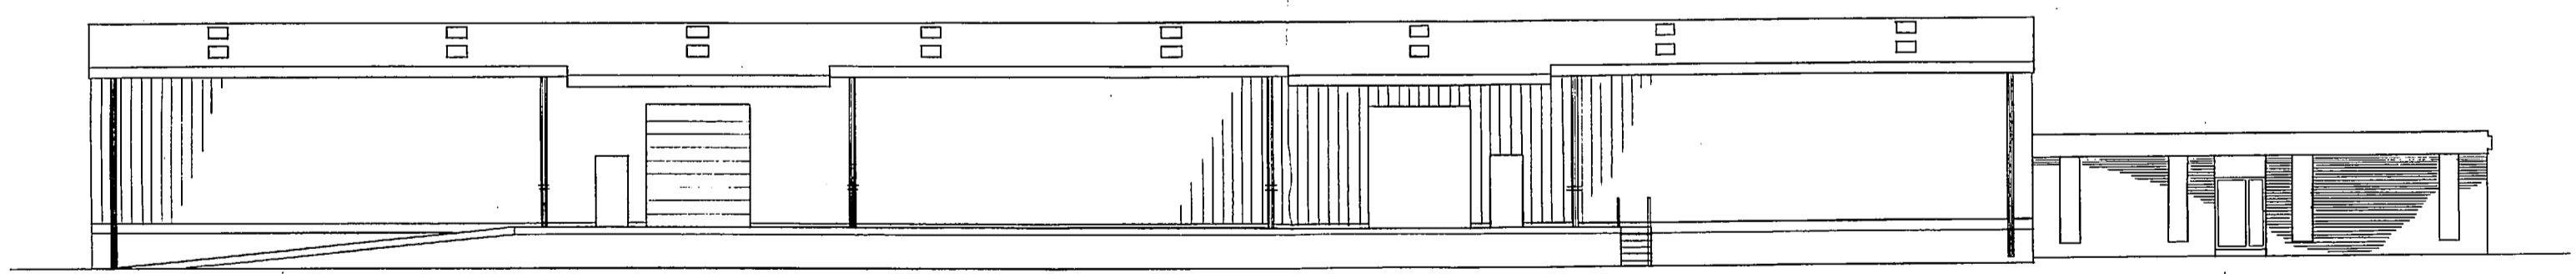

5 EAST ELEVATION - AS BLDG. 4110  
1/8" = 1'-0"

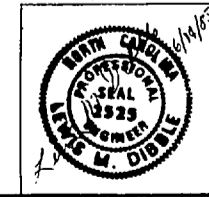





DIBLE & ASSOCIATES, P.A. P.O. BOX 1881 WASHINGTON, D.C. 27889		DEPARTMENT OF THE NAVY NAVAL FACILITIES ENGINEERING COMMAND <b>MARINE CORPS BASE</b> CAMP LEJEUNE, NORTH CAROLINA	
DES. DR. REH JLL	DATE 7/11/41	L1ALCOMIS REPAIRABLES MANAGEMENT MODULE (LRMM) MCAS (H) NEW RIVER JACKSONVILLE, NORTH CAROLINA	
CHK. JLL	DATE 7/11/41	BUILDING AS-4141	
SUBMITTED BY: [Signature]	DATE	SIZE F	CODE IDENT. NO. 80091
DESIGN DIR. [Signature]	DATE	NAVFAC DRAWING NO. 4120650	
APPROVED: PWD OR CIP [Signature]	DATE	CONSTR. CONTR. NO. 122470-05-B-6204	
SATISFACTION [Signature]	DATE	SCALE: GRAPHIC SPEC. 05-85-6886 SHEET 2 OF 12	

E-7







REVISIONS			
SYM.	DESCRIPTION	DATE	APPROVED
Δ	REVISED	7/24/65	

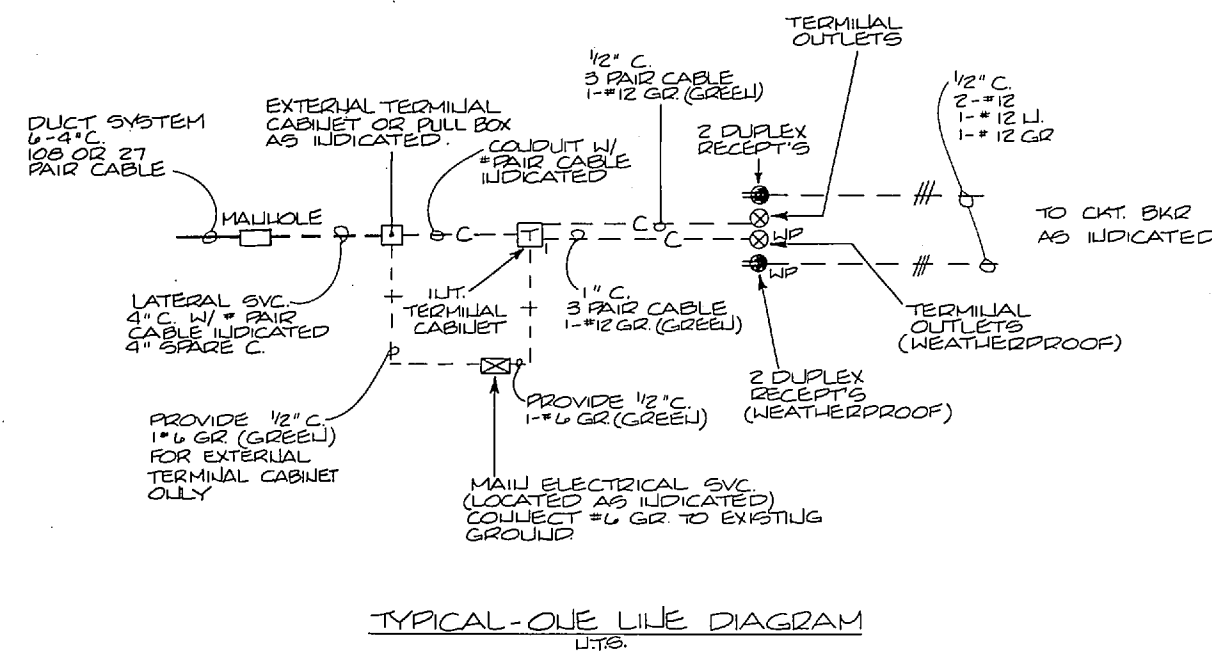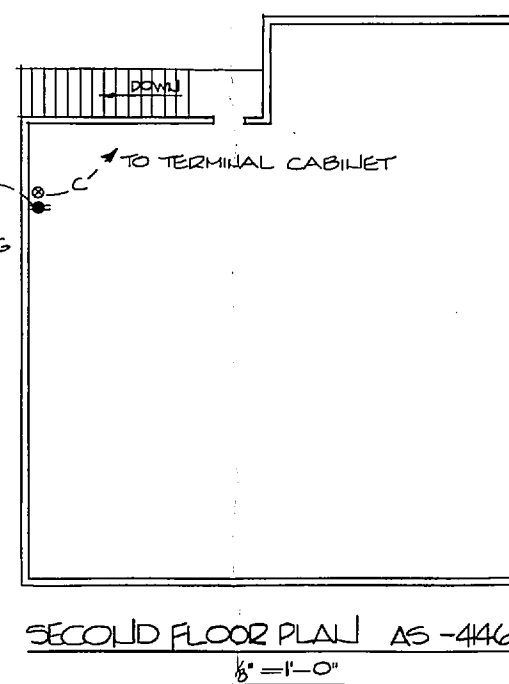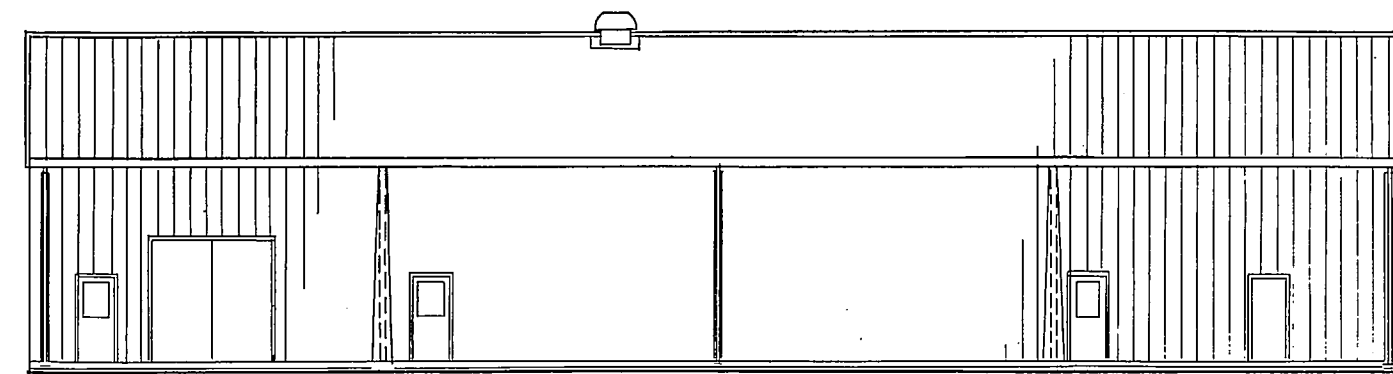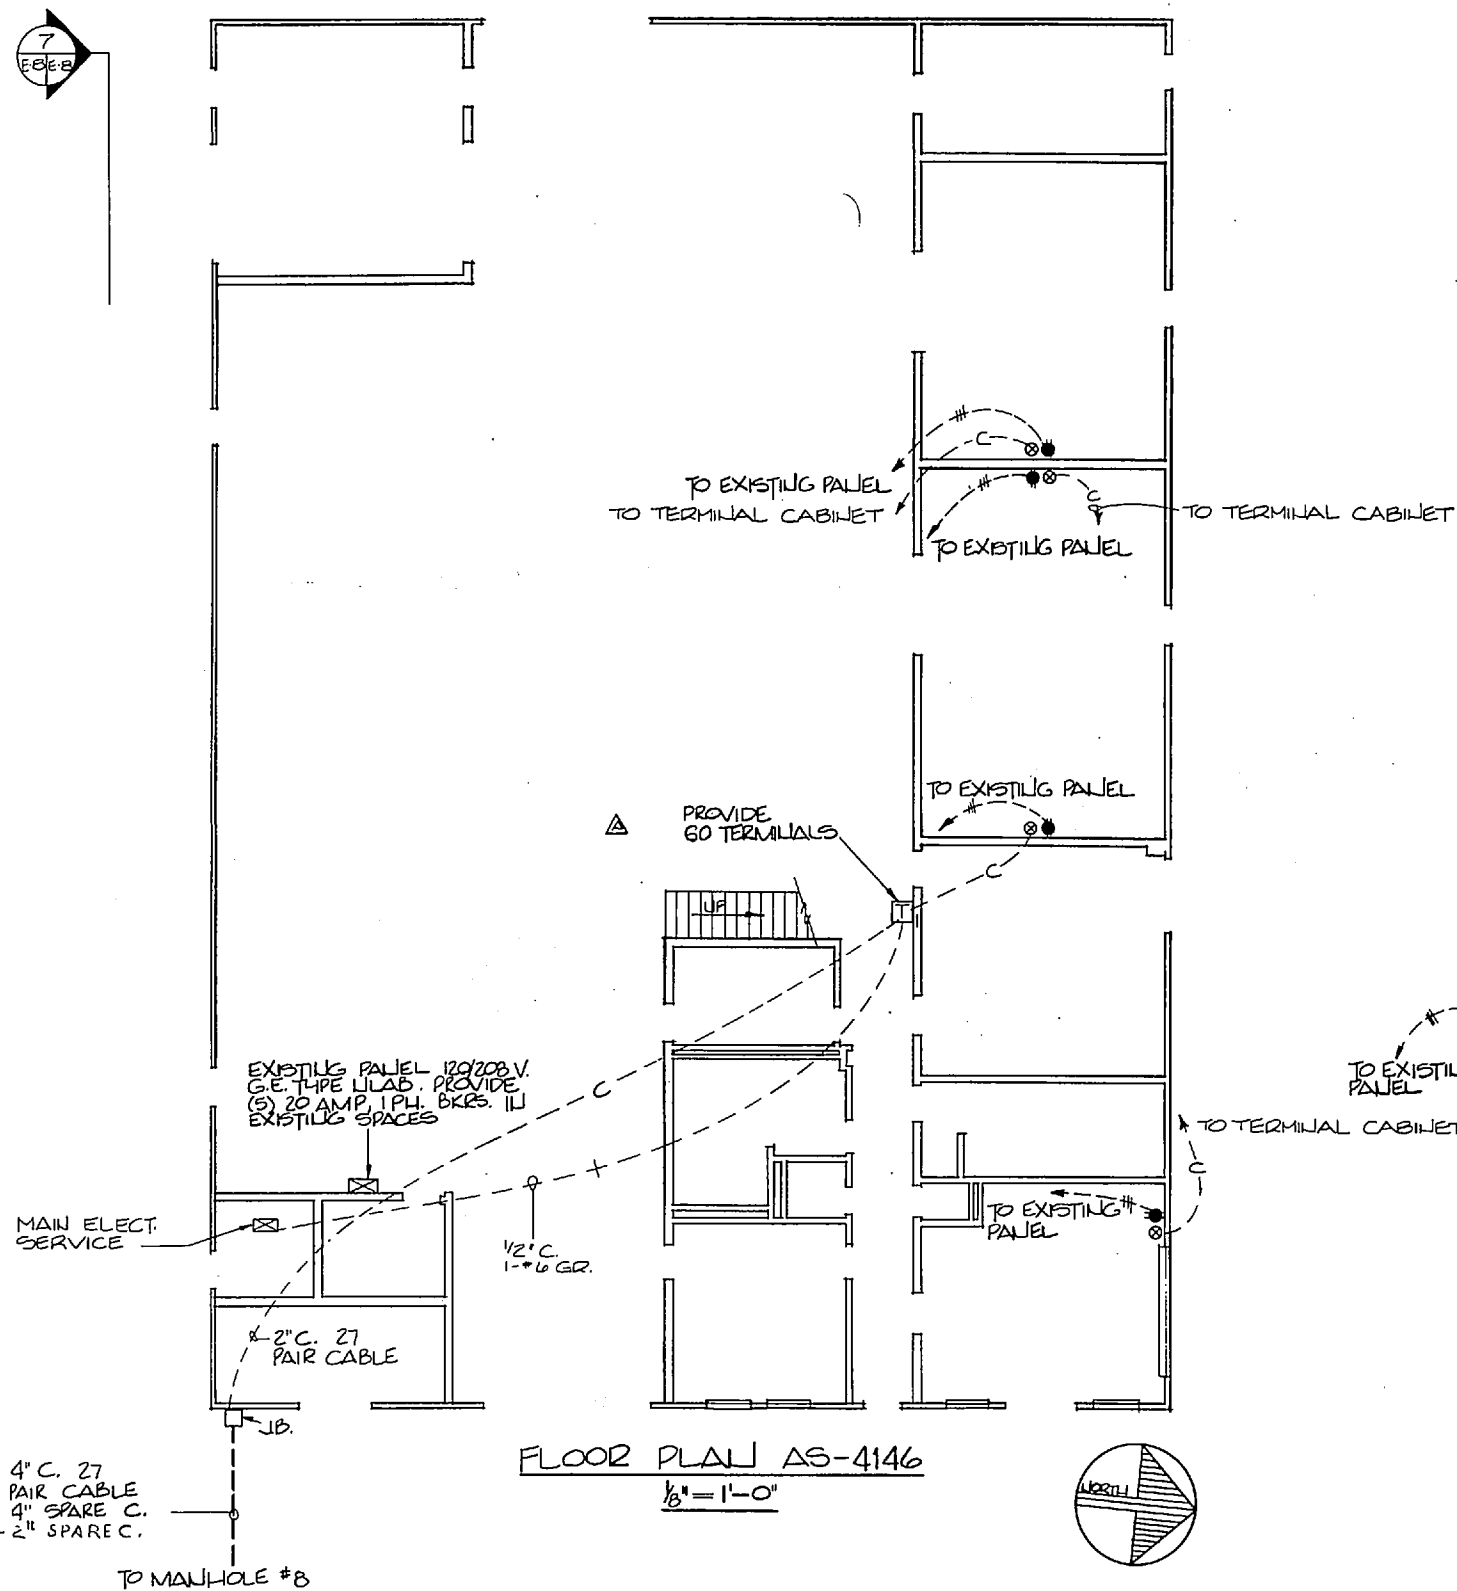


<b>E-8</b>	
DEBLE & ASSOCIATES, P.A. P.O. BOX 1881 WASHINGTON, N.C. 27880	
DEPARTMENT OF THE NAVY NAVAL FACILITIES ENGINEERING COMMAND <b>MARINE CORPS BASE</b> CAMP LEJEUNE, NORTH CAROLINA	
DR. JLL	1/16
CHK. JLL	1/16
SUBMITTED BY: JY	1/16
DESIGN DIR. [Signature]	1/16
APPROVED: PWO OR OUC	DATE
SATISFACTORY TO: [Signature]	DATE
7-24-65	
SIZE	CODE IDENT. NO.
F	80091
NAVFAC DRAWING NO.	4126051
CONSTR. CONTR. NO. 1162470-85-B-C38	
SCALE: 60% P&C	SPEC. 05-85-6386
BUILDING AS-4146	
SHEET 9 OF 14	

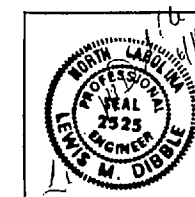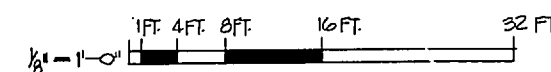




REVISIONS			
SYM.	DESCRIPTION	DATE	APPROVED
(A)	REVISED	7-19-85	
(B)	REVISED	7/24/85	

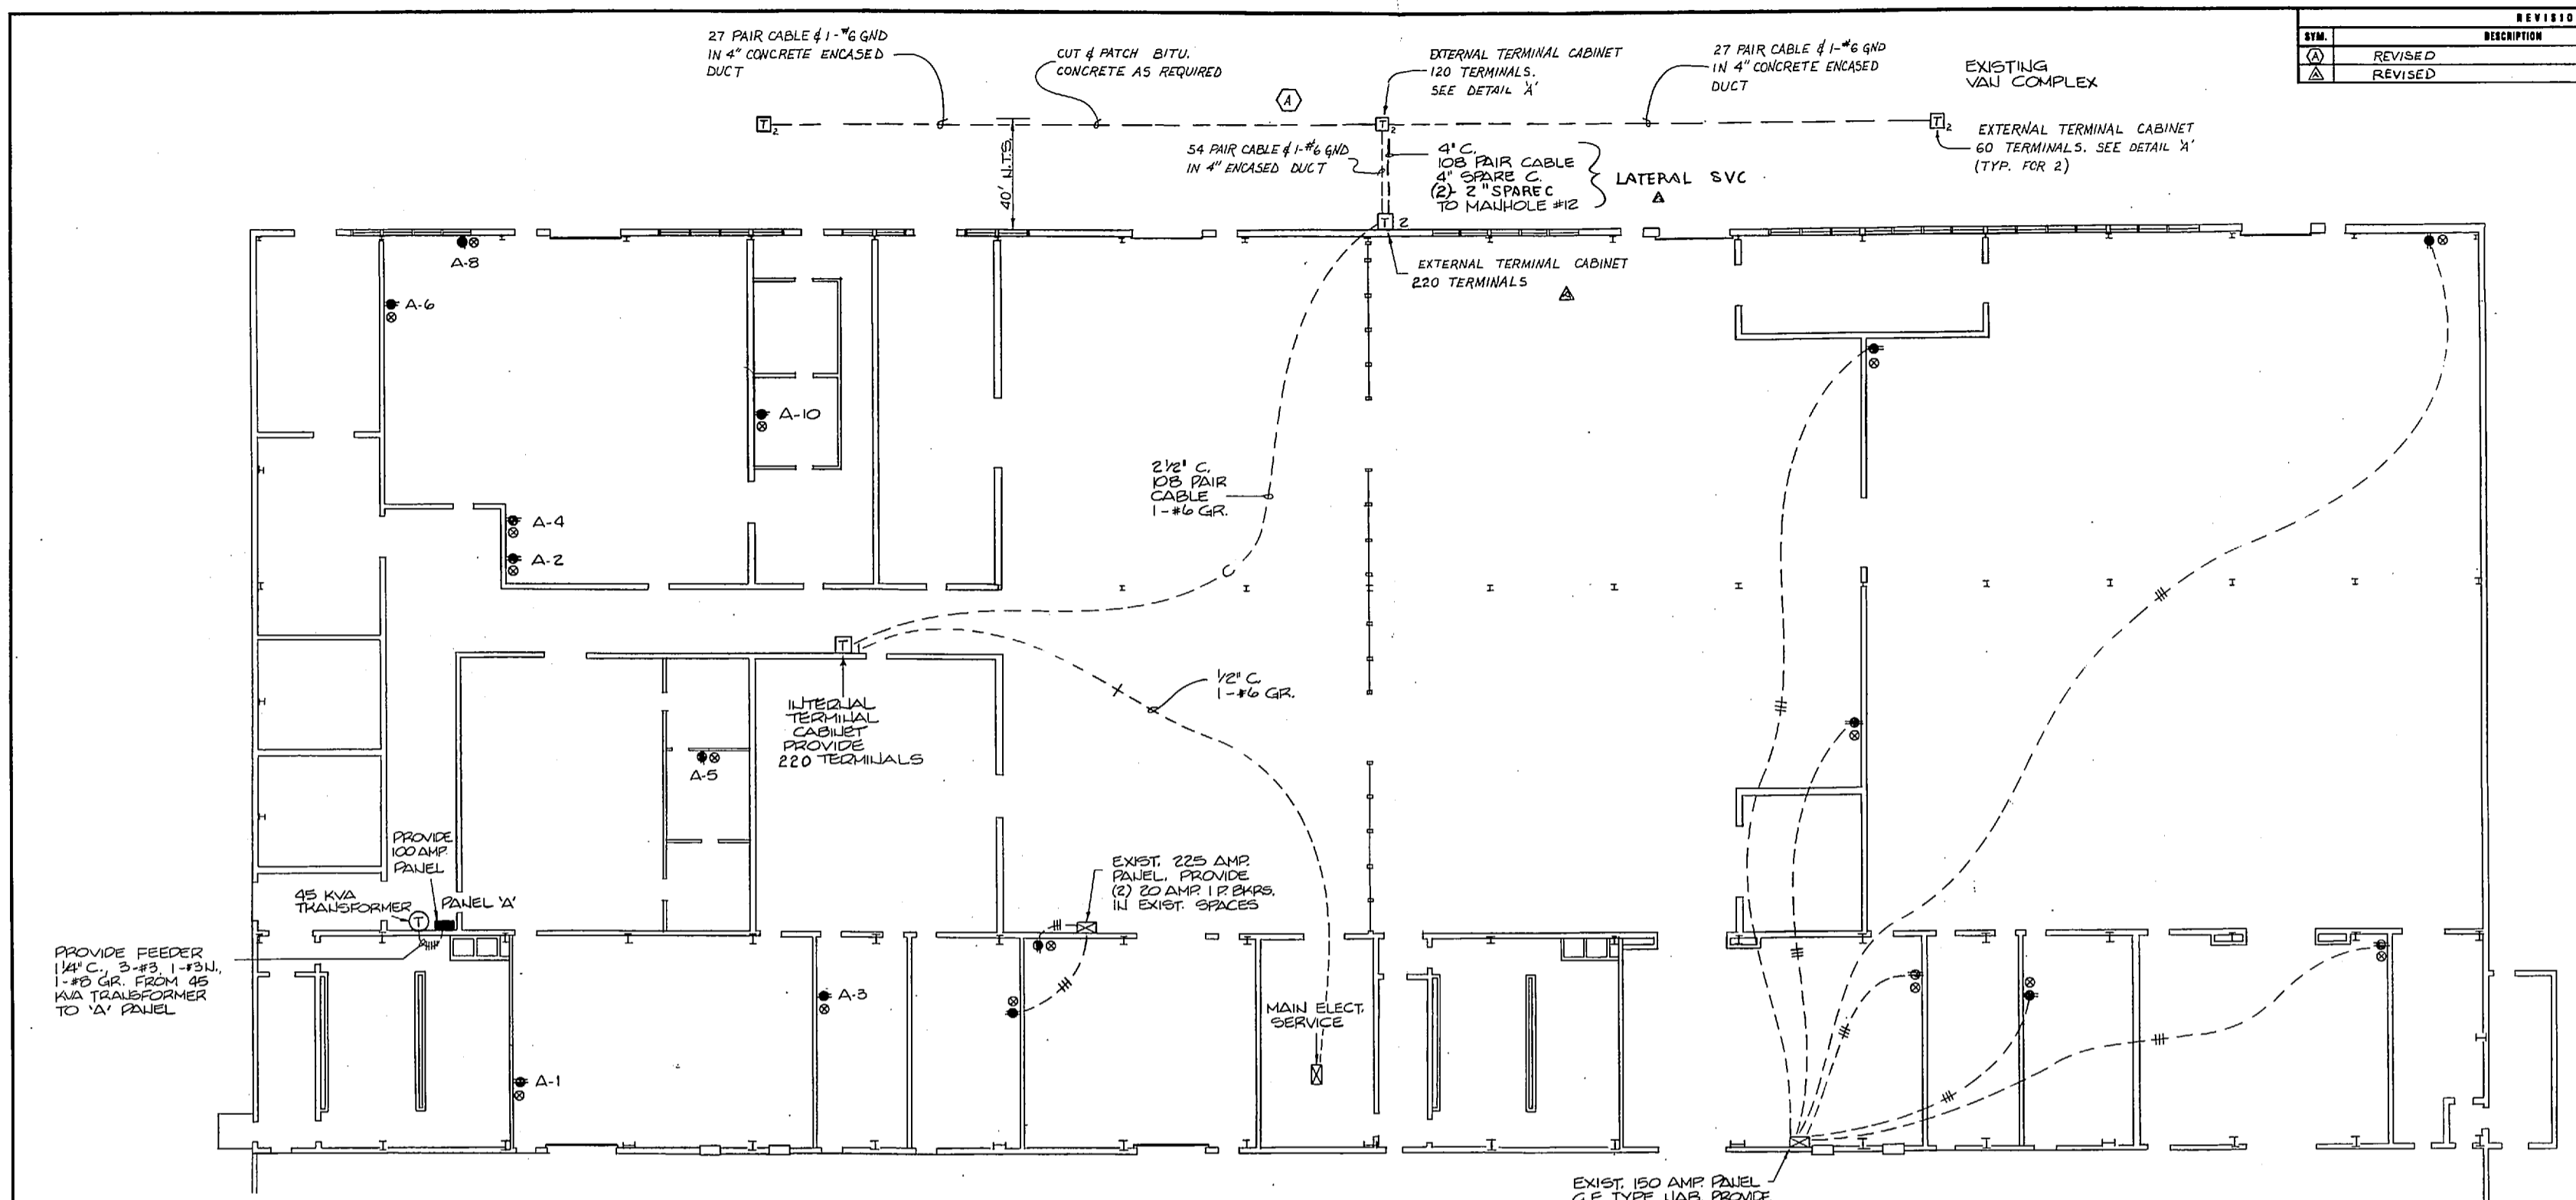


PROVIDE FEEDER 1/4\" C., 3-#3, 1-#2N, 1-#8 GR. FROM 45 KVA TRANSFORMER TO 'A' PANEL

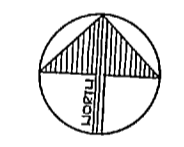


FIRST FLOOR PLAN - HANGAR AS-518  
3/32' = 1'-0"


NOTE:  
ALL TERMINAL OUTLETS FEED FROM INTERNAL TERMINAL CABINET WITH 1/2\" C., 3 PAIR CABLE #12 GR.

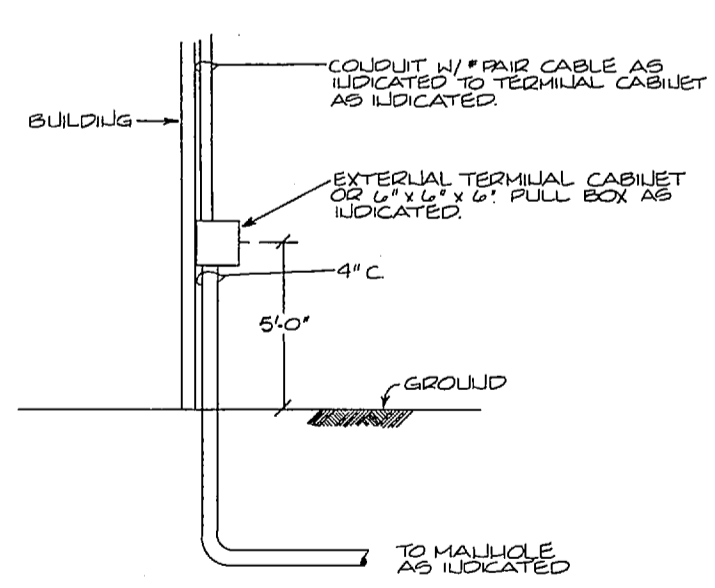


LATERAL SVC. SECTION  
1/8\"

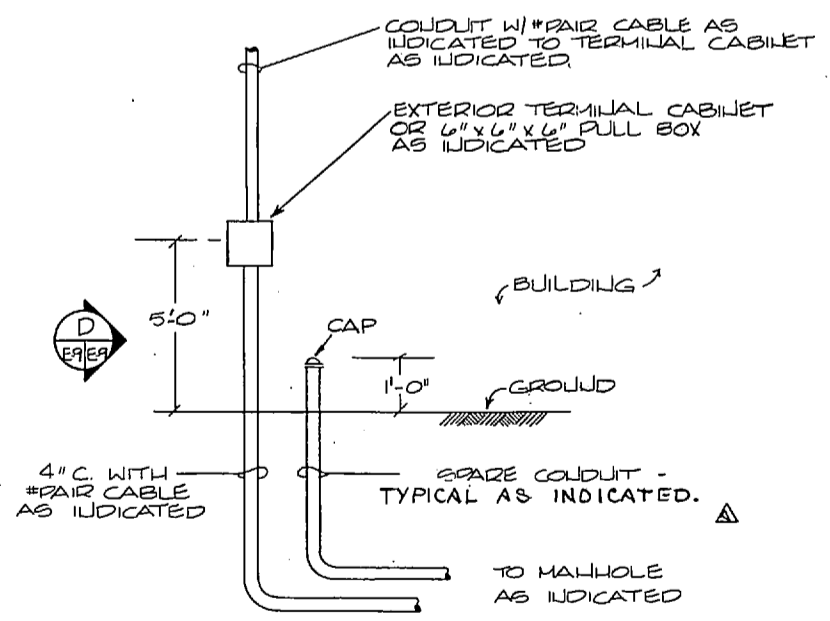

DETAIL - TYP LATERAL SVC. AT BUILDING ENTRANCE  
1/8\"

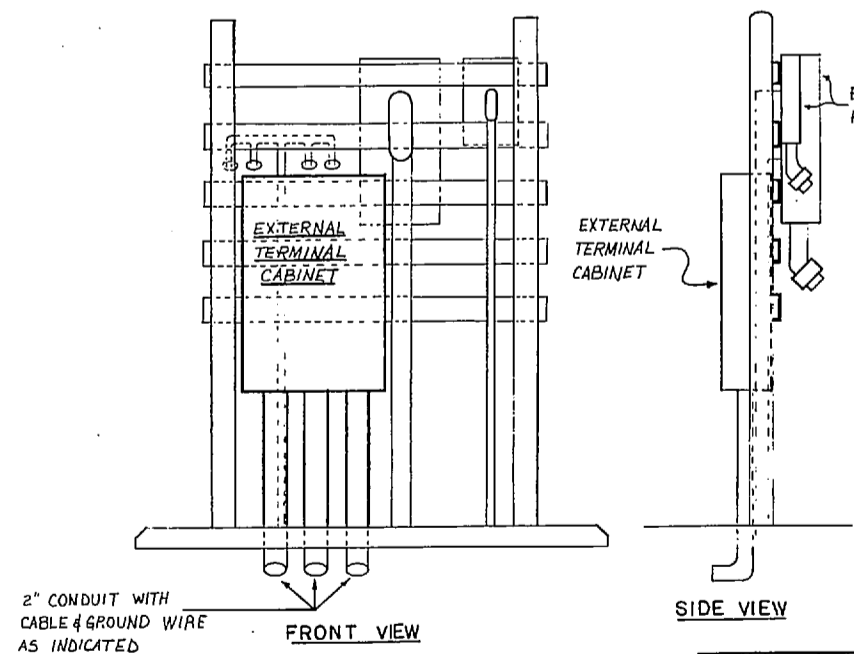

FRONT VIEW  
DETAIL A  
N.T.S.

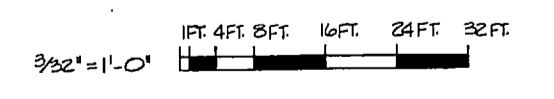



SPACE																														

'A' PANEL - BLDG. AS-518  
100 AMP MLO 120/208 V, 3 Ø,  
4 WIRE, SURFACE MOUNT

DEBLE & ASSOCIATES, P.A. P.O. BOX 1821 WASHINGTON, NC 27889		DEPARTMENT OF THE NAVY NAVAL FACILITIES ENGINEERING COMMAND	
DES. DR. REH JH CHK. [Signature] SUBMITTED BY: [Signature] DESIGN DIR. [Signature]		MARINE CORPS BASE CAMP LEJEUNE, NORTH CAROLINA L1ALCOMS DEPENDABLES MANAGEMENT MODULE (NEMM) MCAS (L) NEW RIVER JACKSONVILLE, NORTH CAROLINA	
APPROVED: PWD OR OIC [Signature] DATE: 7-24-85		HANGAR - AS 518	
SATISFACTION: [Signature]		SIZE: F	CODE IDENT. NO.: 80091
SCALE: 6/8\"/>			




REVISIONS			
SYM.	DESCRIPTION	DATE	APPROVER
△	REVISED	7/24/85	

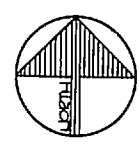
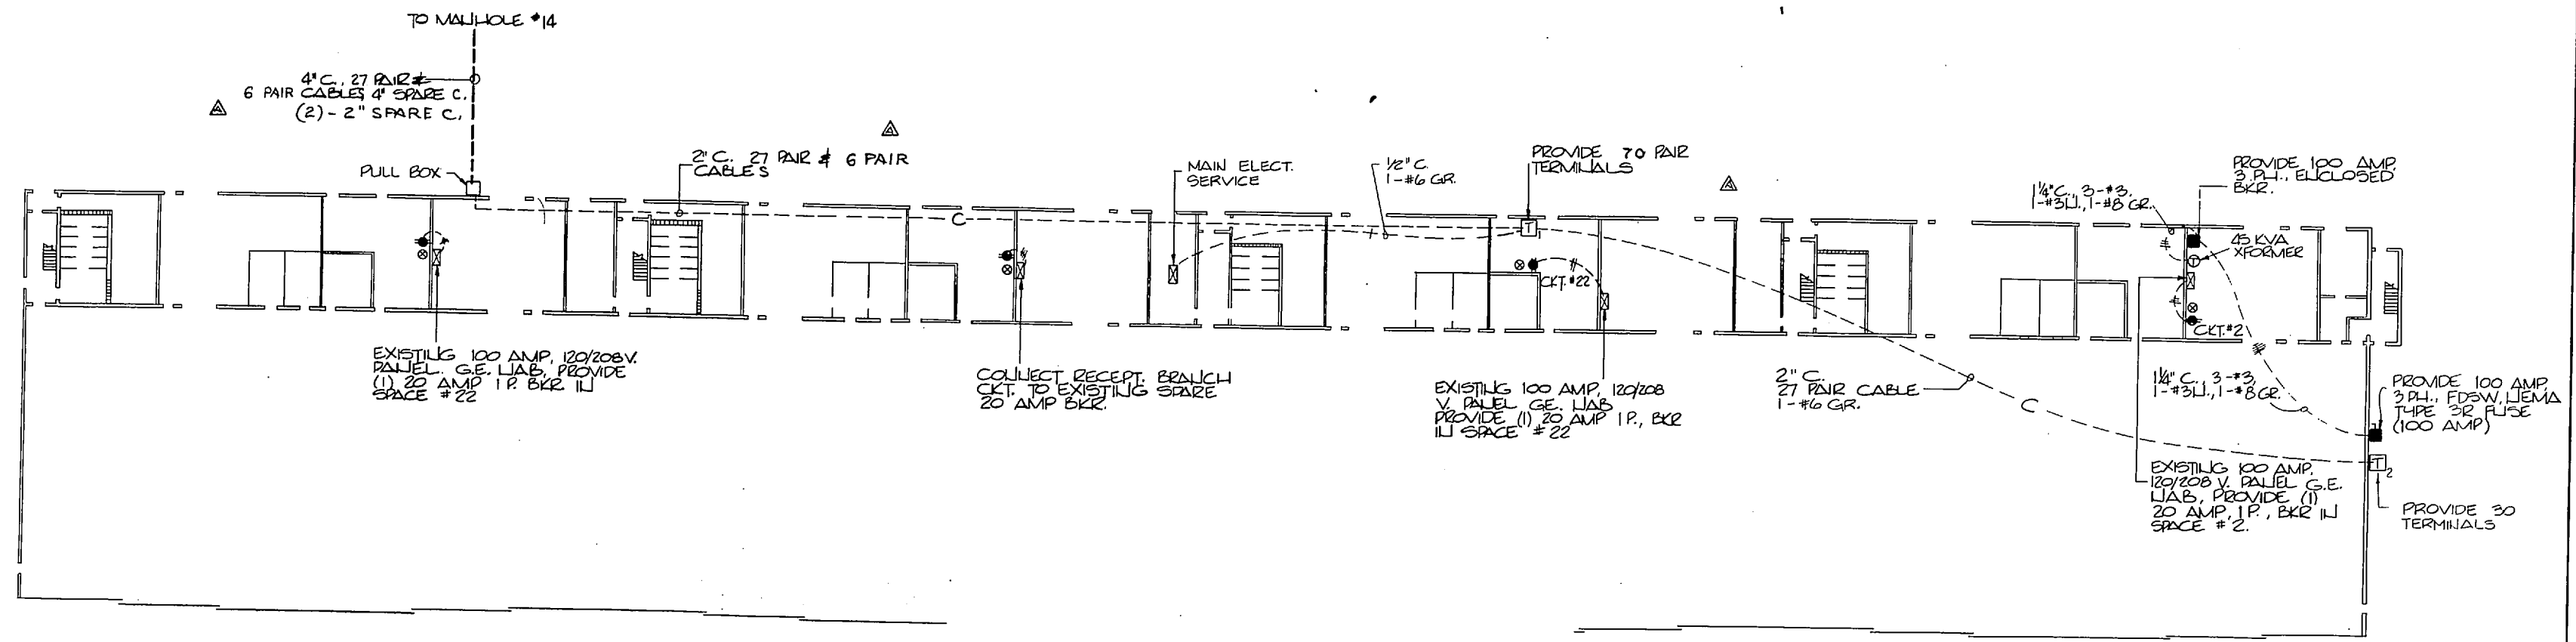


FLOOR PLAN - HANGAR AS-515  
1" = 20' 0"

- NOTE: 1. COLLECT TO EXISTING 45 KVA TRANSFORMER FOR 100 AMP 3P ENCLOSED BKR.  
2. COLLECT ALL OUTLET TERMINALS TO INTERNAL TERMINAL CABINET.

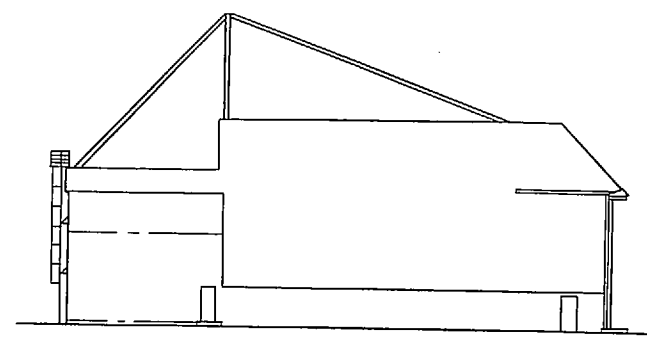




WEST ELEVATION - HANGAR AS-515  
1" = 20' 0"

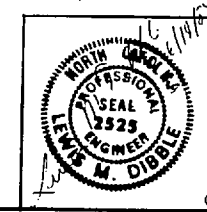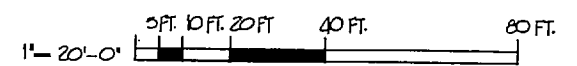

DIBBLE & ASSOCIATES, P.A. P.O. BOX 1881 WASHINGTON, NC 27889		DEPARTMENT OF THE NAVY NAVAL FACILITIES ENGINEERING COMMAND <b>MARINE CORPS BASE</b> CAMP LEJEUNE, NORTH CAROLINA	
DES. DR. JH.	CHK. T.C.	WALCOMB REPAIRABLES MAINTENANCE MODULE (WRMM) MCAS (H) NEW RIVER JACKSONVILLE, NORTH CAROLINA	
SUBMITTED BY: [Signature]		HANGAR AS-515	
APPROVER: PWD 08-01CC	DATE: 7/24/85	SIZE: F	CODE IDENT. NO.: 80091
SATISFACTION NO.:	DATE:	NAVFAC DRAWING NO.: 4126653	CONSTR. CONTR. NO.: 2470-85-B-6284
SCALE: GRAPHIC		SPEC. 05-85-6386 SHEET 11 OF 14	





REVISIONS			
SYM.	DESCRIPTION	DATE	APPROVED
A	REVISED	7/24/81	

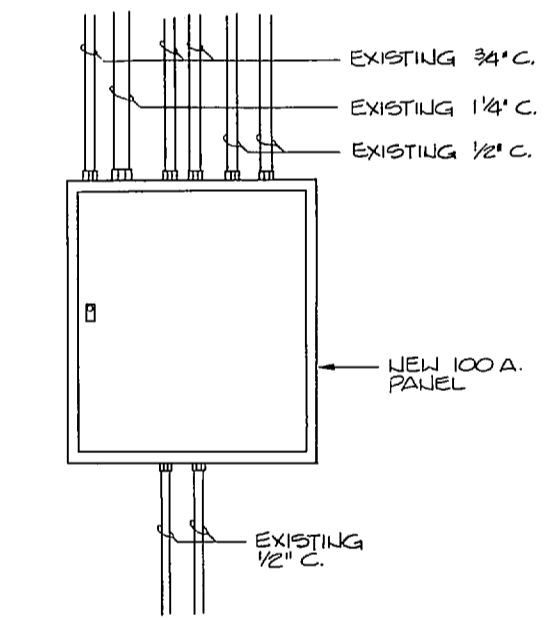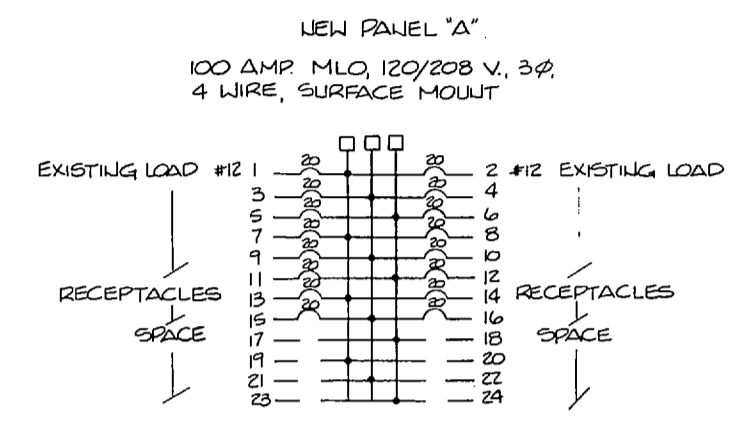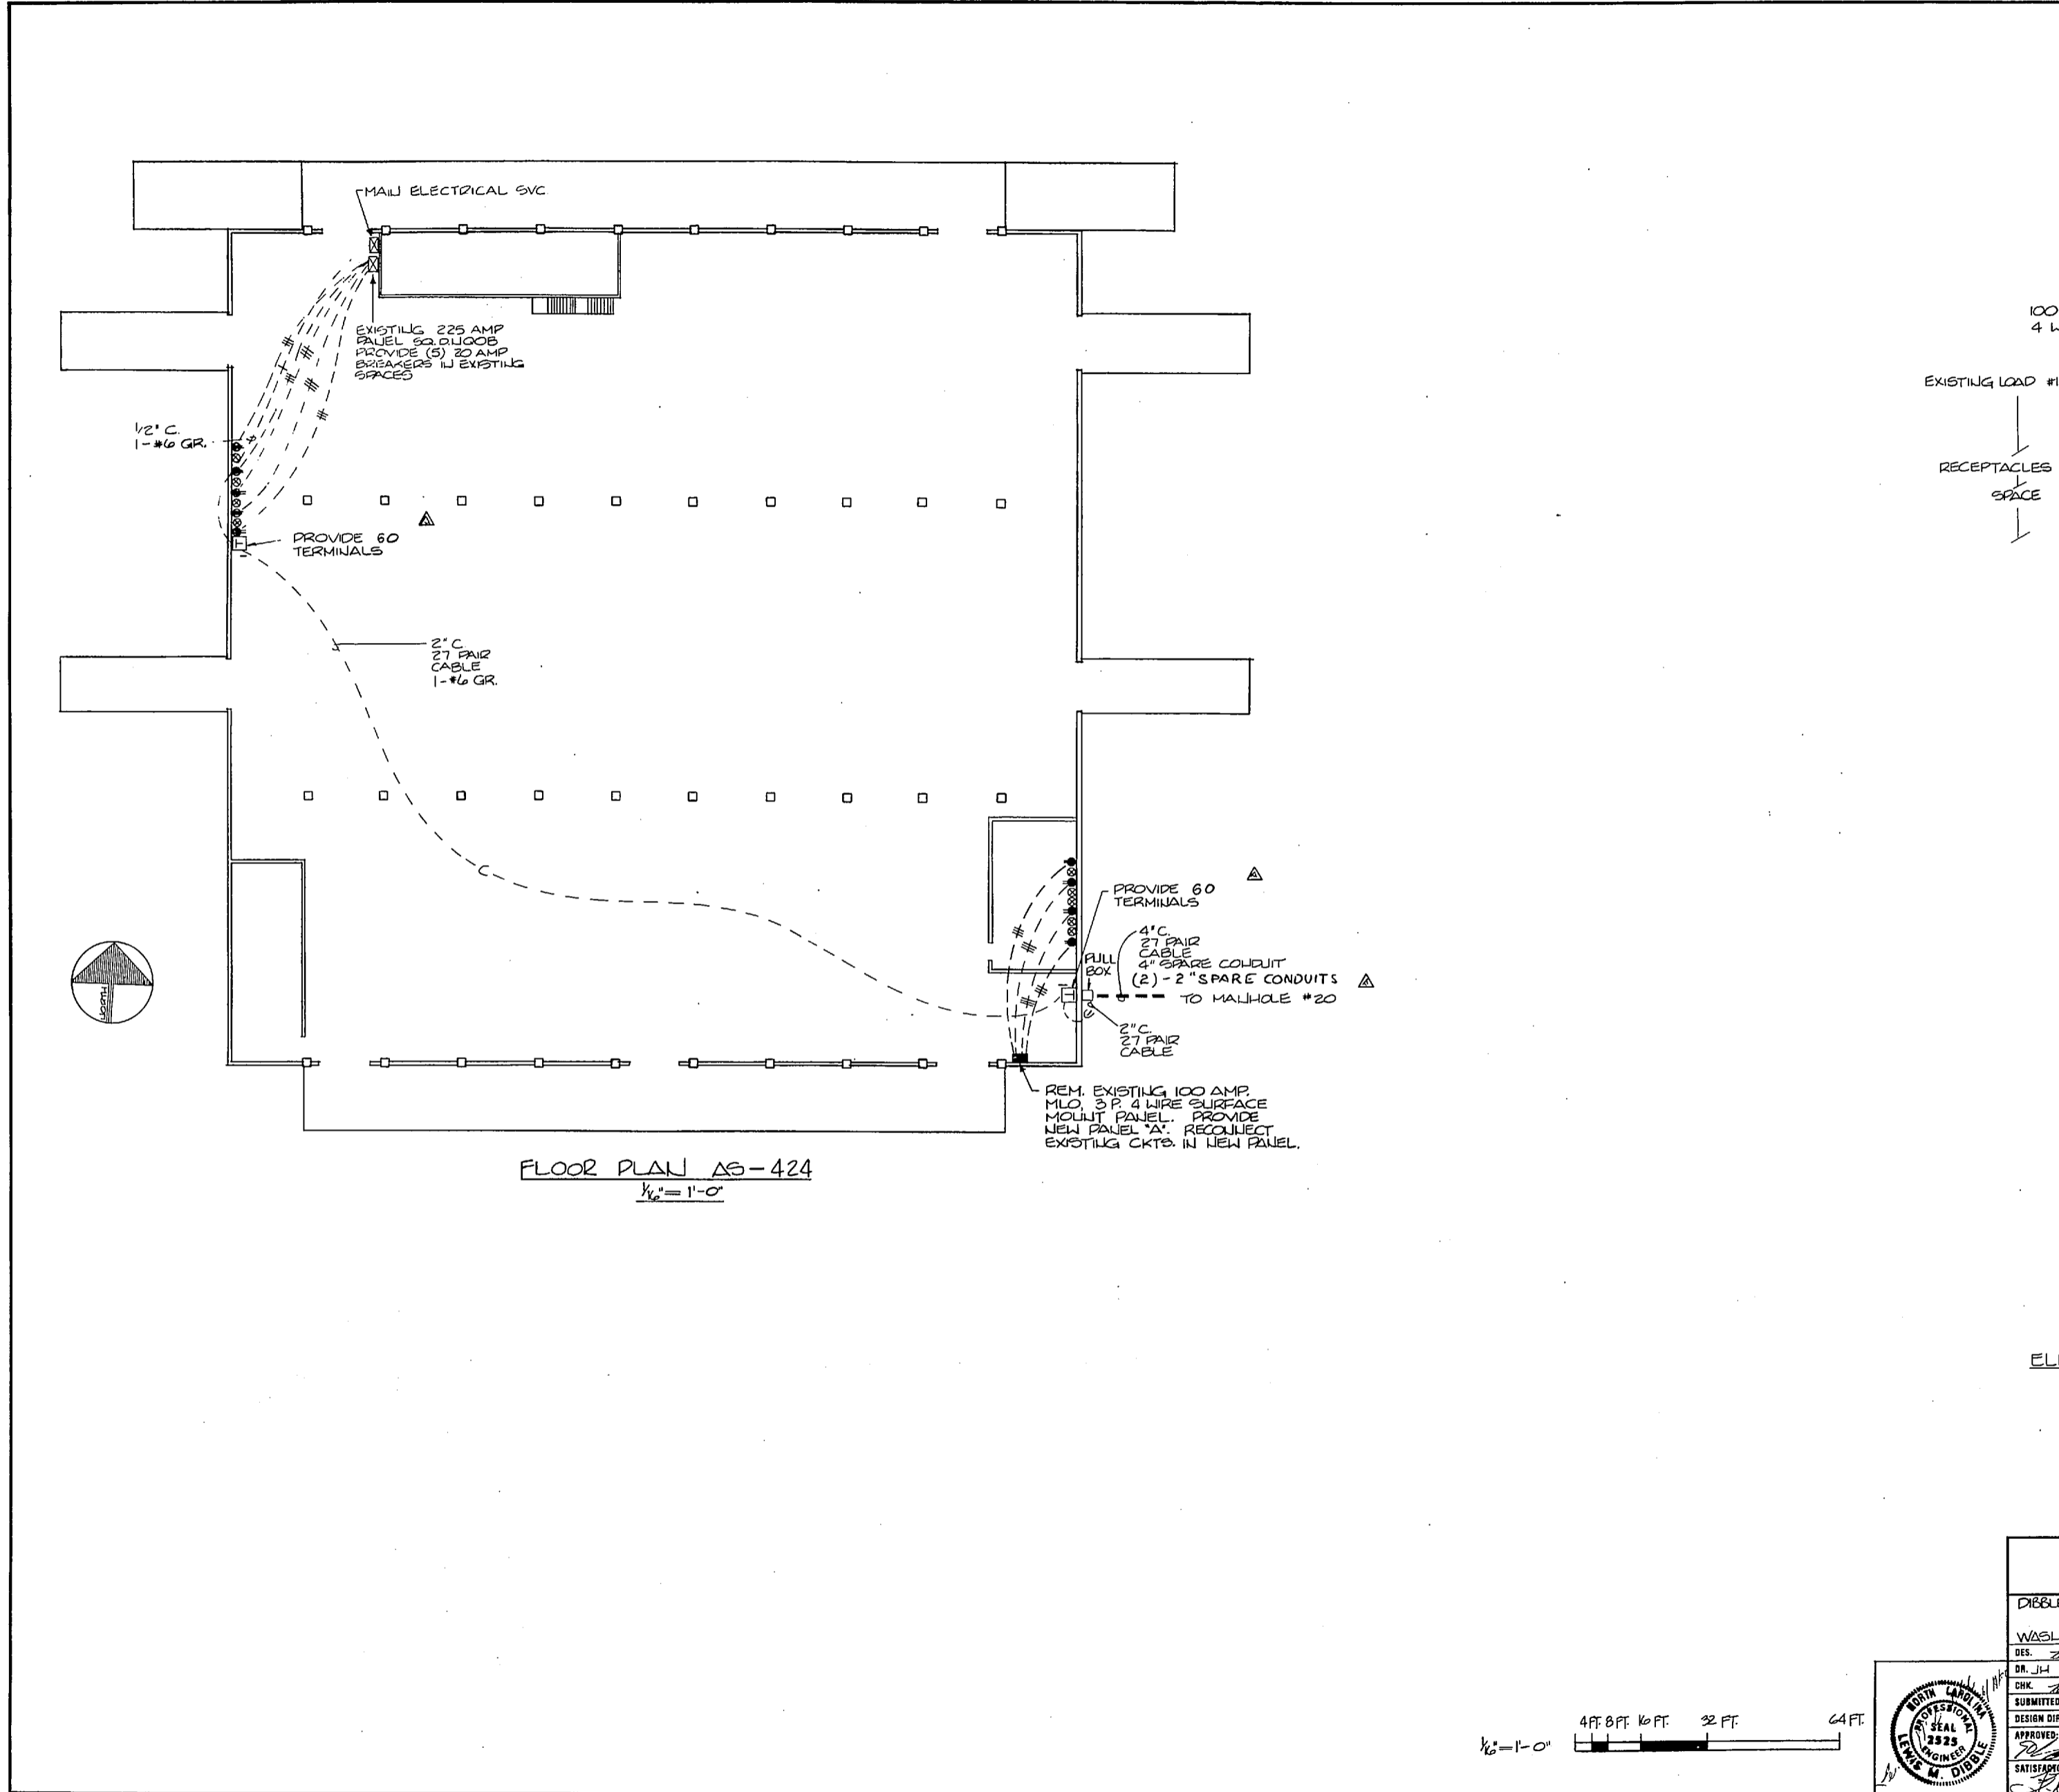

ELEVATION FOR NEW PANEL "A"  
N.T.S.

FLOOR PLAN AS-424  

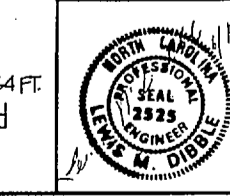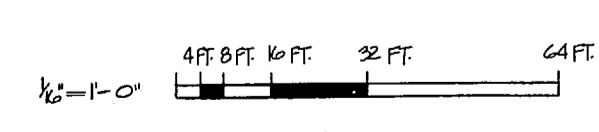

DIBBLE & ASSOCIATES, P.A. P.O. BOX 1881 WASHINGTON, NC 27889		DEPARTMENT OF THE NAVY NAVAL FACILITIES ENGINEERING COMMAND <b>MARINE CORPS BASE</b> CAMP LEJEUNE, NORTH CAROLINA	
DES. <i>JH</i>	CHK. <i>JH</i>	L1ALCOMS REPAIRABLES MANAGEMENT MODULE (L1EMM) MCAS (H) NEW RIVER JACKSONVILLE, NORTH CAROLINA	
DR. <i>JH</i>	TO <i>JH</i>	BUILDING AS-424	
SUBMITTED BY: <i>JH</i>	DATE: <i>7-24-81</i>	SIZE: <b>F</b>	CODE IDENT. NO.: <b>80091</b>
DESIGN DIR. <i>JH</i>	APPROVED: <i>JH</i>	DATE: <i>7-24-81</i>	NAVFAC DRAWING NO.: <b>4126654</b>
SATISFACTORY TO: <i>JH</i>	DATE: <i>7-24-81</i>	CONSTR. CONTR. NO. <i>2470-86-B-386</i>	
SCALE: GRAPHIC		SPEC. <i>05-85-6386</i>	
		SHEET 12 OF 14	

E-11













REVISIONS			
BY	DESCRIPTION	DATE	APPROVED
Δ	REVISED	7/24/85	

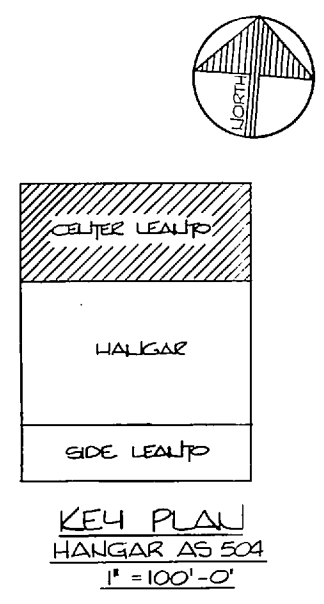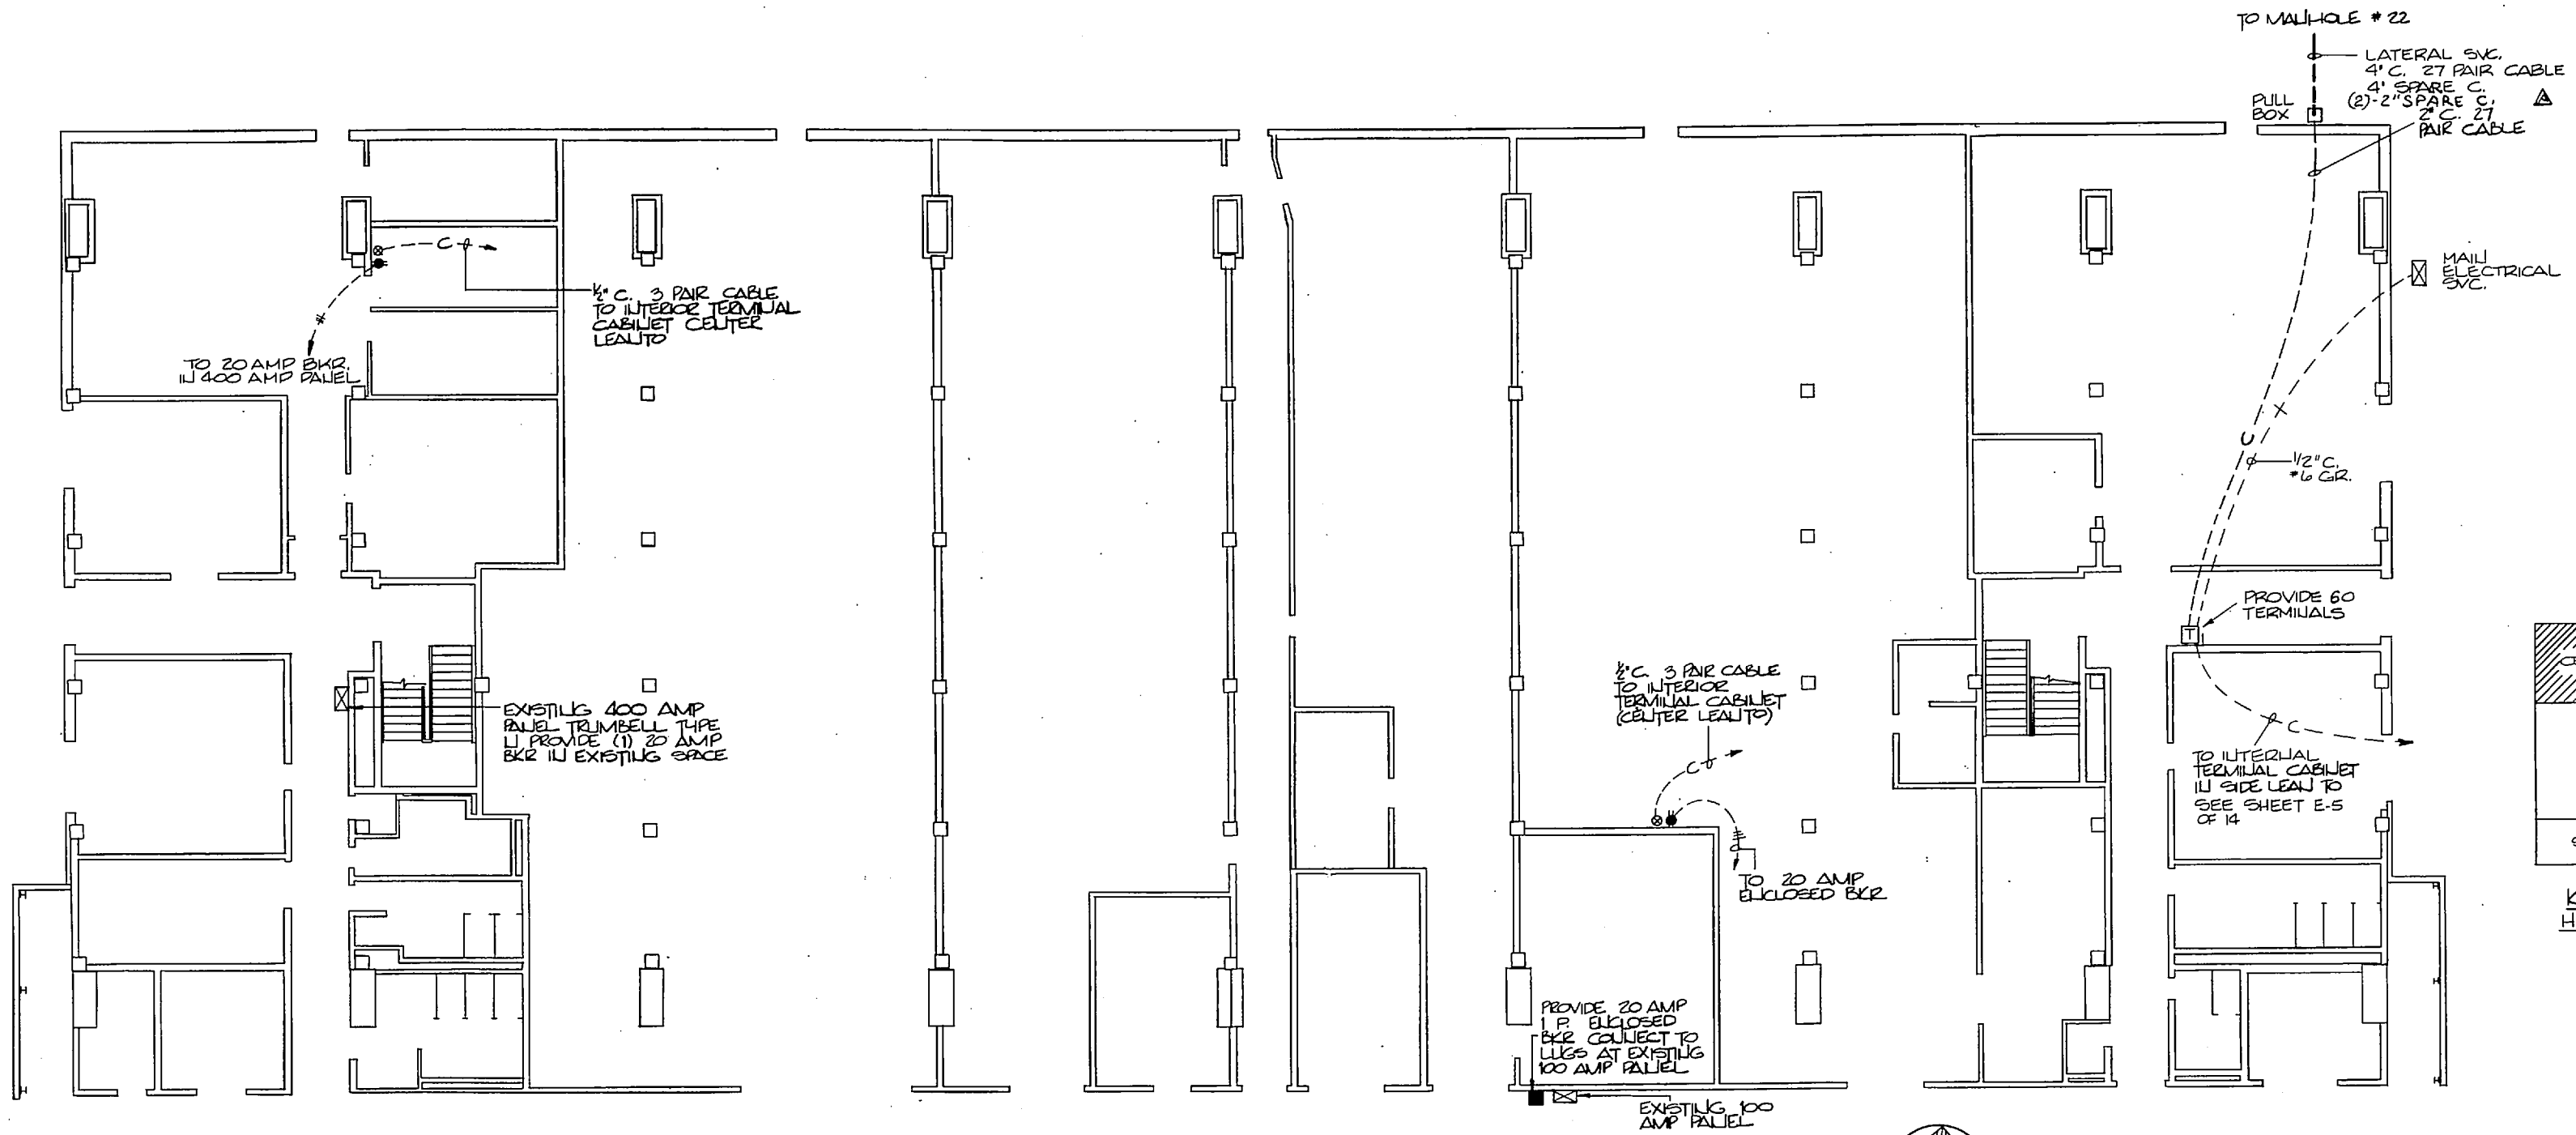

FIRST FLOOR PLAN-CENTER LEAD TO-HANGAR AS-504  
1/8" = 1'-0"

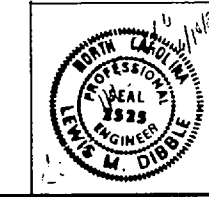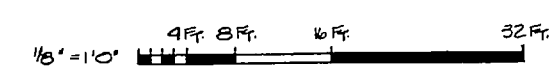

DIBLE & ASSOCIATES, P.A. P.O. BOX 1884 WASSELINGTON, NC 27889		DEPARTMENT OF THE NAVY NAVAL FACILITIES ENGINEERING COMMAND	
MARINE CORPS BASE CAMP LEAUE, NORTH CAROLINA		E-13	
HALLCOMB REPAIRABLES MANAGEMENT MODULE (JRM) MCAS (H) NEW RIVER JACKSONVILLE, NORTH CAROLINA		HANGAR AS-504	
DESIGN NO. 20	DATE 7/18/85	SIZE F	CODE IDENT. NO. 80091
APPROVED: P.M. ON-DISC	DATE 7/24/85	NAVFAC DRAWING NO. 4126856	
SATISFACTORY TO: [Signature]		CONSTR. CONTR. NO. 1240-85-6-286	
SCALE: GRAPHIC SPEC. 05-85-6386		SHEET 14 OF 14	

