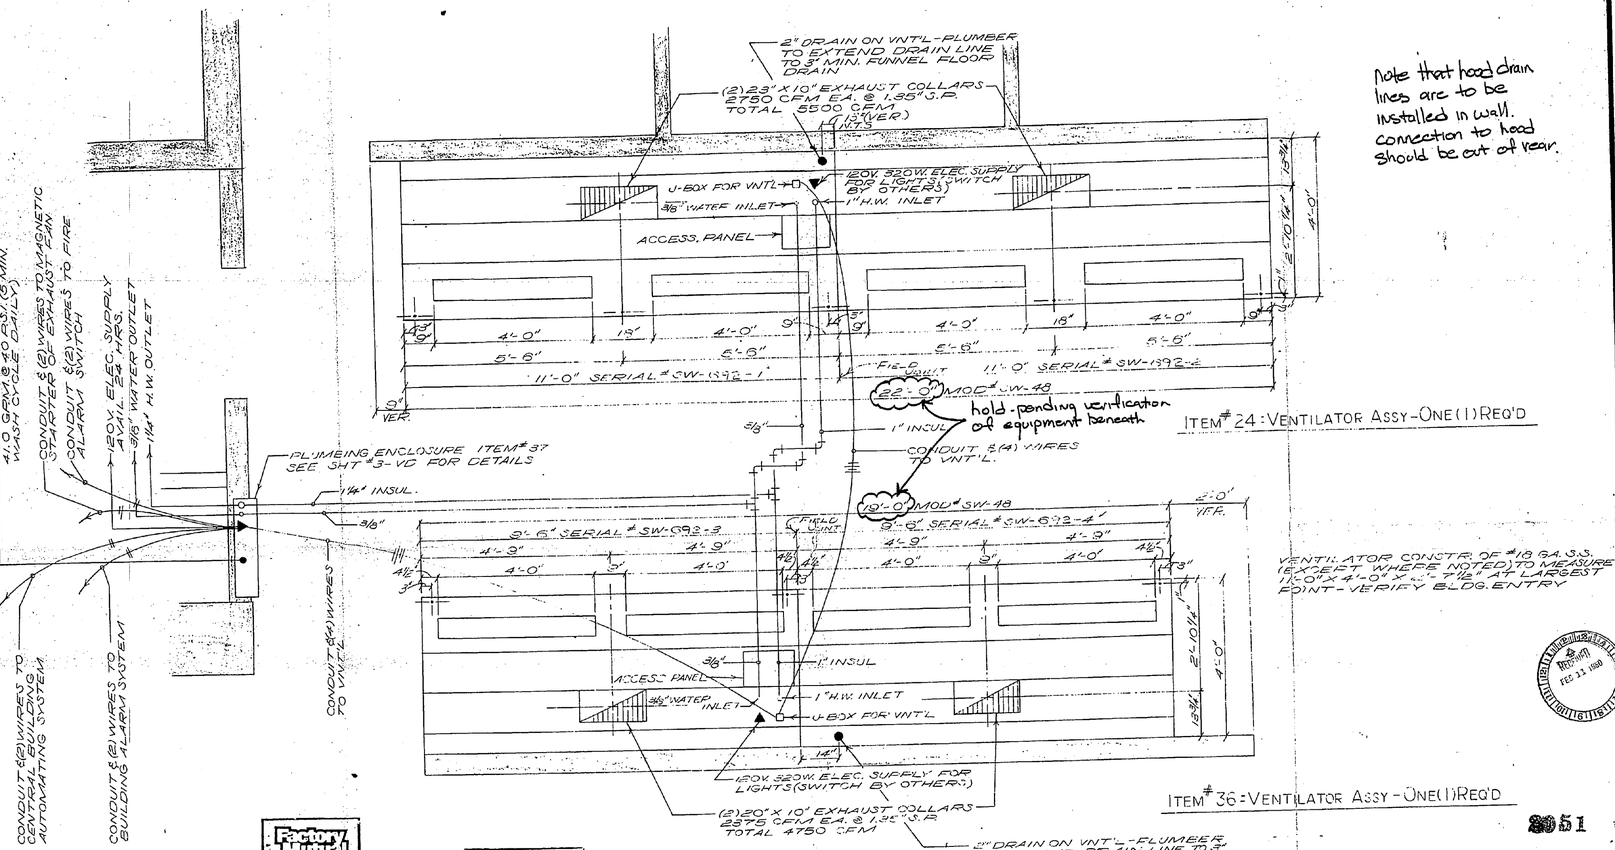

Note that hood drain lines are to be installed in wall. connection to hood should be out of rear.

Factory Mutual System Approved

UL LISTED

NSF THIS SEAL ON OUR EQUIPMENT GUARANTEES ITS COMPLIANCE WITH JOINT INDUSTRY-OFFICIAL HEALTH AGENCY SANITATION STANDARDS THROUGHOUT THE UNITED STATES

N.S.F. LABEL TO BE ATTACHED TO EACH FIXTURE

OK RANGE GUARD SYSTEM

- [x] INCLUDED PIPING ONLY
- [ ] NOT INCLUDED
- [ ] SPECIAL. SEE DETAILS

NORTH & ASSOCIATES INC. 1112 CONVENIENCE DRIVE NAVAL BASE, PORT ROYAL, SC 29035 (803) 897-6500

- [ ] NO CORRECTIONS
- [ ] MAKE CORRECTIONS NOTED
- [x] REVISE AND RESUBMIT
- [ ] REJECTED SEE NOTATIONS

BY fh DATE 1-15-80

ATLANTIC DIVISION NAVAL FACILITIES ENGINEERING COMMAND NORFOLK, VIRGINIA 23511

APPROVED
APPROVED AS NOTED
DISAPPROVED
SUBJECT TO THE REQUIREMENTS OF
CONTRACT NO. N62470-77-C-0755
APPROVAL OF A SUBMITTAL DOES NOT INCLUDE APPROVAL OF ANY DEVIATION FROM THE CONTRACT REQUIREMENTS UNLESS THE CONTRACTOR CALLS ATTENTION TO AND SUBMITS THE DEVIATION. THE CONTRACTOR SHALL BE RESPONSIBLE FOR PROVIDING PROPER PHYSICAL CONNECTIONS, WEIGHTS, COORDINATION OF TRADES, ETC. AS REQUIRED.
DATE 2/1/80
FOR OFFICIAL USE ONLY AT JOB SITE

2051

REVISIONS

DATE	BY	
10-31-79	SEC	REVISED ELEC. CONNS. ON ITEM #24

Seco Products
McGraw-Edison Company
4560 Gustine Avenue
P.O. Box 7116
St. Louis, MO 63177

McGRAW-EDISON Seco®

RECEIVED FEB 11 1980

DATE OCT. 21, 1979
DETAILS OF EQUIPMENT
PROJECT CAMP LEJEUNE NAVAL HOSPITAL CAMP LEJEUNE NORTH CAROLINA
SCALE 3/4" = 1'-0"
DRAWN BY SHELDON GOLDEN
SHEET NO. 1-VD
PROJECT NO. SW-692

QUALITY BLUEPRINT CO. H5106