

# Over Size Form

Too Large

Bound Book

Fragile

Other \_\_\_\_\_

Sheet Number: Profile # 37

Drawing/NAVFAC Number: Profile Y Plotted

Title

Profile Y Plotted

---
















Profile of Water Main from "A" Street (Det. Training Arm) to End of Water Main on River Drive in Officers Quarters.

    

 

*Profile Y  
Notched*







PLAN	DATE
NO.	
PROJECT	
ALIGNED	
DESIGNED	
BY	

PROFILE	DATE
NO.	
PROJECT	
ALIGNED	
DESIGNED	
BY	

PROFILE 8" WATER LINE FROM TENT CAMP No 2 TO OPERATIONS BUILDING - AIR PORT

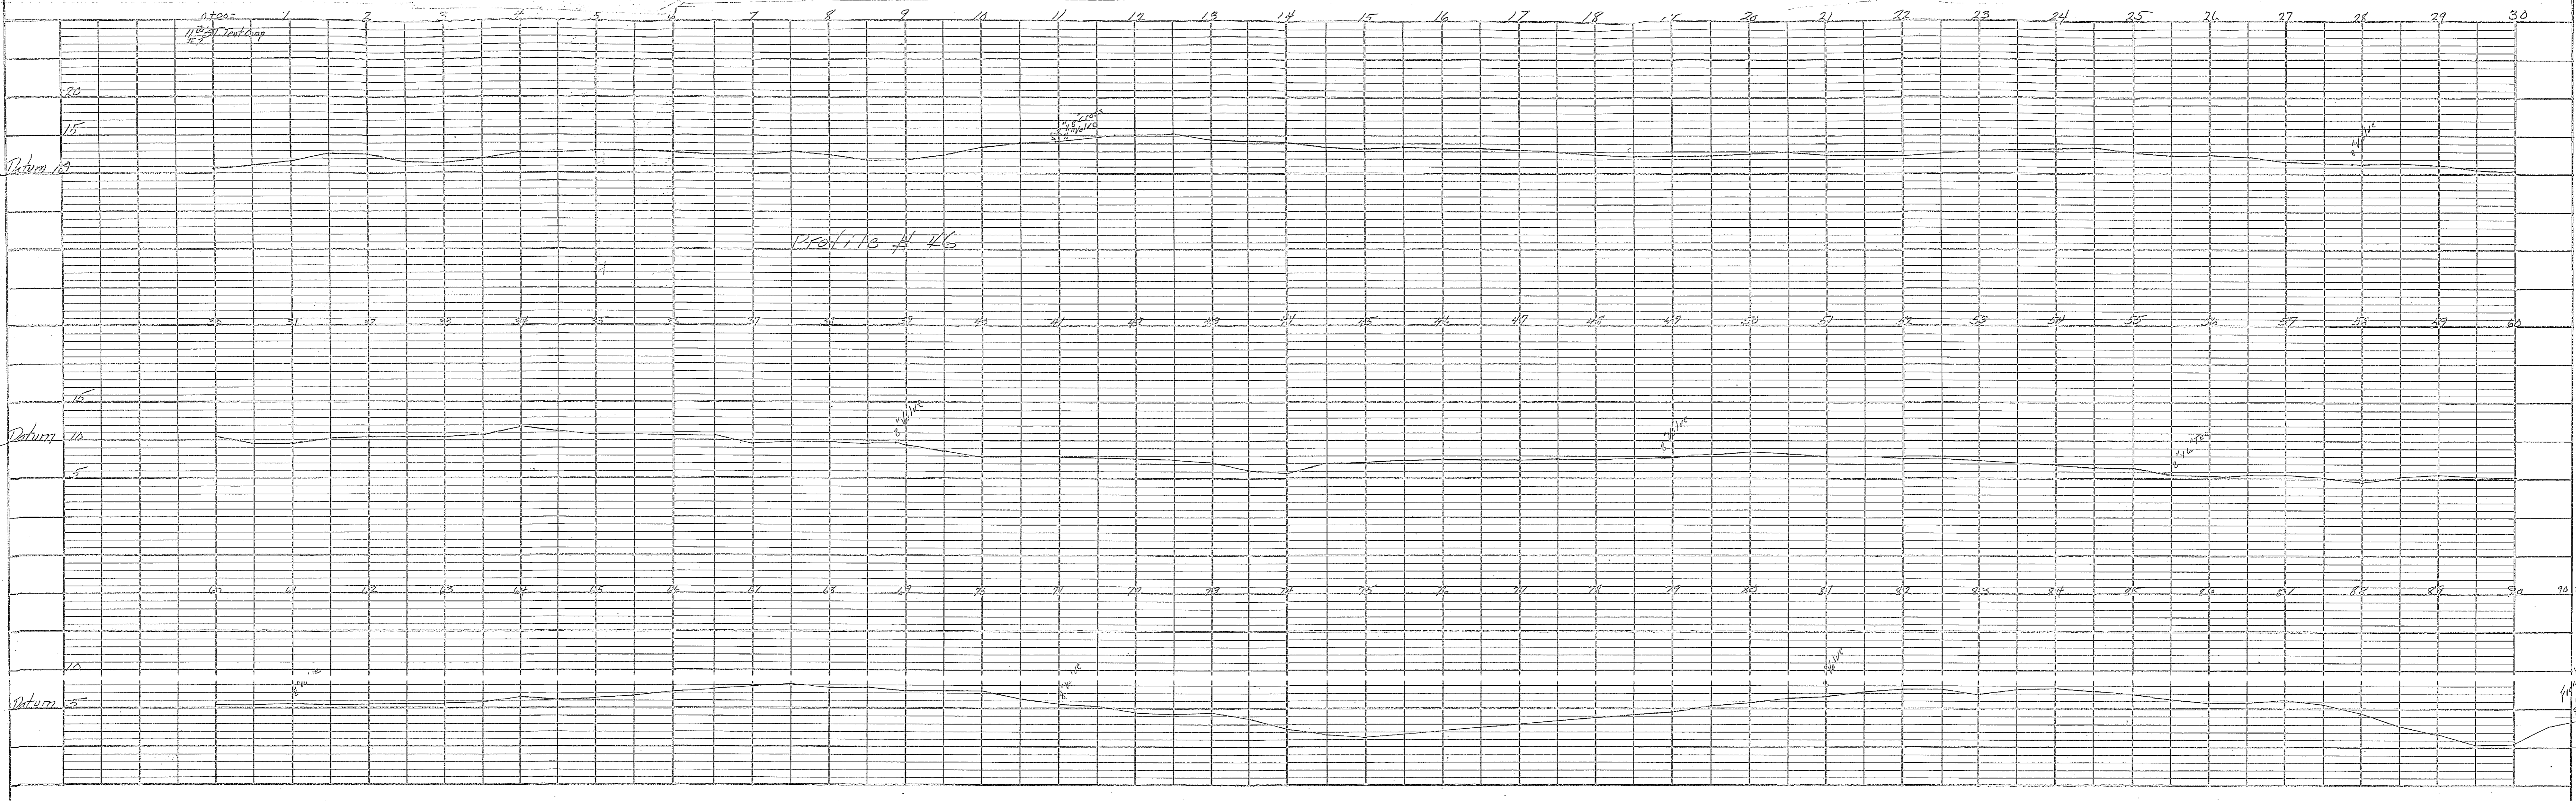




DATE	
BY	
PROJECT	
DATE CHECKED	
BY	
NO.	


DATE	
BY	
PROJECT	
DATE CHECKED	
BY	
NO.	

Profile #58

Profile of 4" and 8" Water Line from Airport Road to Tank Amph. Base (Peterfield Point also Water Line in Tank Amph. Base)

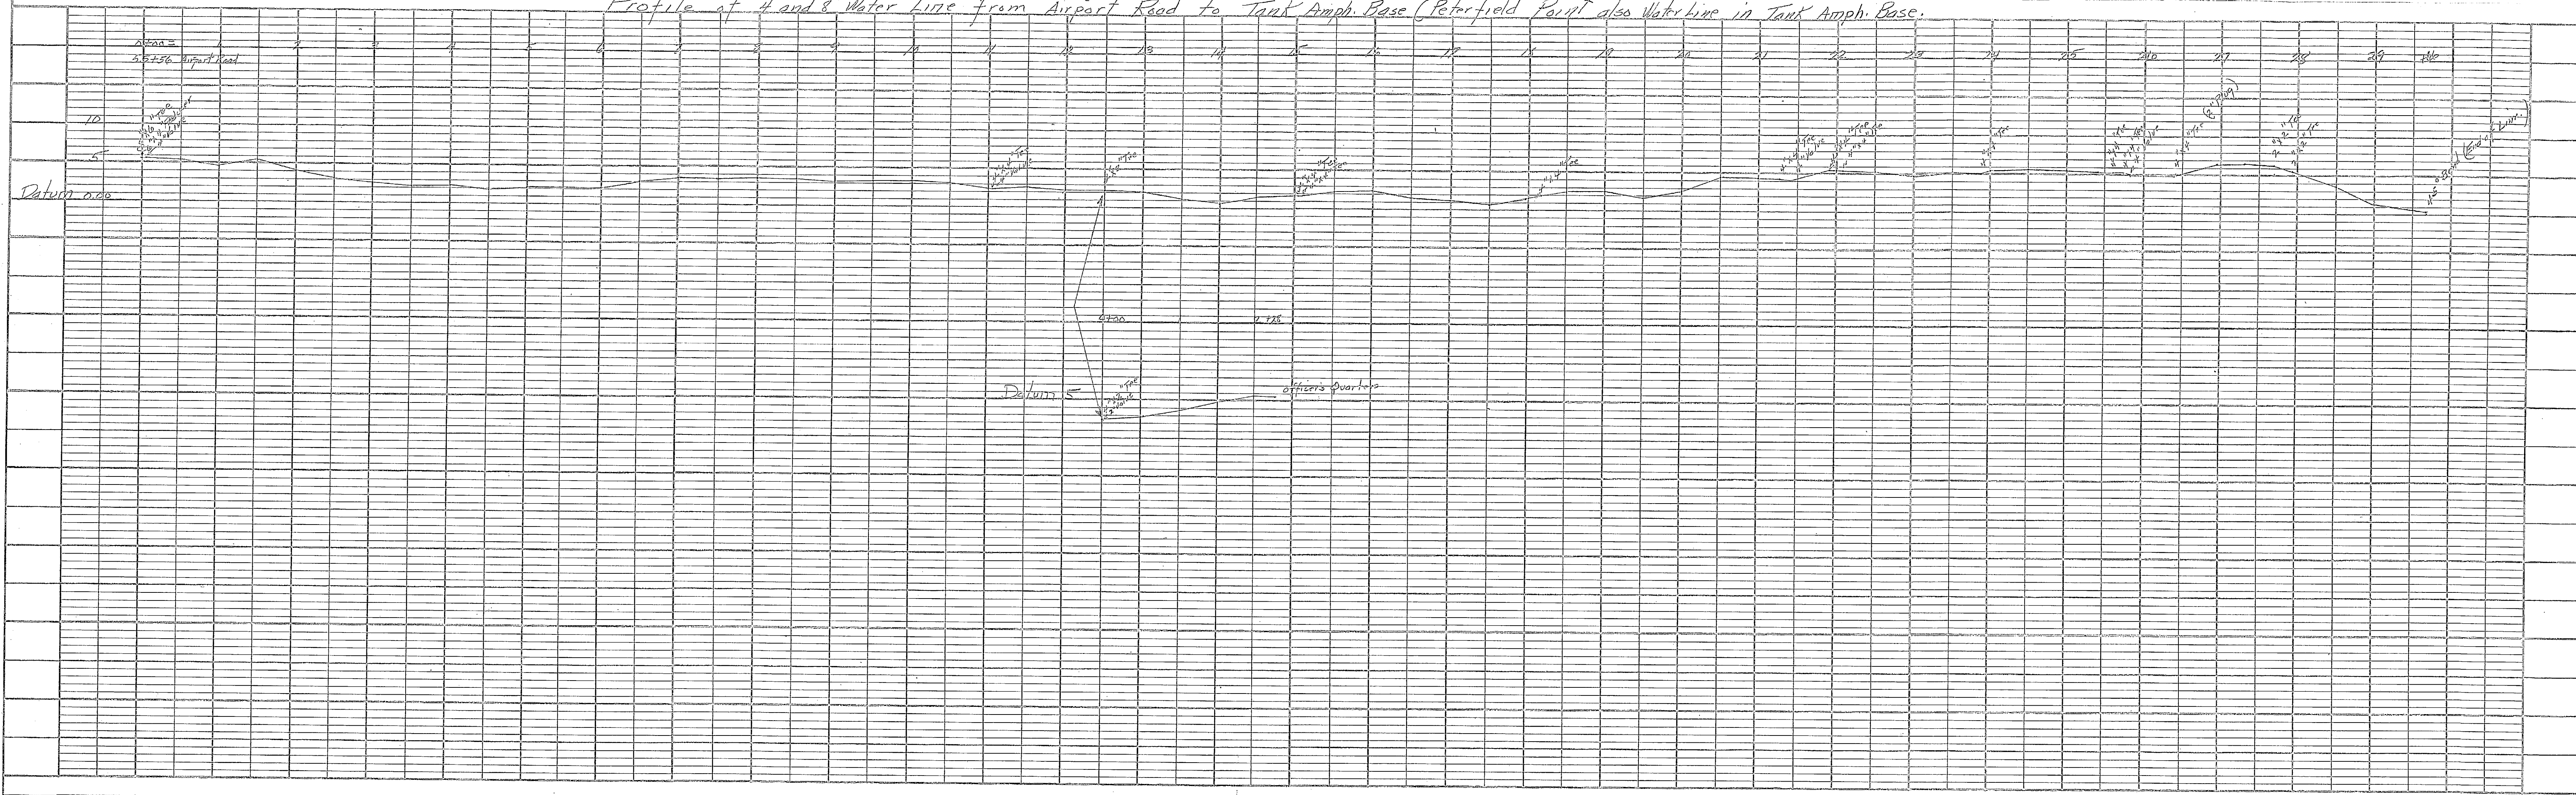



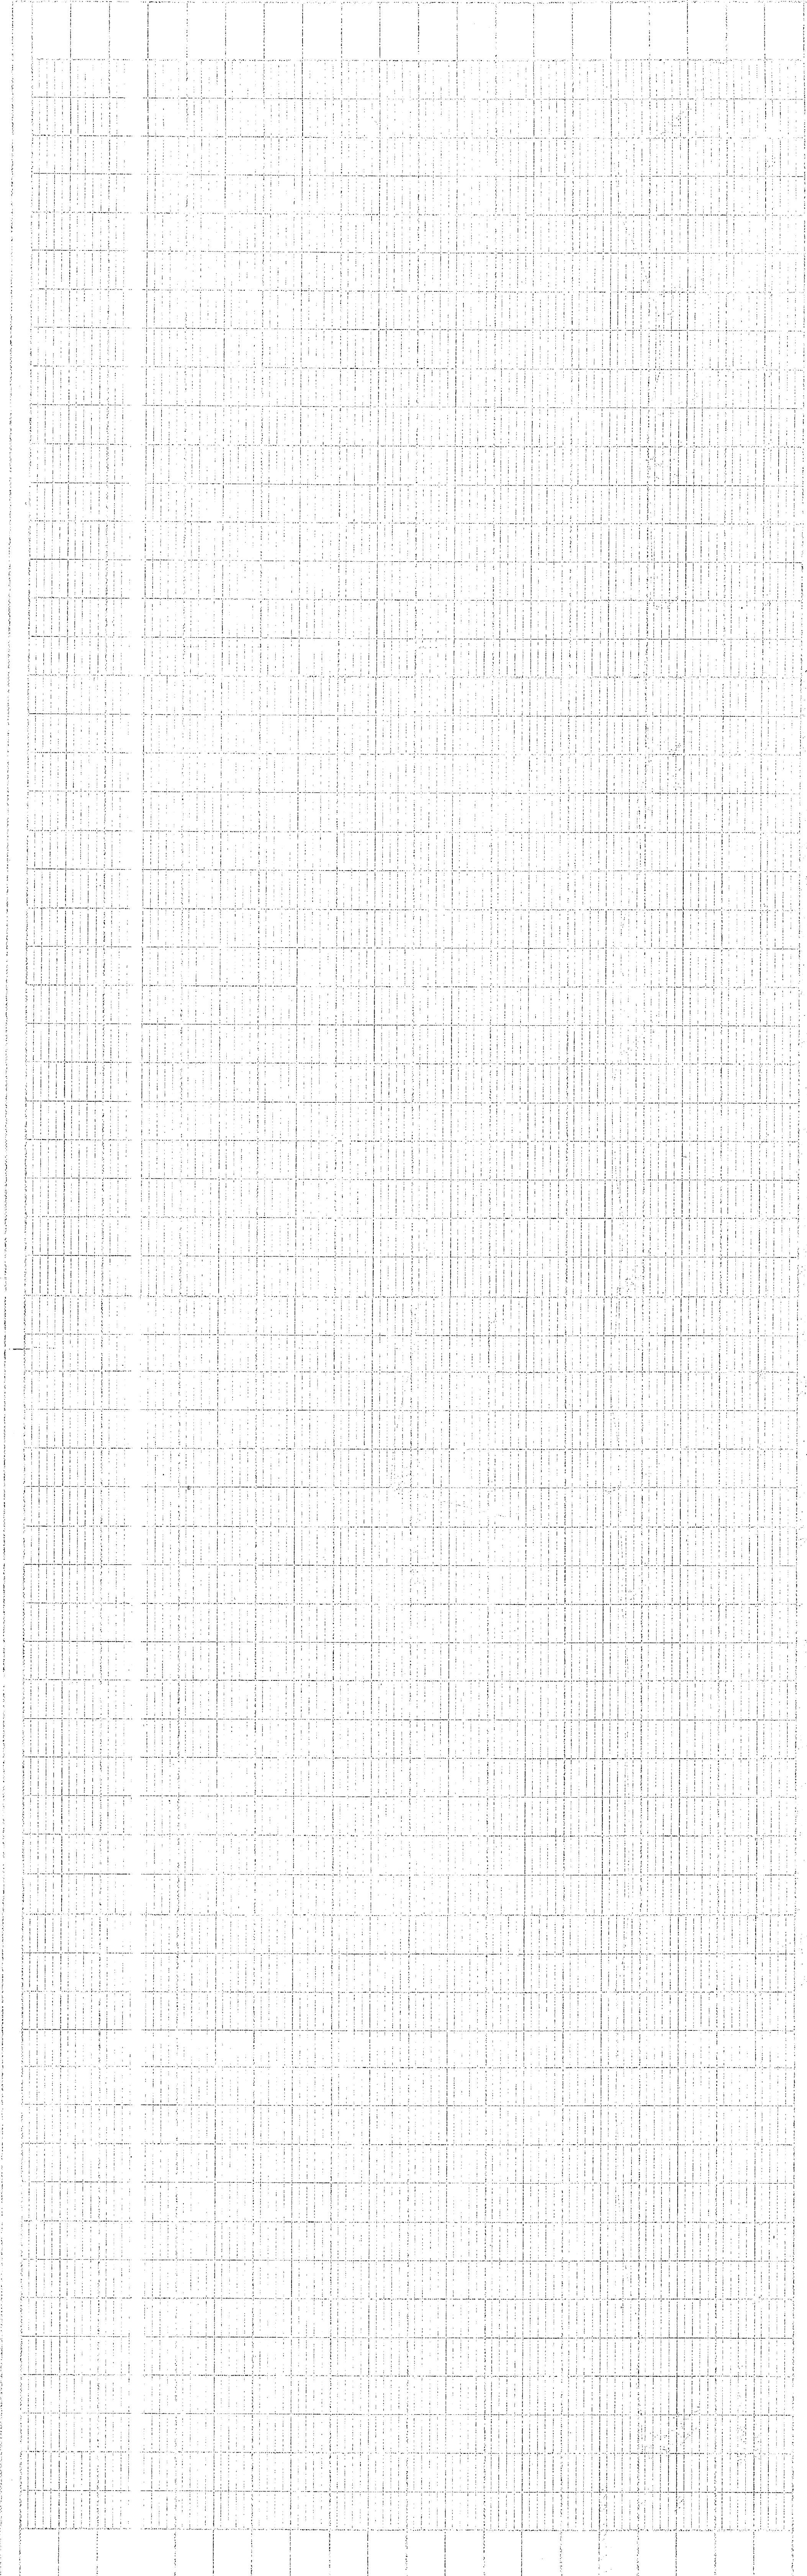

*Profile AA*  
*To Peterfield Point*  
*Plotted*

DATE	1954
BY	...
SCALE	...
PROJECT	...


DATE	1954
BY	...
SCALE	...
PROJECT	...

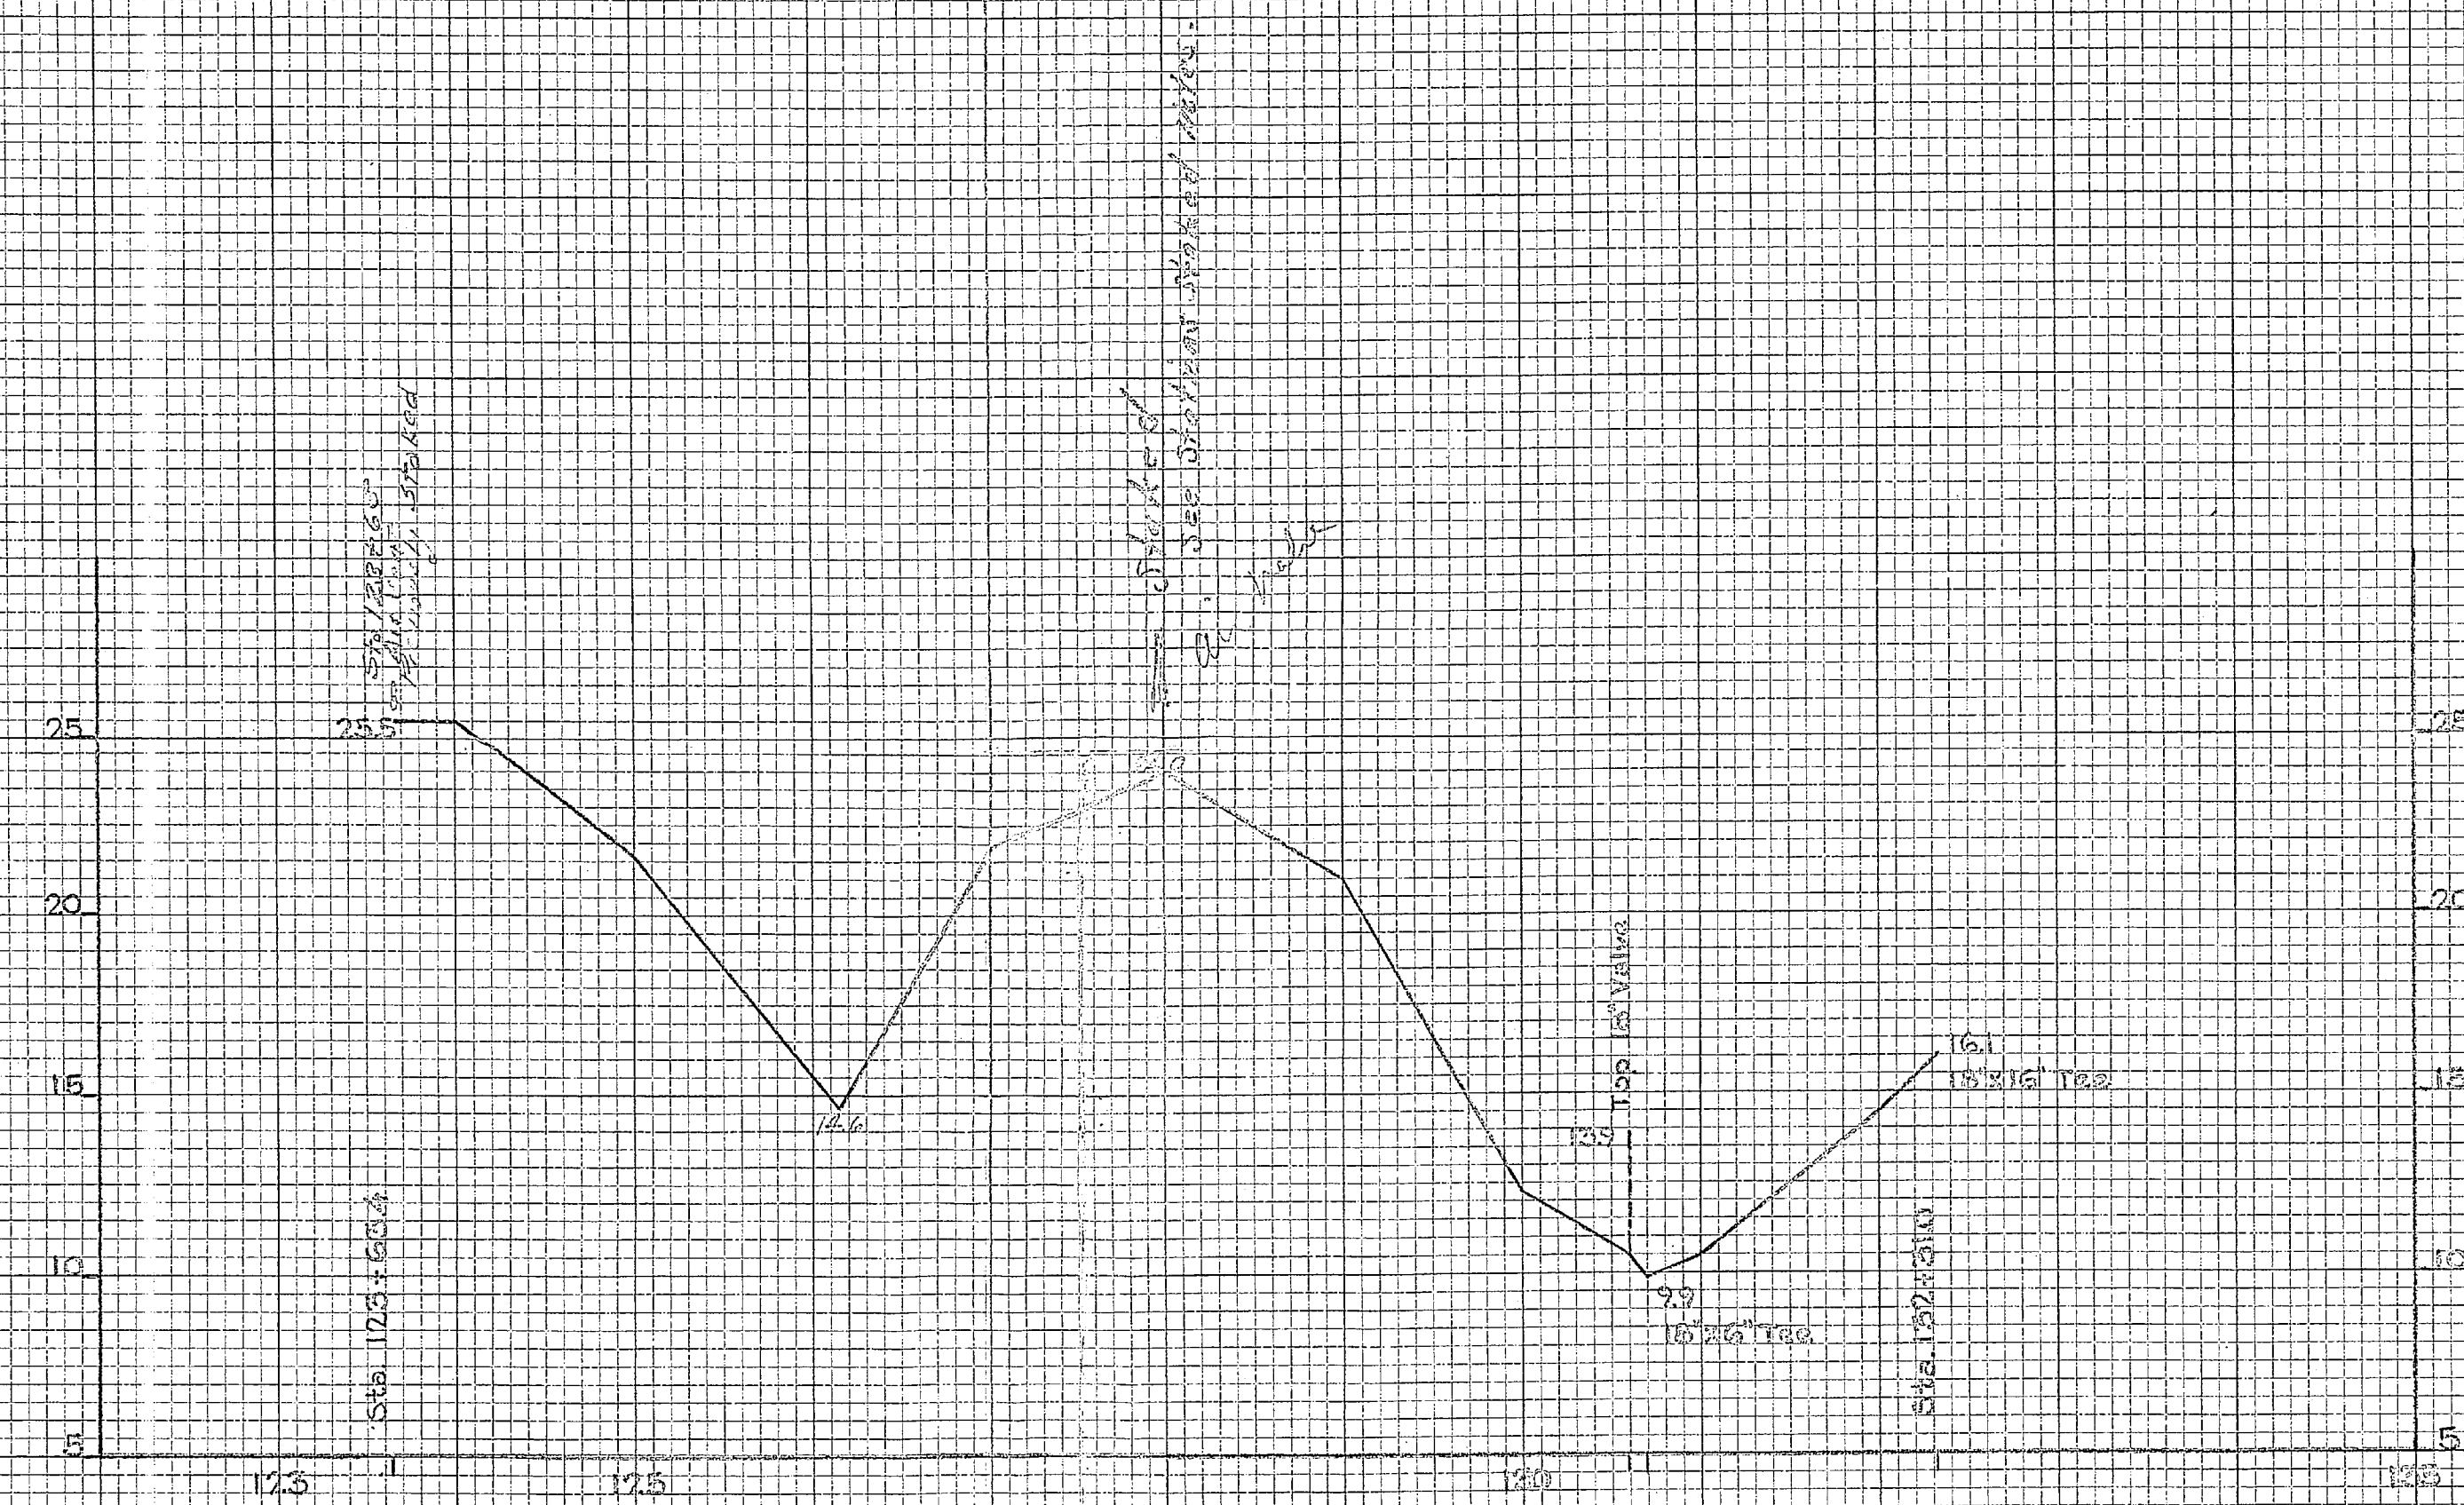


PROFILE "E. I."  
 18" TRANSIT WATER LINE  
 STA. 123+62.4 TO 125+12.5

Scale 1" = 100' Horiz.  
 1" = 5' Vertical



 

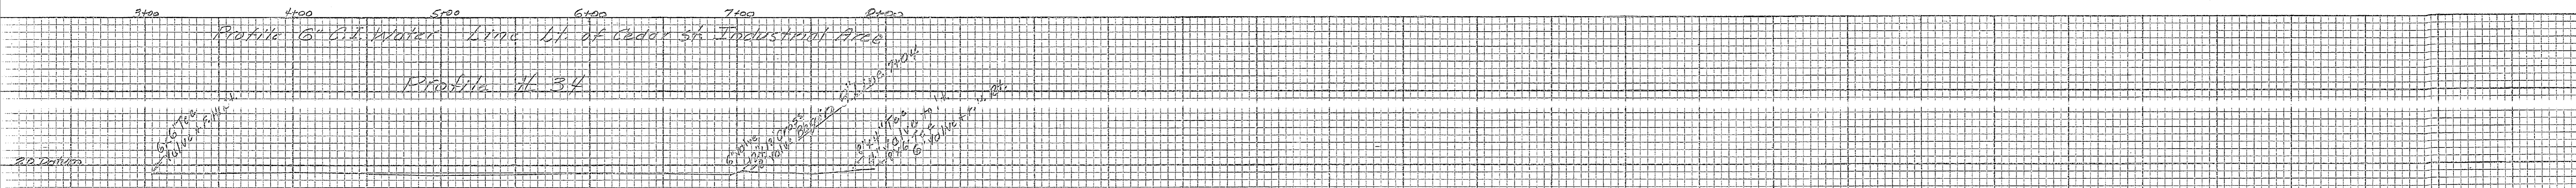

Industrial Area

PROFILE F

Plotted



100%  




Area #5

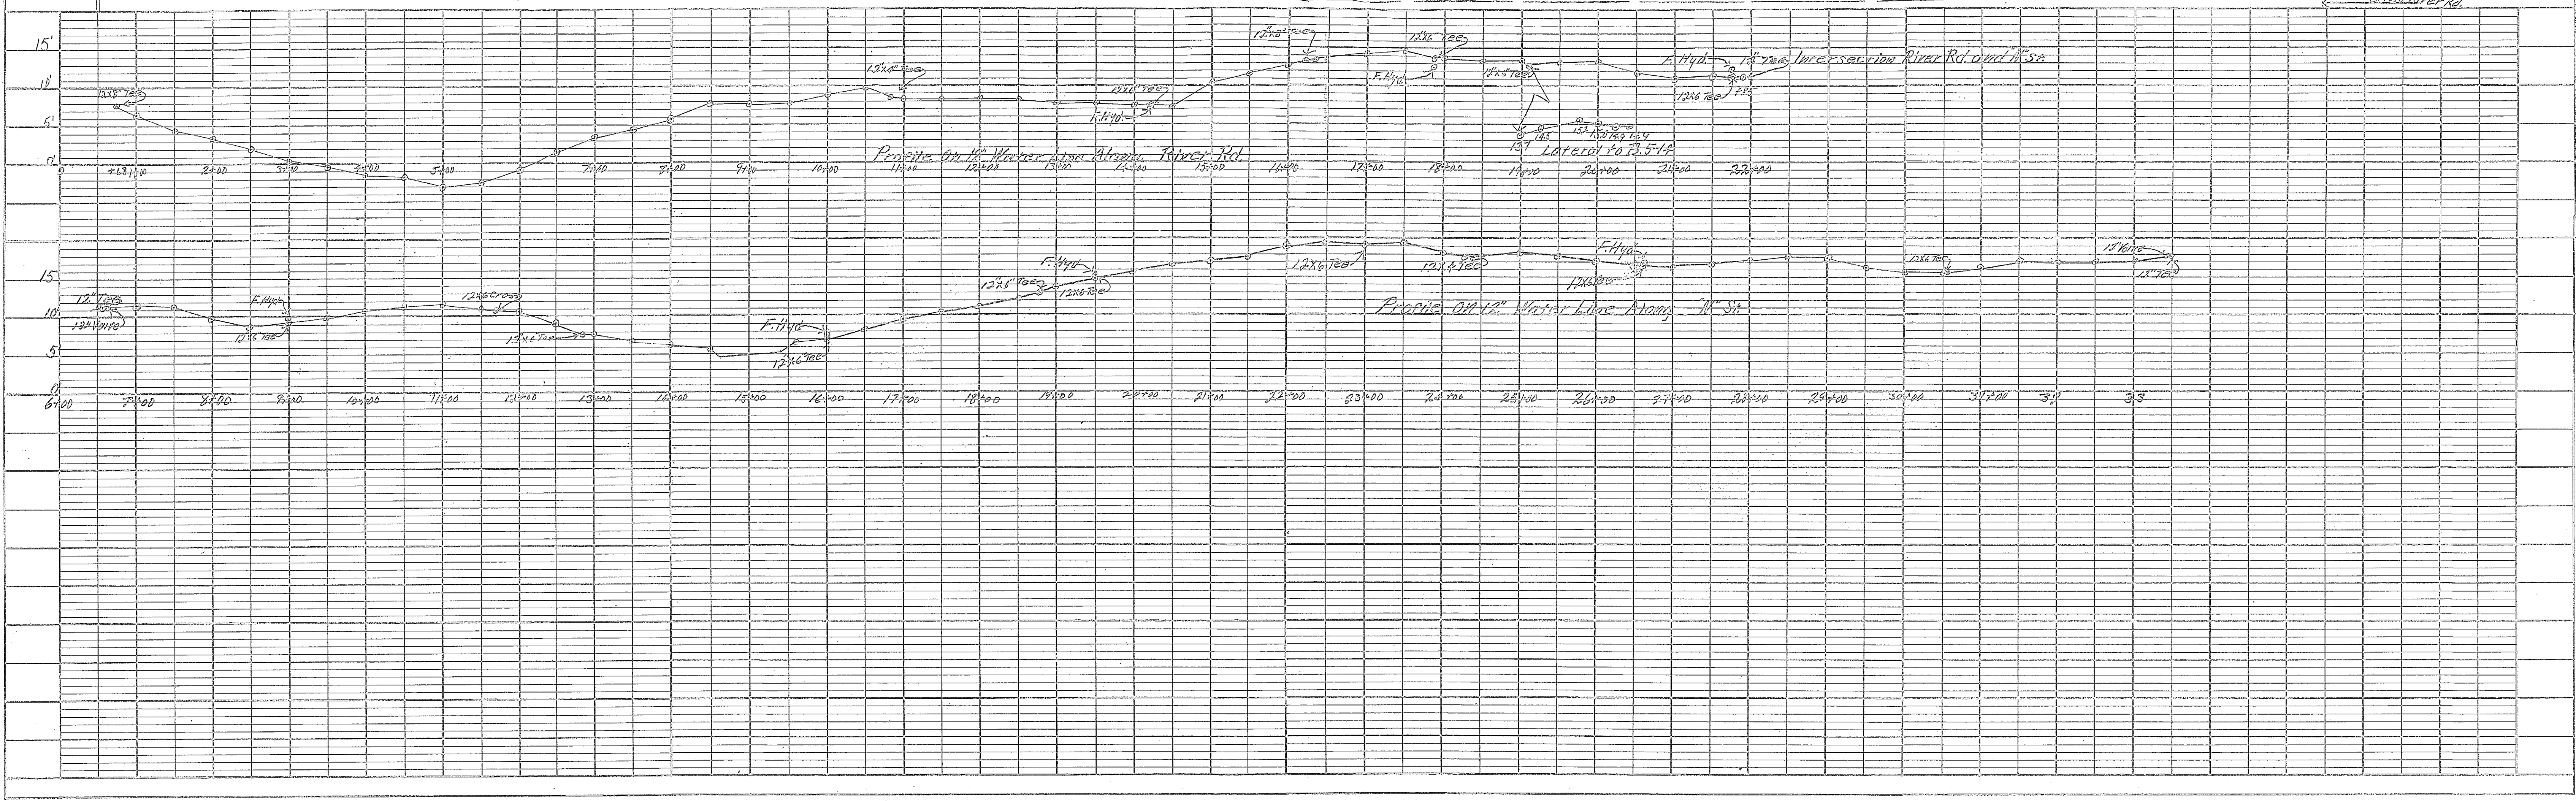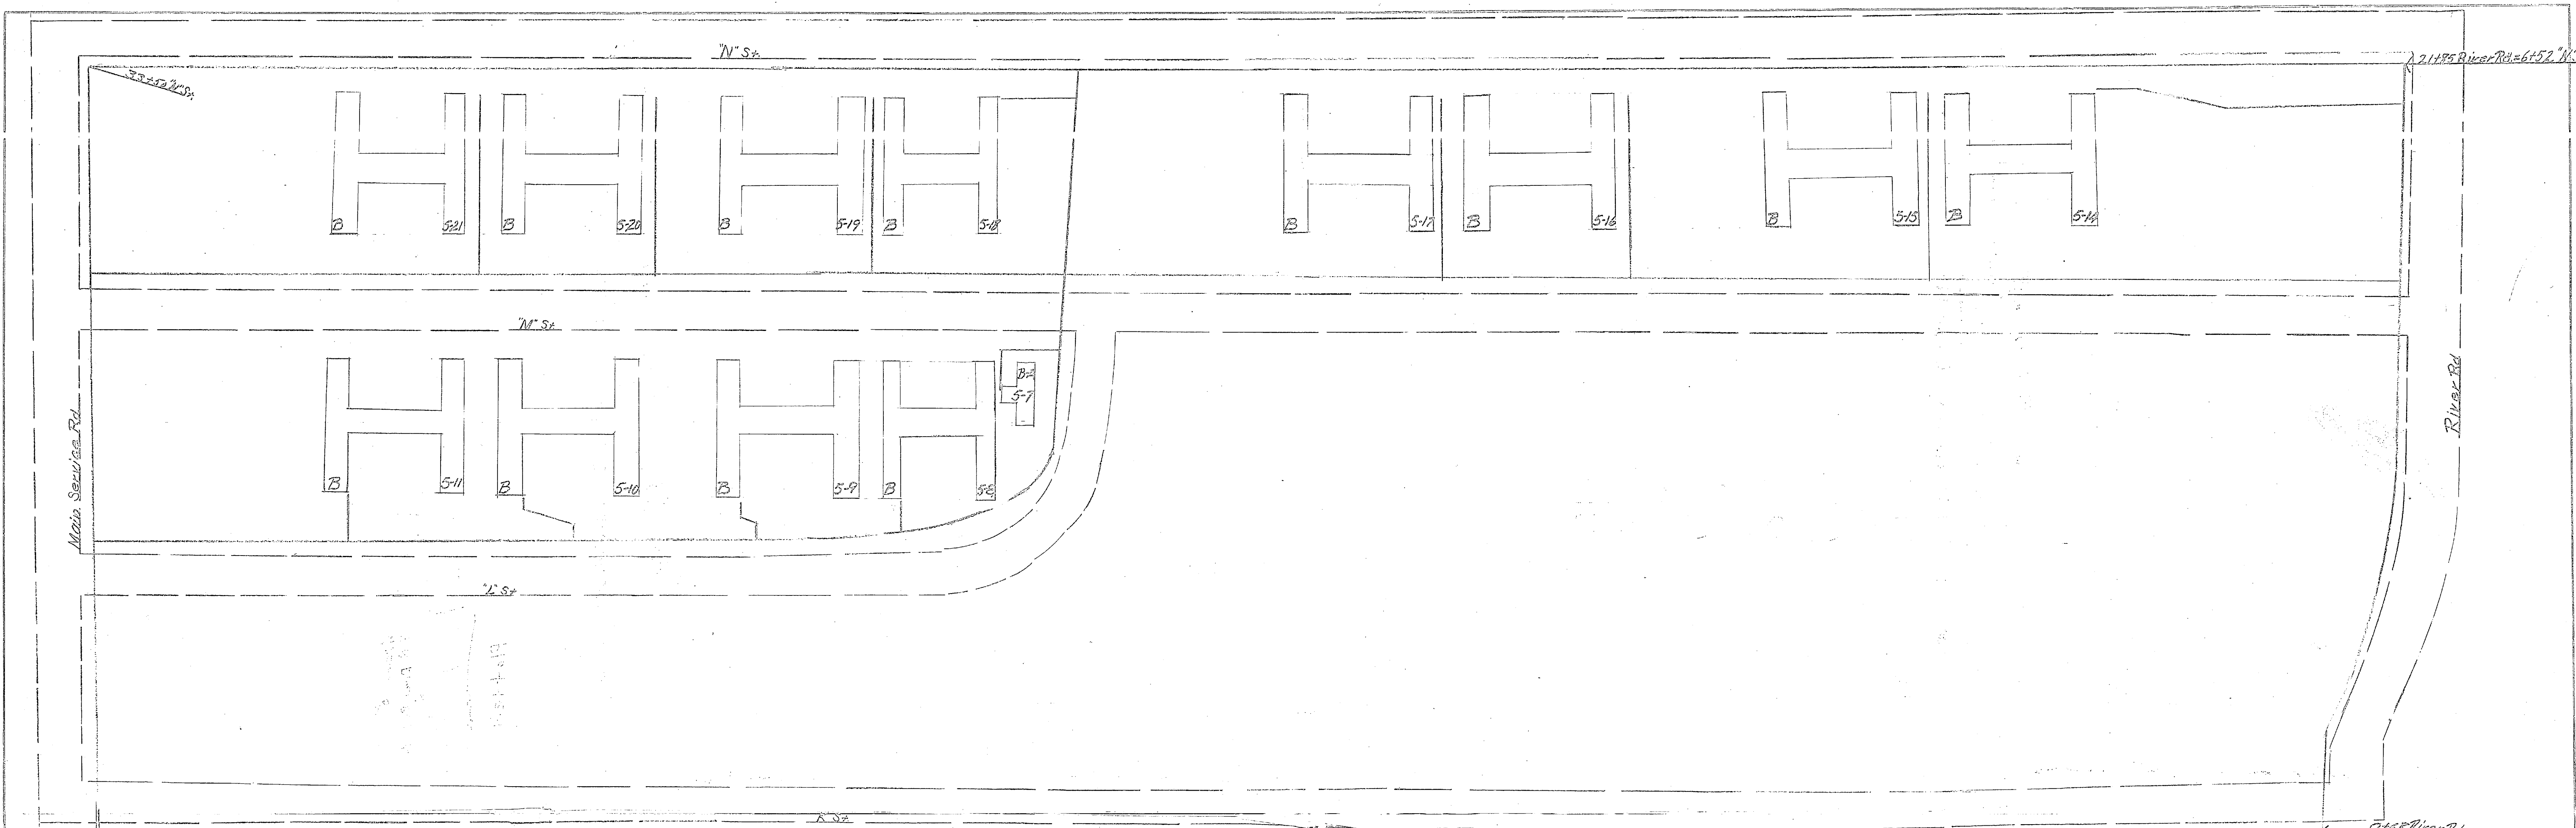

DATE	
BY	
PROJECT	ALBANY WATER SYSTEM
PLANNED	
APPROVED	
BY	
DATE	

DATE	
BY	
PROJECT	ALBANY WATER SYSTEM
PLANNED	
APPROVED	
BY	
DATE	






DATE	NO.	DESCRIPTION	BY

DATE	NO.	DESCRIPTION	BY

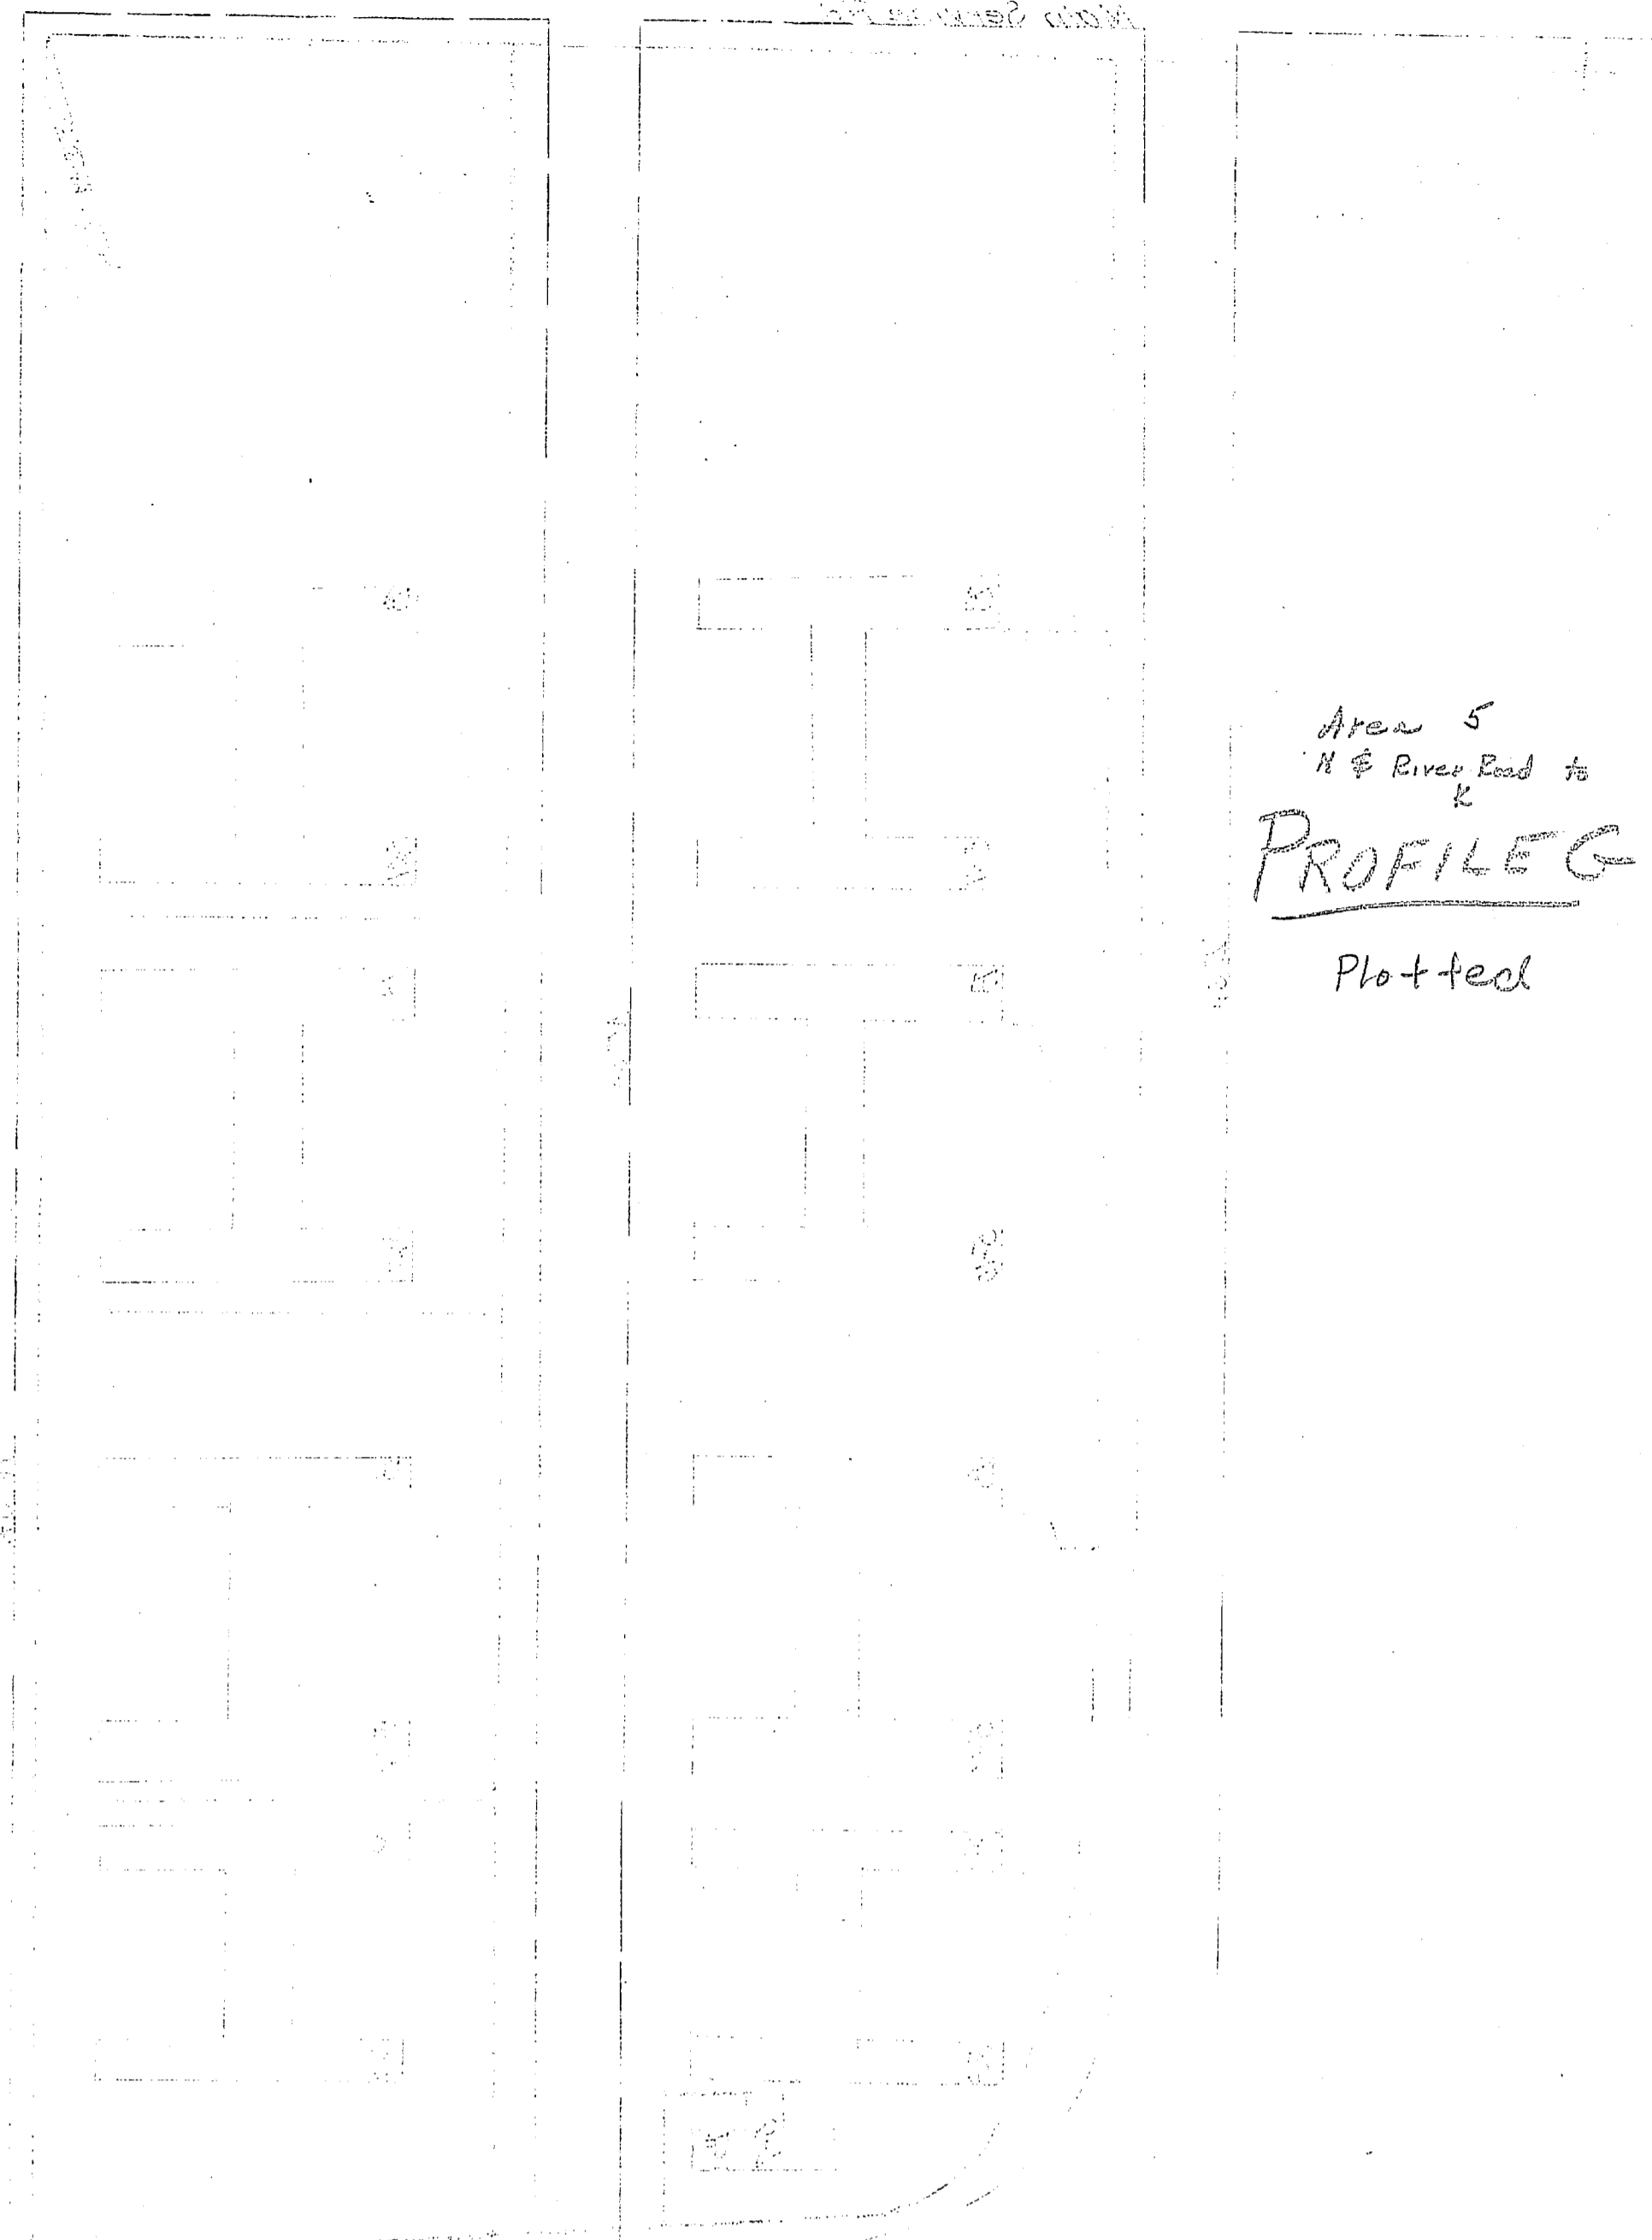



Area 5  
 11 & River Road to  
 K  
**PROFILE**  
 Plotted

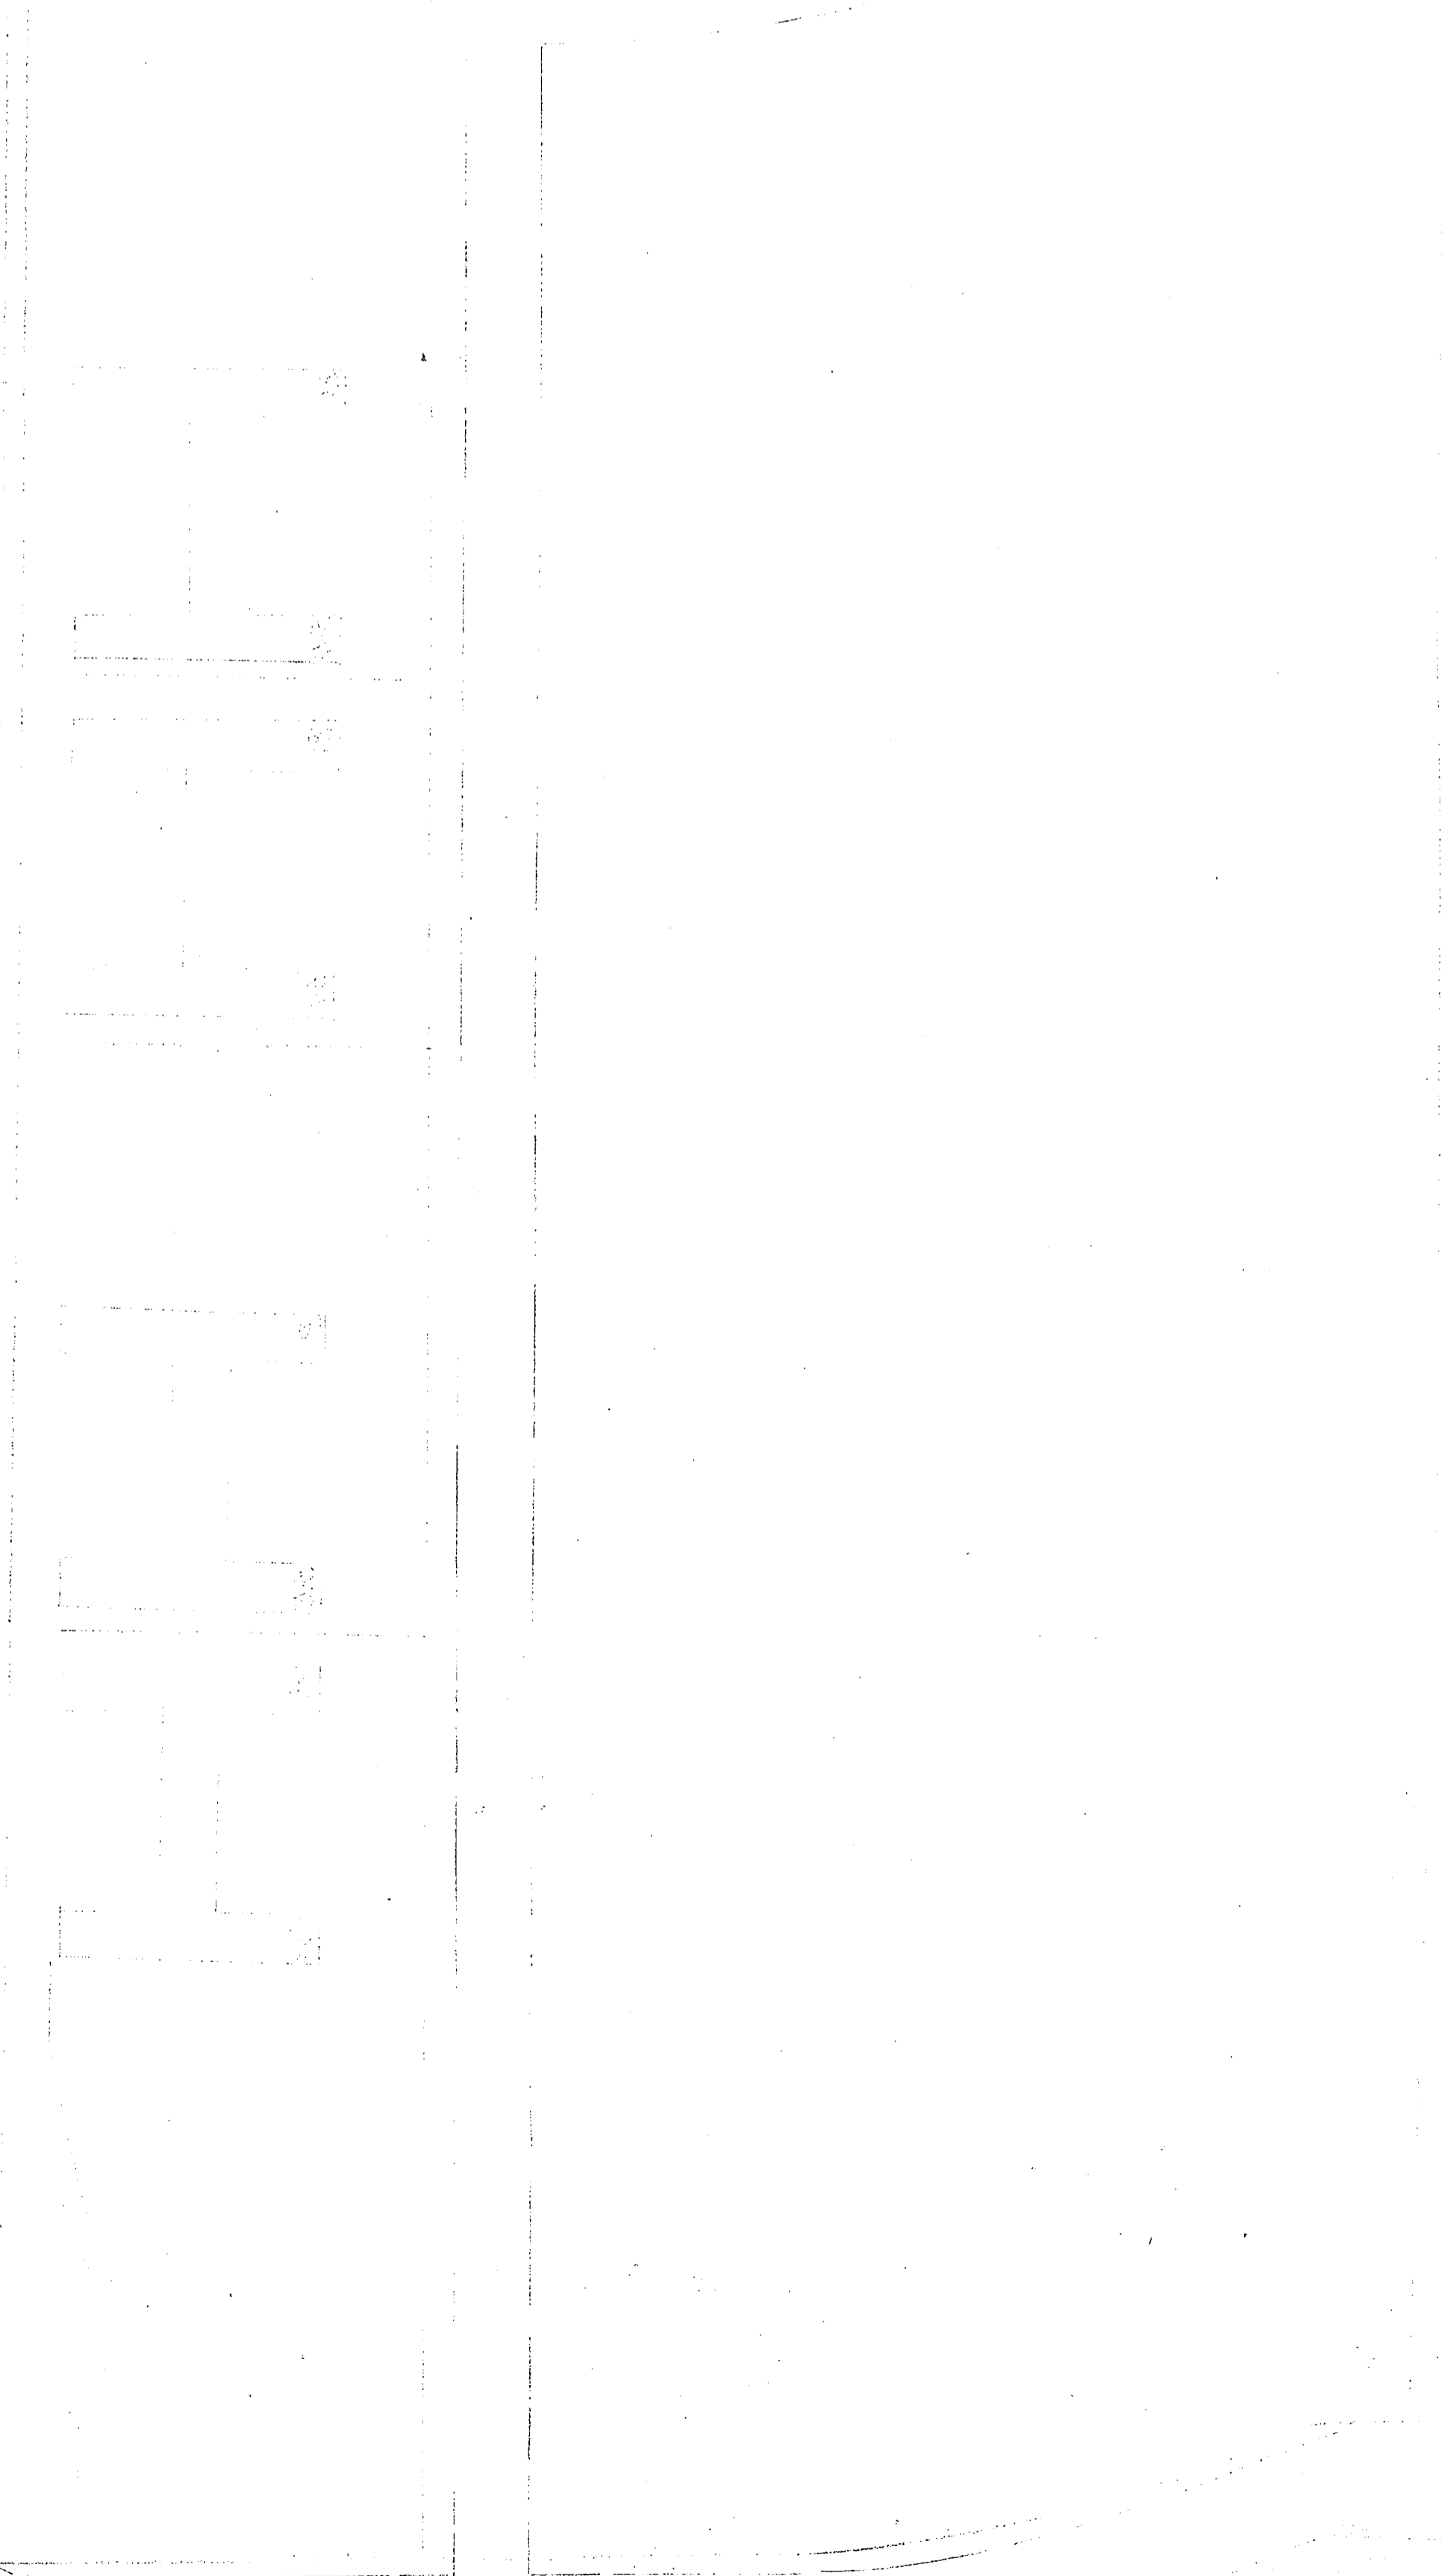





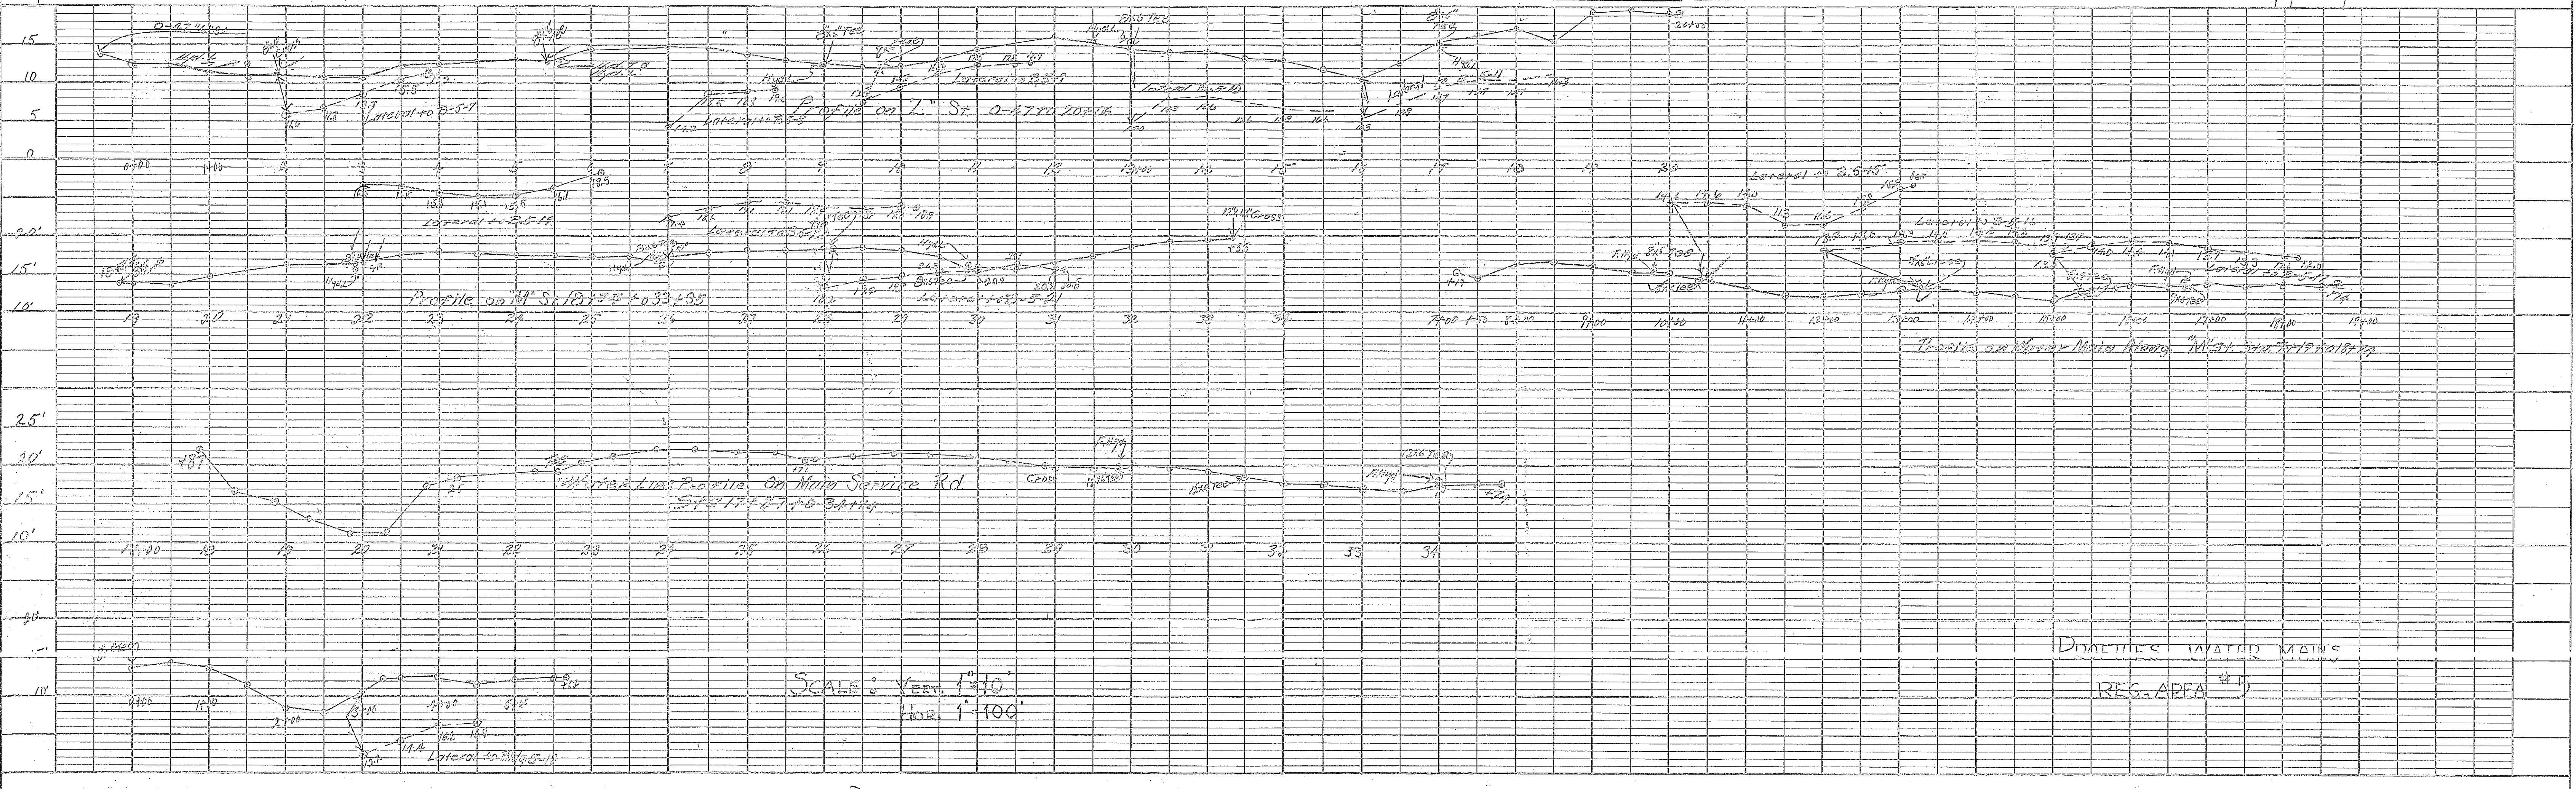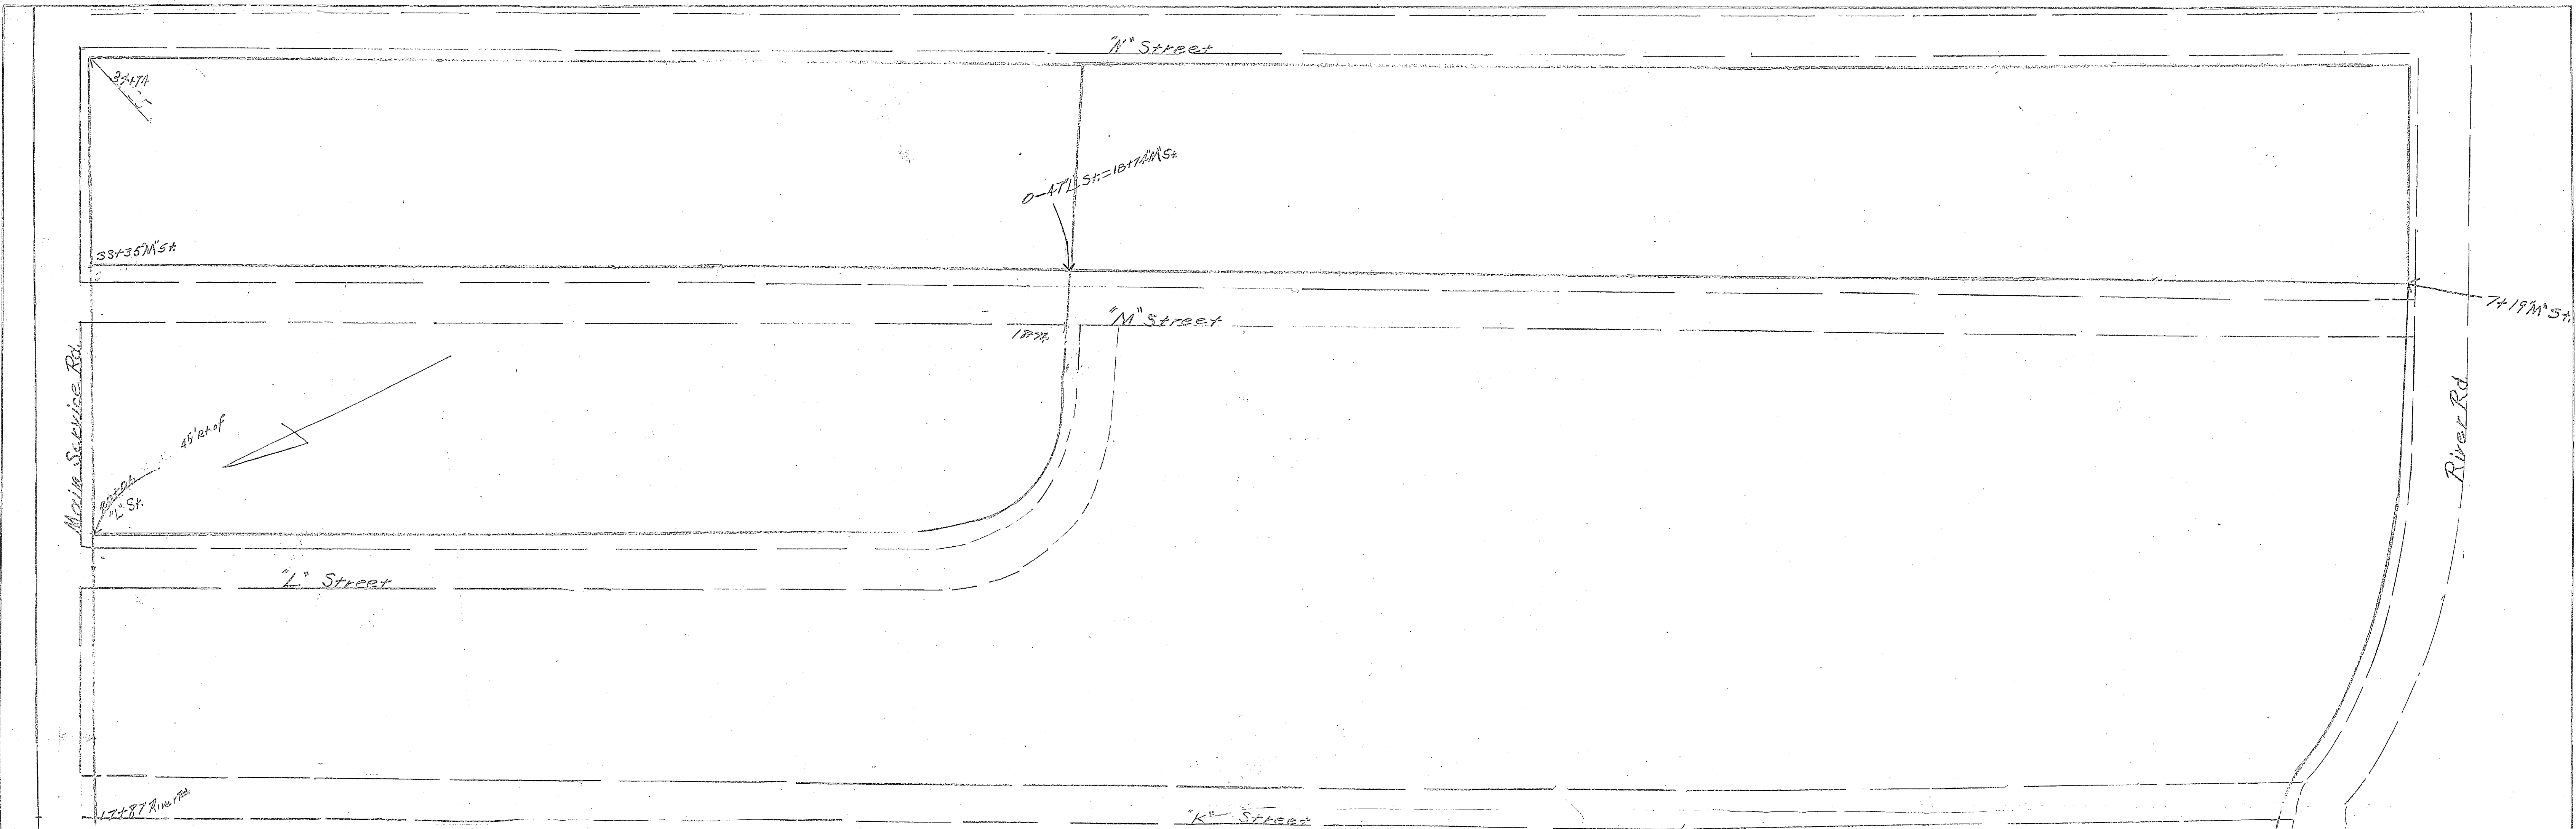


SCALE: VERT. 1"=10'  
HORIZ. 1"=100'

DYNAMIC WATER MARKS  
REG. AREA #1

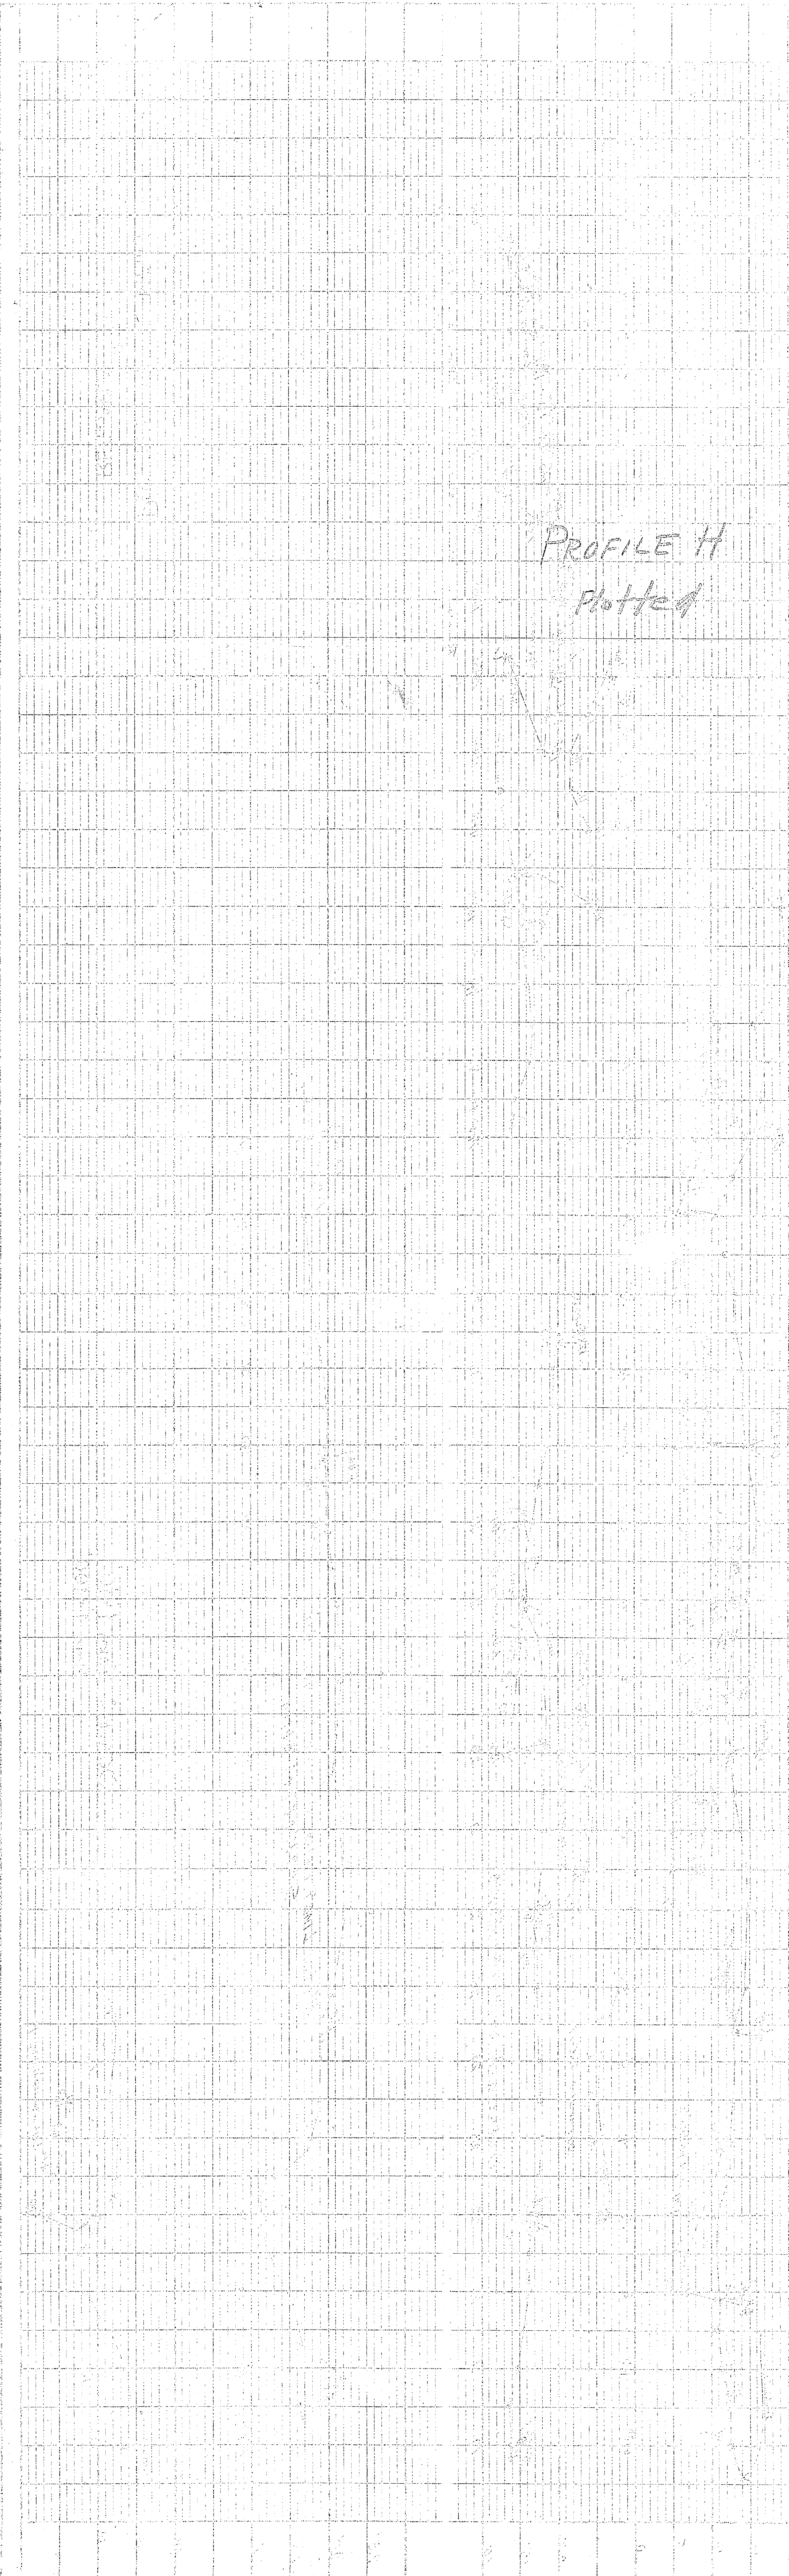

PROFILE H  
Plotted

 

DATE	DESCRIPTION	BY	CHECKED

DATE	DESCRIPTION	BY	CHECKED

# Over Size Form

Too Large

Bound Book

Fragile

Other \_\_\_\_\_

Sheet Number: \_\_\_\_\_

Drawing/NAVFAC Number: Profile 'GG'

## Title

Profile G-G

Water Line: Main Access Rd

Wells 5,6,7,8 & 9      Item 278

Navy Notes 2/24/43

---

---

---

---

---

---


---

---

---

---



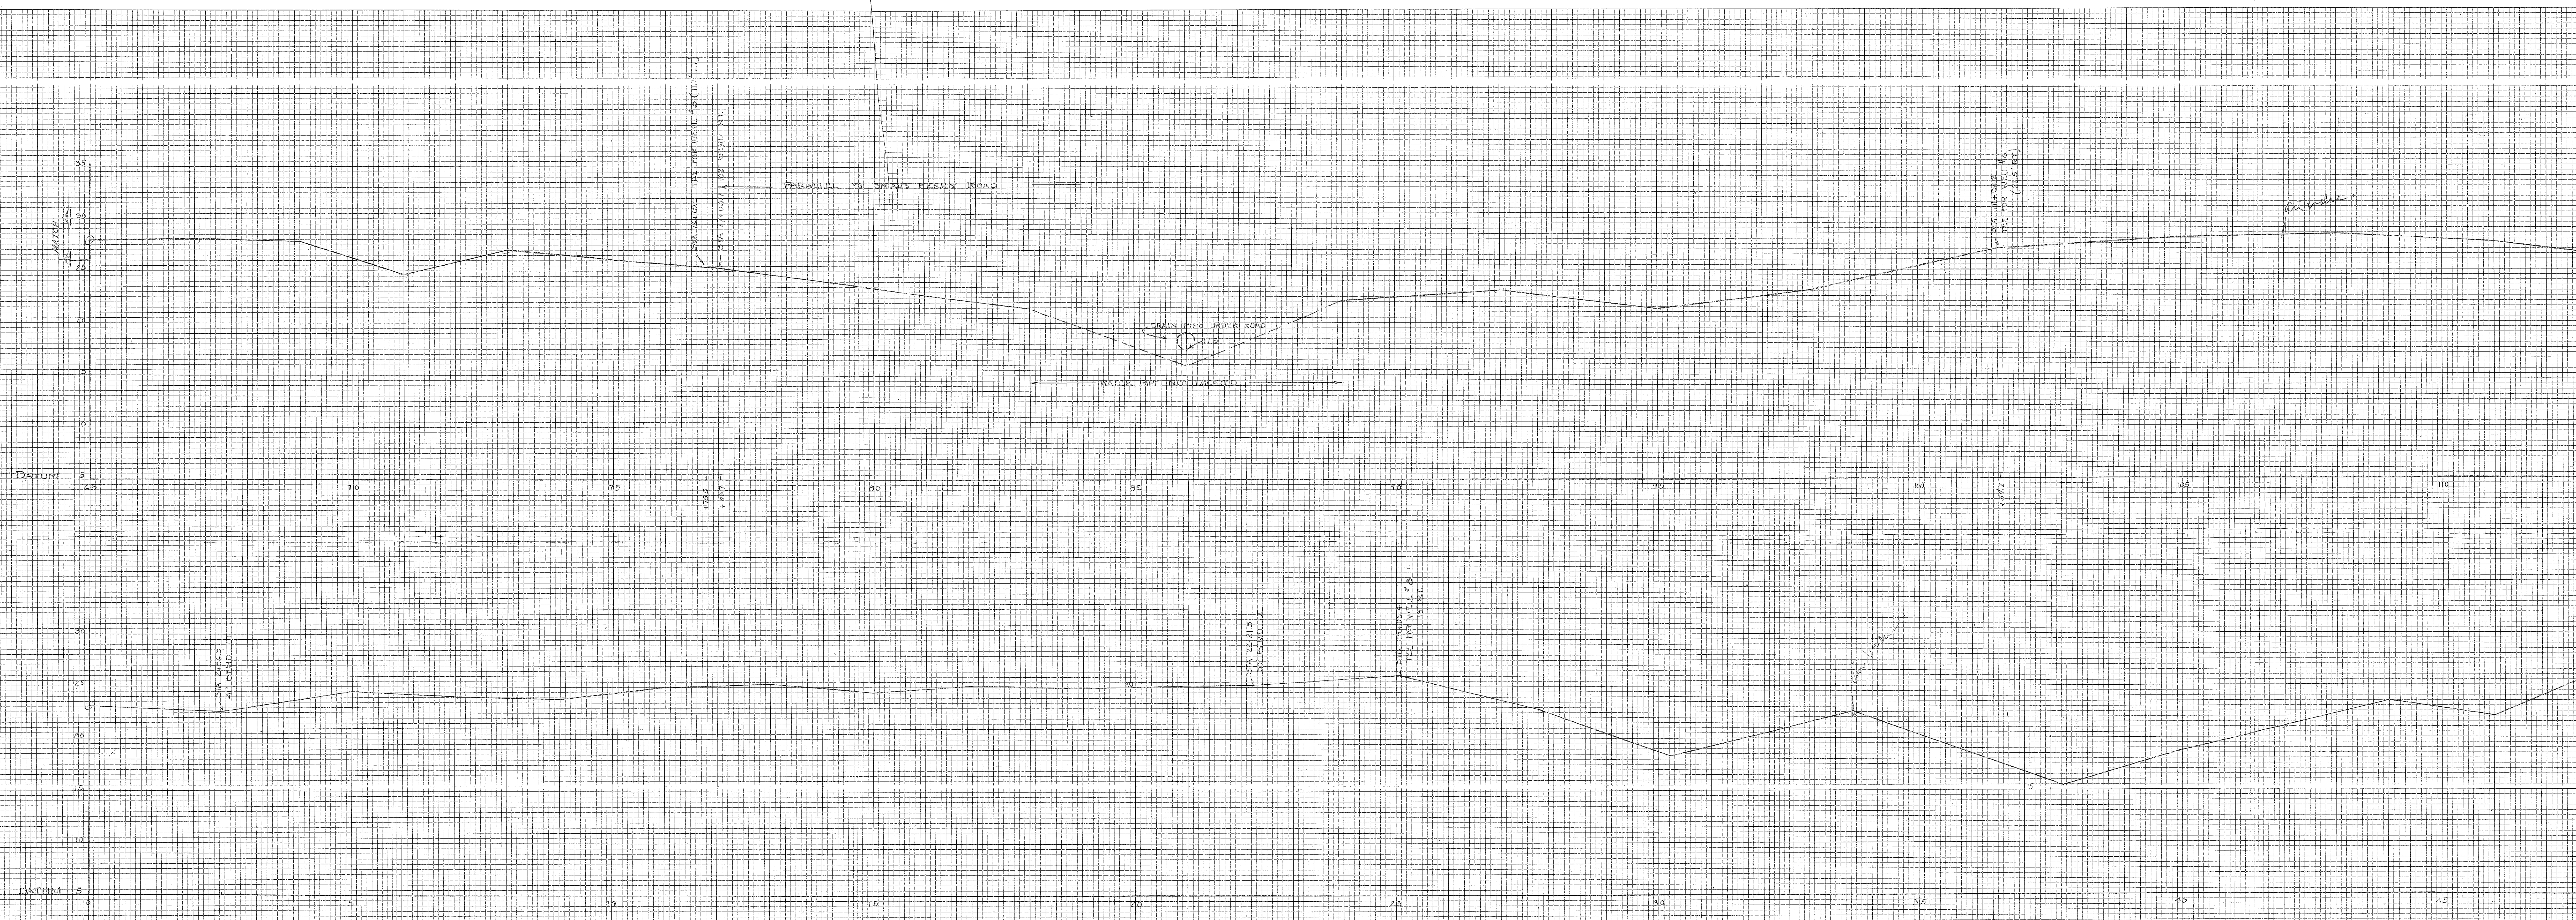

PROFILE "G-G"  
 WATER LINE: MAIN ACCESS RD  
 (SEE SECTION 10)  
 WELLS: 5, 6, 7, 8, 9  
 SCALE: 1" = 10' HORIZ.  
 1" = 5' VERT.  
 DRAWN BY: MARY HIGGINS  
 2/16/43

USE ONLY  
FOR  
DRAWING PURPOSES  
NOT TO BE USED  
FOR CONSTRUCTION


USE ONLY  
FOR  
DRAWING PURPOSES  
NOT TO BE USED  
FOR CONSTRUCTION

 

Profile "G-G"

PROFILE		BY	DATE
SURVEYED			
NOTE BOOK			
GRADES CHECKED			
BY NO. NOTED			
STRUCTURE NOTATIONS CHECKED			

PLAN		BY	DATE
SURVEYED			
NOTE BOOK			
GRADES CHECKED			
BY NO. NOTED			
STRUCTURE NOTATIONS CHECKED			

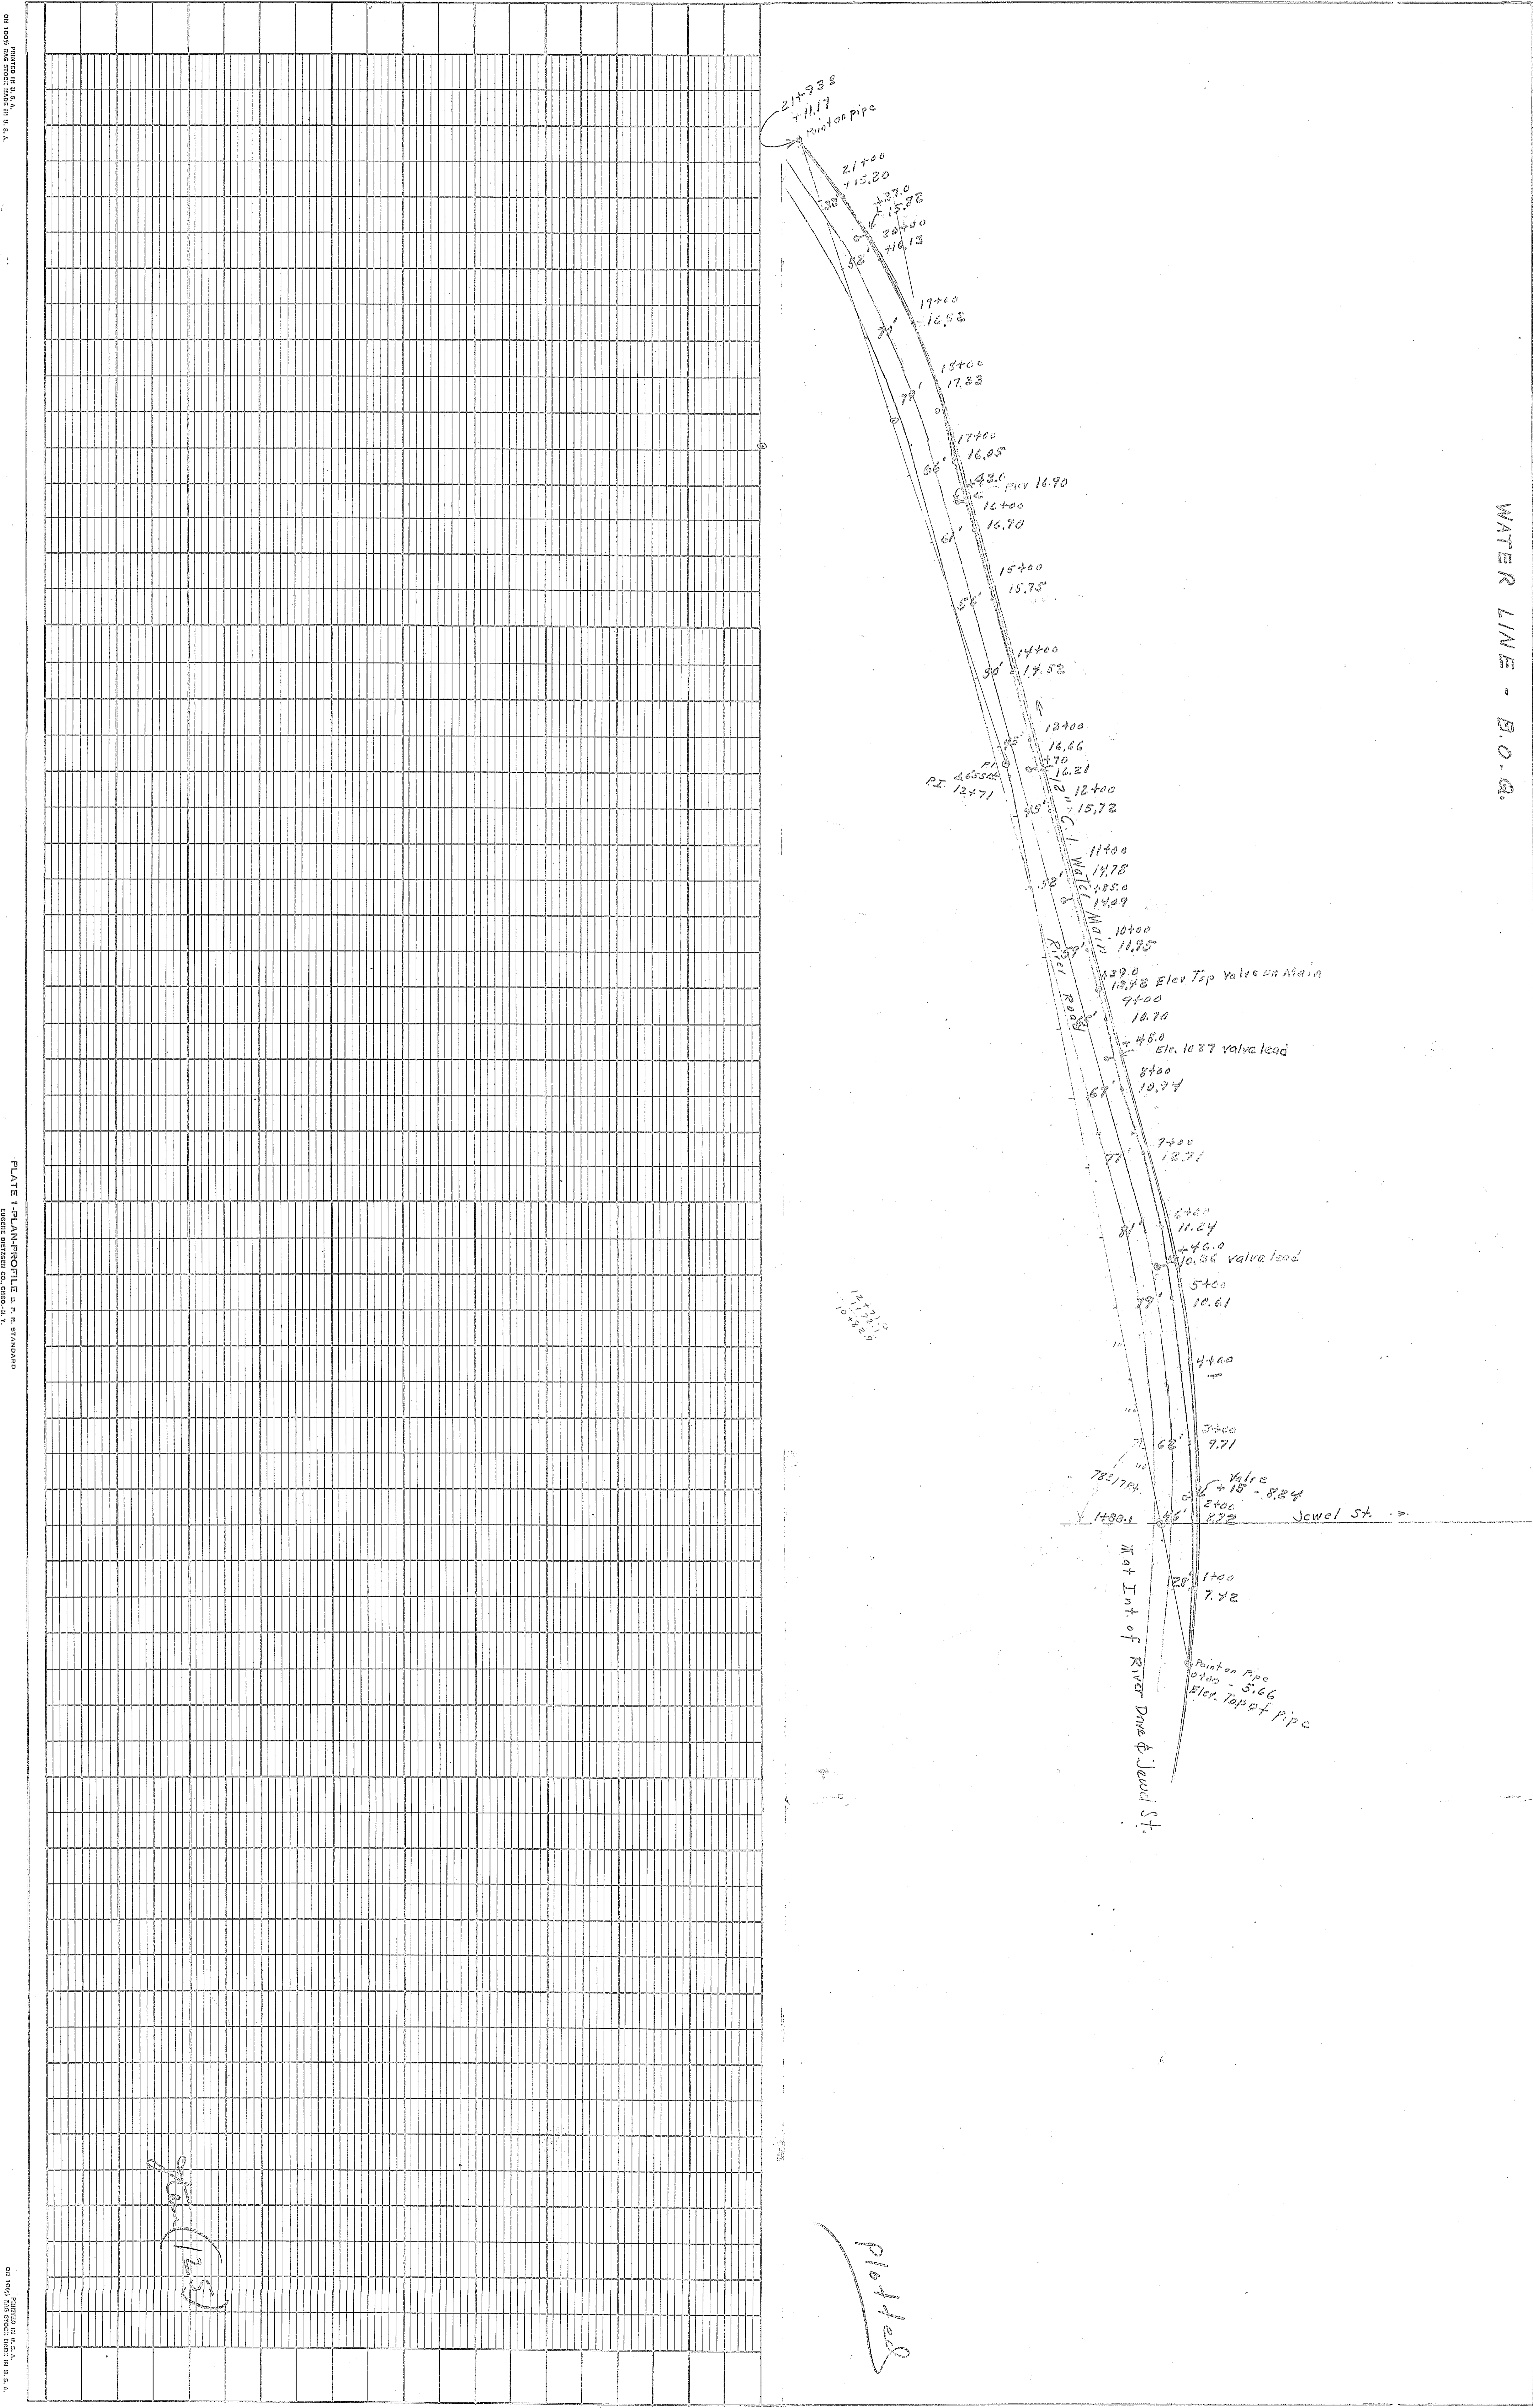


PLATE 1 PLAN PROFILE & GRADES  
 DRAWN BY: [illegible]

*Handwritten signature*

*plotted*

NO.	DATE	DESCRIPTION	AMOUNT

Water Main  
Addit. Officers Qtrs.

NO.	DATE	DESCRIPTION	AMOUNT


Spencer - Med-  
1 1/2  
1 1/2  
1 1/2


RECEIVED BY BIRN






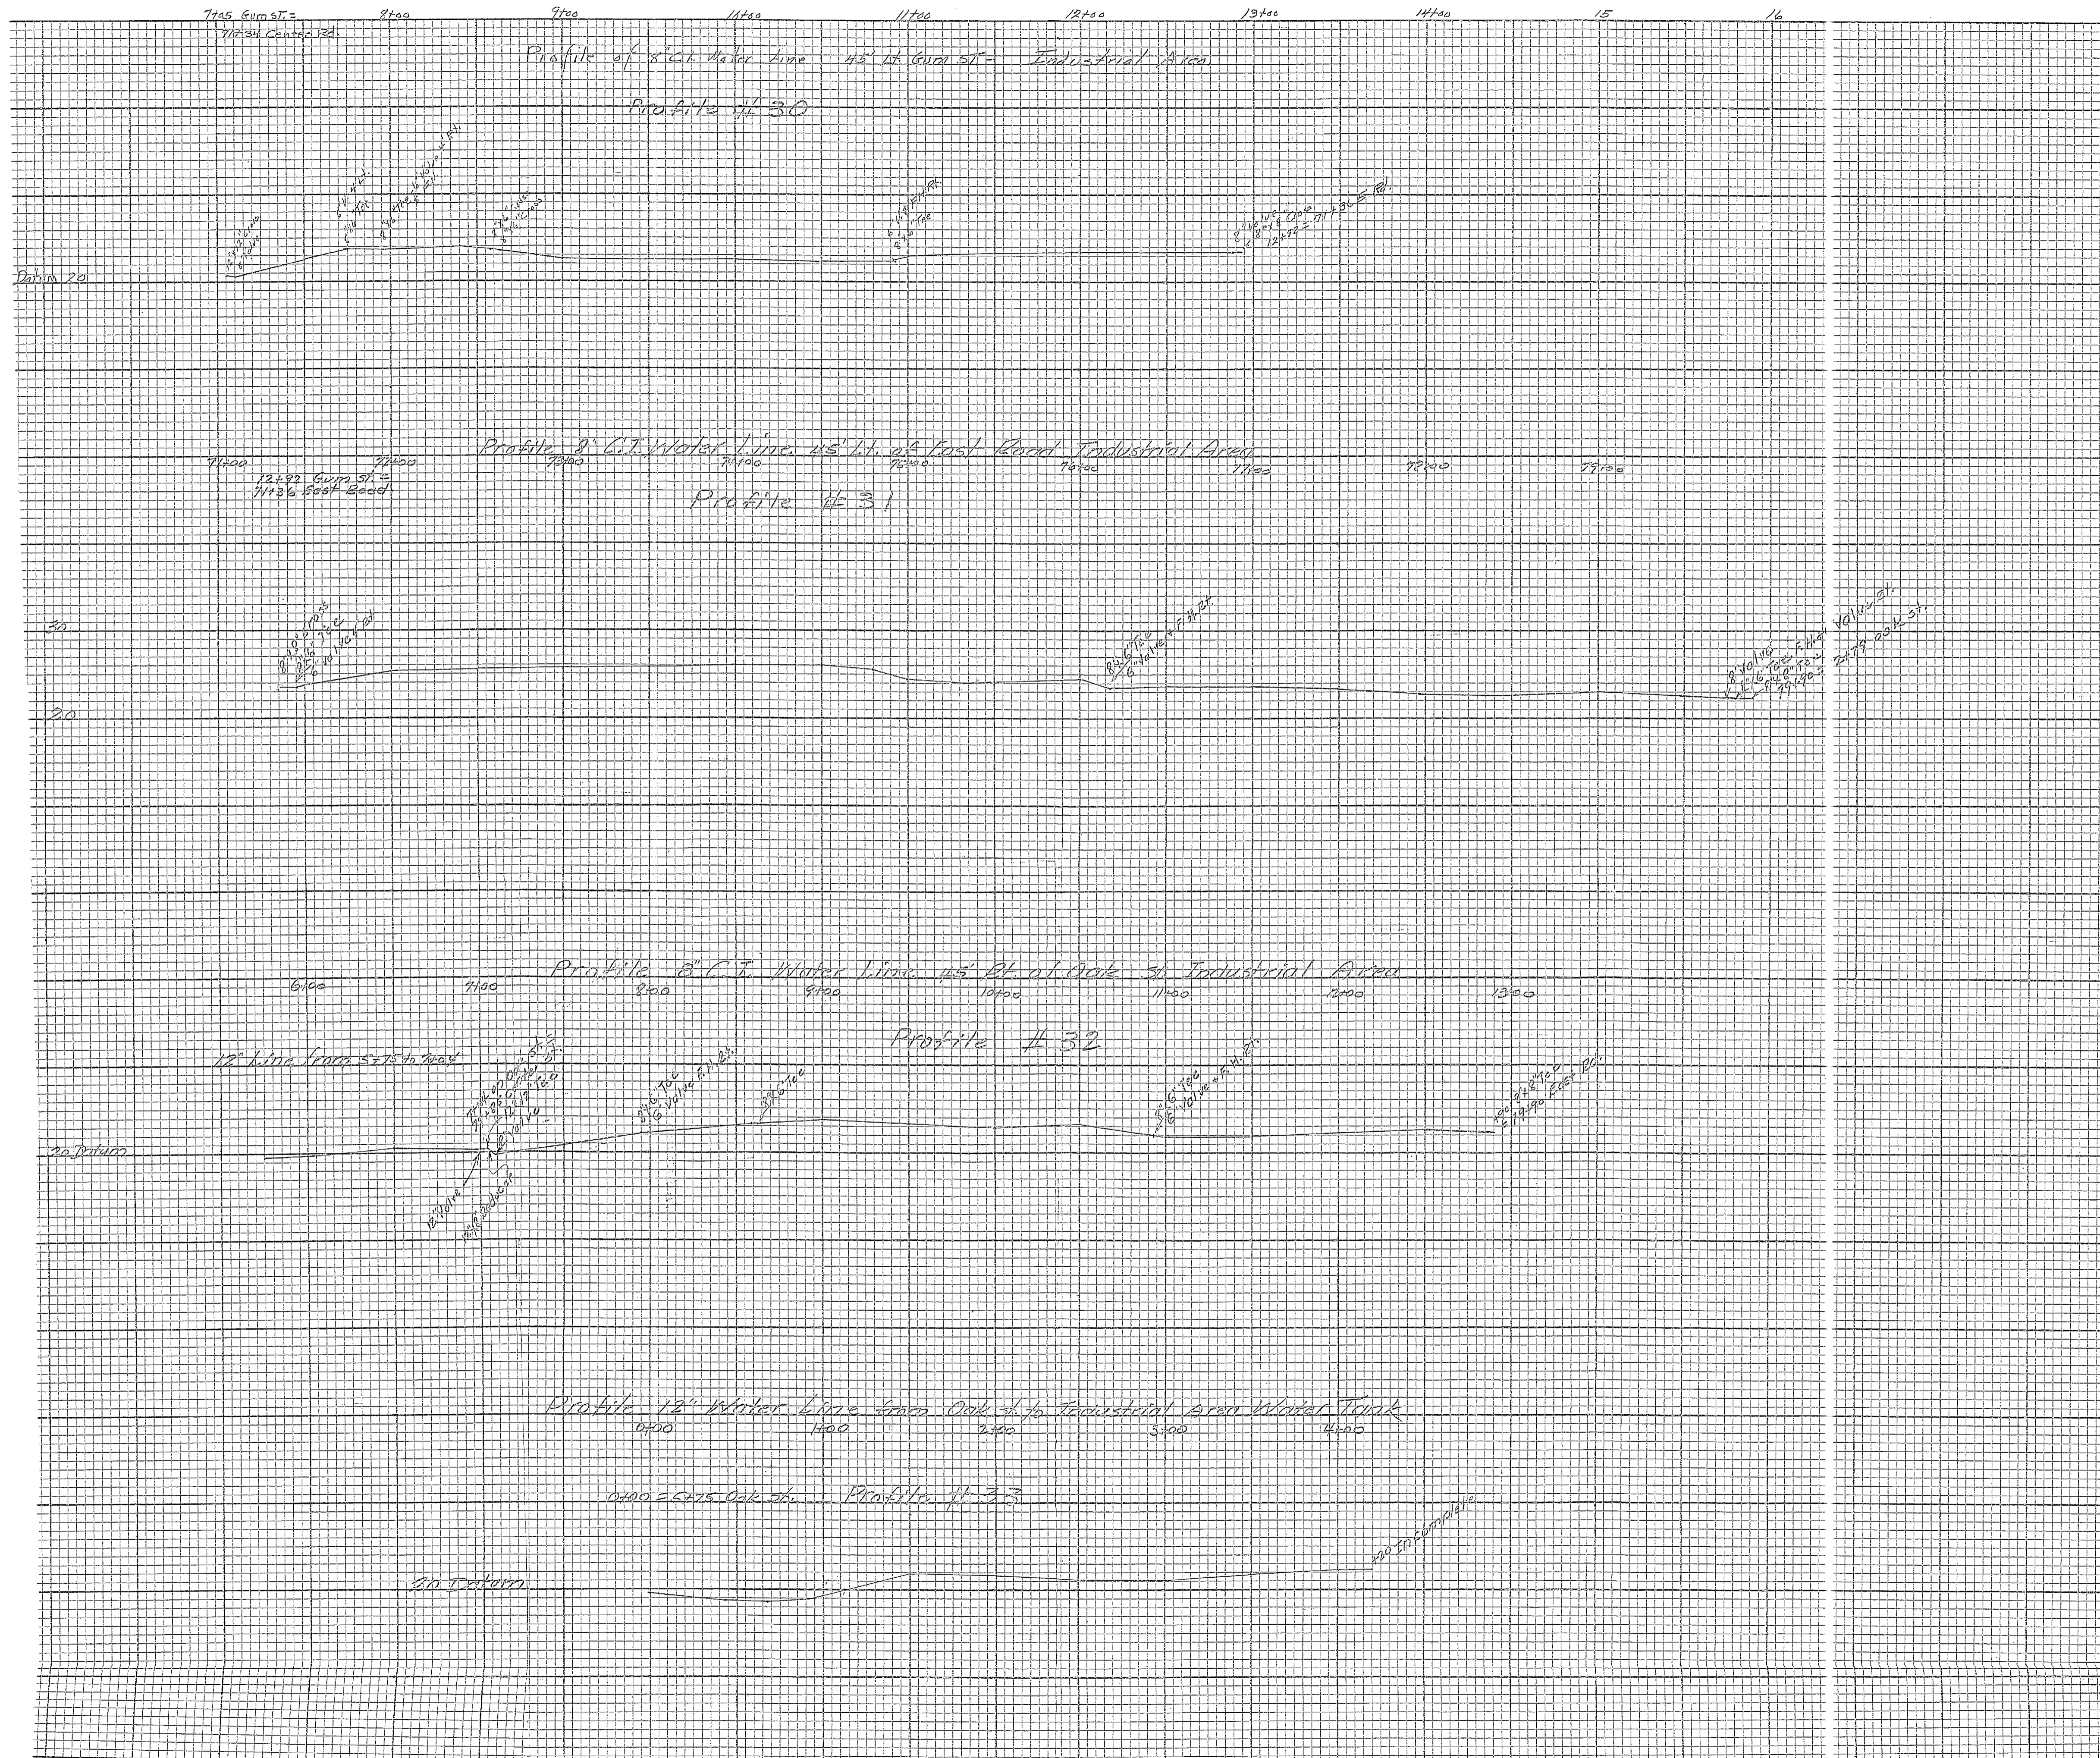


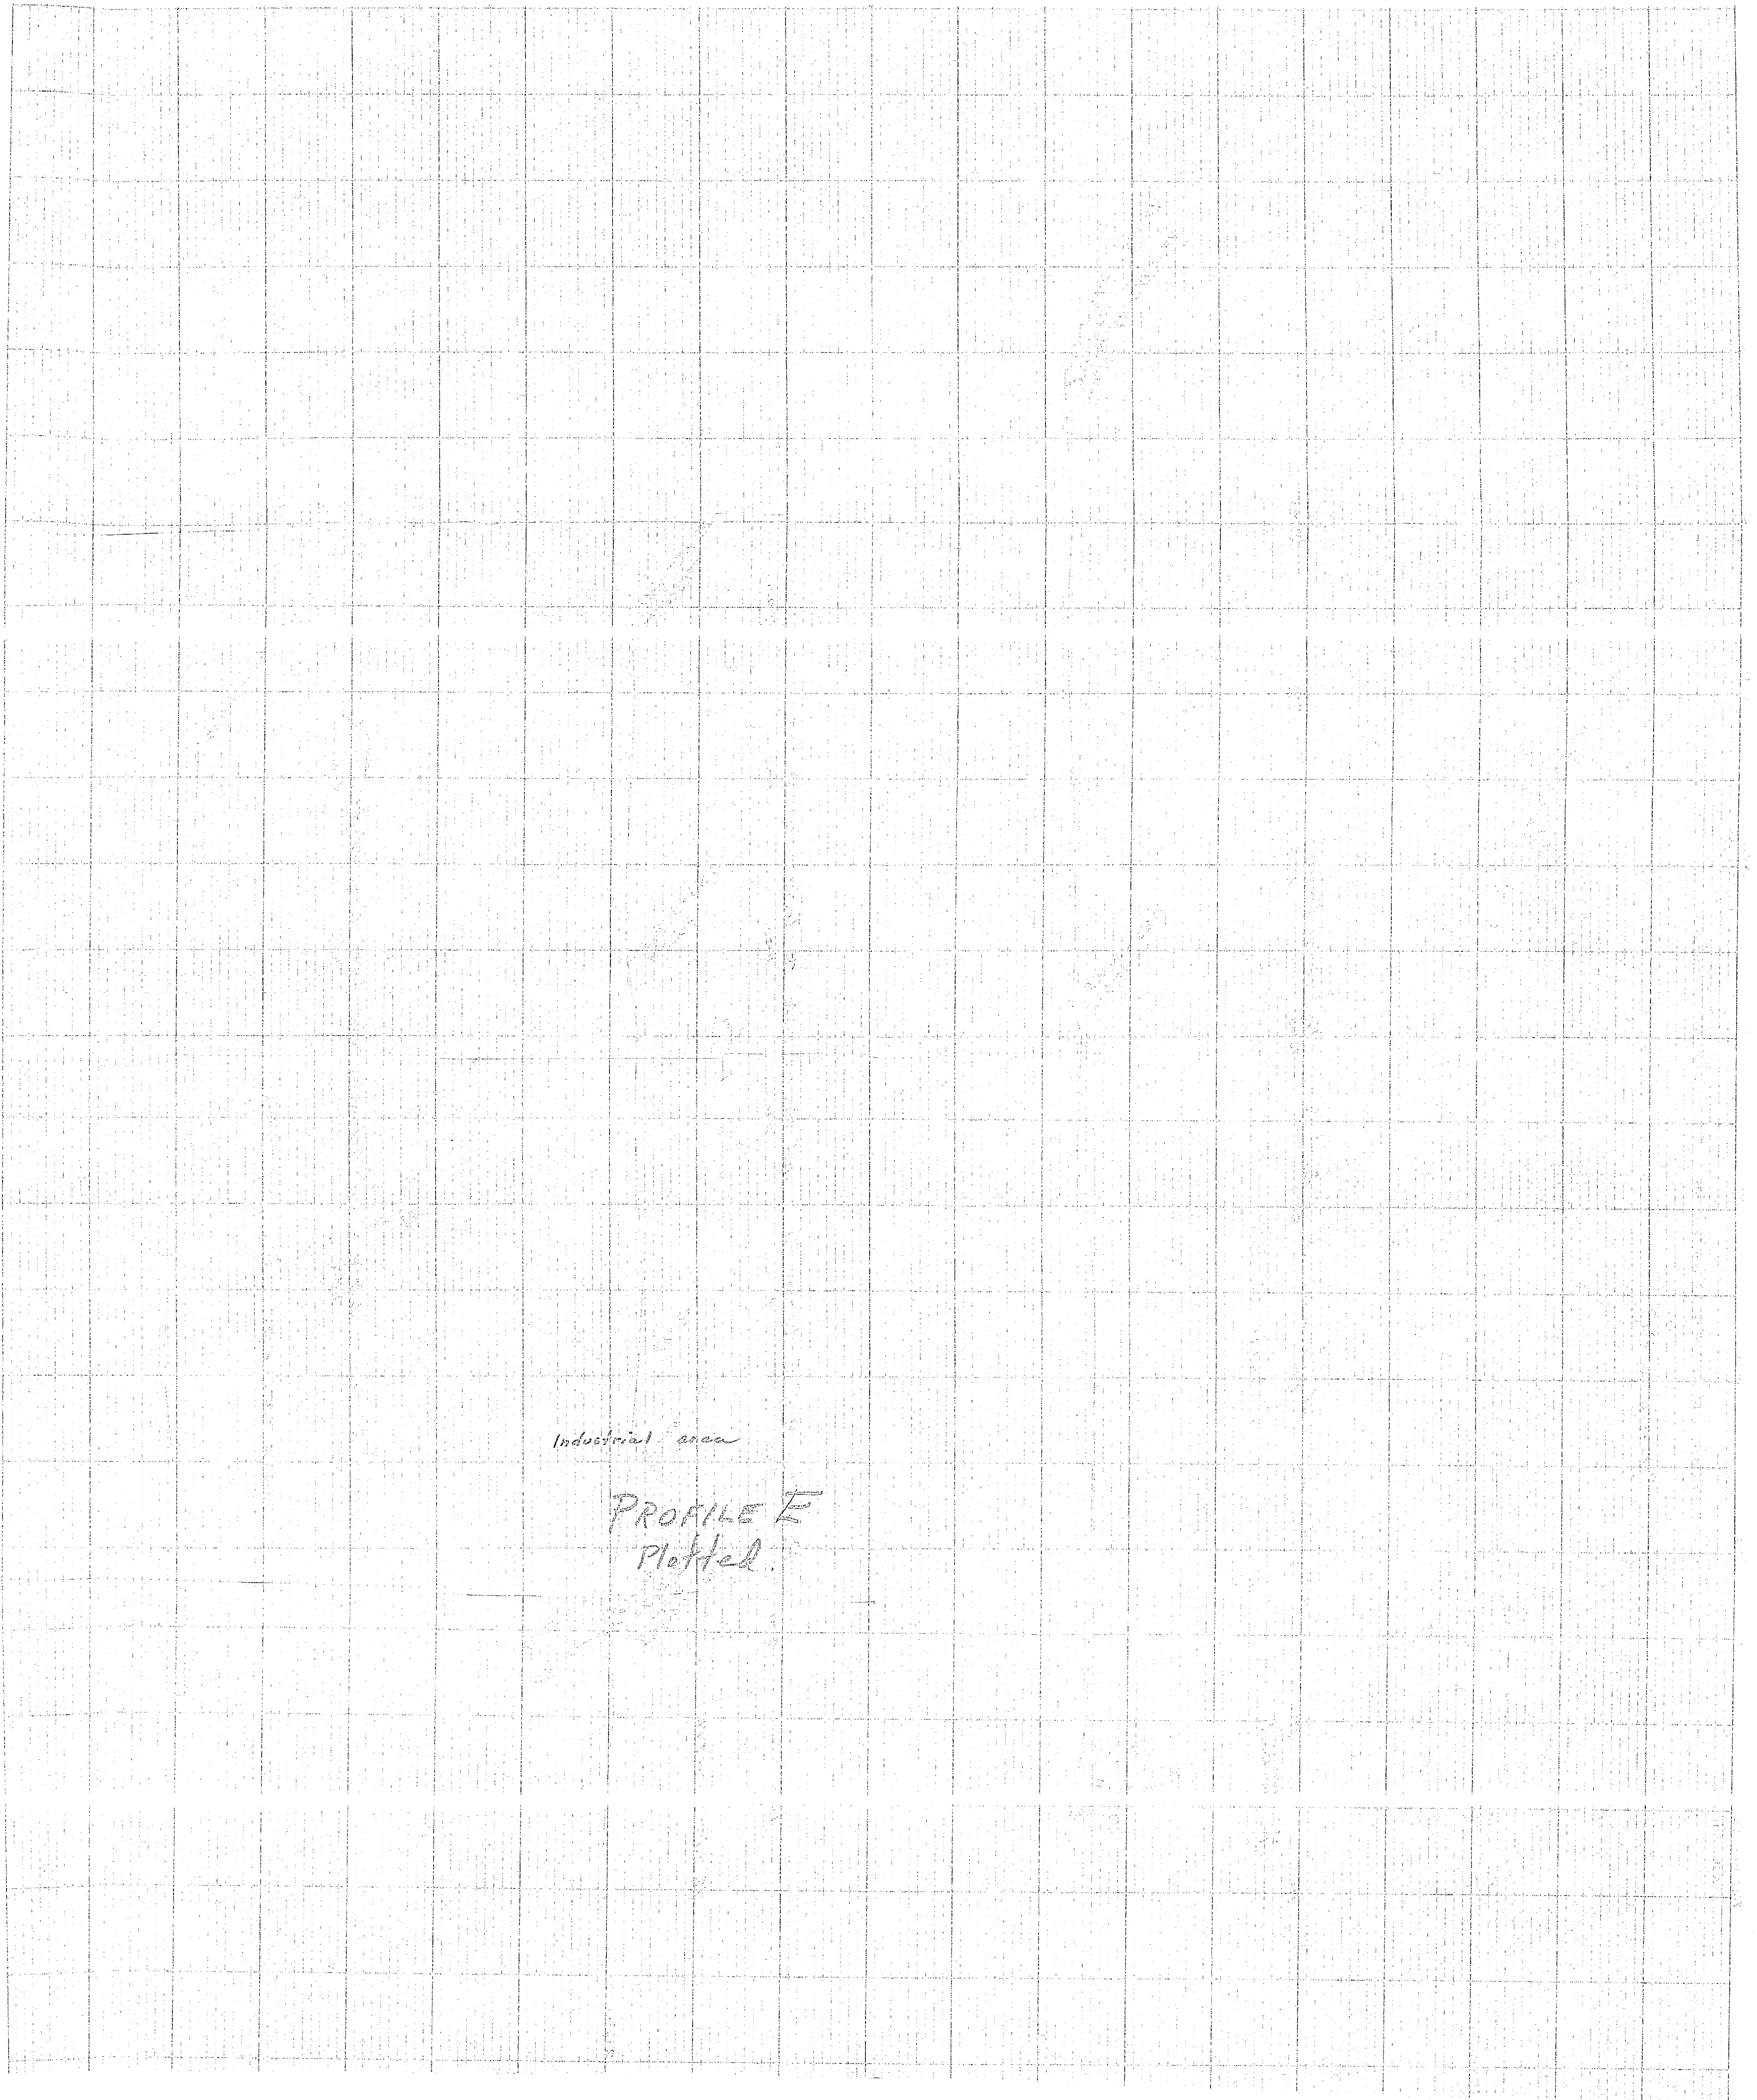

Industrial area

PROFILE E  
Plotted

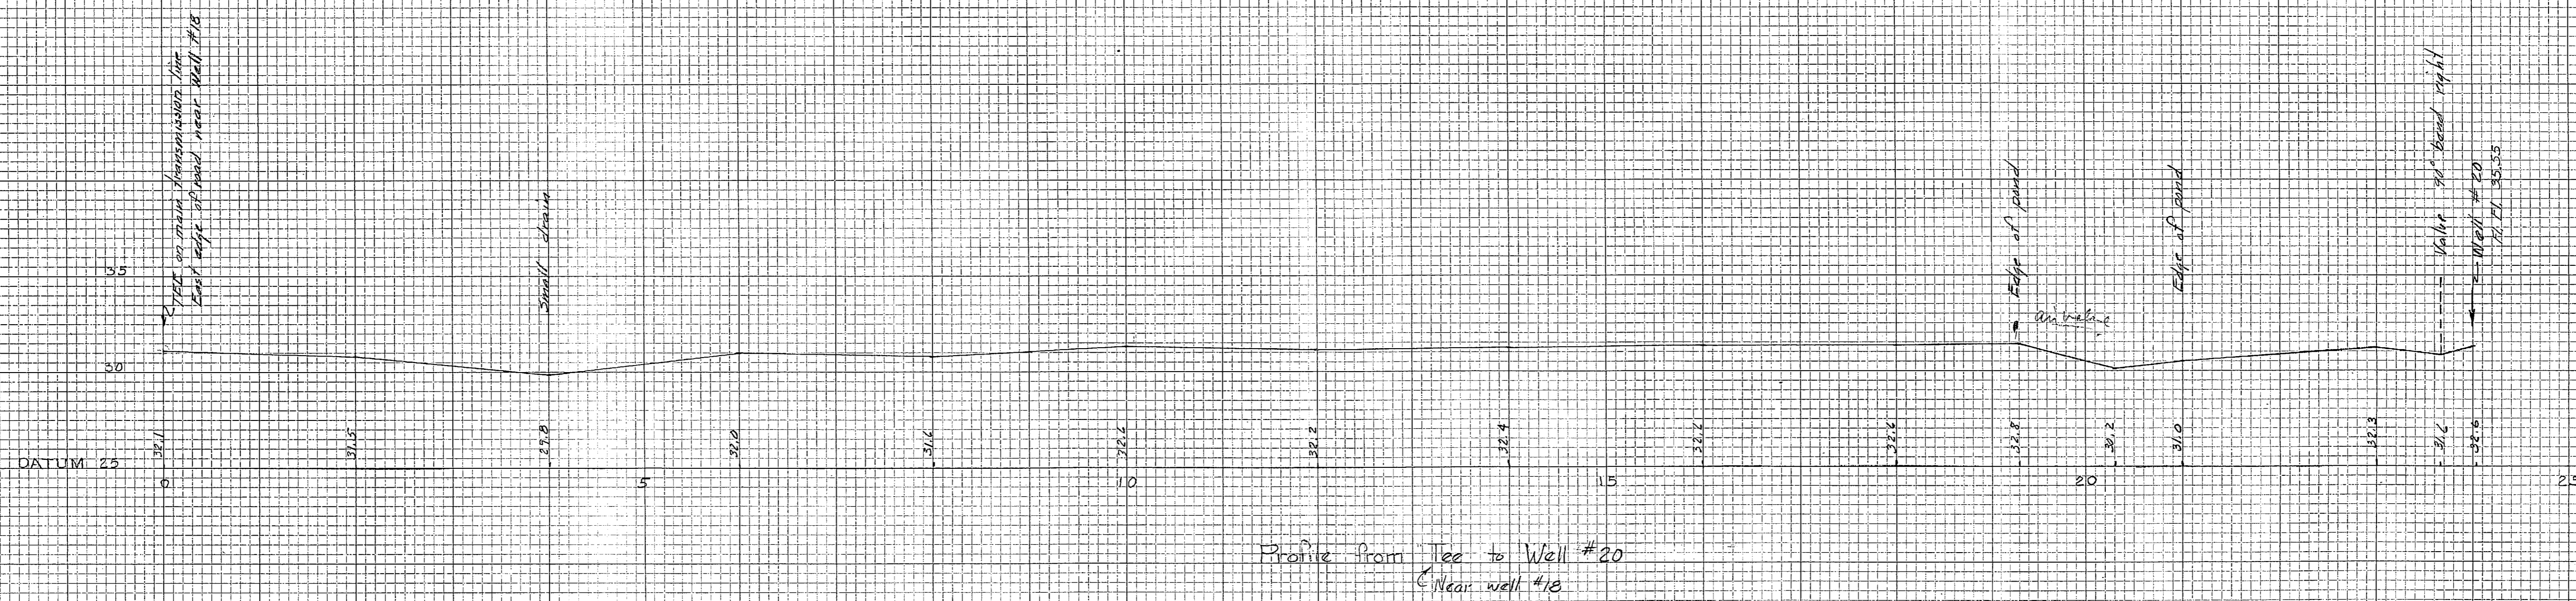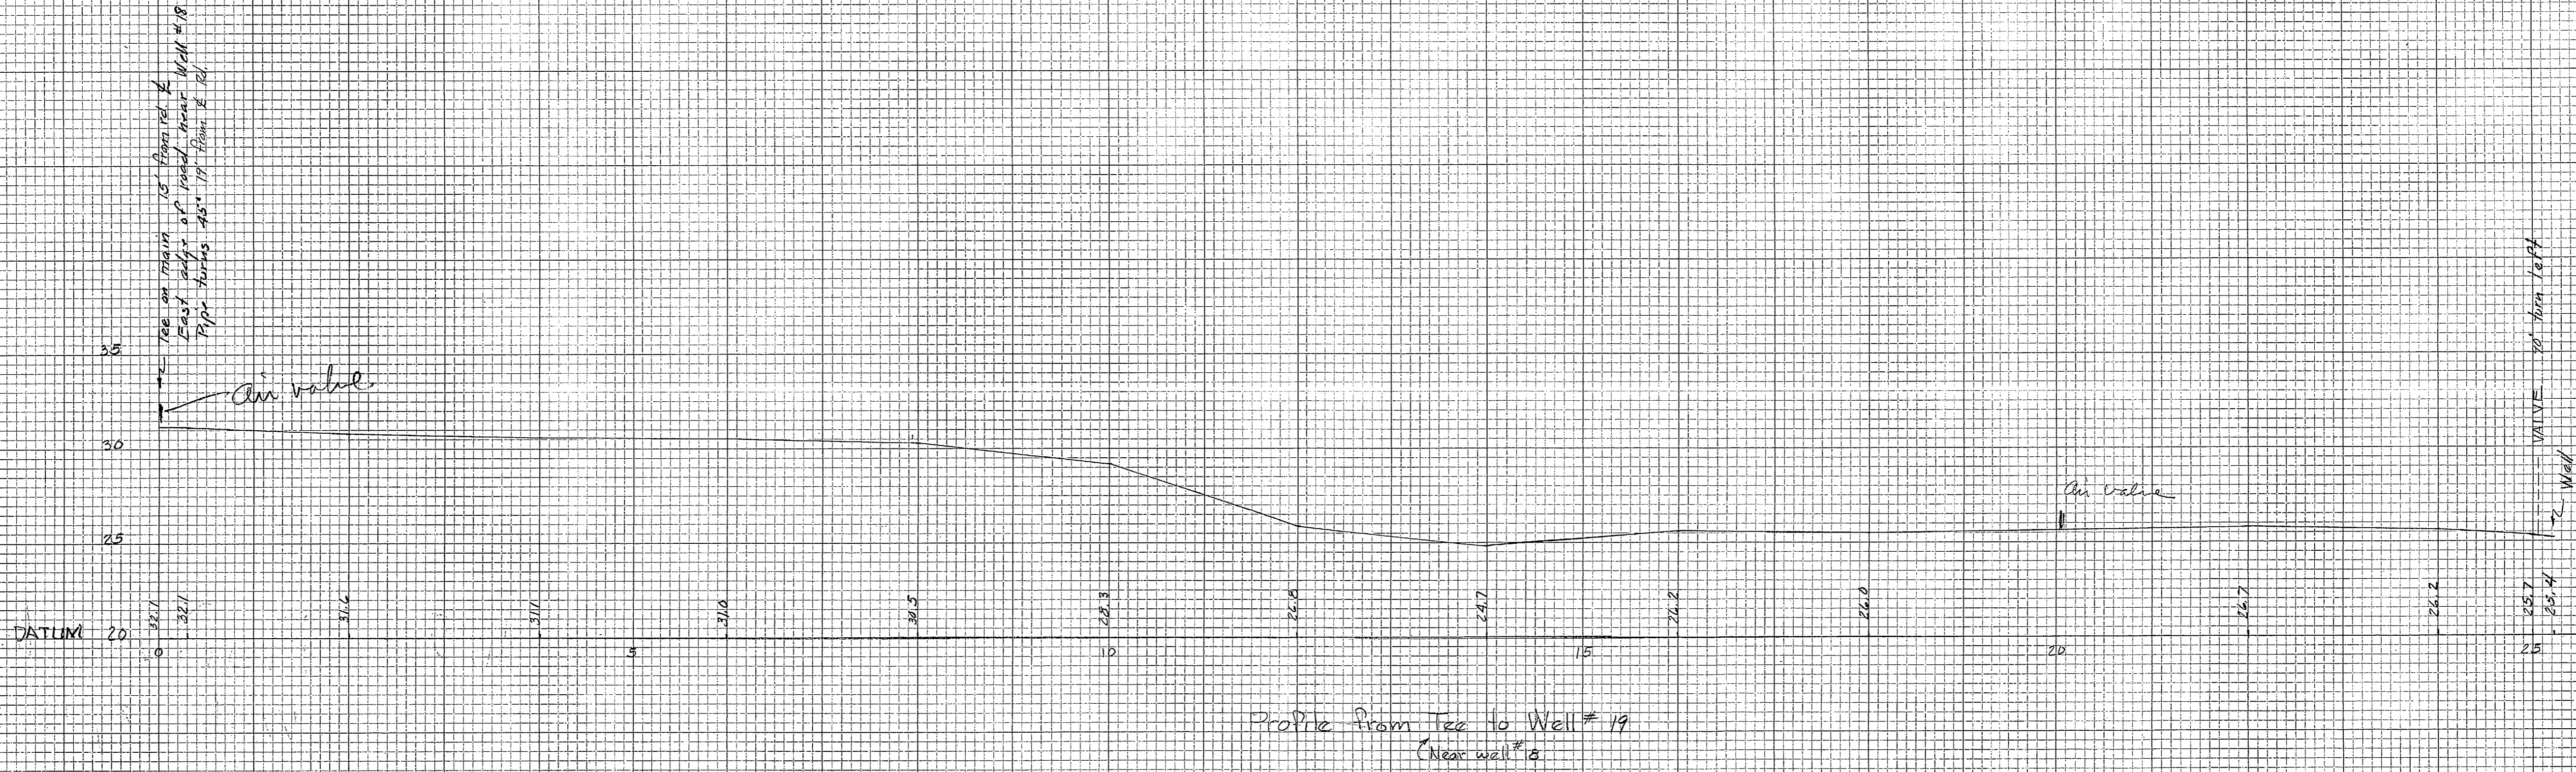

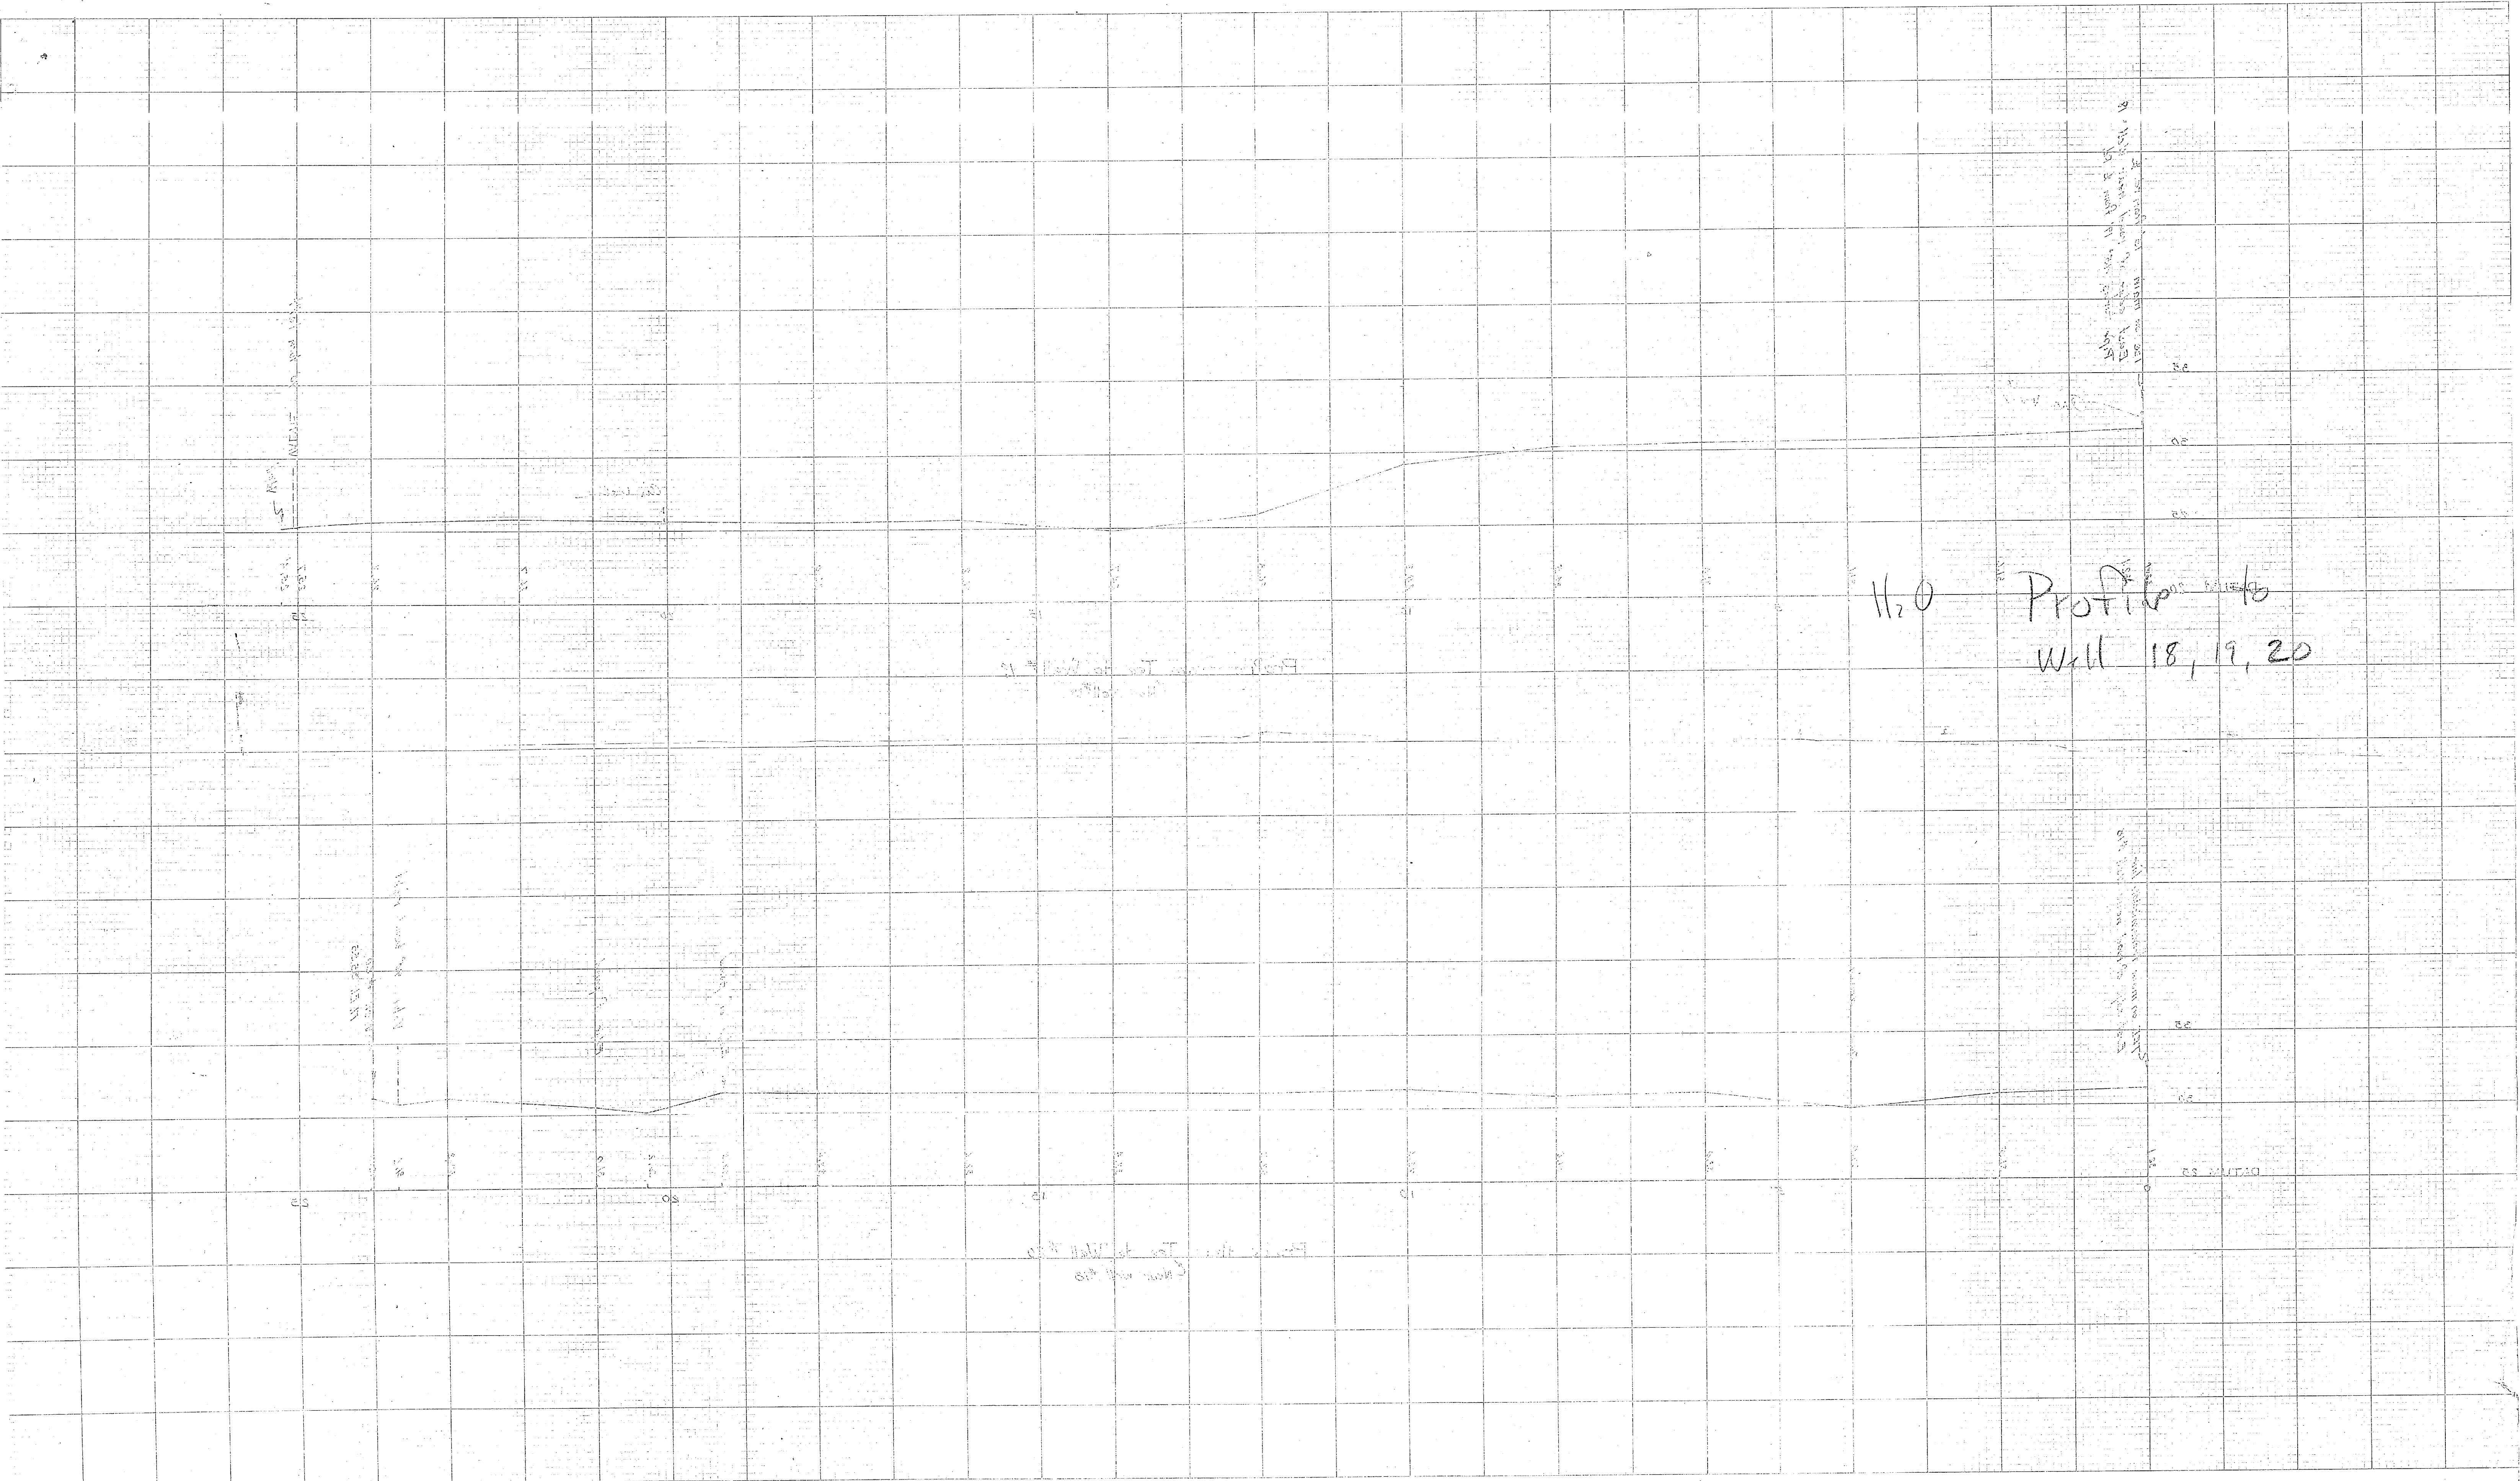

H<sub>2</sub>O Profile to  
Well 18, 19, 20


NEW YORK  
KEMPNER & EBERHART CO.  
CROSS SECTION 10 x 10  

NEW YORK  
KEMPNER & EBERHART CO.  
CROSS SECTION 10 x 10  

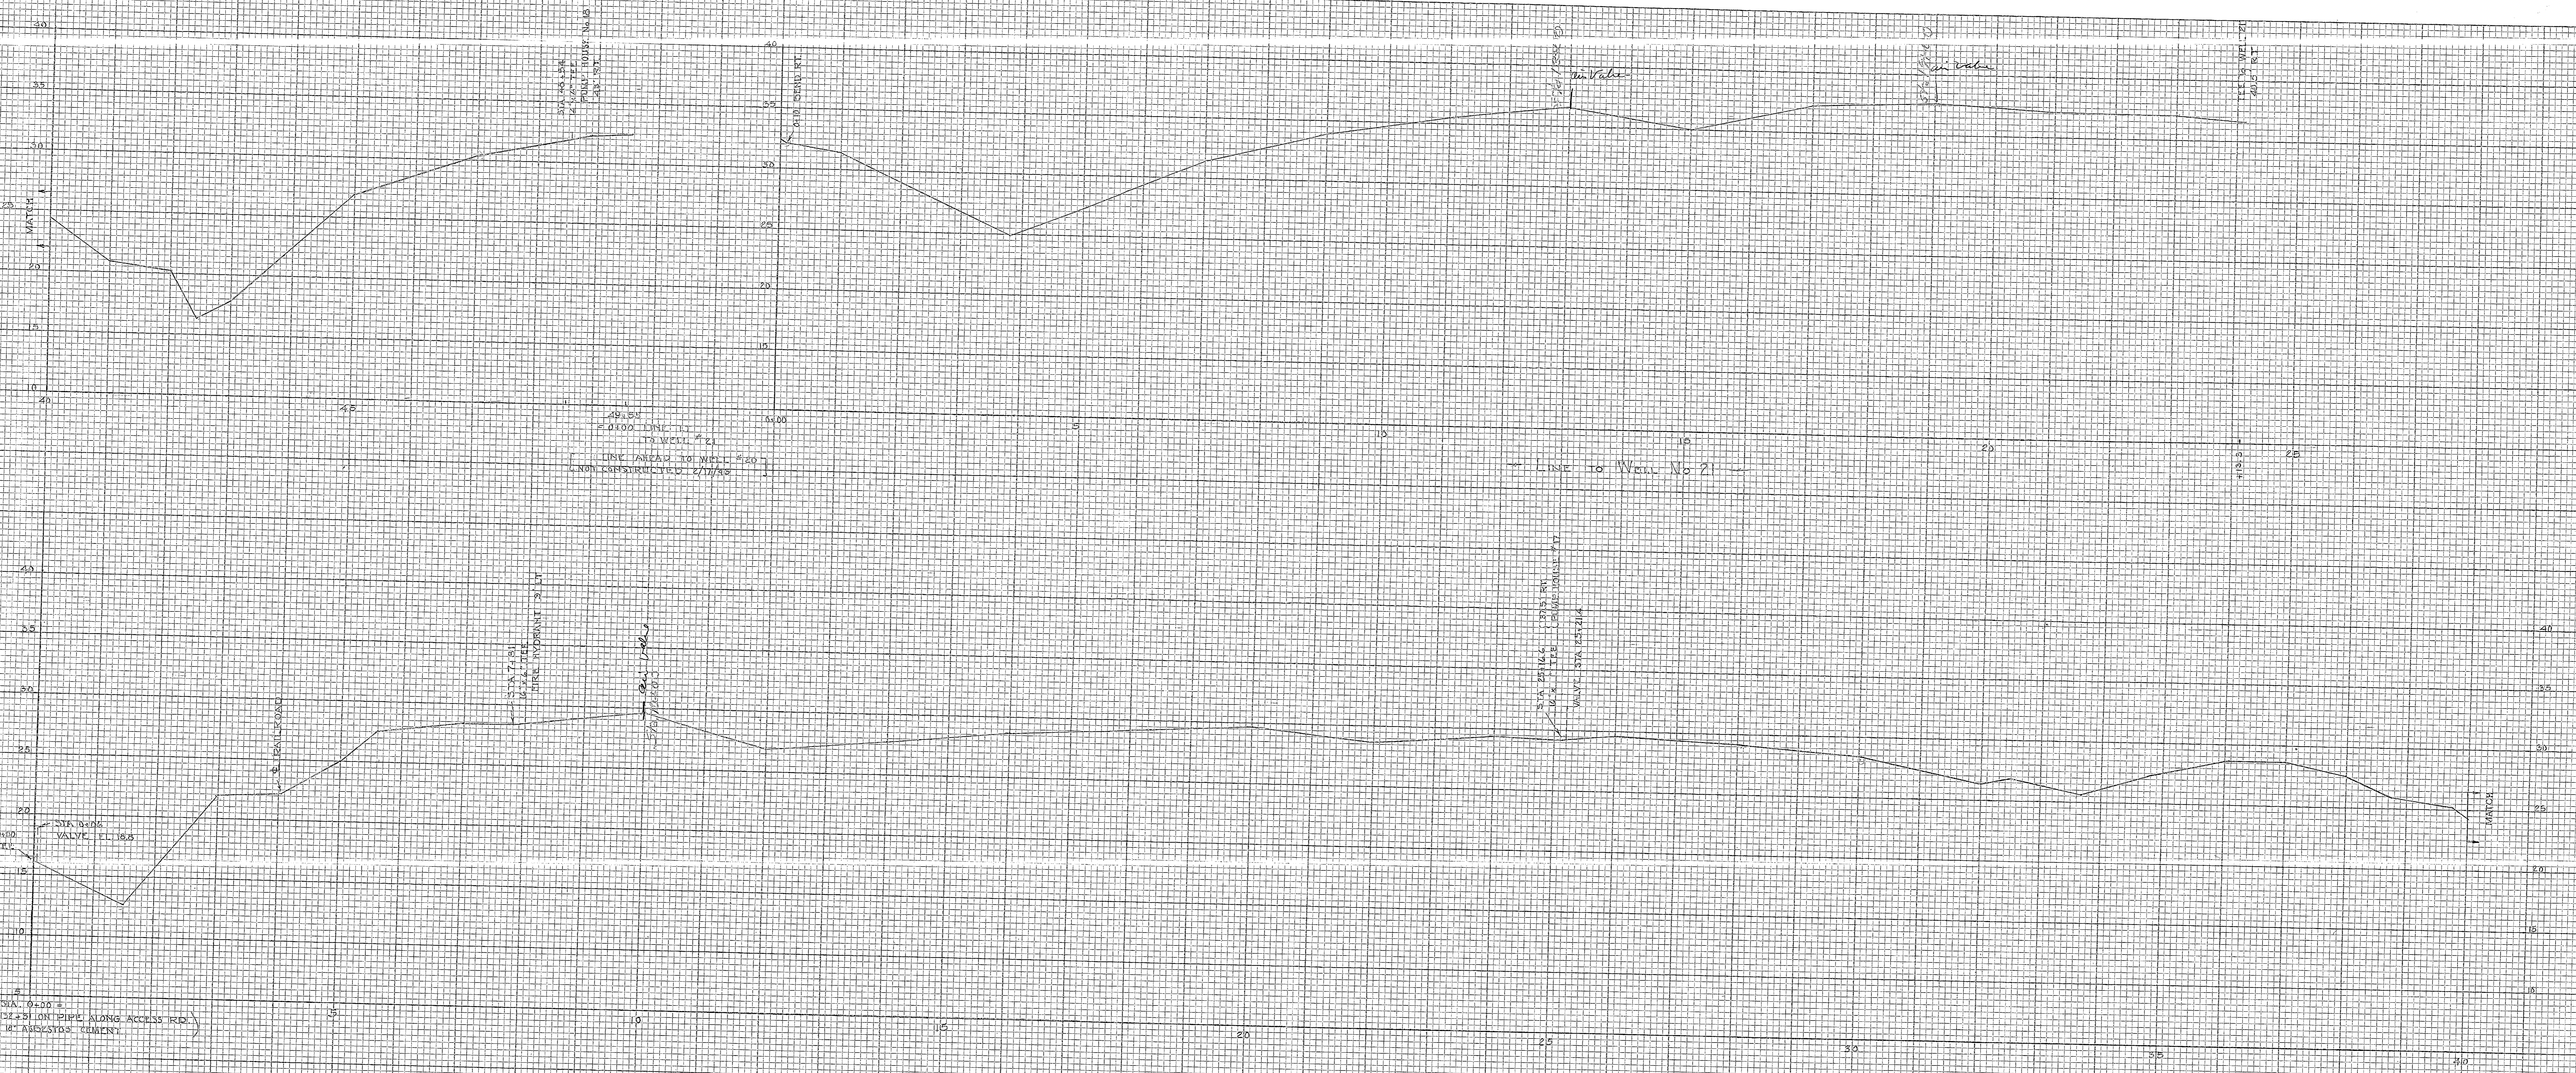

PROFILE 3-3  
 16" TRANSITE WATER LINE  
 Well 13 to Wells 17, 18 & 21  
 SCALE 1" = 5' VERTICAL  
 1" = 100' HORIZONTAL  
 Team: MCM/... notes dated 2/10/68  
 of sheet No. 222



Profile "F-F"

SECTION








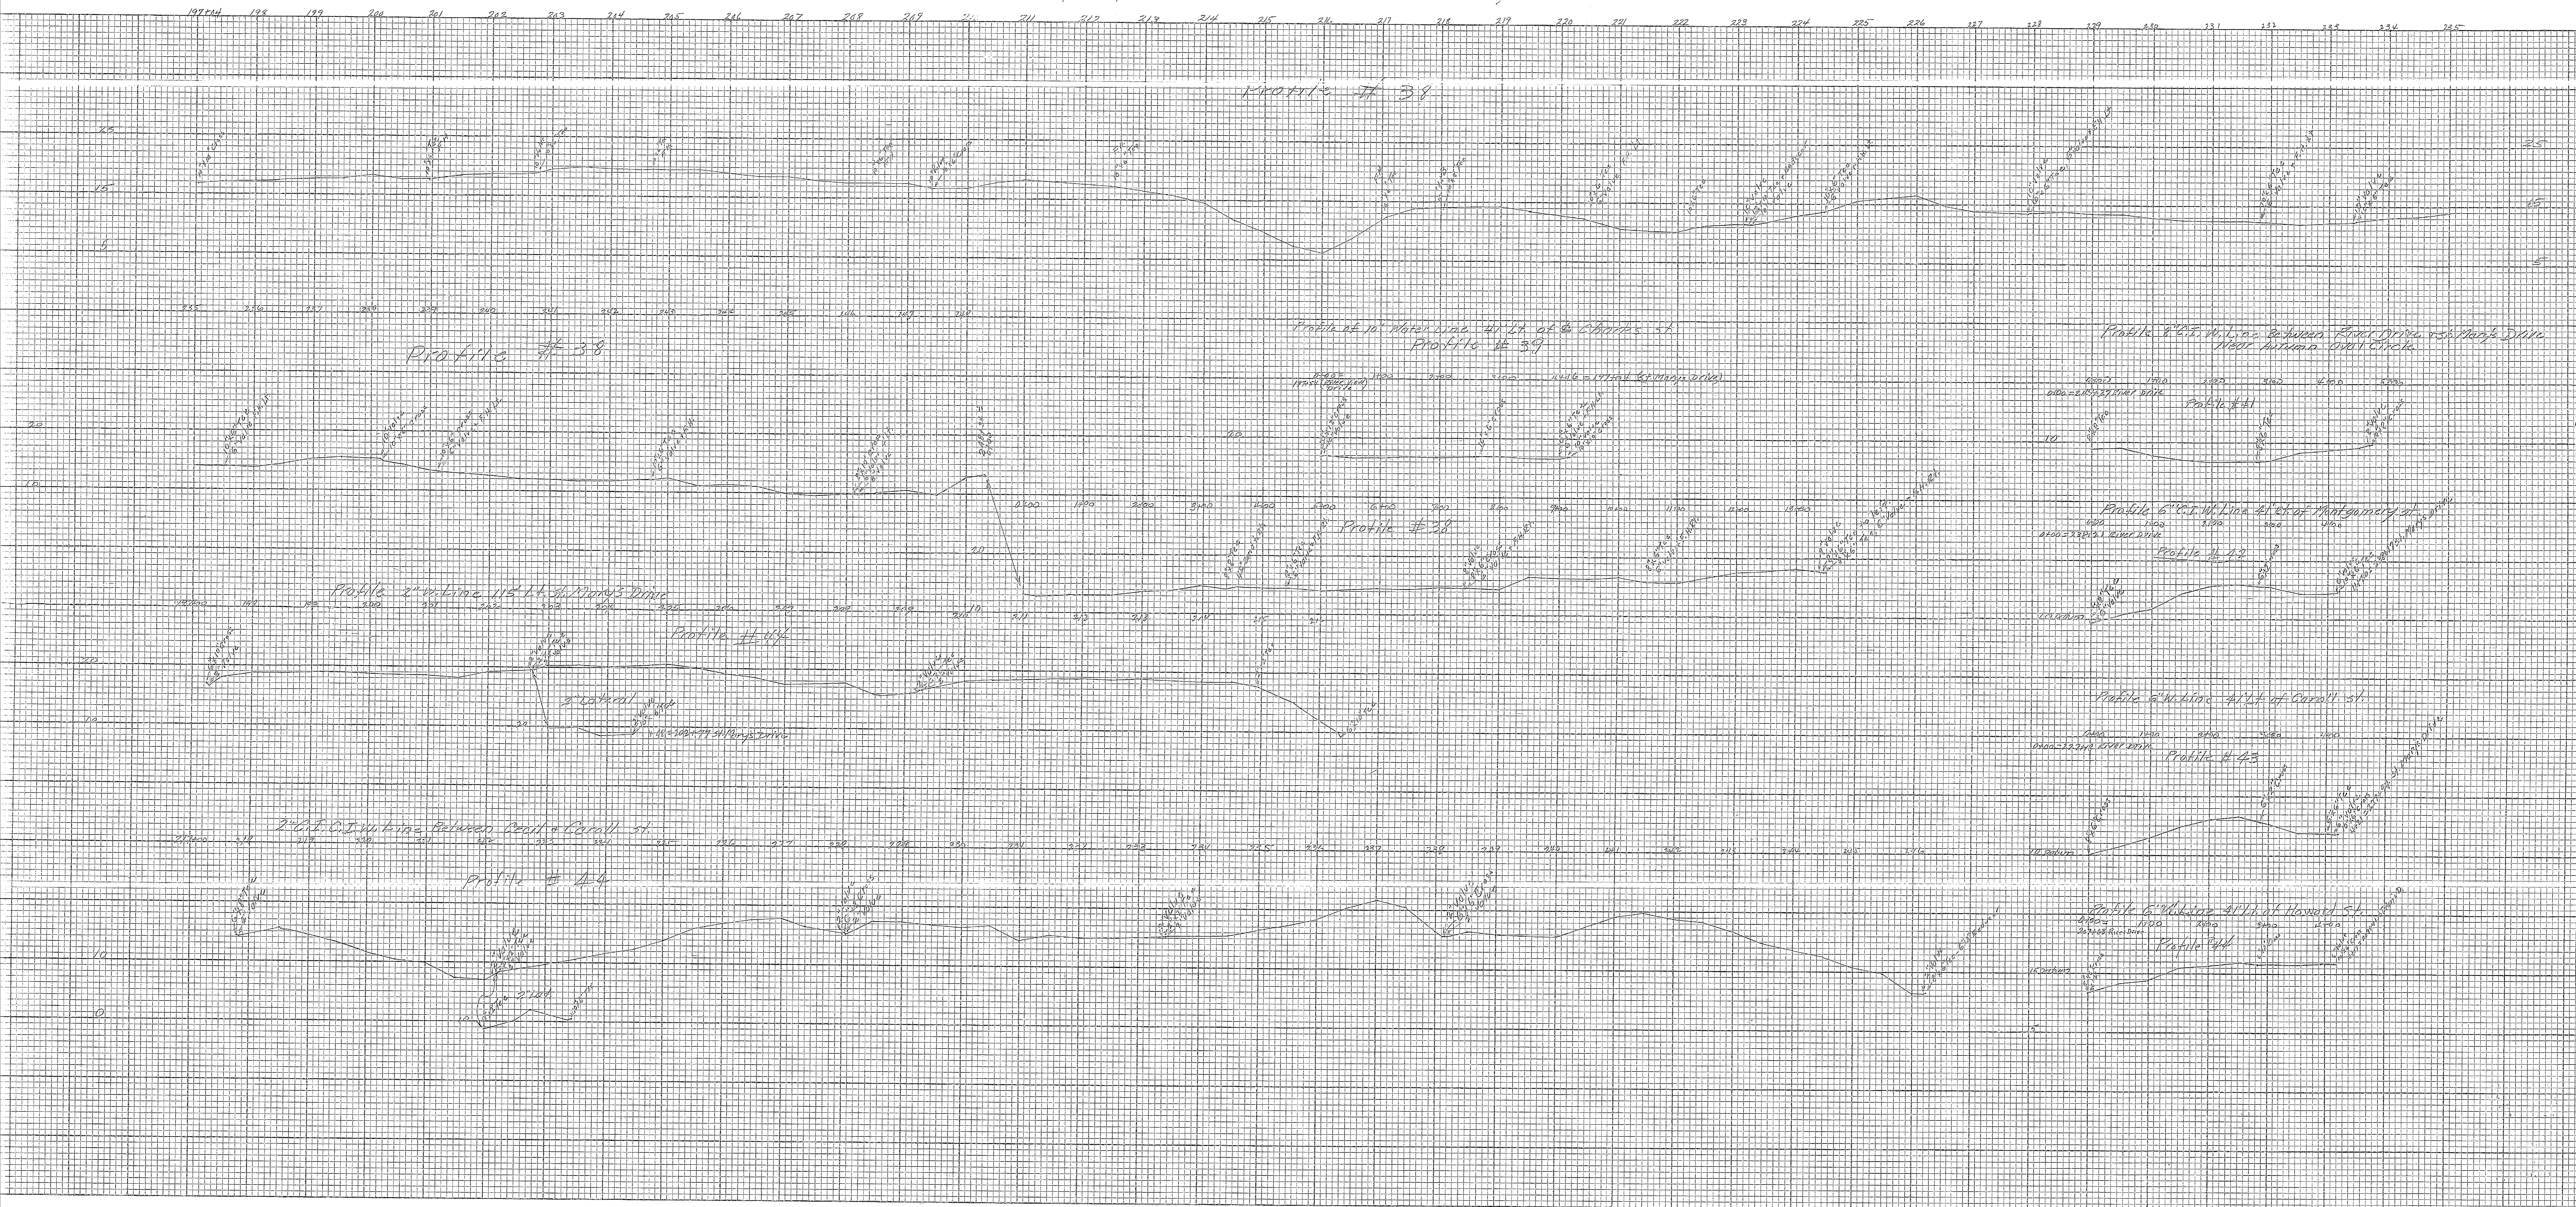

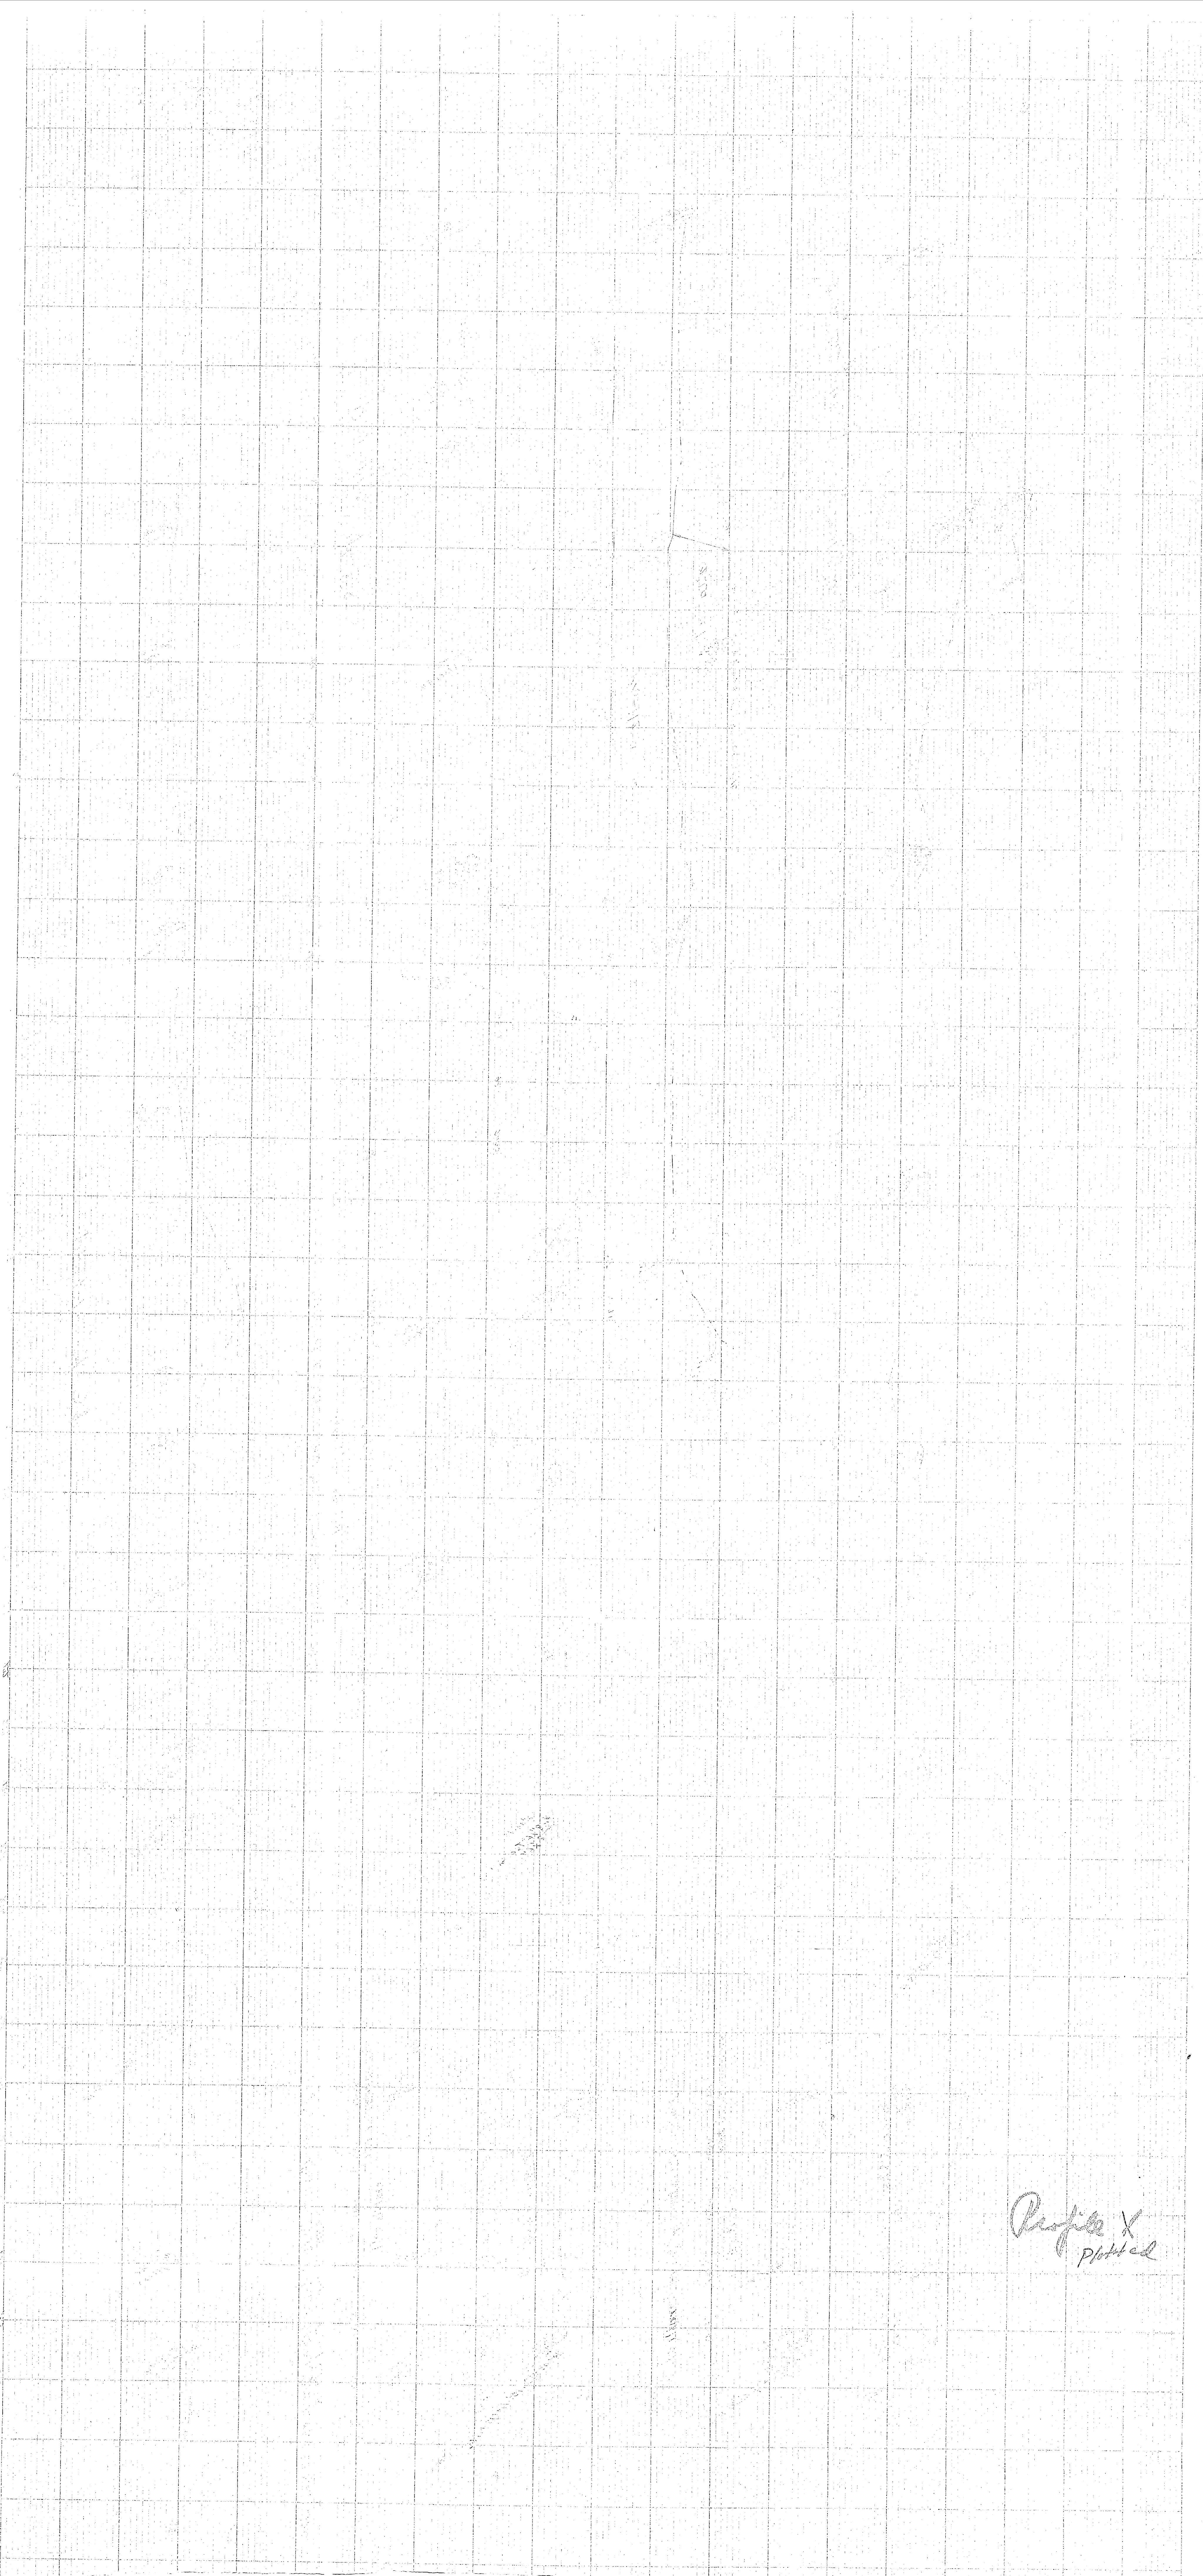






PLAN	DESIGNED	DATE
	BY	
ROUTE BOOK	ALIGNED	
	PLATTED	
NO.	ADJUSTMENT CHECKED	
	BY	

PROFILE	DESIGNED	DATE
	BY	
ROUTE BOOK	ADJUSTMENT CHECKED	
	PLATTED	
NO.	ADJUSTMENT CHECKED	
	BY	

Profile #45 Profile 6" Water Line from River Road Thru Batailor Officers Quarters back to River Road.

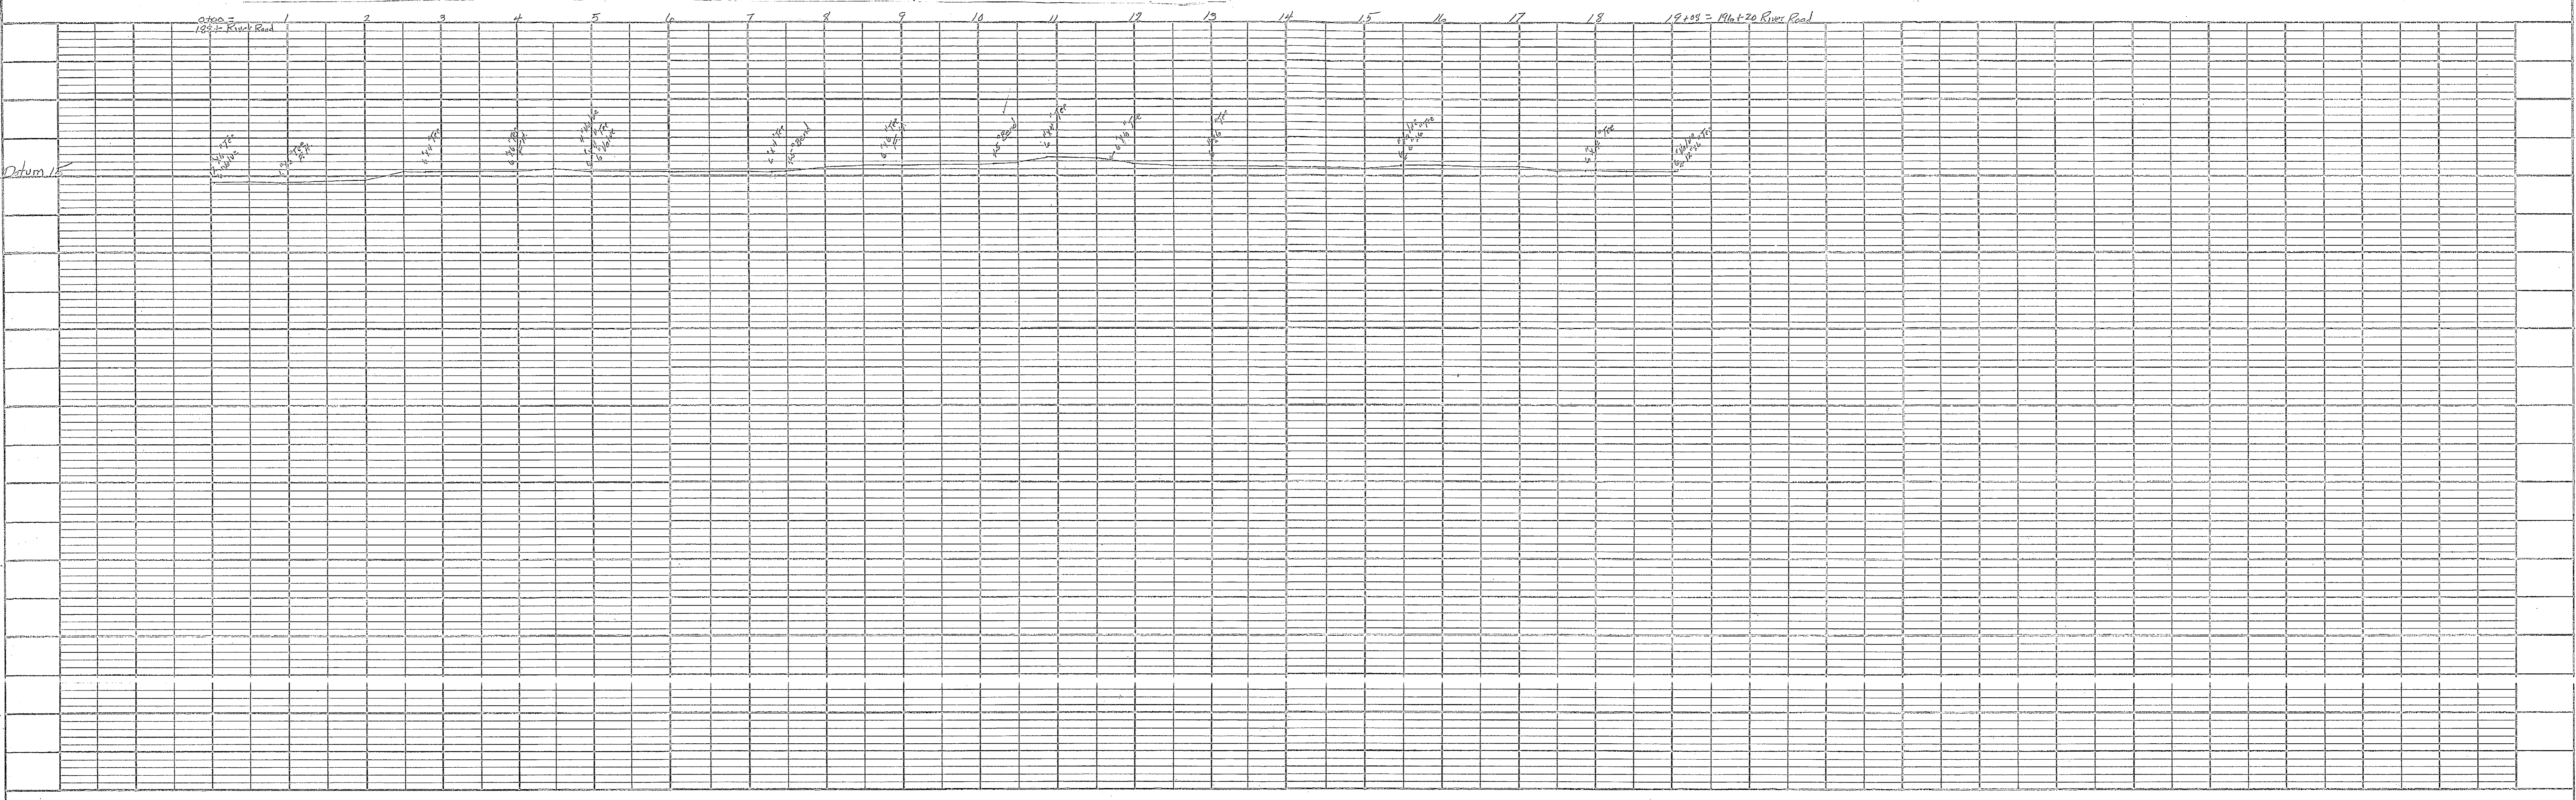


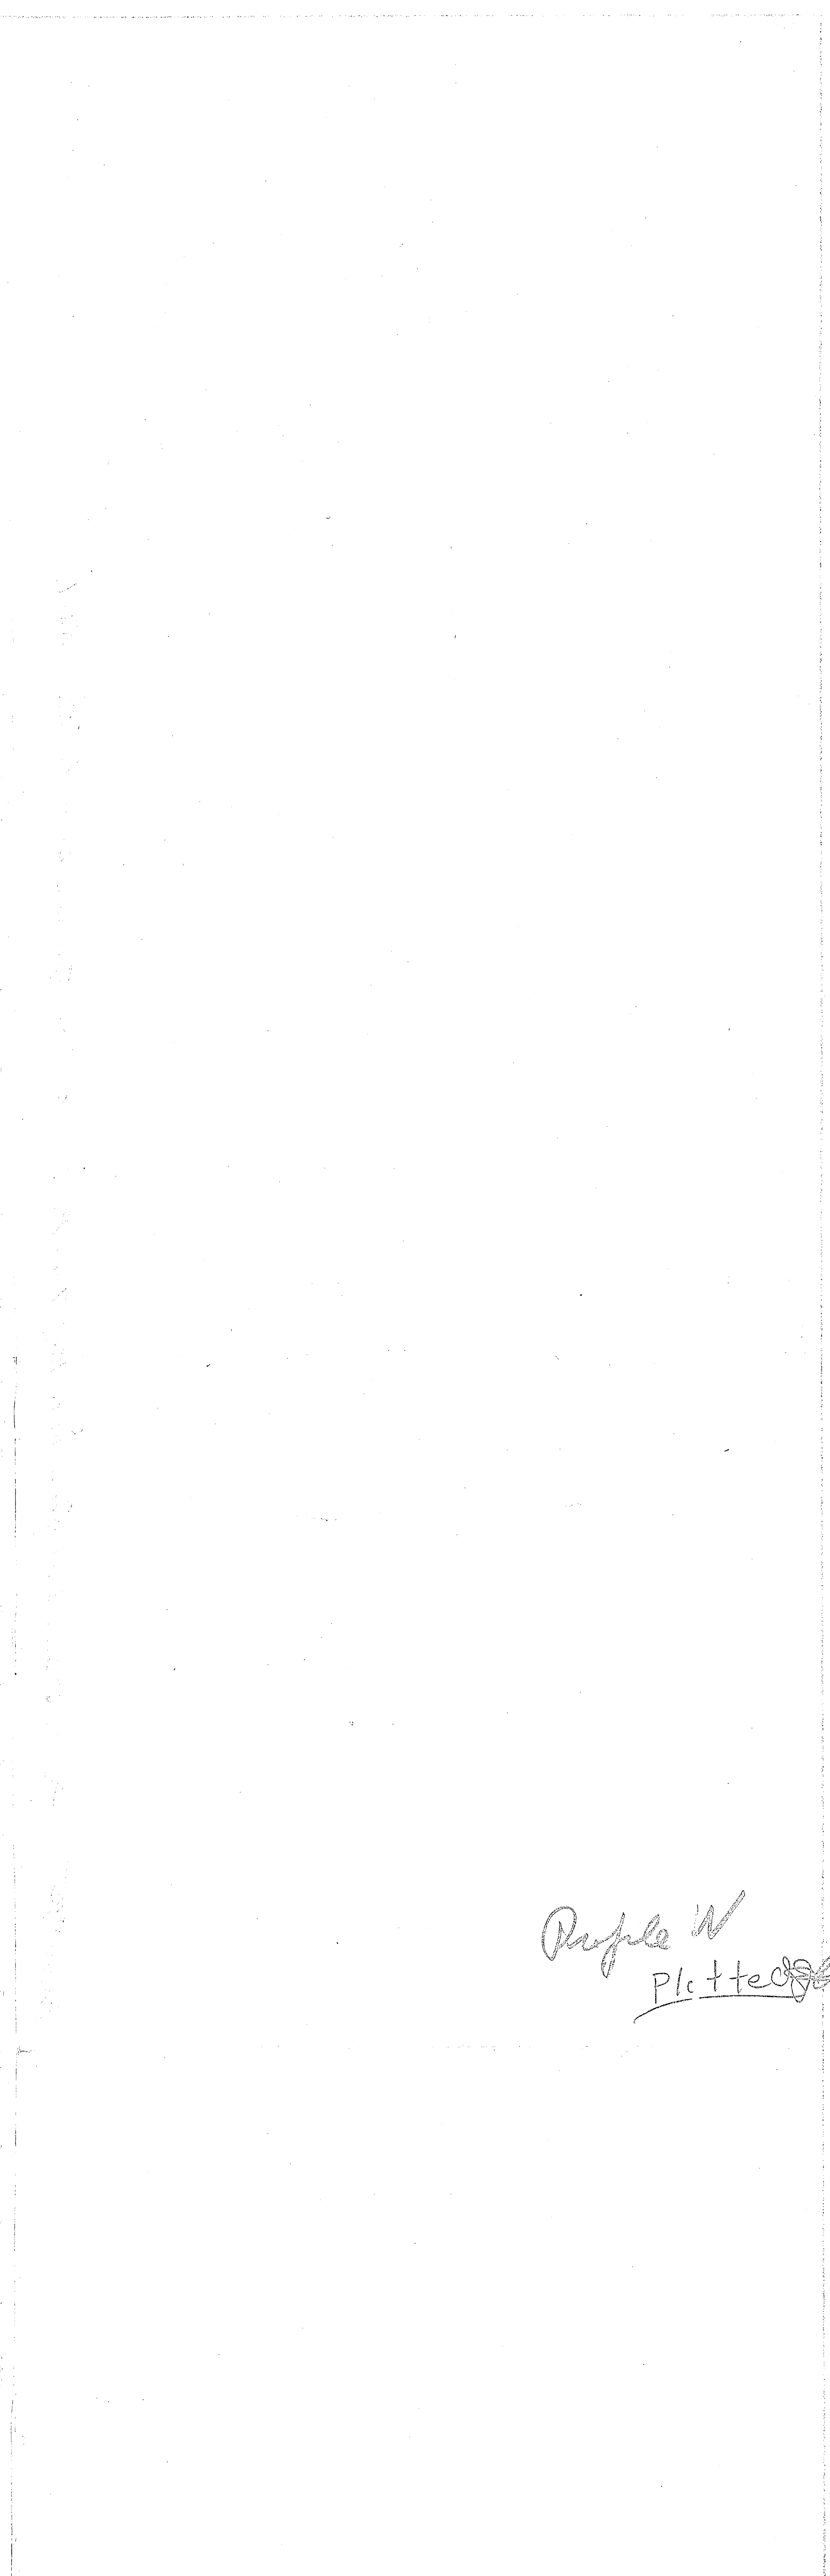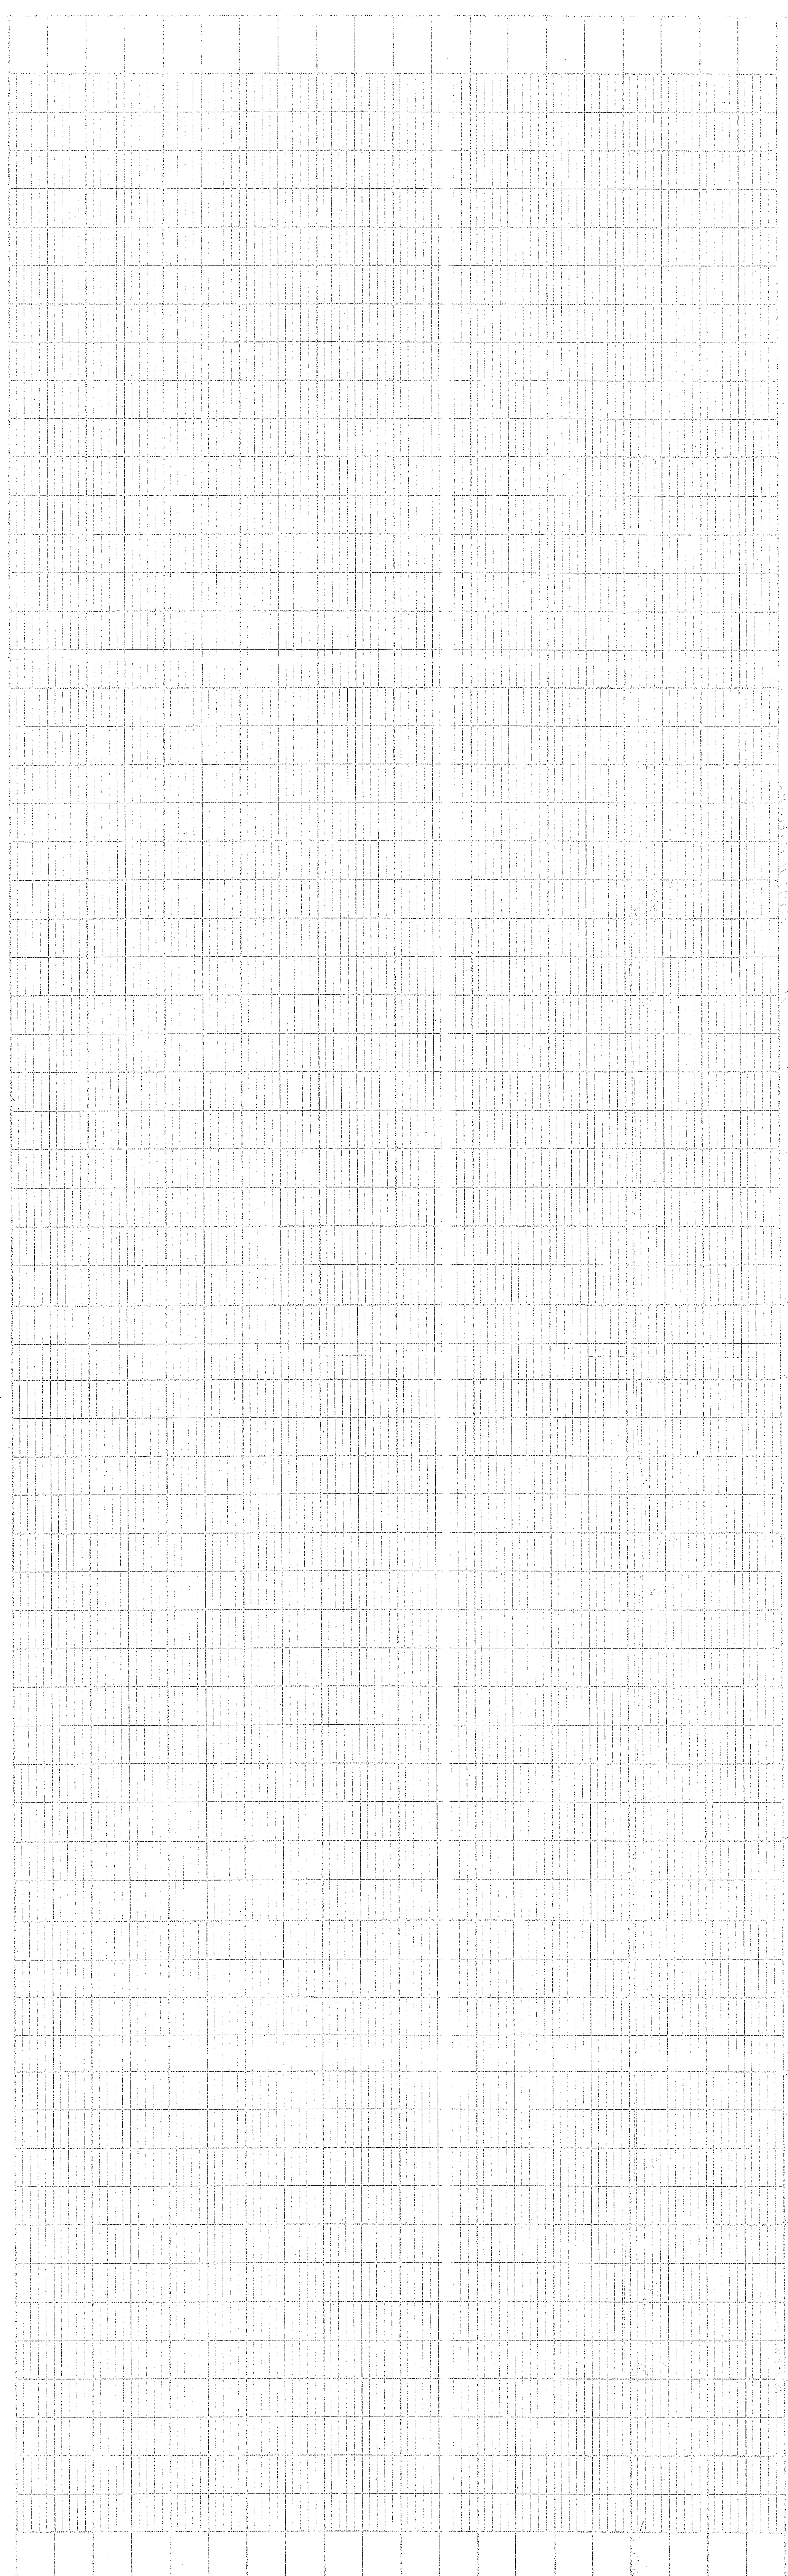

*People in  
Plotted*


	PROJECT NO.	
	DATE	
	DRAWN BY	
	CHECKED BY	
	SCALE	
	TITLE	

	PROJECT NO.	
	DATE	
	DRAWN BY	
	CHECKED BY	
	SCALE	
	TITLE	



DATE	
BY	
CHECKED	
APPROVED	
BY	
DATE	


DATE	
BY	
CHECKED	
APPROVED	
BY	
DATE	

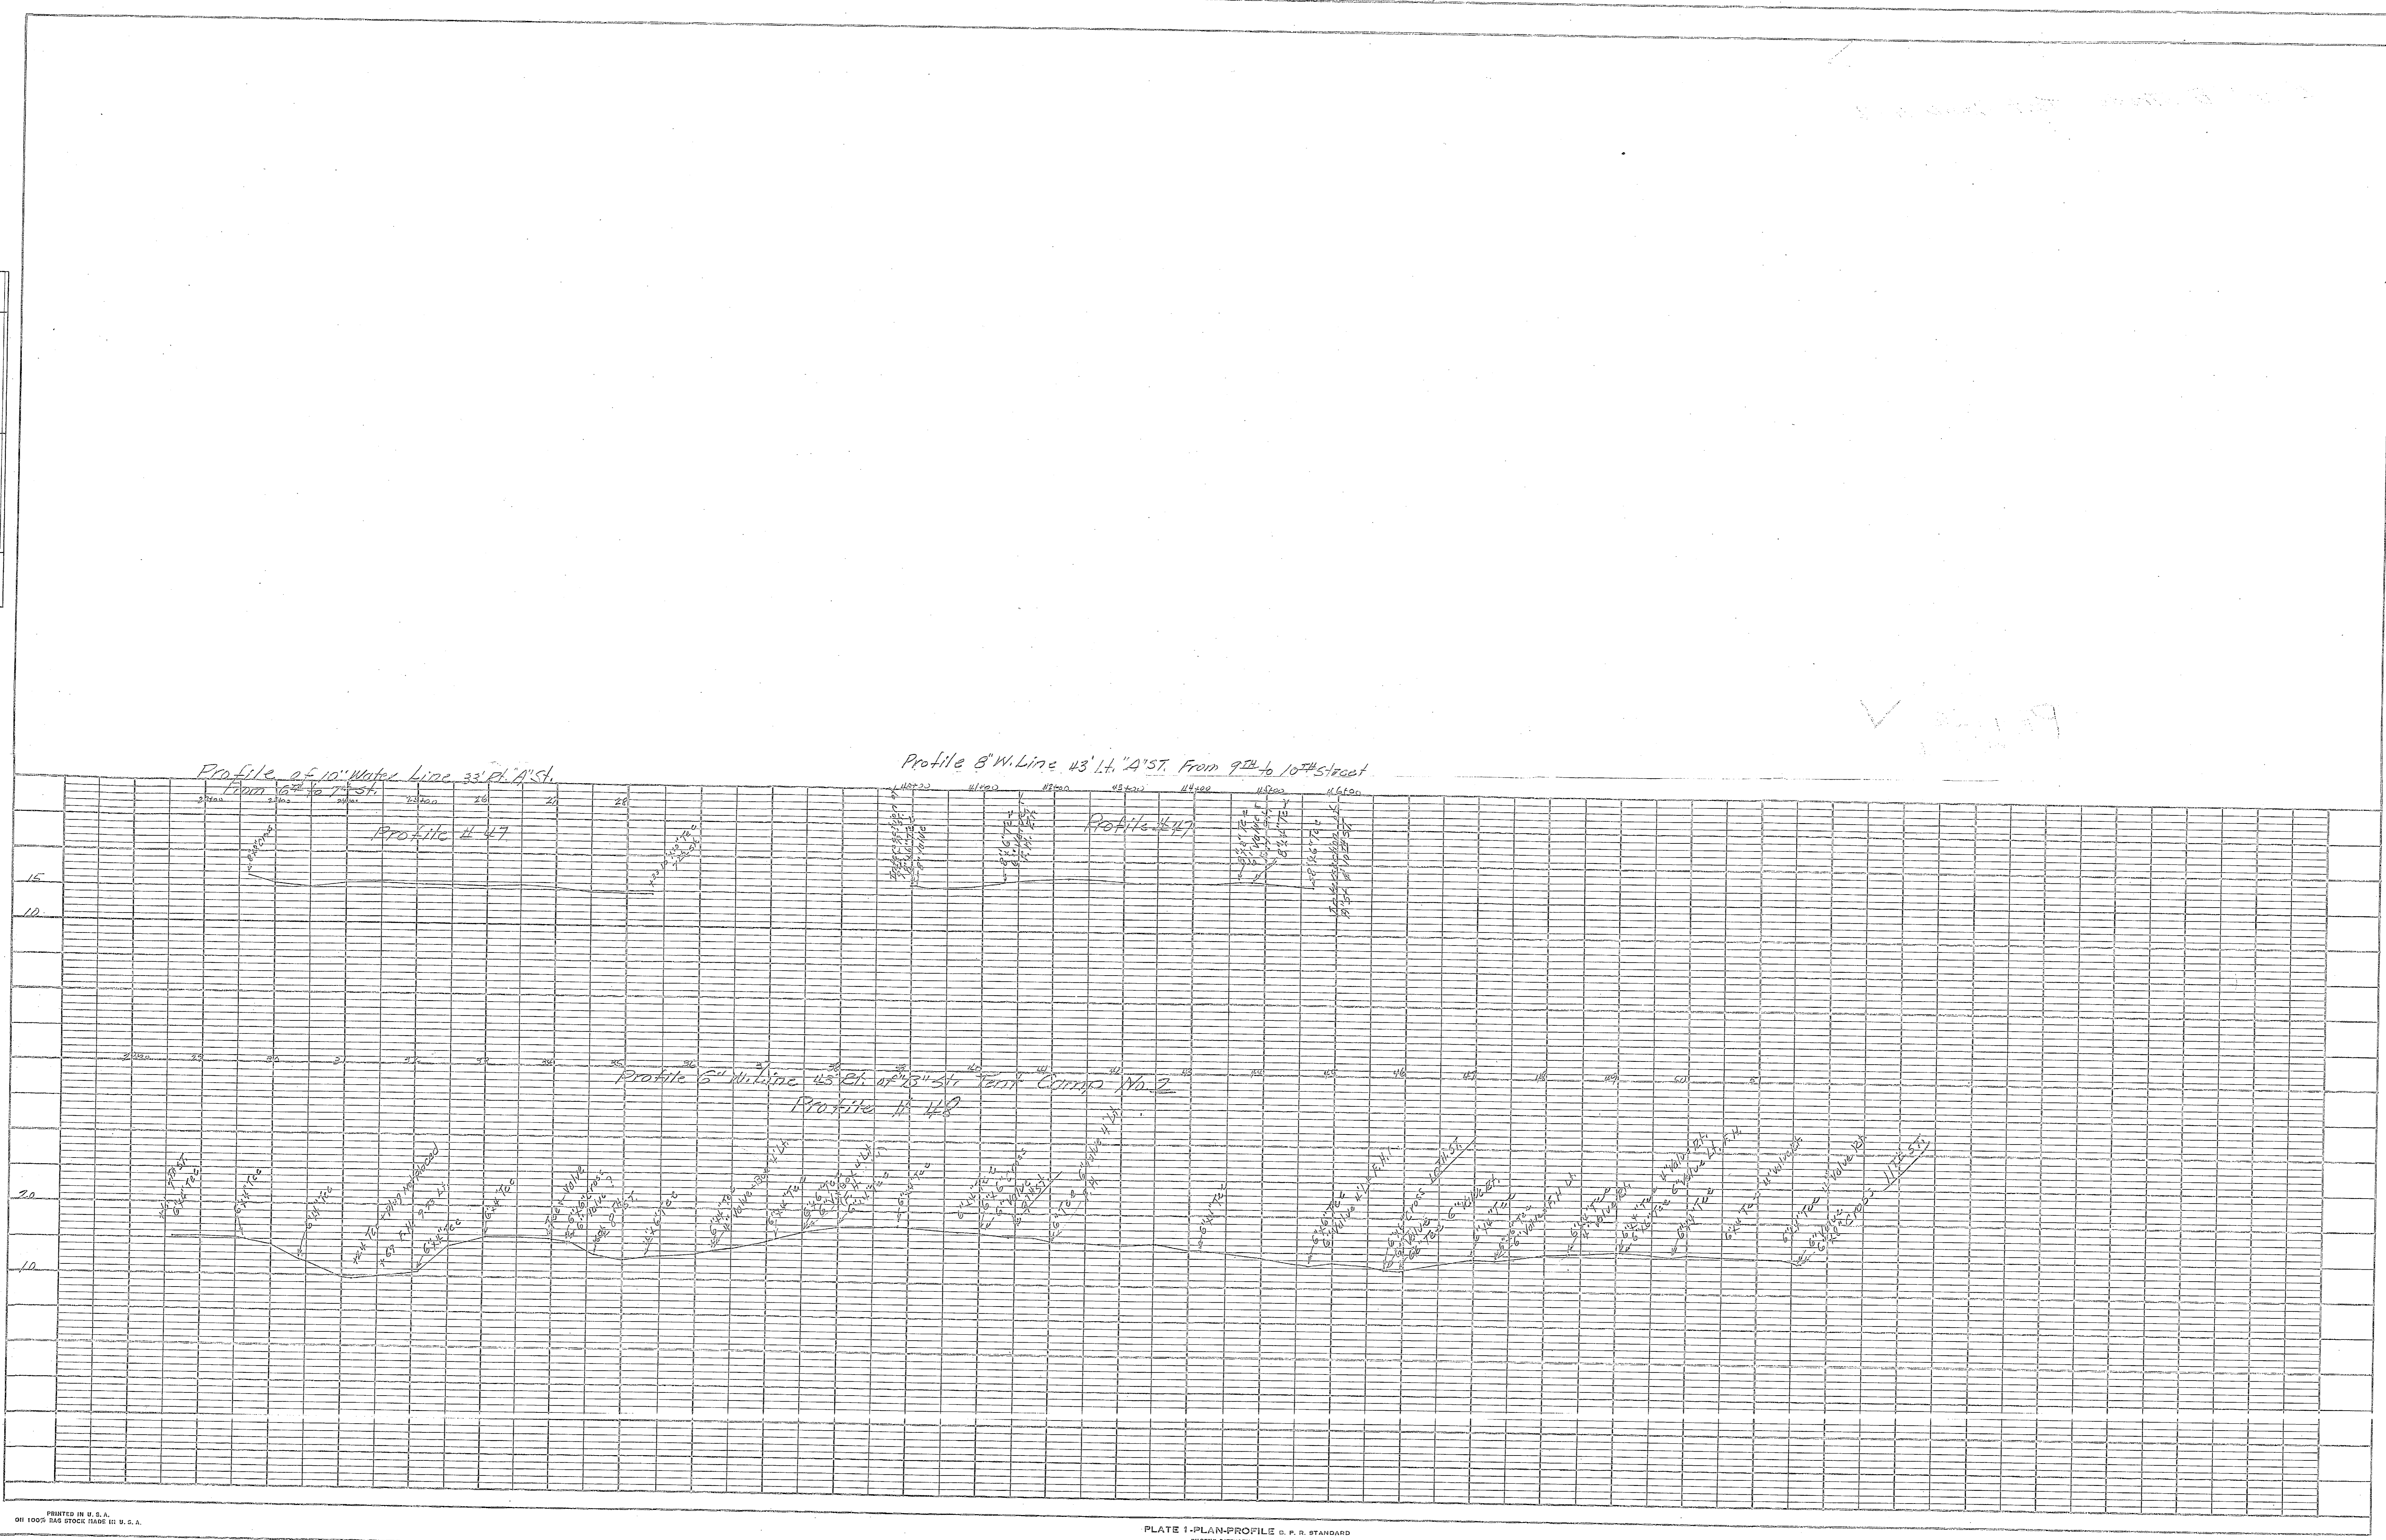



"A" and "B" Streets Test Comp No. 2

PROFILE "V"  
Plotted

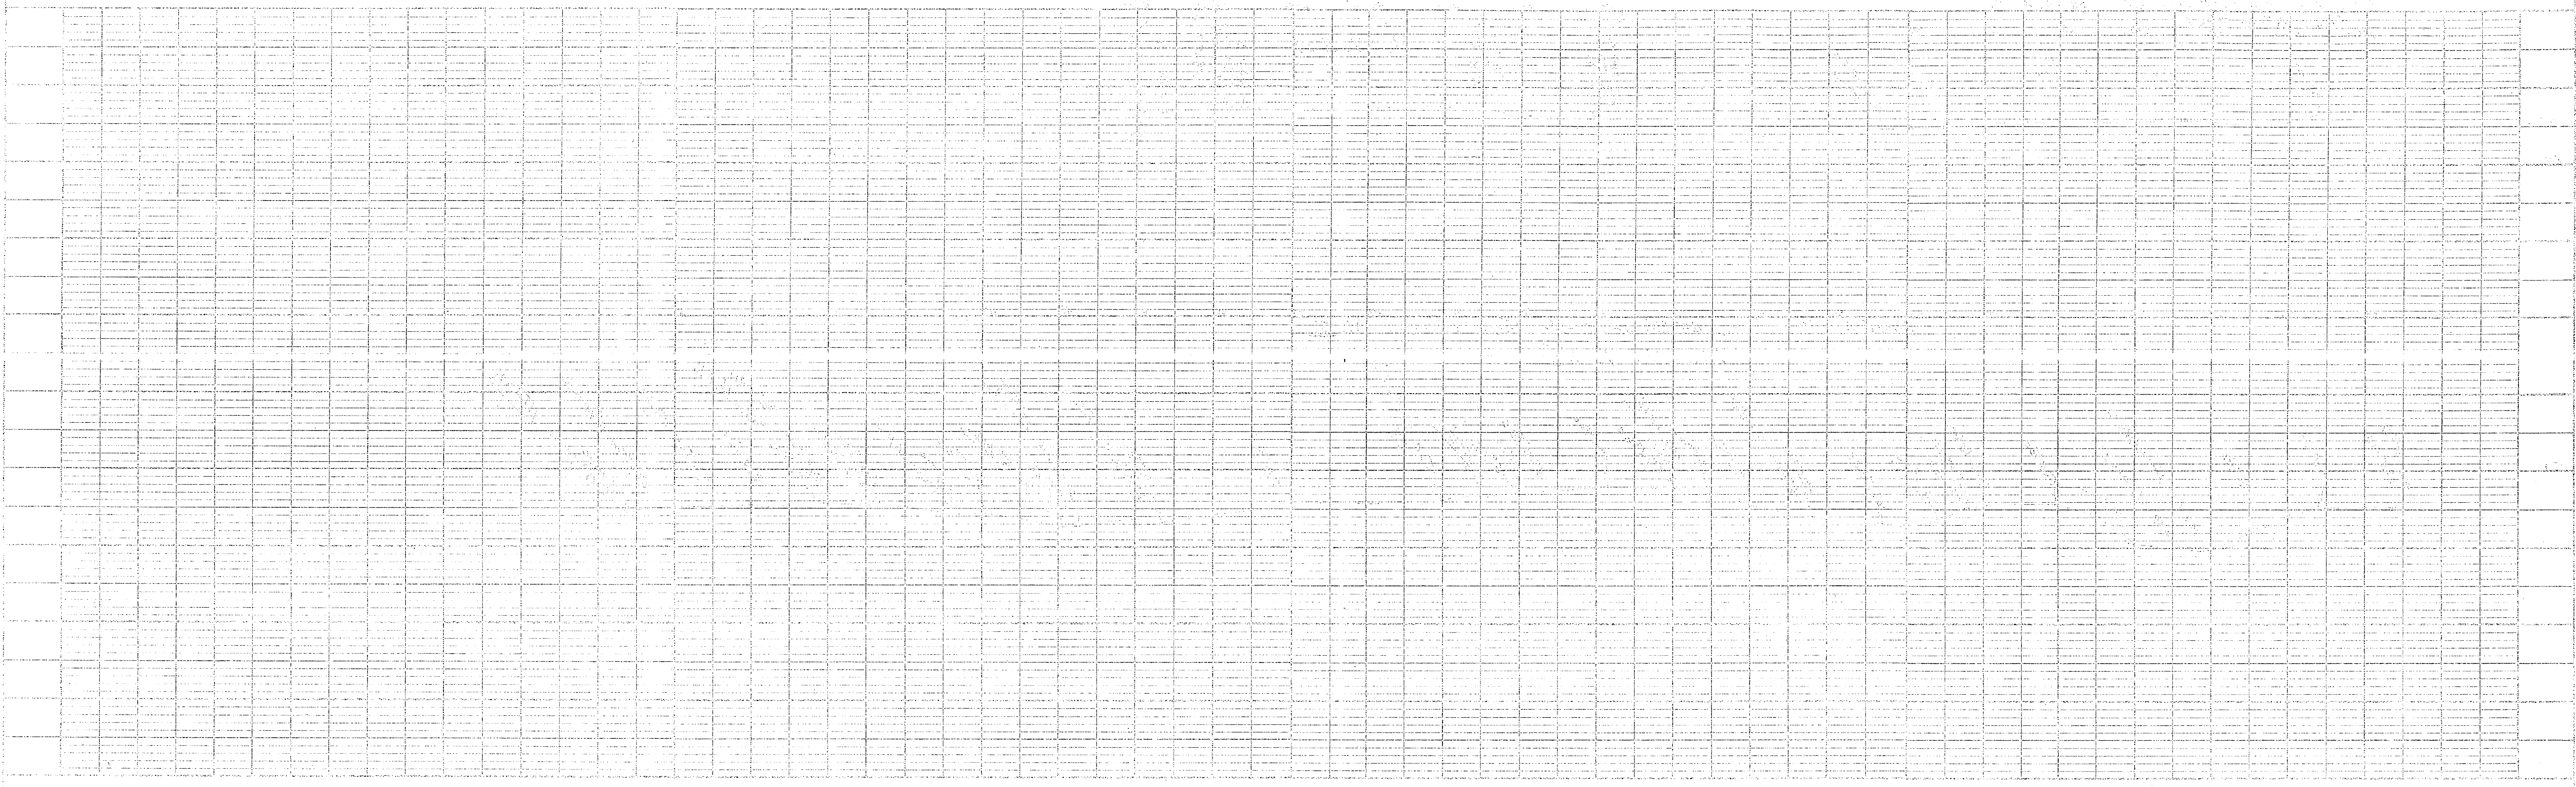




DATE	
PROJECT NO.	
SCALE	
BY	
CHECKED	

DATE	
PROJECT NO.	
SCALE	
BY	
CHECKED	

DATE	
BY	
PROJECT	
ADJUSTMENT CHECKED	
NOTE BOOK	
NO. OF WET CHECKS	
PLAN	
NOTE BOOK	
NO.	

DATE	
BY	
PROJECT	
ADJUSTMENT CHECKED	
NOTE BOOK	
NO. OF WET CHECKS	
PROFILE	
NOTE BOOK	
NO.	

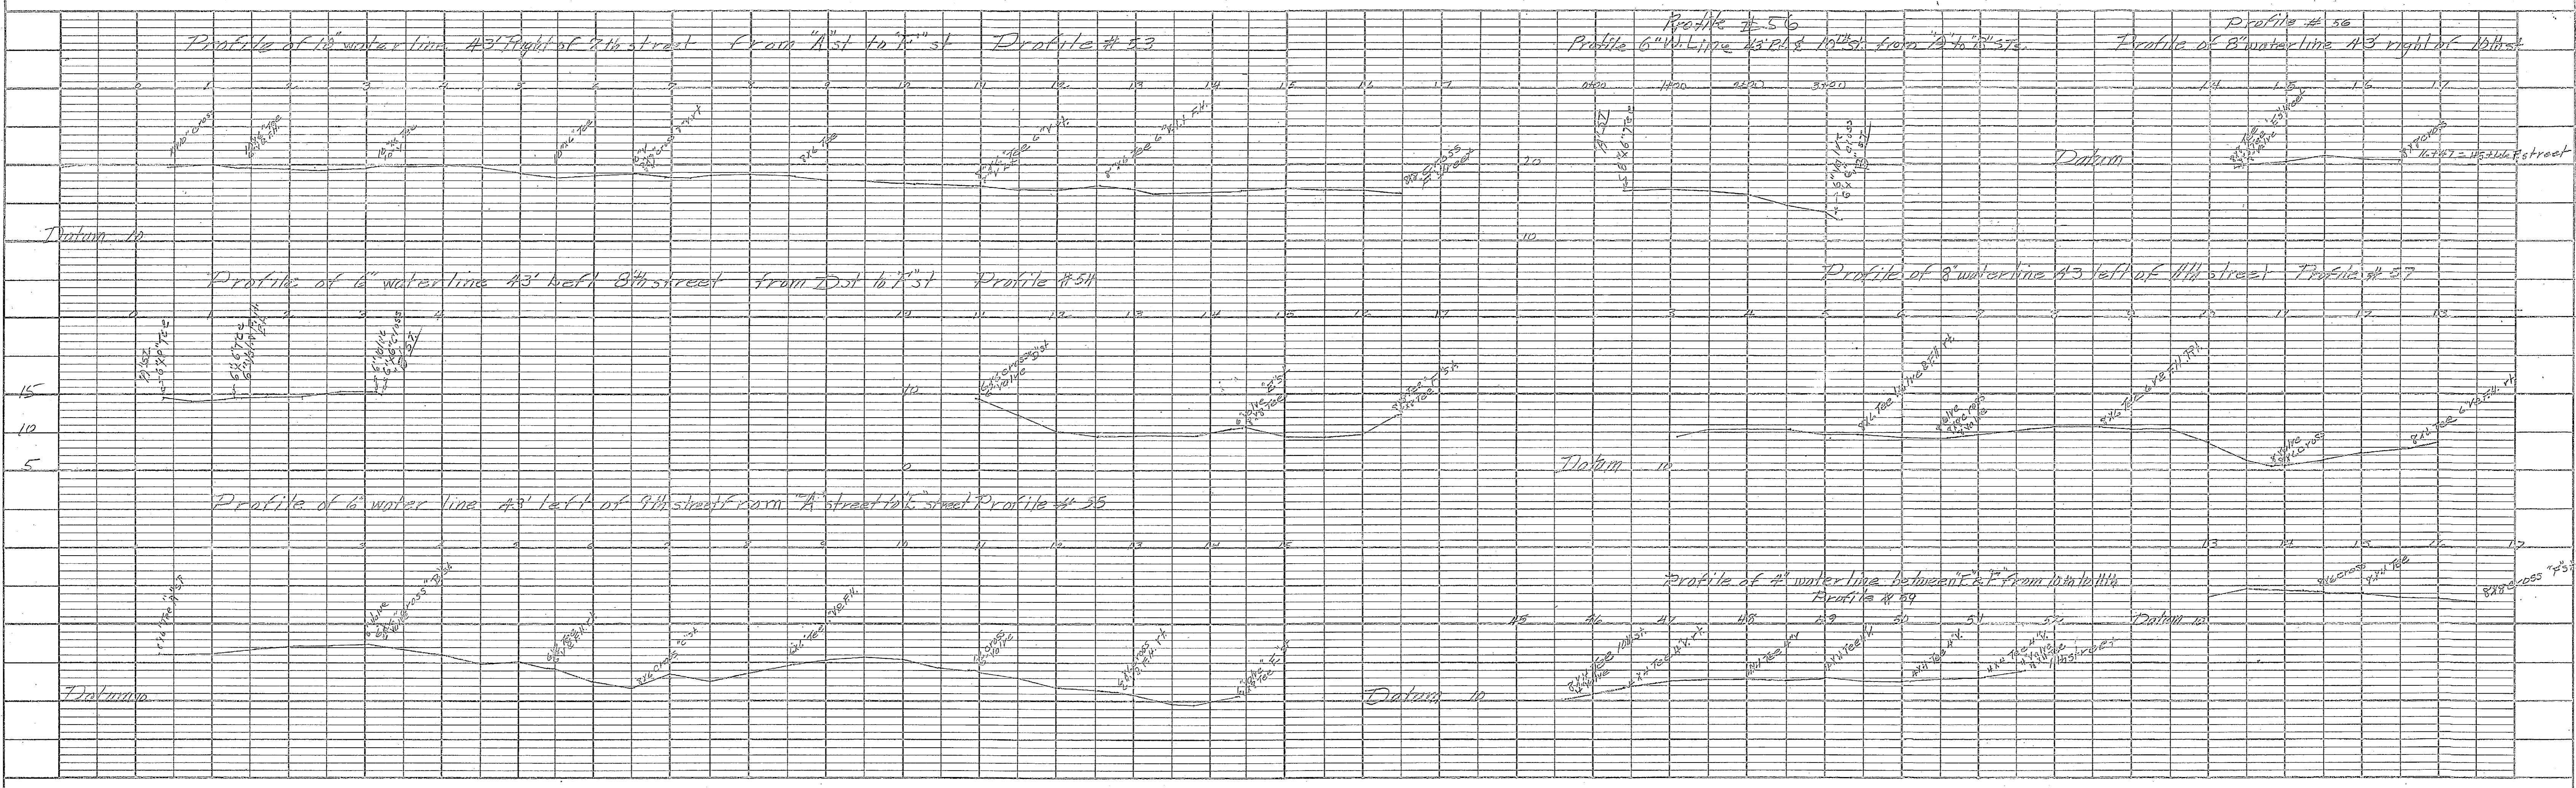

 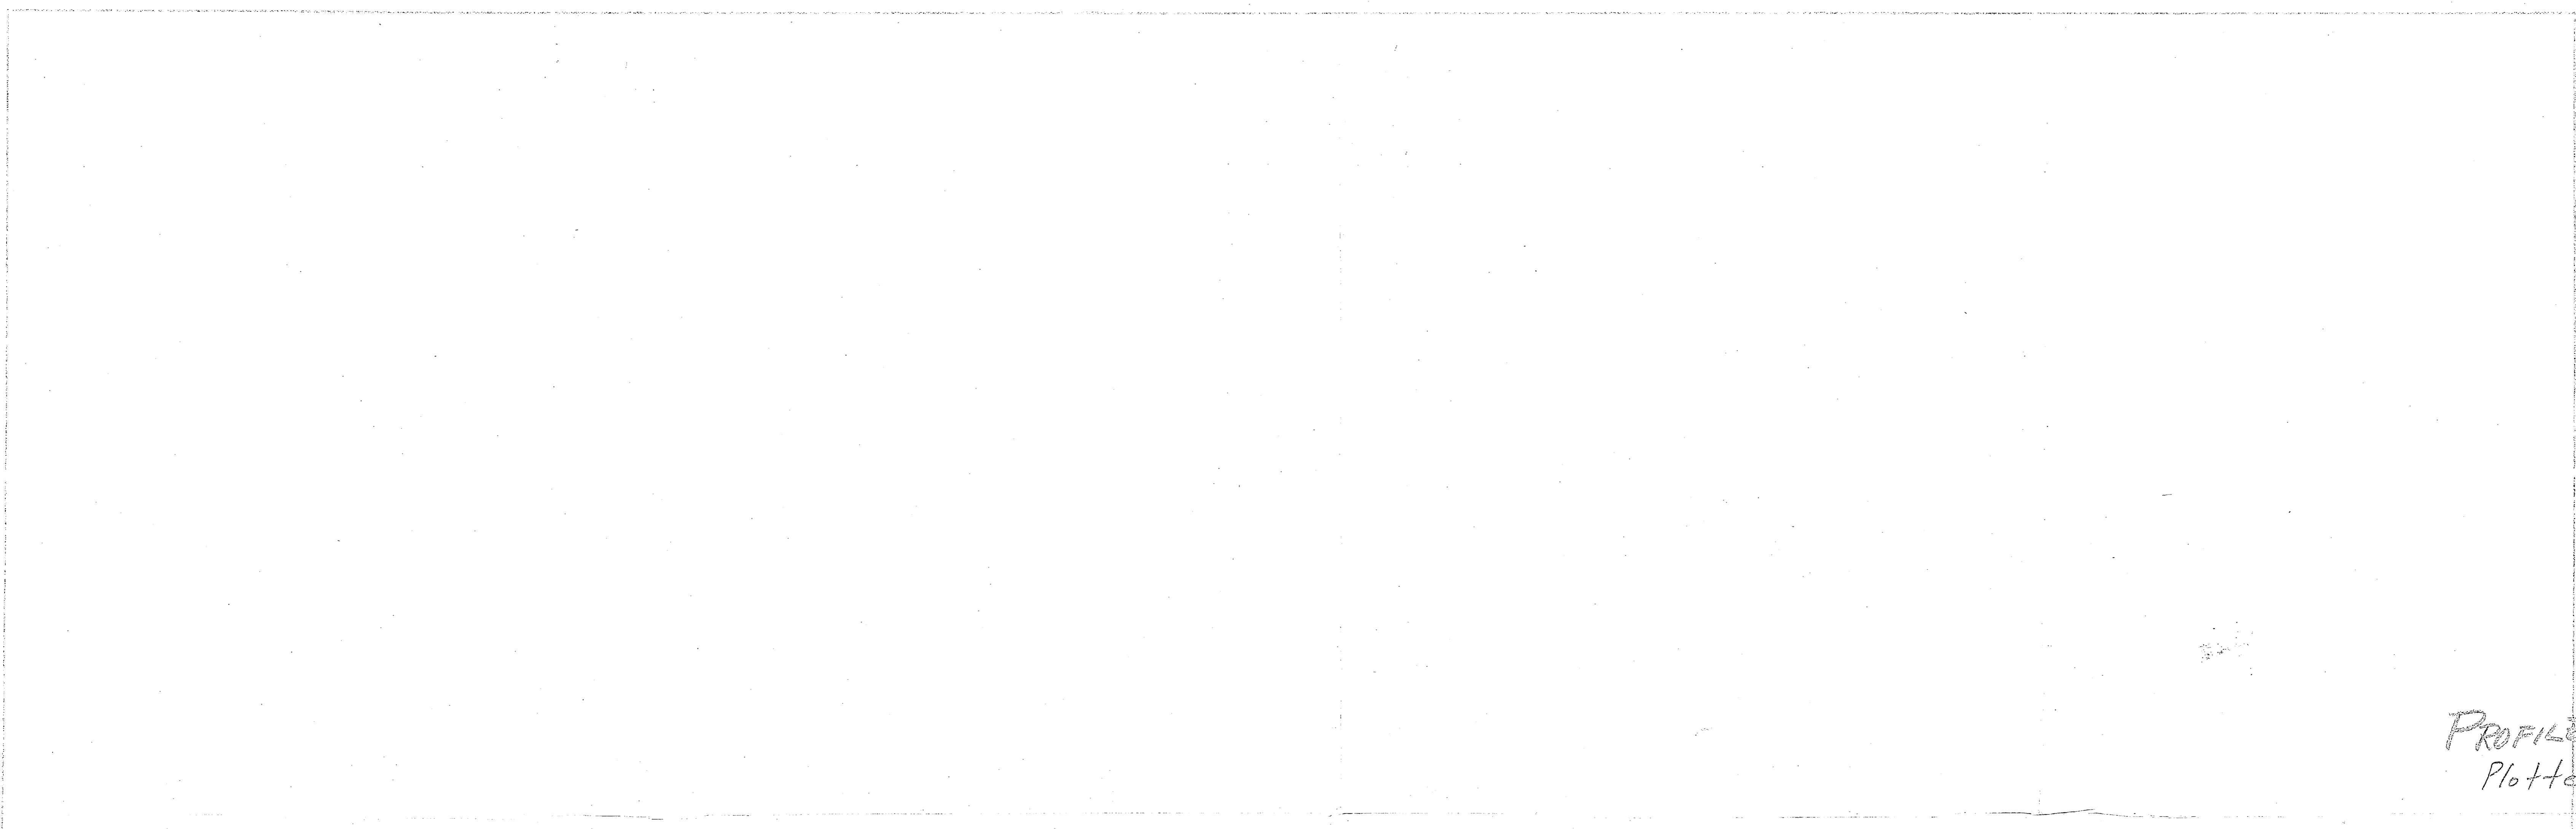

PROFILE "U"  
Plotted


DATE	
BY	
CHECKED	
APPROVED	

DATE	
BY	
CHECKED	
APPROVED	

PLAN	DATE
NO. 10.	
DESIGNED BY	
CHECKED BY	
APPROVED BY	
DATE	

PROFILE	DATE
NO. 10.	
DESIGNED BY	
CHECKED BY	
APPROVED BY	
DATE	

Profile of 8" C.I. Water line 43' Rt. "C" Street - Tent Camp #2

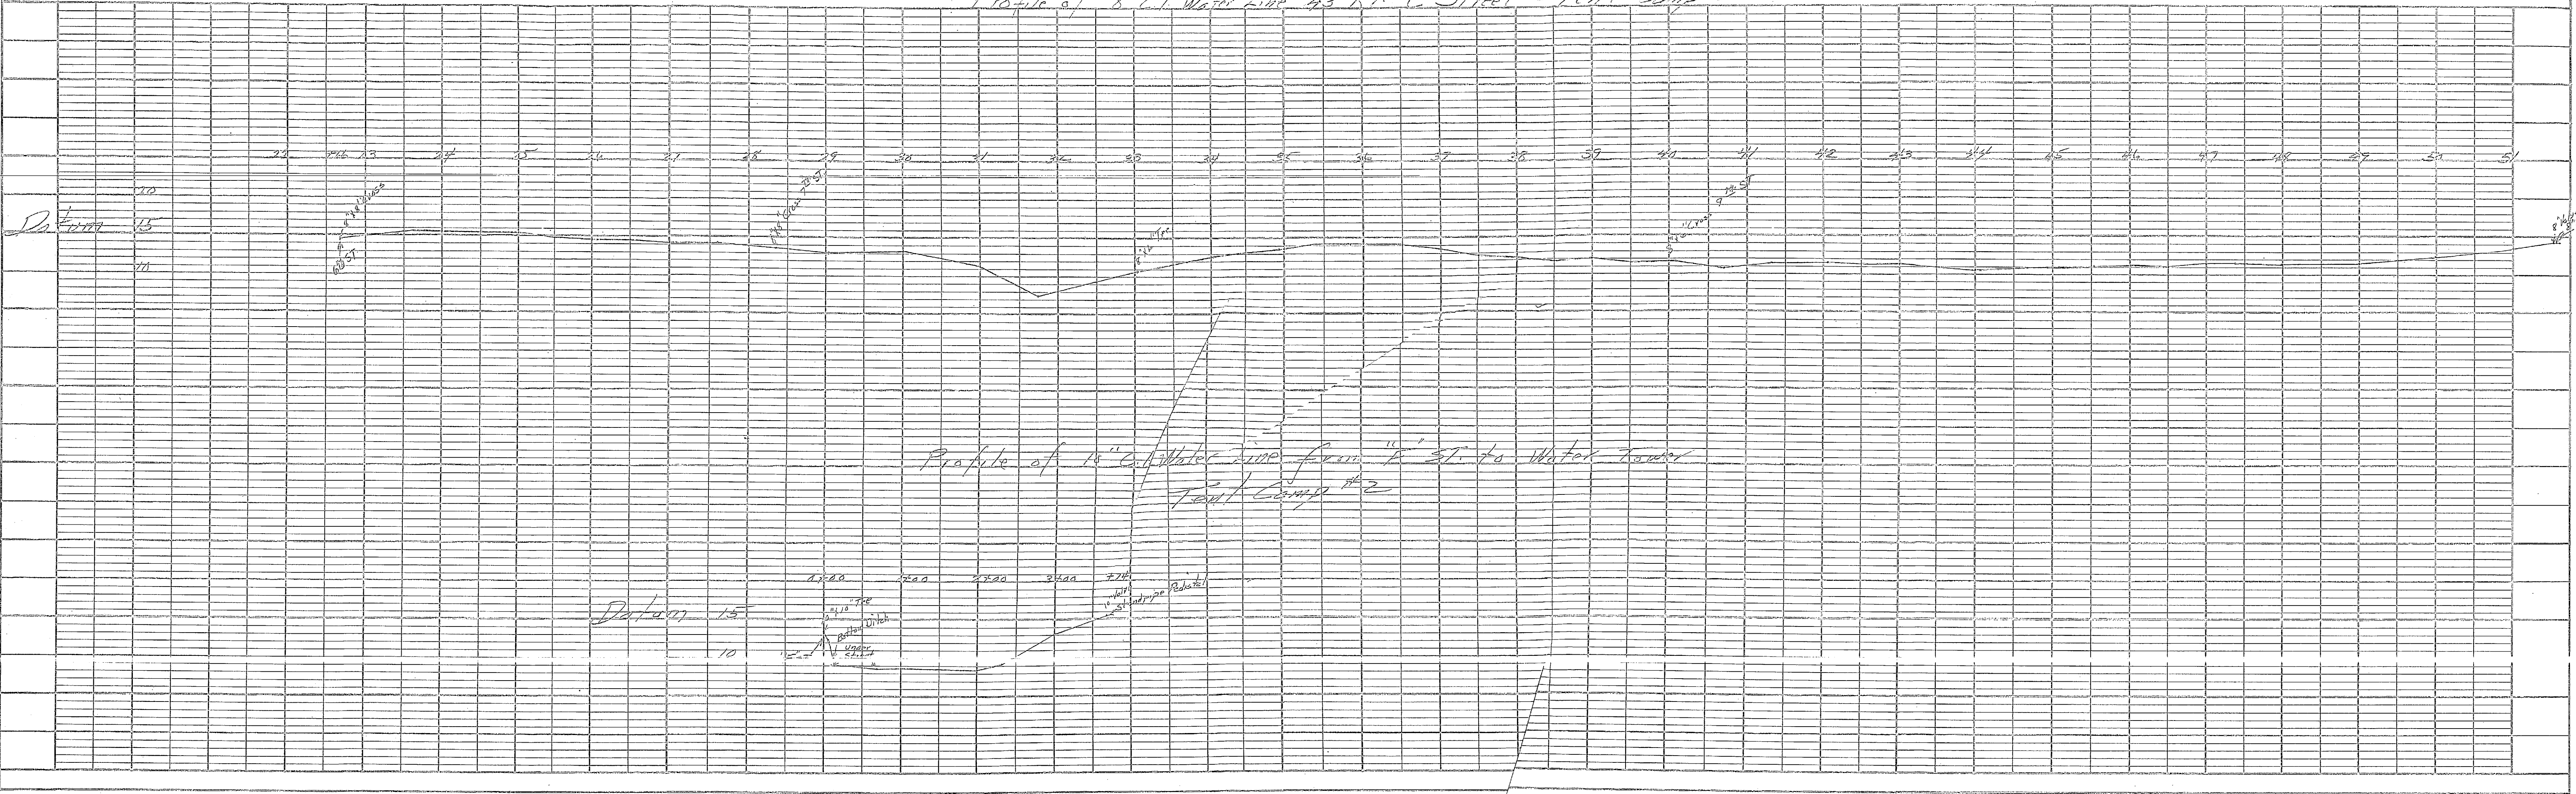

PROFILE T  
Plotted




 



DATE	
BY	
CHECKED	
APPROVED	
REVISIONS	
NO.	


DATE	
BY	
CHECKED	
APPROVED	
REVISIONS	
NO.	

PROFILE 6" C.I. Water Line 43' Lt. of 6<sup>th</sup> St. TENT CAMP No. 2

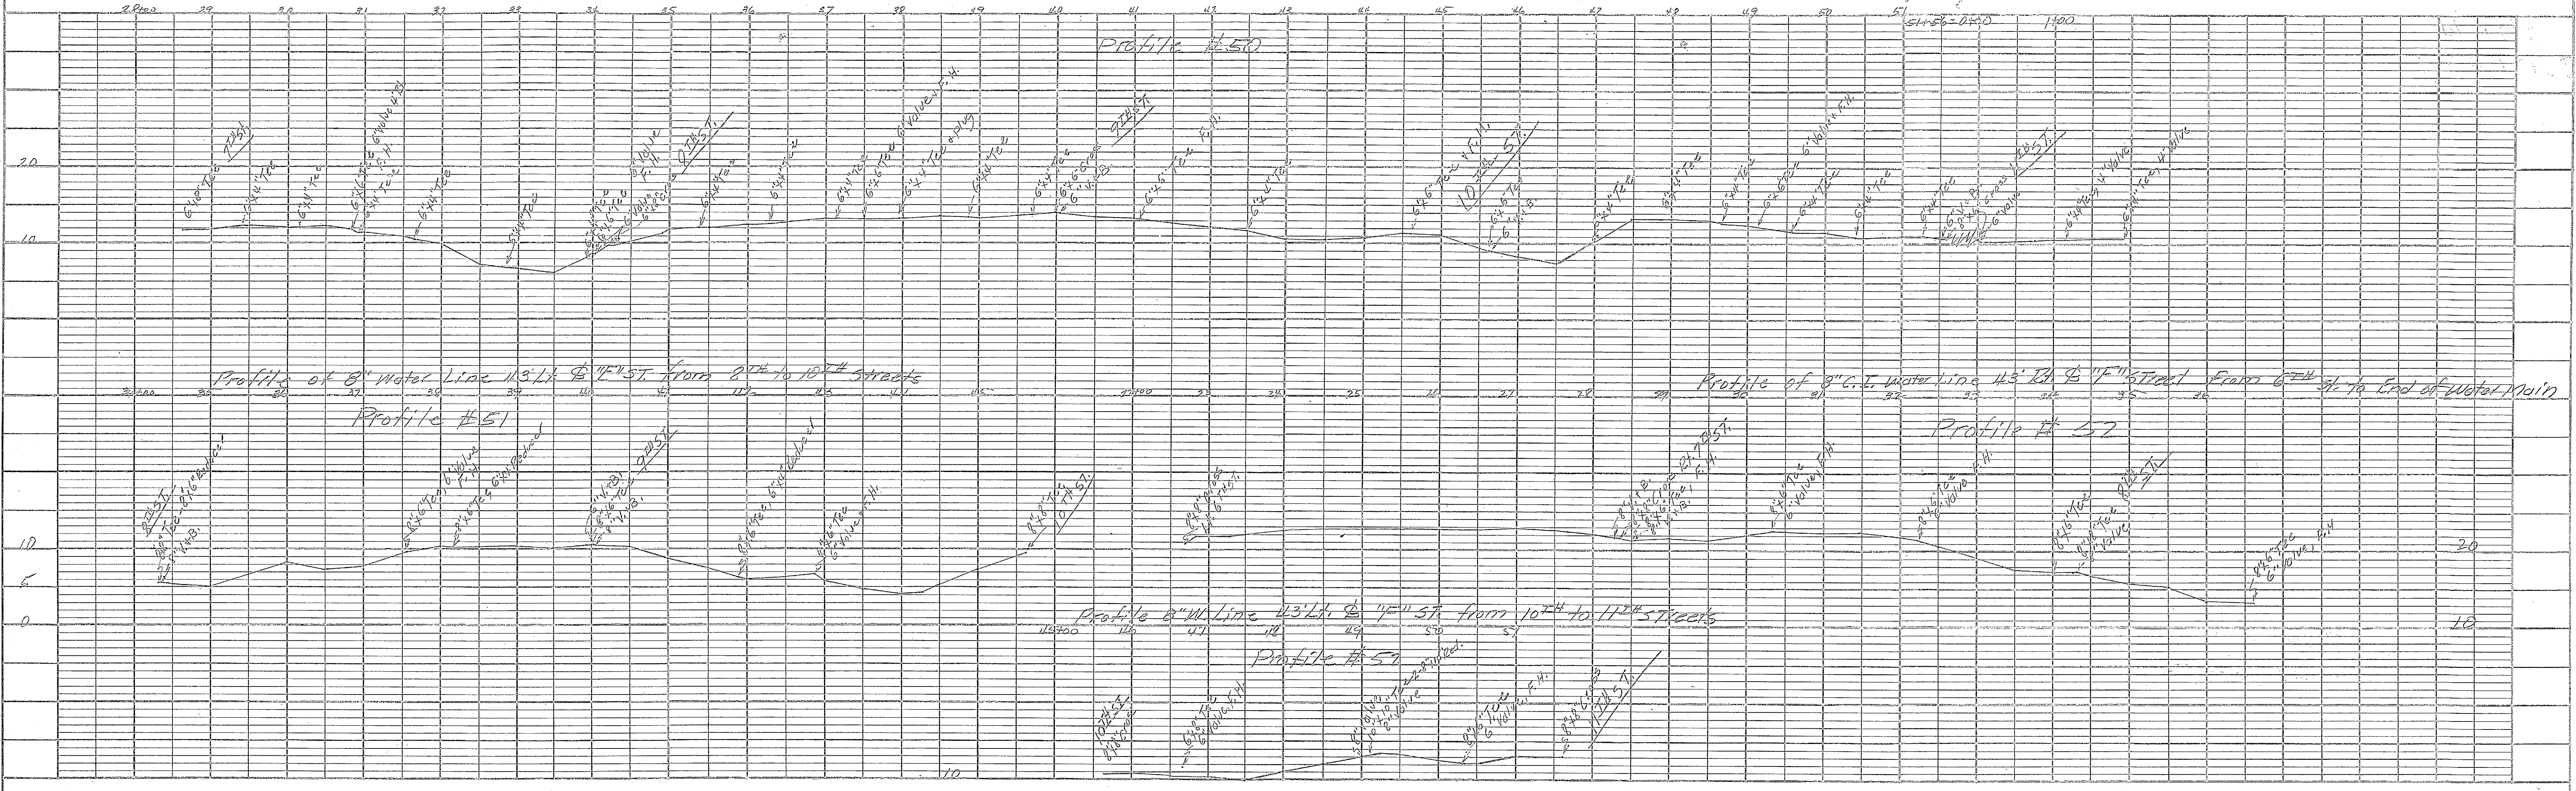



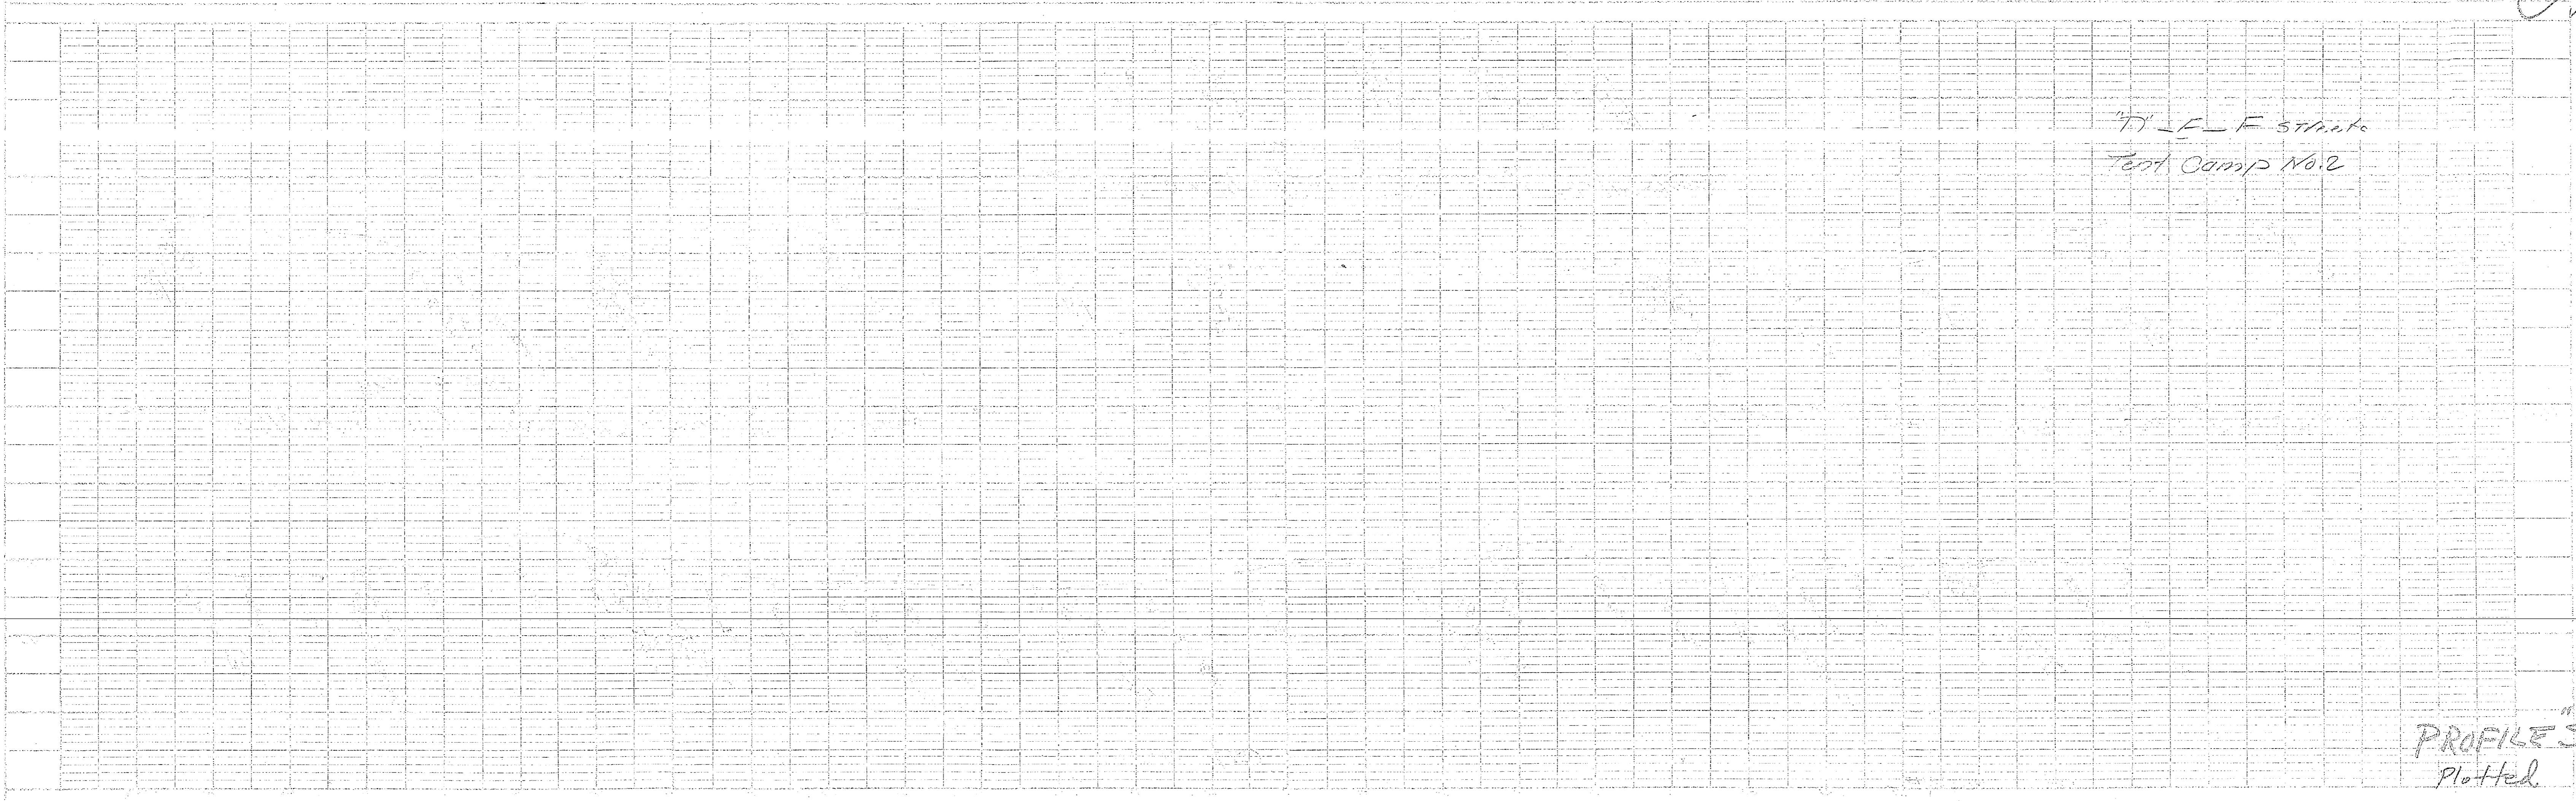


"PROFILES"  
Plotted



Profile of 10" Transit Water Line from Well "M" (along Access Road to Landing Field) to Clear Water Storage in Tent Camp #1.

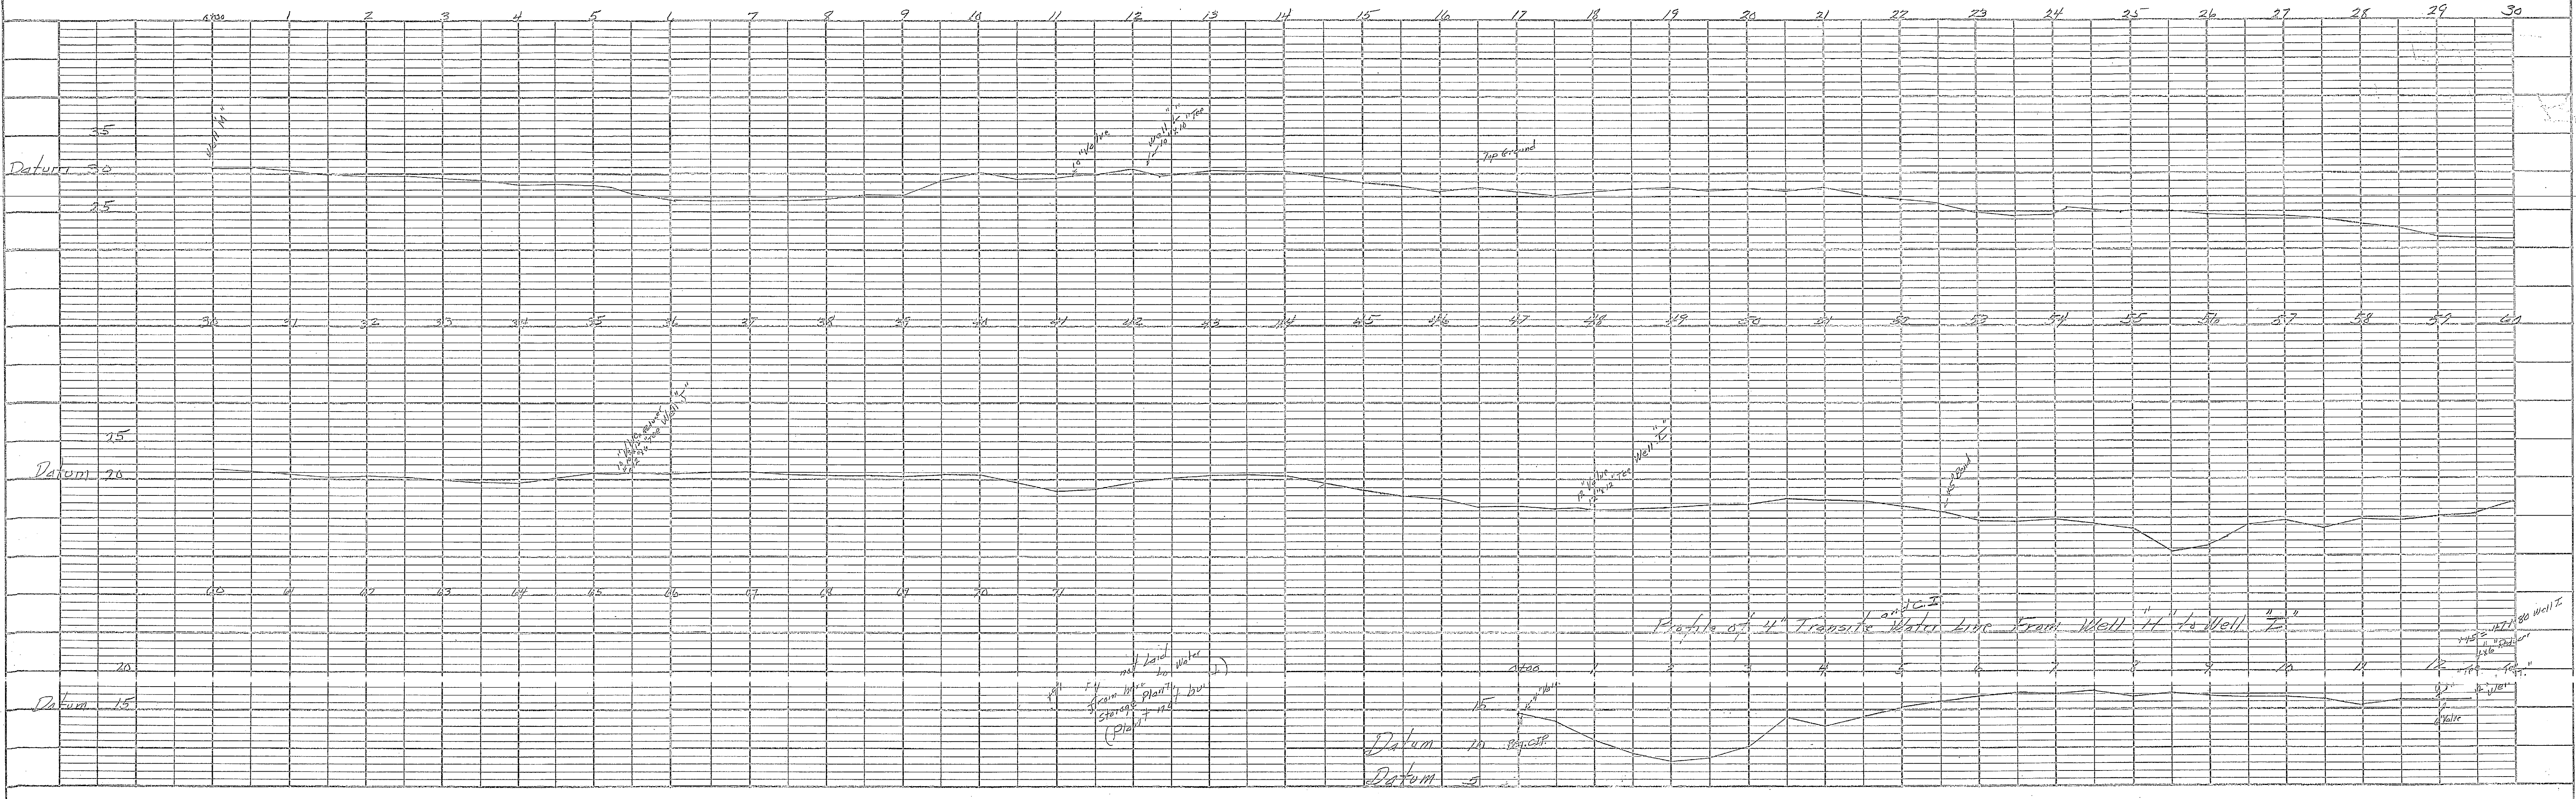







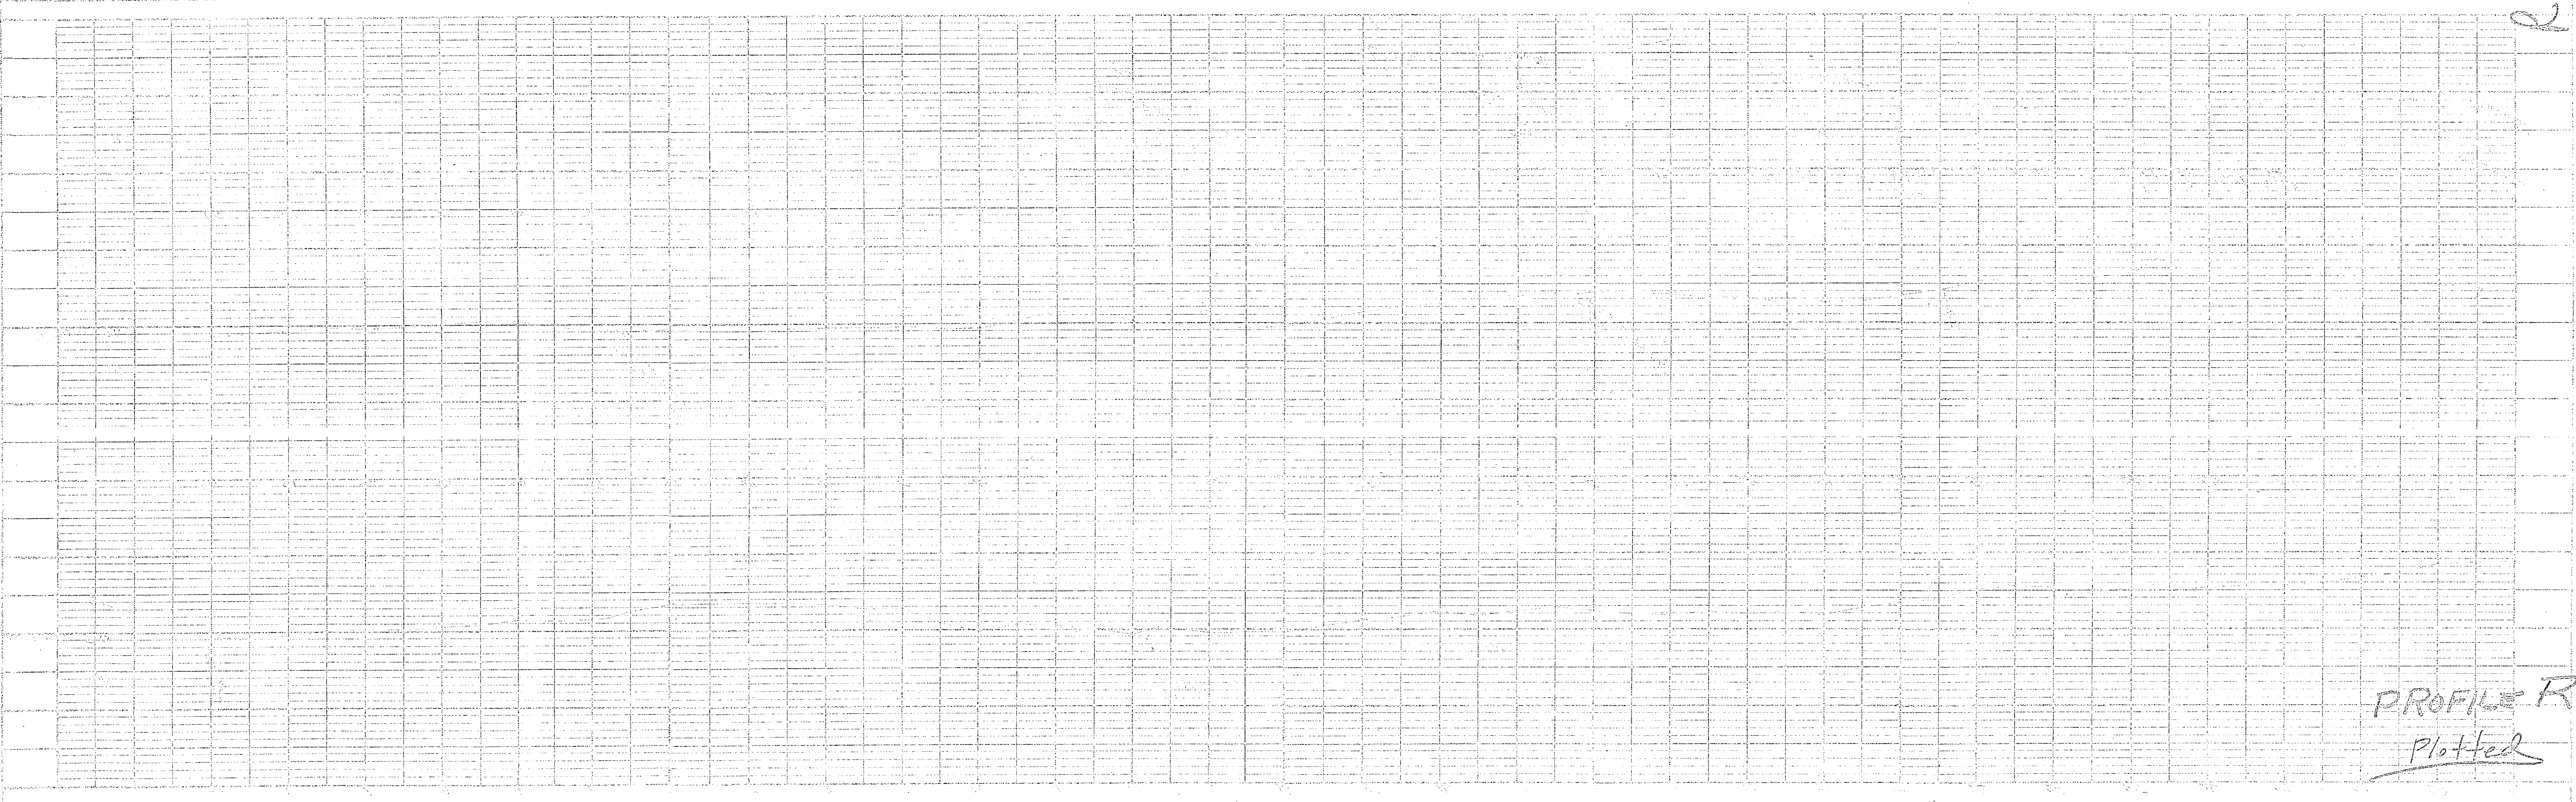

PROFILE R  
Plotted


# Over Size Form

Too Large

Bound Book

Fragile

Other \_\_\_\_\_

Sheet Number: \_\_\_\_\_

Drawing/NAVFAC Number: \_\_\_\_\_

## Title


Req # 4

PROFILE P

PLOTTED

PROFILE WATER LINE

#4?

 

PRINTED IN U.S.A.  
ON 100% RAG PAPER MADE IN U.S.A.

30" x 40" PROFILE  
PLATE A  
ENGINEER DISTINGEN CO.




