

VALUABLE

RETURN TO  
PUBLIC WORKS  
OFFICE,  
CAMP LEJEUNE  
NEW RIVER, N. C.

SUBJECT transverse for sprinkling  
system Golf course

Course #2

FIELD PARTY

H. Waters  
IN CHARGE  
INSTRUMENT  
NOTES  
TAPE READ  
TAPE OR ROD  
TAPE OR ROD  
INSTRUMENT NO.  
TAPE NO.

WEATHER

CLEAR  
CLOUDY  
WINDY  
RAIN  
FAIR  
SNOW  
HOT  
MODERATE  
COLD  
FOG

FILE No. 119 N-5


FLDR. No. \_\_\_\_\_

SHEET 1 of 15

NOTES CHECKED BY \_\_\_\_\_

FIGURED BY \_\_\_\_\_ DATE 5-30 1945

PLOTTED BY \_\_\_\_\_  
Quad. No. 119

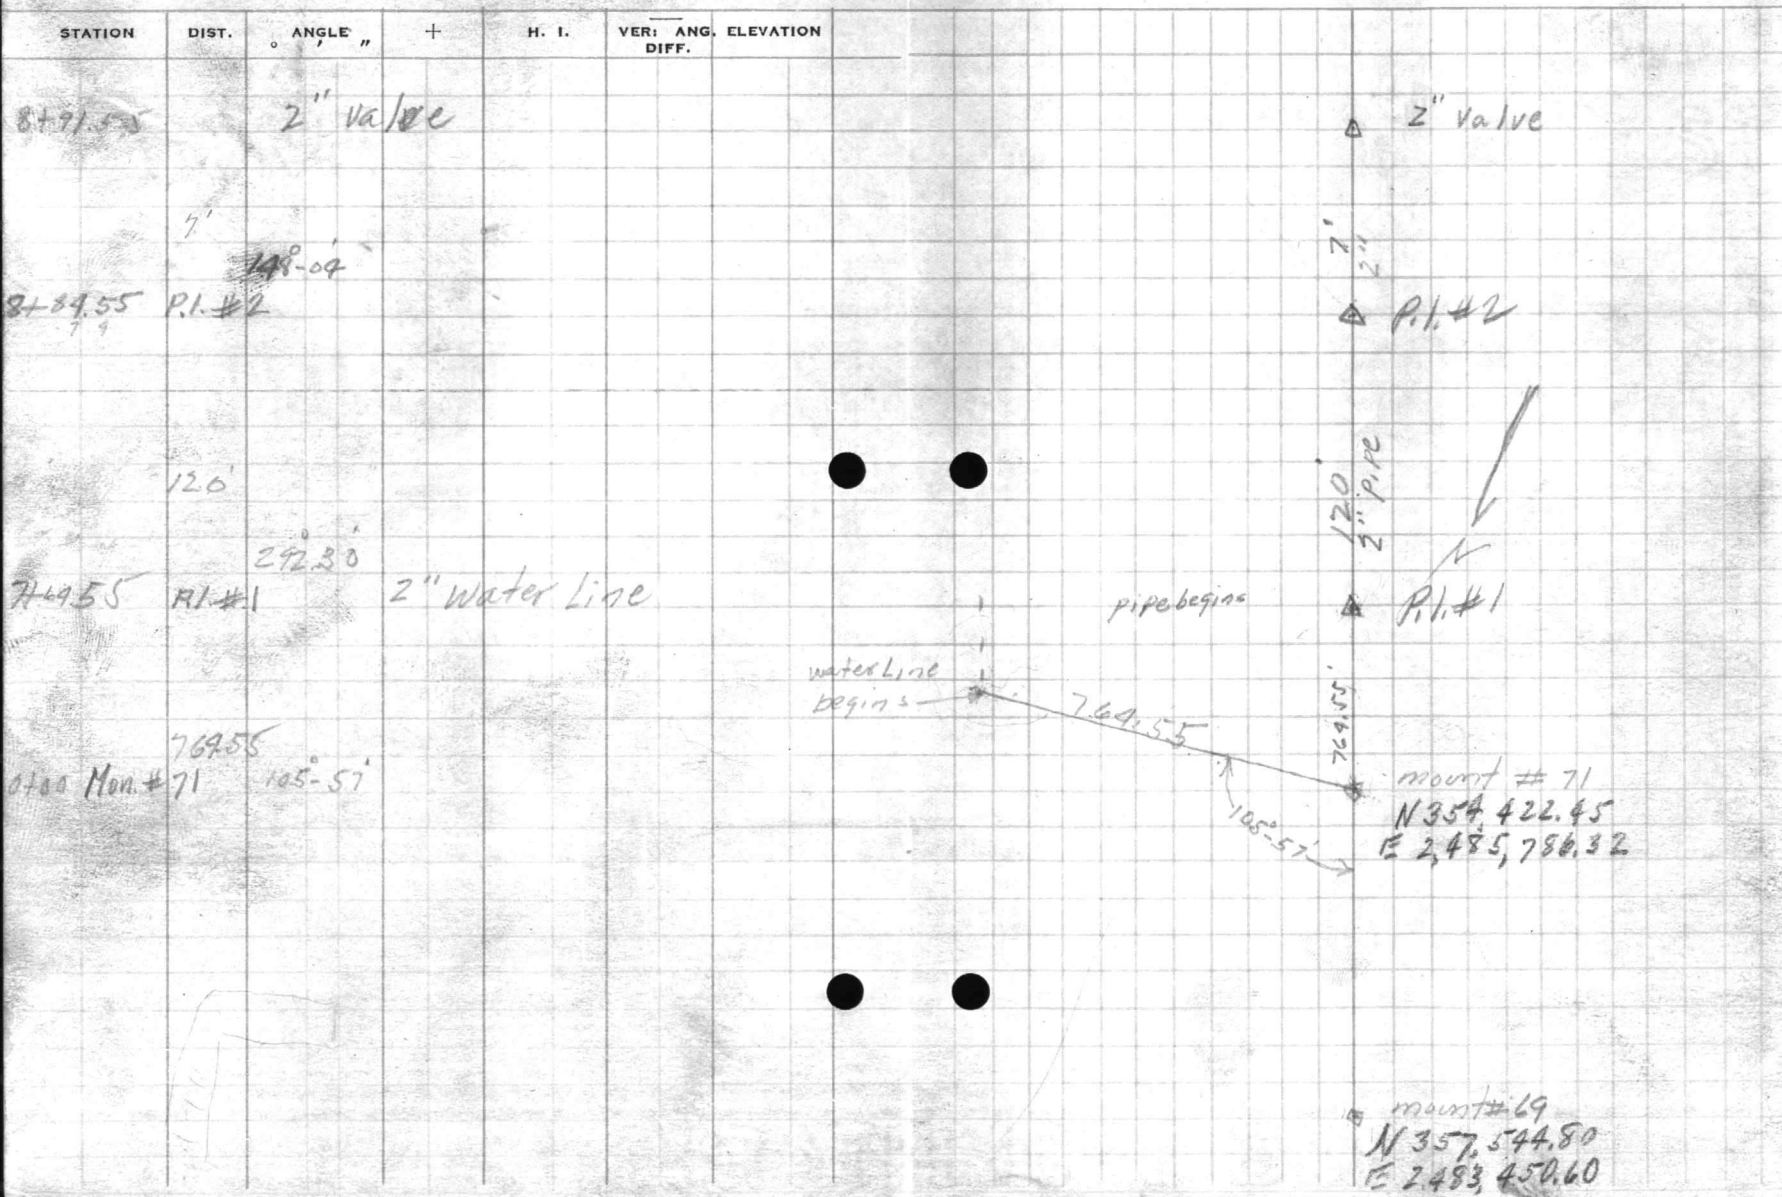

640  
330  
+ 114  
-----  
828

**VALUABLE**RETURN TO  
PUBLIC WORKS  
OFFICECAMP LEJEUNE  
NEW RIVER, N. C.SUBJECT transverse for sprinkling  
system Golf course

## FIELD PARTY

HL Water IN CHARGE  
 \_\_\_\_\_ INSTRUMENT  
 \_\_\_\_\_ NOTES  
 \_\_\_\_\_ TAPE READ  
 \_\_\_\_\_ TAPE OR ROD  
 \_\_\_\_\_ TAPE OR ROD  
 INSTRUMENT NO. \_\_\_\_\_  
 TAPE NO. \_\_\_\_\_

## WEATHER

CLEAR \_\_\_\_\_ SNOW \_\_\_\_\_  
 CLOUDY \_\_\_\_\_ HOT \_\_\_\_\_  
 WINDY \_\_\_\_\_ MODERATE \_\_\_\_\_  
 RAIN \_\_\_\_\_ COLD \_\_\_\_\_  
 FAIR \_\_\_\_\_ FOG \_\_\_\_\_

FILE No. 119-N-5

FLDR. No. \_\_\_\_\_

FIGURED BY \_\_\_\_\_ SHEET 2 of 15

NOTES CHECKED BY \_\_\_\_\_

PLOTTED BY \_\_\_\_\_ DATE 5-30 1945Quad. No. 119

STATION	DIST.	ANGLE "	+	H. I.	VER. ANG. DIFF.	ELEVATION
20+08.5		4" valve				4" valve
	1586					158.1 4"
18+49.75		4" Line Begins 4" x 3" Reducer				3x4" Reducer
	7130					713 3"
17+94.10		Rt. H. 2" Lateral "A"				2" Lateral "A" 3x2" Tee see sheets 7+8
	552.55					552.55 3"
12+41.55		2" x 3" Reducer 3" water Line				2x3 Reducer
	350					350 2"
<del>8+71.55</del>		<del>45.54</del>				

273

340  
750

21155  
10557

30  
2730  
5750

30  
27














**VALUABLE**

RETURN TO  
PUBLIC WORKS  
OFFICE

CAMP LEJEUNE  
NEW RIVER, N. C.

SUBJECT transverse for sprinkling  
system Golf course

FIELD PARTY  
R. H. Lateral IN CHARGE  
INSTRUMENT \_\_\_\_\_  
NOTES \_\_\_\_\_  
TAPE READ \_\_\_\_\_  
TAPE OR ROD \_\_\_\_\_  
TAPE OR ROD \_\_\_\_\_  
INSTRUMENT No. \_\_\_\_\_  
TAPE No. \_\_\_\_\_

WEATHER  
CLEAR \_\_\_\_\_ SNOW \_\_\_\_\_  
CLOUDY \_\_\_\_\_ HOT \_\_\_\_\_  
WINDY \_\_\_\_\_ MODERATE \_\_\_\_\_  
RAIN \_\_\_\_\_ COLD \_\_\_\_\_  
FAIR \_\_\_\_\_ FOG \_\_\_\_\_

FILE No. 119 N-2  
FLDR. No. \_\_\_\_\_  
SHEET 30 of 15  
NOTES CHECKED BY \_\_\_\_\_  
DATE 5-30 1945  
PLOTTED BY \_\_\_\_\_  
Quad. No. 119

STATION	DIST.	ANGLE "	+	H. I.	VER: ANG. ELEVATION DIFF.
WT 61.70 P.I. #4					
R. H. Lateral					"C"
					1" x 4" tee
					P.I. #4 1" Lateral "C" See page 14
226.2					
		179.07			
					226.2 4"
WT 35.50 P.I. #3					
L. H. Lateral					"B"
					3" Lateral B See pages 9-13
					P.I. #3
27.15					
					27.15 4"
20408.35					








7/10  
375

VALUABLE

SUBJECT

Waters system Golfcourse

RETURN TO  
PUBLIC WORKS  
OFFICE

CAMP LEJEUNE  
NEW RIVER, N. C.

FIELD PARTY

*W. L. Waters* IN CHARGE

INSTRUMENT

NOTES

TAPE READ

TAPE OR ROD

TAPE OR ROD

INSTRUMENT NO.

TAPE NO.

WEATHER

CLEAR SNOW  
CLOUDY HOT  
WINDY MODERATE  
RAIN COLD  
FAIR FOG

FILE No. *119 N-5*

FLDR. No. \_\_\_\_\_

FIGURED BY \_\_\_\_\_ SHEET *4 of 15*

NOTES CHECKED BY \_\_\_\_\_

PLOTTED BY \_\_\_\_\_ DATE *5-30* 19*45*

Quad. No. *119*

STATION	DIST.	ANGLE "	+	H. I.	VER: ANG DIFF.	ELEVATION
24+41.2 = P.I. #6						
	22.1					
24+19.10 Lateral				D	R.H.	
	48.1	157° 51'				
23+71.00 P.I. #5						
	109.3					
		179° 45'				
22+61.70						

4" valve P.I. #6

1" Lateral "D" se page 15

17x4" tee

P.I. #5

4" 22.1 4" 48.1 4" 109.3 4"

























VALUABLE

SUBJECT

Water system golf course

RETURN TO PUBLIC WORKS OFFICE

CAMP LEJEUNE NEW RIVER, N. C.

FIELD PARTY  
~~N.L. WATSON~~ IN CHARGE  
 \_\_\_\_\_ INSTRUMENT  
 \_\_\_\_\_ NOTES  
 \_\_\_\_\_ TAPE READ  
 \_\_\_\_\_ TAPE OR ROD  
 \_\_\_\_\_ TAPE OR ROD  
 \_\_\_\_\_ INSTRUMENT NO.  
 \_\_\_\_\_ TAPE NO.

WEATHER  
 CLEAR SNOW  
 CLOUDY HOT  
 WINDY MODERATE  
 RAIN COLD  
 FAIR FOG

FILE No. 119 N-5  
 FLDR. No. \_\_\_\_\_  
 SHEET 5 of 15  
 DATE 5-30 1945  
 Quad. No. 119

STATION	DIST.	ANGLE "	+	H. I.	VER. ANG. DIFF.	ELEVATION
33+51.03 PI	900	188° 18'			60° 18'	
		86° 37'			value on 8" main	
29+51.03 PI #7	9.43	172° 26'			8" main Reducer 4" X 8"	
29+41.2						

Charles st

No. P.I.P.E. 900'

5' man

86° 37'

Line

P.I. #7

7.83 4"

Drivel





VALUABLE.

SUBJECT \_\_\_\_\_

RETURN TO  
PUBLIC WORKS  
OFFICE  
CAMP LEJEUNE  
NEW RIVER, N. C.

*Water system golf course*

FIELD PARTY

*Hit water* IN CHARGE

INSTRUMENT \_\_\_\_\_

NOTES \_\_\_\_\_

TAPE READ \_\_\_\_\_

TAPE OR ROD \_\_\_\_\_

TAPE OR ROD \_\_\_\_\_

INSTRUMENT No. \_\_\_\_\_

TAPE No. \_\_\_\_\_

WEATHER

CLEAR SNOW  
CLOUDY HOT  
WINDY MODERATE  
RAIN COLD  
FAIR FOG

FILE No. *119 N-5*

FLDR. No. \_\_\_\_\_

FIGURED BY \_\_\_\_\_ SHEET *6 of 15*

NOTES CHECKED BY \_\_\_\_\_

PLOTTED BY \_\_\_\_\_ DATE *5-31 1945*

Quad. No. *119*

STATION	DIST.	ANGLE " +	H. I.	VER. ANG. DIFF.	ELEVATION
<i>43+5624</i>	<i>P.I. =</i>	<i>mount # 71</i>			
<i>100521</i>					
		<i>182°-21'</i>			
<i>33+5103</i>					

78  
981  
672

48  
051  
677

232  
8  
+ 28  
12  
672.9

VALUABLE.

SUBJECT \_\_\_\_\_

RETURN TO  
PUBLIC WORKS  
OFFICE

CAMP LEJEUNE  
NEW RIVER, N. C.

Waters system golf course

A

FIELD PARTY

H. L. Waters IN CHARGE

INSTRUMENT \_\_\_\_\_

NOTES \_\_\_\_\_

TAPE READ \_\_\_\_\_

TAPE OR ROD \_\_\_\_\_

TAPE OR ROD \_\_\_\_\_

INSTRUMENT No. \_\_\_\_\_

TAPE No. \_\_\_\_\_

WEATHER

CLEAR SNOW  
CLOUDY HOT  
WINDY MODERATE  
RAIN COLD  
FAIR FOG

FILE No. 119 N-5

FLDR. No. \_\_\_\_\_


FIGURED BY \_\_\_\_\_ SHEET 7 of 15

NOTES CHECKED BY \_\_\_\_\_

PLOTTED BY \_\_\_\_\_ DATE 5-31-1945

Quad. No. 119

STATION	DIST.	ANGLE "	+	H. I.	VER. ANG. DIFF.	ELEVATION
0+01						
	1.0	269-25				
0+00 = Rt. H. Lateral						
3+24.6 = Base Line						
	.7					
3+23.9						
	71.0					
2+52.9						
	252.9					
17+94.1 Base Line		82 38'				
0+00 = R.T. #						
2" Lateral "A"						

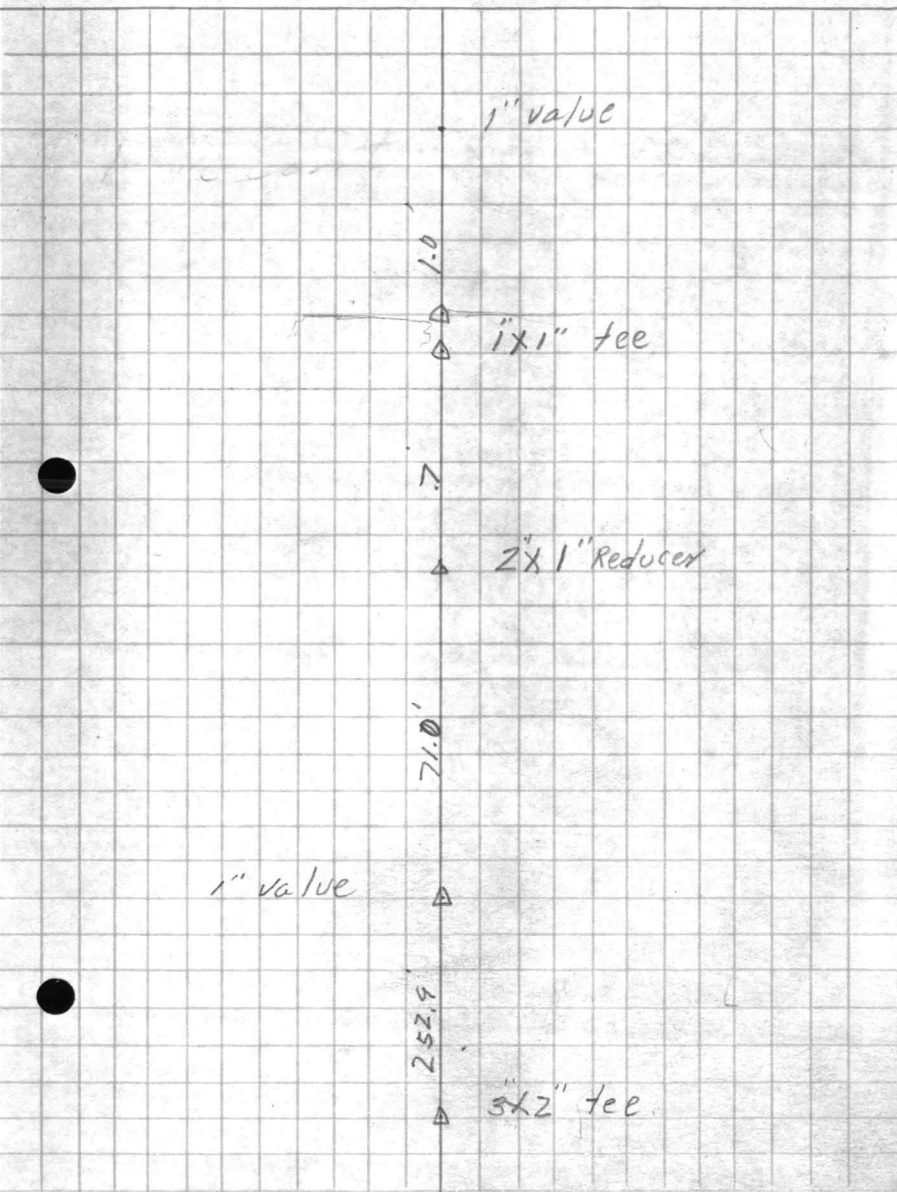

























 

VALUABLE

SUBJECT \_\_\_\_\_

RETURN TO  
PUBLIC WORKS  
OFFICE\*

CAMP LEJEUNE  
NEW RIVER, N. C.

Water system 90 ft course

A"

FIELD PARTY

*H.L. Waters* IN CHARGE

INSTRUMENT \_\_\_\_\_

NOTES \_\_\_\_\_

TAPE READ \_\_\_\_\_

TAPE OR ROD \_\_\_\_\_

TAPE OR ROD \_\_\_\_\_

INSTRUMENT No. \_\_\_\_\_

TAPE No. \_\_\_\_\_

WEATHER

CLEAR SNOW  
CLOUDY HOT  
WINDY MODERATE  
RAIN COLD  
FAIR FOG

FILE No. *119 N-5*

FLDR. No. \_\_\_\_\_

FIGURED BY \_\_\_\_\_ SHEET *8 of 15*

NOTES CHECKED BY \_\_\_\_\_

PLOTTED BY \_\_\_\_\_ DATE *5-31* 19*45*

Quad. No. *119*

STATION	DIST.	ANGLE "	+	H. I.	VER. ANG. DIFF.	ELEVATION
<i>144.6</i>						
	<i>145.0</i>					
<i>0+01</i>						
	<i>1.0</i>	<i>94°-09'</i>				
<i>0+00 = L.H. Lateral</i>						
<i>3+24.6 = Base Line</i>						
<i>2+56.6</i>						
	<i>255.0</i>					
<i>0+01</i>						

End of Lateral "A"

145.0  
1"

1" value

10' 1"

End of Lateral "A"

255.0  
1"

13

$$\begin{array}{r} 155 \\ 26 \\ \hline 171 \end{array}$$
$$\begin{array}{r} 24 \\ 37 \\ \hline 2.7 \end{array}$$

7 29

118

847






VALUABLE

SUBJECT \_\_\_\_\_

RETURN TO  
PUBLIC WORKS  
OFFICE  
CAMP LEJEUNE  
NEW RIVER, N. C.

Water system golf course

"B"

FIELD PARTY  
H.L. Waters IN CHARGE  
\_\_\_\_\_  
INSTRUMENT  
\_\_\_\_\_  
NOTES  
\_\_\_\_\_  
TAPED READ  
\_\_\_\_\_  
TAPE OR ROD  
\_\_\_\_\_  
TAPED ROD  
\_\_\_\_\_  
INSTRUMENT NO. \_\_\_\_\_  
TAPE NO. \_\_\_\_\_

WEATHER  
CLEAR SNOW  
CLOUDY HOT  
WINDY MODERATE  
RAIN COLD  
FAIR FOG  
FIGURED BY \_\_\_\_\_ SHEET 9 of 15  
NOTES CHECKED BY \_\_\_\_\_ DATE 5-31 1945  
PLOTTED BY \_\_\_\_\_  
Quad. No. 119

FILE No. 119 N-5

FLDR. No. \_\_\_\_\_

STATION	DIST.	ANGLE "	+	H. I.	VER. DIFF.	ANG. DIFF.	ELEVATION
8+47.1							
	118						
7+29.1							
	710						
	162-42						
710+19.1							
	155						
0+36							
	36						
	83-38						
<p>20x35.50 = Base Line main line Photo = L.H. 3" Lateral</p>							

3" x 3" Tee

see page 13  
3"

1" see page 12  
1" x 3" Tee

1" x 3" Reducer

4 4 5

91

3 5 5

7 1 0

4" valve

4" x 5" Reducer

3" Lateral

3" x 4" Tee

118' 3" PIPE  
710' 3" PIPE  
155' 3" PIPE  
36' 4" PIPE


























VALUABLE

SUBJECT \_\_\_\_\_

FIELD PARTY  
H.L. Waters IN CHARGE

WEATHER  
CLEAR SNOW  
CLOUDY HOT  
WINDY MODERATE  
RAIN COLD  
FAIR FOG

FILE No. 119 N-5

FLDR. No. \_\_\_\_\_

SHEET 10 of 15

DATE 5-31 1945

Quad. No. 119

RETURN TO  
PUBLIC WORKS  
OFFICE  
CAMP LEJEUNE  
NEW RIVER, N. C.


Water system golf course

"B"

INSTRUMENT \_\_\_\_\_  
NOTES \_\_\_\_\_  
TAPE READ \_\_\_\_\_  
TAPE OR ROD \_\_\_\_\_  
TAPE OR ROD \_\_\_\_\_  
INSTRUMENT No. \_\_\_\_\_  
TAPE No. \_\_\_\_\_

FIGURED BY \_\_\_\_\_  
NOTES CHECKED BY \_\_\_\_\_  
PLOTTED BY \_\_\_\_\_  
Quad. No. 119

STATION	DIST.	ANGLE "	+	H. I.	VER: ANG. DIFF.	ELEVATION
10+07.5						
	122.4					
8+78.1						
	4.0					
		82°-44				
8+74.1						

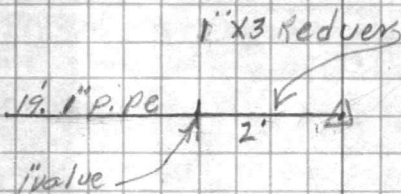

the above is in line with  
the back line

3" valve

3' X 3" tree





✓

VALUABLE

SUBJECT \_\_\_\_\_

FIELD PARTY  
H. L. Weston IN CHARGE

WEATHER

FILE No. 119 N-5

CLEAR SNOW  
CLOUDY HOT  
WINDY MODERATE  
RAIN COLD  
FAIR FOG

FLDR. No. \_\_\_\_\_

RETURN TO  
PUBLIC WORKS  
OFFICE

Water system golf course

SHEET 11 of 15


CAMP LEJEUNE  
NEW RIVER, N. C.

B

INSTRUMENT \_\_\_\_\_  
NOTES \_\_\_\_\_  
TAPE READ \_\_\_\_\_  
TAPE OR ROD \_\_\_\_\_  
TAPE OR ROD \_\_\_\_\_  
INSTRUMENT No. \_\_\_\_\_  
TAPE No. \_\_\_\_\_

FIGURED BY \_\_\_\_\_  
NOTES CHECKED BY \_\_\_\_\_  
PLOTTED BY \_\_\_\_\_ DATE 5-31 1945  
Quad. No. 119

STATION	DIST.	ANGLE "	+	H. I.	VER. ANG. DIFF.	ELEVATION
20 + 43.85					End of Pipe	
	406.2					
		242°-58'				
16 + 37.65						
	533					
		177°-14'				
13 + 02.65						
	293.15					
10 + 09.5						
	2.0					
		259°-29'				
10 + 07.5	P.I.					

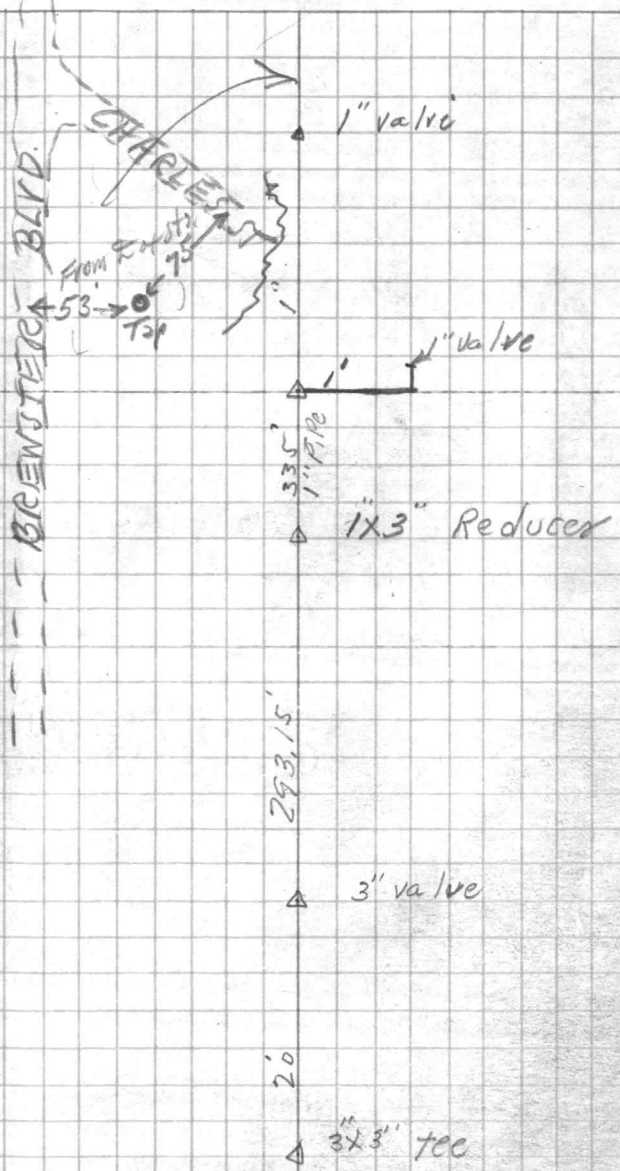
















VALUABLE

SUBJECT \_\_\_\_\_

Water system golf course

"B"

RETURN TO  
PUBLIC WORKS  
OFFICE.

CAMP LEJEUNE  
NEW RIVER, N. C.

FIELD PARTY

H.L. Waters IN CHARGE

INSTRUMENT \_\_\_\_\_

NOTES \_\_\_\_\_

TAPE READ \_\_\_\_\_

TAPE OR ROD \_\_\_\_\_

TAPE OR ROD \_\_\_\_\_

INSTRUMENT No. \_\_\_\_\_

TAPE No. \_\_\_\_\_

WEATHER

CLEAR SNOW  
CLOUDY HOT  
WINDY MODERATE  
RAIN COLD  
FAIR FOG

FILE No. 119 N-5

FLDR. No. \_\_\_\_\_

FIGURED BY \_\_\_\_\_ SHEET 12 of 15

NOTES CHECKED BY \_\_\_\_\_

PLOTTED BY \_\_\_\_\_ DATE 5-31 1945

Quad. No. 119

STATION	DIST.	ANGLE "	+	H. I.	VER. ANG. DIFF.	ELEVATION
0+65						
	63					
0+02						
	2.0					
		84-52'				

0+00 = L.H. Lateral  
7+29.1 = Base Line


End of Lateral

1" valve

1' x 4" tee  
1" x 4" Reducor



 



VALUABLE

SUBJECT \_\_\_\_\_

RETURN TO  
PUBLIC WORKS  
OFFICE,  
CAMP LEJEUNE  
NEW RIVER, N. C.

Water system golf course

B

FIELD PARTY  
H. Waters IN CHARGE  
\_\_\_\_\_  
INSTRUMENT  
\_\_\_\_\_  
NOTES  
\_\_\_\_\_  
TAPE READ  
\_\_\_\_\_  
TAPE OR ROD  
\_\_\_\_\_  
TAPE OR ROD  
\_\_\_\_\_  
INSTRUMENT NO. \_\_\_\_\_  
TAPE NO. \_\_\_\_\_

WEATHER  
CLEAR SNOW  
CLOUDY HOT  
WINDY MODERATE  
RAIN COLD  
FAIR FOG  
FIGURED BY \_\_\_\_\_  
NOTES CHECKED BY \_\_\_\_\_  
PLOTTED BY \_\_\_\_\_  
Quad. No. \_\_\_\_\_

FILE No. 119 N-5  
FLDR. No. \_\_\_\_\_  
SHEET 13 of 15  
DATE 5-31 1945  
119

STATION	DIST.	ANGLE "	+	H. I.	VER. DIFF.	ANG. DIFF.	ELEVATION
0+86							
	83'						
0+03							
	1.0						
0+02							
	2.0						
0+00 =	262°-01'						
8+74.1 =	Rt. H. Lateral						
	Base Line						

△ End of line

83'  
B

1" Valve △

1.0  
B

1x3" Reducer △

2.0  
B

3x3" Tee △ - - - - -

FILE NO

WEATHER

PHYS. PART

SUBJECT

VALUABLE

RECORDED BY

TAKEN BY

FILE NO

INDEXED BY

TAKEN ON

DATE

PLACED IN

TAKEN AT

TIME

FILE NO

DATE

PLACE

Good No

FILE NO

NO. OF VOLS. IN SET

DATE

BY

FILE NO

28  
031  
272

VALUABLE

SUBJECT \_\_\_\_\_

*Water system golf course*

*119*

RETURN TO  
PUBLIC WORKS  
OFFICE,  
CAMP LEJEUNE  
NEW RIVER, N. C.

FIELD PARTY  
*H.L. Waters* IN CHARGE  
\_\_\_\_\_  
INSTRUMENT  
\_\_\_\_\_  
NOTES  
\_\_\_\_\_  
TAPE READ  
\_\_\_\_\_  
TAPE OR ROD  
\_\_\_\_\_  
TAPE OR ROD  
\_\_\_\_\_  
INSTRUMENT NO. \_\_\_\_\_  
TAPE NO. \_\_\_\_\_

WEATHER  
CLEAR SNOW  
CLOUDY HOT  
WINDY MODERATE  
RAIN COLD  
FAIR FOG

FILE No. *119 N-5*

FLDR. No. \_\_\_\_\_

FIGURED BY \_\_\_\_\_ SHEET *14 of 15*

NOTES CHECKED BY \_\_\_\_\_

PLOTTED BY \_\_\_\_\_ DATE *5-31* 19 *45*

Quad. No. *119*

STATION	DIST.	ANGLE "	+	H. I.	VER. DIFF.	ANG. DIFF.	ELEVATION
0+63	63						
	60.8						
0+22	22						
	262.27						
<p><i>22+61.70 = Base Line</i>  <i>0+00 - R/L</i>      <i>R.H. Lateral 1"</i></p>							



*1" valve*







---

 120  
 104

VALUABLE

SUBJECT \_\_\_\_\_

Water system golf course

"D"

RETURN TO  
PUBLIC WORKS  
OFFICE

CAMP LEJUNE  
NEW RIVER, N. C.

FIELD PARTY

H.L. Waters IN CHARGE

\_\_\_\_\_ INSTRUMENT

\_\_\_\_\_ NOTES

\_\_\_\_\_ TAPE READ

\_\_\_\_\_ TAPE OR ROD

\_\_\_\_\_ TAPE OR ROD

INSTRUMENT NO. \_\_\_\_\_

TAPE NO. \_\_\_\_\_

WEATHER

CLEAR SNOW  
CLOUDY HOT  
WINDY MODERATE  
RAIN COLD  
FAIR FOG

FILE No. 119-115

FLDR. No. \_\_\_\_\_

FIGURED BY \_\_\_\_\_ SHEET 15 of 15

NOTES CHECKED BY \_\_\_\_\_

PLOTTED BY \_\_\_\_\_ DATE 5-31 1945

Quad. No. 119

STATION	DIST.	ANGLE "	+	H. I.	VER. ANG. DIFF.	ELEVATION
---------	-------	---------	---	-------	-----------------	-----------

D+84

83'

End of lateral Δ

D+01

10

1" valve Δ

271° 41'

10

24+19.10 = Base Line "D"

D+00

Δ





N.G.  
 O.K. for Plotting on 500' Scale

292  
 180  
 112

Book #119 N-5

CARR & J. E. GREINER CO.  
 ARCHITECT - ENGINEERS

6/1/45

Traverse Computation  
 Description:

Marine Barracks, New River, N. C.  
 Sheet #1 of 1

Water System & Golf Course

Station	Distance	Bearing	Cosine	Sine	Latitude	Departure	Y Coordinate North	X Coordinate East
Mon # 71		536°18'18"E					354,424.06	2485,786.00
P.I. #1 Beginning of 2" C.V.	764.55	N69°10'54"E	.3554	.9347	+277.72	-712.46	354,696.55	486,498.46
P.I. #2 8+84.55	115'	S1°43'06"W	.9995	.03	-114.84	+346	354,582.02	486,495.00
P.I. #3 20+35.50 4"x3" Tee	1150.95	S30°06'36"E	.8651	.5016	-425.64	-575.72	353,589.73	487,070.74
P.I. #4 22+61.70 4"x1" Tee	226.20	S30°21'30"E	.8628	.5054	-195.76	-114.80	353,395.47	487,184.72
P.I. #5 23+71.00 ✓	109.30	S30°34'18"E	.8609	.5086	-94.10	-53.59	353,301.69	487,240.11
P.I. #6 24+41.2 4" Valve	70.20	S52°41'06"E	.6062	.7953	-42.56	-55.63	353,259.29	487,295.74
P.I. #7 24+51.03	9.83	S60°12'54"E	.4967	.8679	-4.88	-8.59	353,254.41	487,304.24
P.I.	900'	N53°52'42"W	.5995	.8078	+541.49	+729.20	353,795.90	486,575.04
Mon # 71	1005.21	N51°29'30"W	.6226	.7825	+625.84	+789.02	353,423.99	485,786.04
							10.22	1.04
							.07	.04

Off 0'22'

2884.44 3043.26

