

FILE FOLDER

DESCRIPTION ON TAB:

water main

Cable-Hart Hoosing

Outside/inside of actual folder did not contain hand written information

Outside/inside of actual folder did contain hand written information

*Scanned as next image
















VALUABLE

SUBJECT _____

RETURN TO
PUBLIC WORKS
OFFICE
CAMP LEJEUNE
NORTH CAROLINA

FIELD PARTY

IN CHARGE

INSTRUMENT

NOTES

TAPE READ

TAPE OR ROD

TAPE OR ROD

INSTRUMENT NO.

TAPE NO.

WEATHER

CLEAR _____ SNOW _____
CLOUDY _____ HOT _____
WINDY _____ MODERATE _____
RAIN _____ COLD _____
FAIR _____ FOG _____

FILE No. _____

FLDR. No. _____

SHEET 2 of

FIGURED BY _____

NOTES CHECKED BY _____

PLOTTED BY _____

DATE _____ 19__

Quad. No. _____


STATION	DIST.	ANGLE ° ' "	+	H. I. BEARING	VER: ANG. DIFF.	ELEVATION
P.I. 93+18.05						
A		37° 27' 30" R4.				
D		3° 46' 04"				
T		515.69				
L ₂		994.38				
R		1520.98				
Ext.		82.25				
Defl.		1.1301 per ft.				

Curve for Water Line
worked from External of
stone st. as built.
stone st. Curve does not fit Plan Data.

P.I. 93+18.05
A 37° 27' 30" R4.
D 3° 46' 04"
T 515.69
L₂ 994.38
R 1520.98
Ext. 82.25
Defl. 1.1301 per ft.

1520.98
- 50.98

1470.00

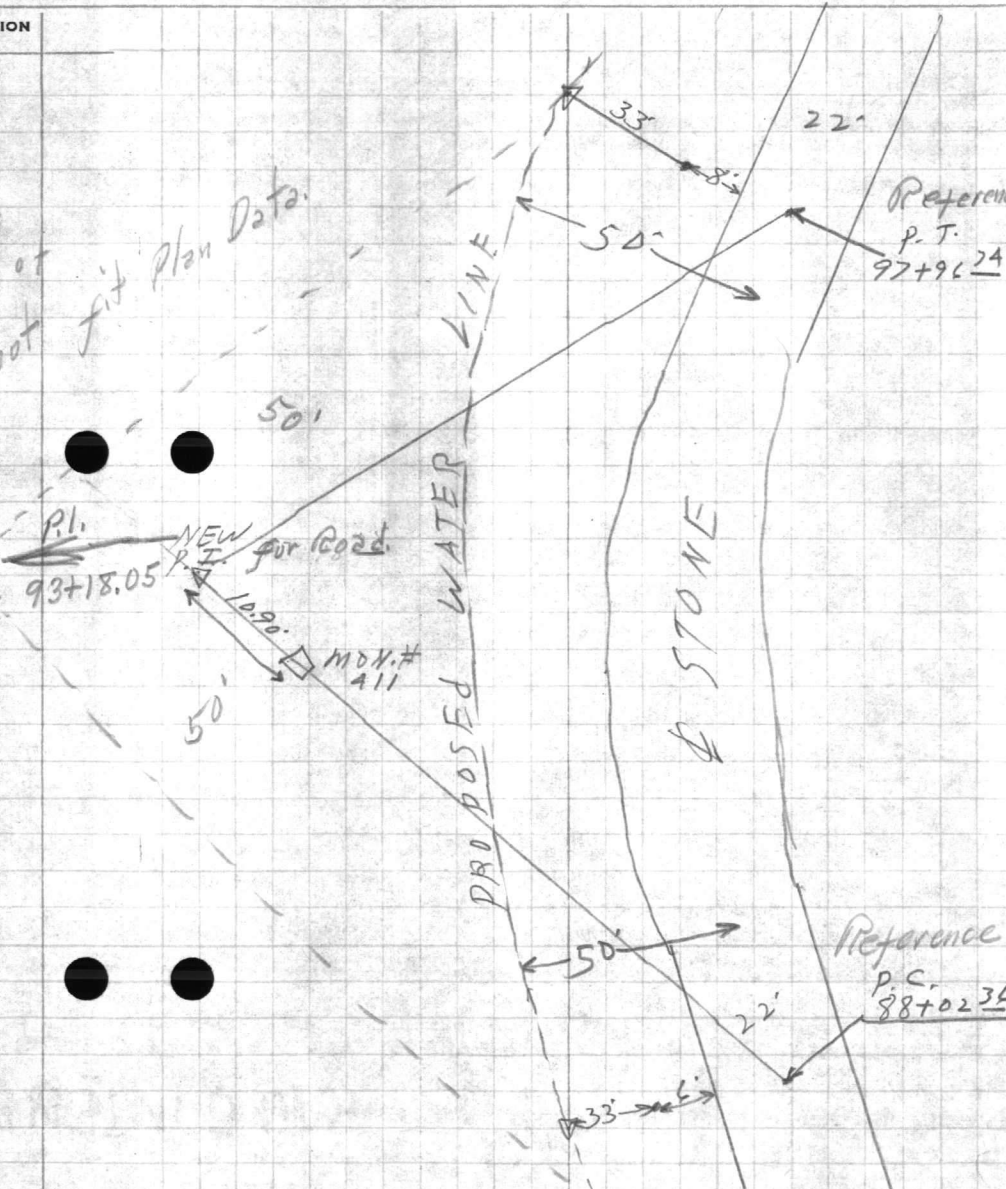

PROPOSED WATER LINE
STONE
Reference P.T. 97+96.24
Reference P.C. 88+02.36
50'
33'
22'
50'
33'
22'










































































VALUABLE

SUBJECT _____

RETURN TO
PUBLIC WORKS
OFFICE
CAMP LEJEUNE
NORTH CAROLINA

FIELD PARTY

IN CHARGE

INSTRUMENT

NOTES

TAPE READ

TAPE OR ROD

TAPE OR ROD

INSTRUMENT NO.

TAPE NO.

WEATHER

CLEAR
CLOUDY
WINDY
RAIN
FAIR
SNOW
HOT
MODERATE
COLD
FOG

FILE No. _____

FLDR. No. _____

SHEET. 4 of 5

FIGURED BY _____

NOTES CHECKED BY _____

PLOTTED BY _____

DATE _____ 19__

Quad. No. _____

STATION	DIST.	ANGLE ° ' " +	H. I. BEARING	VER: ANG. DIFF.	ELEVATION
P.T.	927	+ 78	89		
P.I.	117	+ 46.54			
A	26° 14' 40"	Rt.			
D	1° 14' 54"				
T	1069.74				
L ₂	2102.00				
R	4589.00				
Ext.	121.70				
Defl. D.	3746'	per ft.			
P.C.	106	+ 76	80		


Curve for Waterline
worked from external of
stone St. as built.

P.I. 117+34.88

NEW P.I. for Road

171.70 to S Rd.

MON.#
146

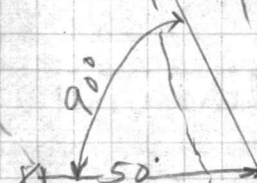












VALUABLE

SUBJECT _____

RETURN TO
PUBLIC WORKS
OFFICE
CAMP LEJEUNE
NORTH CAROLINA

FIELD PARTY

IN CHARGE

INSTRUMENT

NOTES

TAPE READ

TAPE OR ROD

TAPE OR ROD

INSTRUMENT NO.

TAPE NO.

WEATHER

CLEAR
CLOUDY
WINDY
RAIN
FAIR
SNOW
HOT
MODERATE
COLD
FOG
FIGURED BY _____
NOTES CHECKED BY _____
PLOTTED BY _____

FILE No. _____


FLDR. No. _____

SHEET 5 of 6

DATE _____ 19__

Quad. No. _____

STATION	DIST.	ANGLE ° ' "	+	H. I. BEARING	VER. ANG. DIFF.	ELEVATION
AT NAIL		321 41 30	①			
INT. STONE & RIVER		245 64 00	②			
B.S. 141+06.45		321 41 20	(M)			
TO NAIL INT. STONE & EDEN						
AT 141+06.45		218 19 30	①			
B.S. 134+24.23		294 58 30	③			
TO NAIL INT. STONE & RIVER		218 19 30	(M)			
AT 134+24.23		168 45 00	①			
B.S. 133+52.50		337 30 00	②			
TO 141+06.45		168 45 00	(M)			
AT 133+52.50		191 15 00	①			
B.S. 127+78.20		22 30 00	②			
TO 134+24.23		191 15 00	(M)			

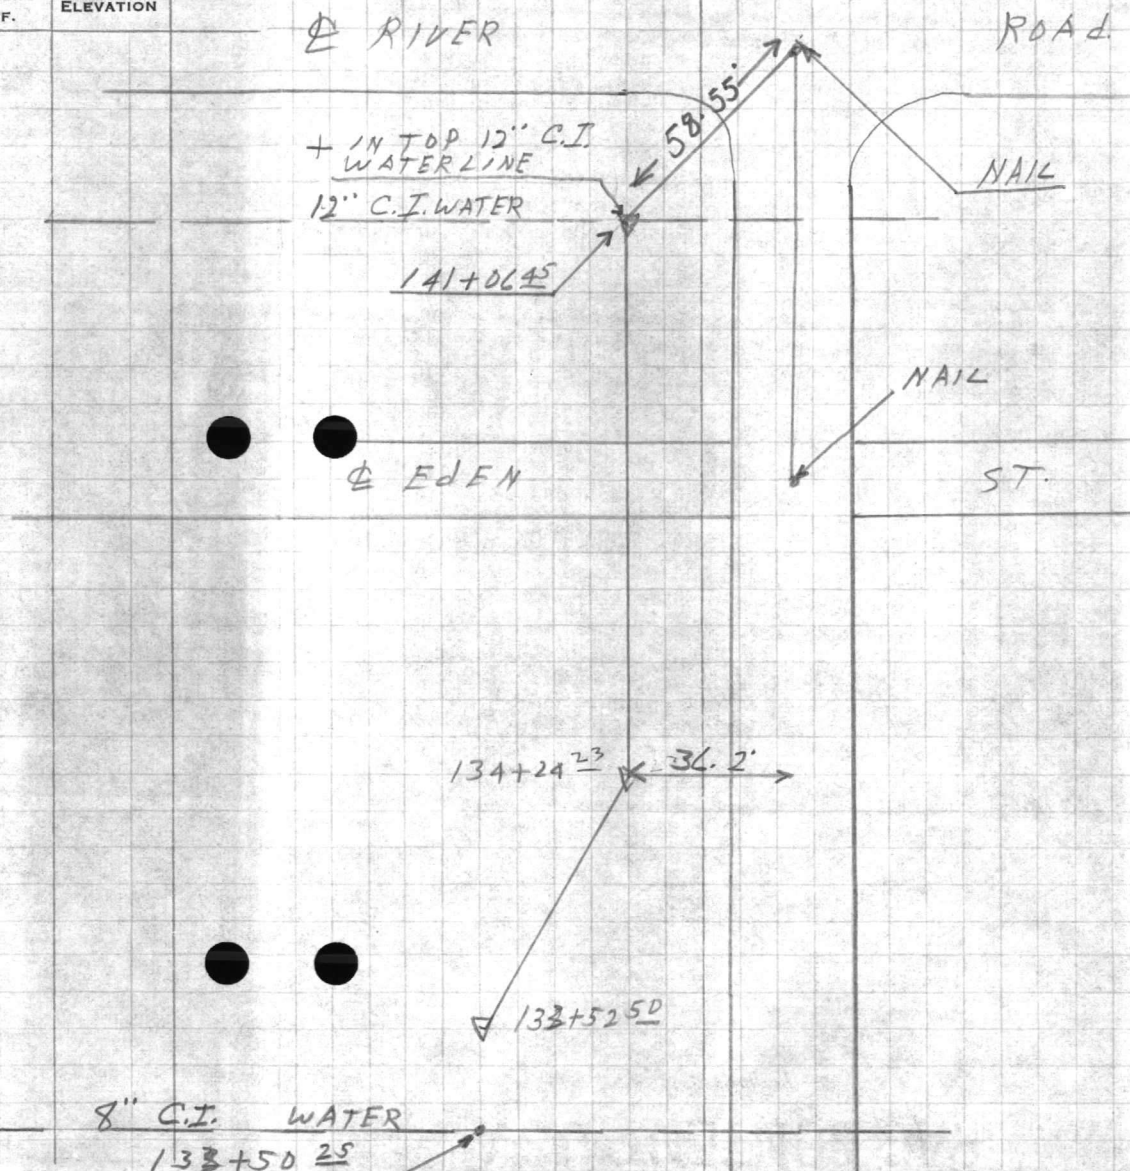


PUBLIC WORKS DEPARTMENT
Camp Lejeune, North Carolina
Survey Department

File _____
Quadrangle _____
Date _____
Sheet _____ of _____

Traverse Computation
Description

Station	Distance	Bearing	Cosine	Sine	Latitude	Departure	Y Coordinate North	X Coordinate East
Int. Stone St. & Berin St.		N56° 44' E					346,015.73	2492,225.17
P.O.T. 17+41.74	900'		54854	83612	493.69	752.51	346,509.42	2492,977.68
P.I. 24+47.00							346,896.33	2493,568.96
P.T. 34+80.51	1072.16	N30° 08' E	86486	50201	927.27	538.24	347,823.60	2494,107.20
P.O.T. 37+08.51	228'	"	"	"	197.19	114.46	348,020.79	2494,221.66
P.C. 43+57.32	648.81		"	"	561.13	325.71	348,581.92	2494,547.37
P.I. 48+38.45		N6° 59' 30" W					348,998.10	2494,789.86
P.T. = 52+85.64 BK. 53+07.22 AH.	481.13	"	99256	12172	477.55	58.56	349,475.65	2494,731.30
P.O.T. 58+67.22	560'	"	"	"	555.83	68.16	350,031.48	2494,663.14
68+67.22	1000'	"	99256	12172	492.56	121.72	351,024.04	2494,541.42
88+67.22	2000'	"	"	"	1985.12	243.44	353,009.16	2494,297.98

2(385)
199

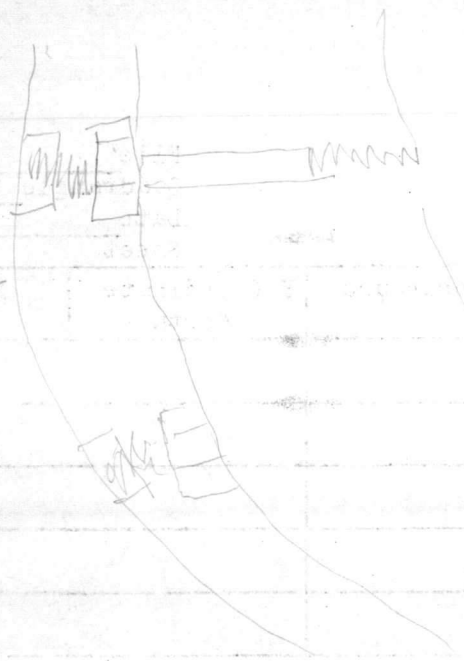
























VALUABLE

RETURN TO
PUBLIC WORKS
OFFICE
CAMP LEJEUNE
NORTH CAROLINA

SUBJECT STAKE OUT PROPOSED
WATER LINE CAPEHART
HOUSING AREA NEAR SAW
MILL AREA

FIELD PARTY
DENNIS IN CHARGE

INSTRUMENT

NOTES

TAPE READ

TAPE OR ROD

TAPE OR ROD


WEATHER
CLEAR
CLOUDY
WINDY
RAIN
FAIR
SNOW
HOT
MODERATE
COLD
FOG
FIGURED BY _____
NOTES CHECKED BY _____
PLOTTED BY _____

FILE No. _____
FLDR. No. _____
SHEET 1 of 1
DATE 4-21 1958

INSTRUMENT No. _____
TAPE No. _____

Quad. No. _____

STATION	DIST.	ANGLE ° ' "	+	H. I. BEARING	VER. ANG. DIFF.	ELEVATION
---------	-------	----------------	---	------------------	--------------------	-----------

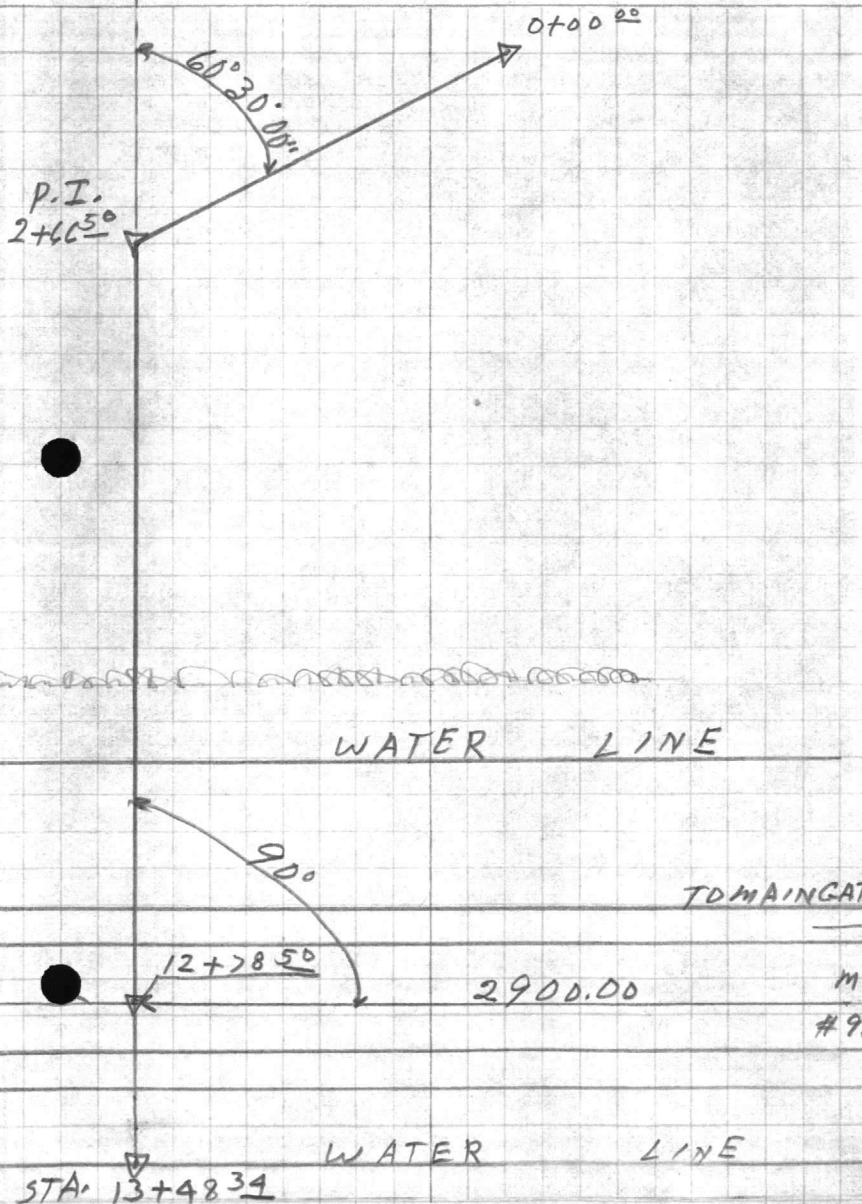

12" RAW WATER LINE

MON. #129
E HOLCOMB BLVD

12" TREATED WATER LINE

STA. 13+48.34

P.I.
2+66.5

0+00.00

60° 30' 00"

90°

12+78.50

2900.00

TO MAIN GATE

MON. #93

VALUABLE

RETURN TO
PUBLIC WORKS
OFFICE
CAMP LEJEUNE
NORTH CAROLINA

SUBJECT PROFILE ON PROPOSED
WATER LINE CAPEHART
HOUSING SAWMILL AREA

FIELD PARTY
DENNIS IN CHARGE

INSTRUMENT

NOTES

TAPE READ

TAPE OR ROD

TAPE OR ROD

INSTRUMENT NO. _____
TAPE NO. _____

WEATHER
CLEAR _____ SNOW _____
CLOUDY _____ HOT _____
WINDY _____ MODERATE _____
RAIN _____ COLD _____
FAIR _____ FOG _____
FIGURED BY _____
NOTES CHECKED BY _____
PLOTTED BY _____

FILE No. _____
FLDR. No. _____
SHEET 1 of
DATE 7. 21 1958

Quad. No. _____

STATION	DIST.	ANGLE ° ' "	H. I. BEARING	VER. ANG. DIFF.	ELEVATION
B.m.		5 32	27.43		27.11
T.P.		4 38	25.96	5 77	21.66 ✓
T.P.		9 70	35.18	9 20	25.73 ✓
T.P.		4 01	27.48	1 96	33.47 ✓
T.P.		3 01	36.73	3 76	33.72 ✓
T.P.		5 44	38.11	4 06	32.67 ✓
B.m.		37.82	37.82	3 86	34.17 ✓ 34.25
		3 65	37.70 (37.8)		34.25
0+00	00			4 5	33.3
0+53	50				
0+91	90				
1+00				4 6	33.2
1+40					
1+41				4 6	33.2

NAIL IN 74" PINE APPROX. 70' WEST OF R.R. TRACK
ON RD. TO SAWMILL.

SEE BENCH LEVELS
4-22-58
R.R. SPIKE IN 8" PINE 17.50' RT. STA 0+75

1.00' RT. 8" PINE

4.00' RT. 8" PINE

10" PINE ON E EDGE OF WOODS
AND EDGE BETWEEN AREA























VALUABLE

RETURN TO
PUBLIC WORKS
OFFICE
CAMP LEJEUNE
NORTH CAROLINA

SUBJECT _____

FIELD PARTY

IN CHARGE

INSTRUMENT

NOTES

TAPE READ

TAPE OR ROD

TAPE OR ROD

INSTRUMENT NO.

TAPE NO.

WEATHER

CLEAR
CLOUDY
WINDY
RAIN
FAIR
SNOW
HOT
MODERATE
COLD
FOG
FIGURED BY _____
NOTES CHECKED BY _____
PLOTTED BY _____

FILE No. _____
FLDR. No. _____
SHEET 2 of
DATE _____ 19__

Quad. No. _____

STATION	DIST.	ANGLE			+	H. I.	VER. ANG.	ELEVATION	
		°	'	"		BEARING	DIFF.		
						27.82 37.90 (37.8)	5.3	32.5	
1+48							5.3	32.5	
1+66							6.6	31.2	
1+84							7.4	30.4	BANK
1+90							9.6	28.2	
1+94							10.3	27.5	
1+98							11.4	26.2	DITCH
2+00							11.5	26.3	
2+04 ⁸⁰							11.4	26.4	DITCH
2+06							11.0	26.8	
2+14							10.0	27.8	
2+20							8.6	29.2	BANK
2+25							9.1	28.7	
2+45							8.0	29.8	
2+50							6.7	31.1	
2+66 ⁵⁰							6.0	31.8	P.I.







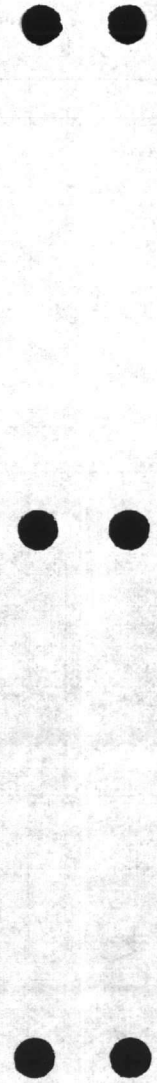

VALUABLE

SUBJECT _____

RETURN TO
PUBLIC WORKS
OFFICE
CAMP LEJEUNE
NORTH CAROLINA

FIELD PARTY

IN CHARGE

INSTRUMENT

NOTES

TAPE READ

TAPE OR ROD

TAPE OR ROD

INSTRUMENT NO.

TAPE NO.

WEATHER

CLEAR
CLOUDY
WINDY
RAIN
FAIR
SNOW
HOT
MODERATE
COLD
FOG

FILE No. _____

FLDR. No. _____

SHEET 314

FIGURED BY _____

NOTES CHECKED BY _____

PLOTTED BY _____ DATE _____ 19__

Quad. No. _____

STATION	DIST.	ANGLE		+	H. I.	VER: ANG.	ELEVATION	
		°	' "		BEARING	DIFF.		
T.P.					37.82 37.82		31.92	
					5.90	5.90	32.00	TOP HUB
					(37.8)			
3+00						4.1	31.7	25' RT. EDGE BORROW AREA
3+31						4.4	31.4	
3+48						5.8	31.0	
3+49						4.8	33.0	EDGE BORROW AREA
3+52								2' RT- 12" PINE
4+00						4.7	33.1	
5+00						4.5	33.3	
5+34								7.50' LT. 20" PINE
5+37								12' LT. 12" PINE
5+94								3' RT. 8" PINE
6+00						4.4	33.4	
7+00						4.4	33.4	
							33.80	
T.P.					37.58	4.02	33.84	P.D.T. 4+78 50
					3.78		37.66	
					37.6			
8+00						4.4	33.2	
9+00						4.2	33.4	



































VALUABLE

SUBJECT _____

RETURN TO
 PUBLIC WORKS
 OFFICE
 CAMP LEJEUNE
 NORTH CAROLINA

FIELD PARTY

 IN CHARGE

 INSTRUMENT

 NOTES

 TAPE READ

 TAPE OR ROD

 TAPE OR ROD

 INSTRUMENT NO. _____
 TAPE NO. _____

WEATHER

CLEAR
 CLOUDY
 WINDY
 RAIN
 FAIR
 SNOW
 HOT
 MODERATE
 COLD
 FOG
 FIGURED BY _____
 NOTES CHECKED BY _____
 PLOTTED BY _____

FILE No. _____
 FLDR. No. _____
 SHEET 4 of
 DATE _____ 19__

Quad. No. _____

STATION	DIST.	ANGLE		+	H. I. BEARING	VER: ANG. DIFF.	ELEVATION	
		°	' "					
					37.66			
					27.58			
9+64					(27.6)			9.60' LT. 12" PINE
9+94								20" PINE ON E
10+00						4.2	33.4	
11+00						4.5	33.1	
11+								
11+55						4.5	33.1	
11+60						3.9	33.7	
11+90						3.8	33.8	WOOD LINE
12+00						4.3	33.3	
							34.28	
T.P.						34.73	33.30	34.31
						0.45	31.81	
							31.38	(31.35)
B.M.						3.35	31.16	SPIKE IN 14" PINE
						2.52	33.99	APPRD. 50' RT. OF STA
T.P.						1.18	28.62	13+48.34
							27.14	IN EDGE OF WOODS.
T.P.						4.29	28.01	
							21.77	
						0.75	27.26	27.11

















VALUABLE

SUBJECT _____

RETURN TO
 PUBLIC WORKS
 OFFICE
 CAMP LEJEUNE
 NORTH CAROLINA

FIELD PARTY

 IN CHARGE

 INSTRUMENT

 NOTES

 TAPE READ

 TAPE OR ROD

 TAPE OR ROD

 INSTRUMENT NO. _____
 TAPE NO. _____

WEATHER

CLEAR
 CLOUDY
 WINDY
 RAIN
 FAIR
 SNOW
 HOT
 MODERATE
 COLD
 FOG
 FIGURED BY _____
 NOTES CHECKED BY _____
 PLOTTED BY _____

FILE No. _____
 FLDR. No. _____
 SHEET 54
 DATE _____ 19__

Quad. No. 8.47

STATION	DIST.	ANGLE ° ' "	+	H. I. BEARING	VER: ANG. DIFF.	ELEVATION	
B. m.				44235.77		31.35	SPIKE IN 14' PINE APPROX. 50' RT. STA. 13+48.34
12+03					6.25	29.52	TOP RAW WATER LINE
12+08 ⁵⁰					6.02	29.75	TOP ELEC. CABLE
12+10 ⁵⁰							91.50' LT. P.P. A-55 88.50' RT. P.P. A-56
12+12					3.7	32.1	
12+18					4.6	31.2	
12+23					5.9	29.9	DITCH
12+24					5.9	29.9	DITCH
12+30					5.1	30.7	
12+34					4.5	31.3	
12+38					6.25	29.52	FIRE ALARM CABLE
12+41 ²⁰					4.31	31.46	WEST EDGE HOLCOMB BLVD.
12+52 ⁴⁰					4.11	31.66	E WEST LANE HOLCOMB BLVD.
12+53 ²⁰					4.30	31.47	EAST EDGE OF WEST LANE HOLCOMB
12+70					4.9	30.9	
12+78 ⁵⁰					5.5	30.3	
12+85					4.6	31.2	
12+93 ⁷⁵					4.05	31.72	WEST EDGE OF EAST LANE HOLCOMB
12+15 ⁷² 13+04 ⁷⁰					4.12	31.65	E EAST LANE HOLCOMB BLVD.
13+15 ⁷²					4.34	31.43	EAST EDGE OF EAST LANE HOLCOMB
13+19 ²²					7.14	28.63	TEL. CABLE

$$\begin{array}{r} 78.50 \\ 26.20 \\ \hline 47.0 \end{array}$$
 E
 F.1

VALUABLE

SUBJECT _____

RETURN TO
 PUBLIC WORKS
 OFFICE
 CAMP LEJEUNE
 NORTH CAROLINA

FIELD PARTY

 IN CHARGE

 INSTRUMENT

 NOTES

 TAPE READ

 TAPE OR ROD

 TAPE OR ROD

 INSTRUMENT NO. _____
 TAPE NO. _____

WEATHER

 CLEAR

 CLOUDY

 WINDY

 RAIN

 FAIR

 SNOW

 HOT

 MODERATE

 COLD

 FOG
 FIGURED BY _____
 NOTES CHECKED BY _____
 PLOTTED BY _____


FILE No. _____
 FLDR. No. _____
 SHEET 6 of
 DATE _____ 19__

Quad. No. _____

STATION	DIST.	ANGLE ° ' "	+	H. I. BEARING	VER: ANG. DIFF.	ELEVATION	
				35.77			
13+2234				48	31.0		BANK
13+2834				54	30.2		
13+33				62	29.6		DITCH
13+4234				51	30.7		
13+48 ³⁴				847	27.30		TOP 12" TREATED WATER LINE
13+48 ³⁴				48	31.0		GROUND AT END of LINE
Bm				4.42	31.35		SPIKE IN 1/4" PINE APPROX. 50' RT. STA-13+48 ³⁴ IN EDGE WOODS
					31.35		



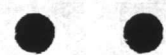

VALUABLE

RETURN TO
PUBLIC WORKS
OFFICE
CAMP LEJEUNE
NORTH CAROLINA

SUBJECT BENCH MARK CHECK
ON PROPOSED WATER LINE
CAPE HART HOUSEANG NEAR
SARV MILL

FIELD PARTY
DENNIS IN CHARGE

INSTRUMENT

NOTES

TAPE READ

TAPE OR ROD

TAPE OR ROD

STRUMENT NO. _____
TAPE NO. _____

WEATHER
CLEAR _____
CLOUDY _____
WINDY _____
RAIN _____
FAIR _____
SNOW _____
HOT _____
MODERATE _____
COLD _____
FOG _____
FIGURED BY _____
NOTES CHECKED BY _____
PLOTTED BY _____

FILE No. _____
FLDR. No. _____
SHEET 1 of 1
DATE 4-22-58

Quad. No. _____

STATION	DIST.	ANGLE ° ' "	+	H. I. BEARING	VER: ANG. DIFF.	ELEVATION	
B.M.			0.52	27.63		27.11	NAILED IN 14" PINE APPROX. 70' WEST R.R. ON RD. LEADING TO SAWMILL
T.P.			4.18	25.68	6.13	21.50	
T.P.			10.25	35.64	0.29	25.39	
T.P.			3.82	37.28	2.18	33.46	
T.P.			2.67	36.35	3.60	33.68	
T.P.			5.18	37.73	3.80	32.55	
B.M.			3.64	37.81	3.56	34.17	R.R. SPIKE IN 8" PINE 17.50' RT. STA. 0+75.00
T.P.			5.44	37.75	5.50	32.31	
T.P.			3.75	37.85	3.65	34.10	
T.P.			1.45	35.71	3.59	34.26	
B.M.			2.55	33.90	4.36	31.35	APPROX. R.R. SPIKE IN 14" PINE 150' RT. STA. 13+48.34 IN EDGEWOODS






VALUABLE

SUBJECT _____

 RETURN TO
 PUBLIC WORKS
 OFFICE
 CAMP LEJEUNE
 NORTH CAROLINA

FIELD PARTY

 _____ IN CHARGE
 _____ INSTRUMENT
 _____ NOTES
 _____ TAPE READ
 _____ TAPE OR ROD
 _____ TAPE OR ROD
 _____ INSTRUMENT NO.
 _____ TAPE NO.

WEATHER

 CLEAR
 CLOUDY
 WINDY
 RAIN
 FAIR
 SNOW
 HOT
 MODERATE
 COLD
 FOG

FILE No. _____

FLDR. No. _____

FIGURED BY _____

SHEET

2 of 2

NOTES CHECKED BY _____

PLOTTED BY _____

DATE

19__

Quad. No. _____

STATION	DIST.	ANGLE			H. I. BEARING	VER: ANG. DIFF.	ELEVATION										
		°	'	"				+									
					33 90												
T. P.					2.07 29.09	6 88	27.02										
T. P.					5 94 27.73	7 30	21.79										
B. m.						0 61	27.12	NAIL IN 14" PINE APPRD. 70' WEST OF R.R. Rd. LEADING TO Sawmill									

VALUABLE

RETURN TO
PUBLIC WORKS
OFFICE
CAMP LEJEUNE
NORTH CAROLINA

SUBJECT COORDINATE TIE FOR CAPEHART
WATER LINE (PROPOSED)

FIELD PARTY
KELLUM IN CHARGE

INSTRUMENT

NOTES

TAPE READ

TAPE OR ROD


TAPE OR ROD

INSTRUMENT No. _____
TAPE No. _____

WEATHER
CLEAR _____ SNOW _____
CLOUDY _____ HOT _____
WINDY _____ MODERATE _____
RAIN _____ COLD _____
FAIR _____ FOG _____
FIGURED BY _____
NOTES CHECKED BY _____
PLOTTED BY _____ DATE 10-19 1956

FILE No. _____
FLDR. No. _____
SHEET 1-A-
DATE 10-19 1956

Quad. No. _____

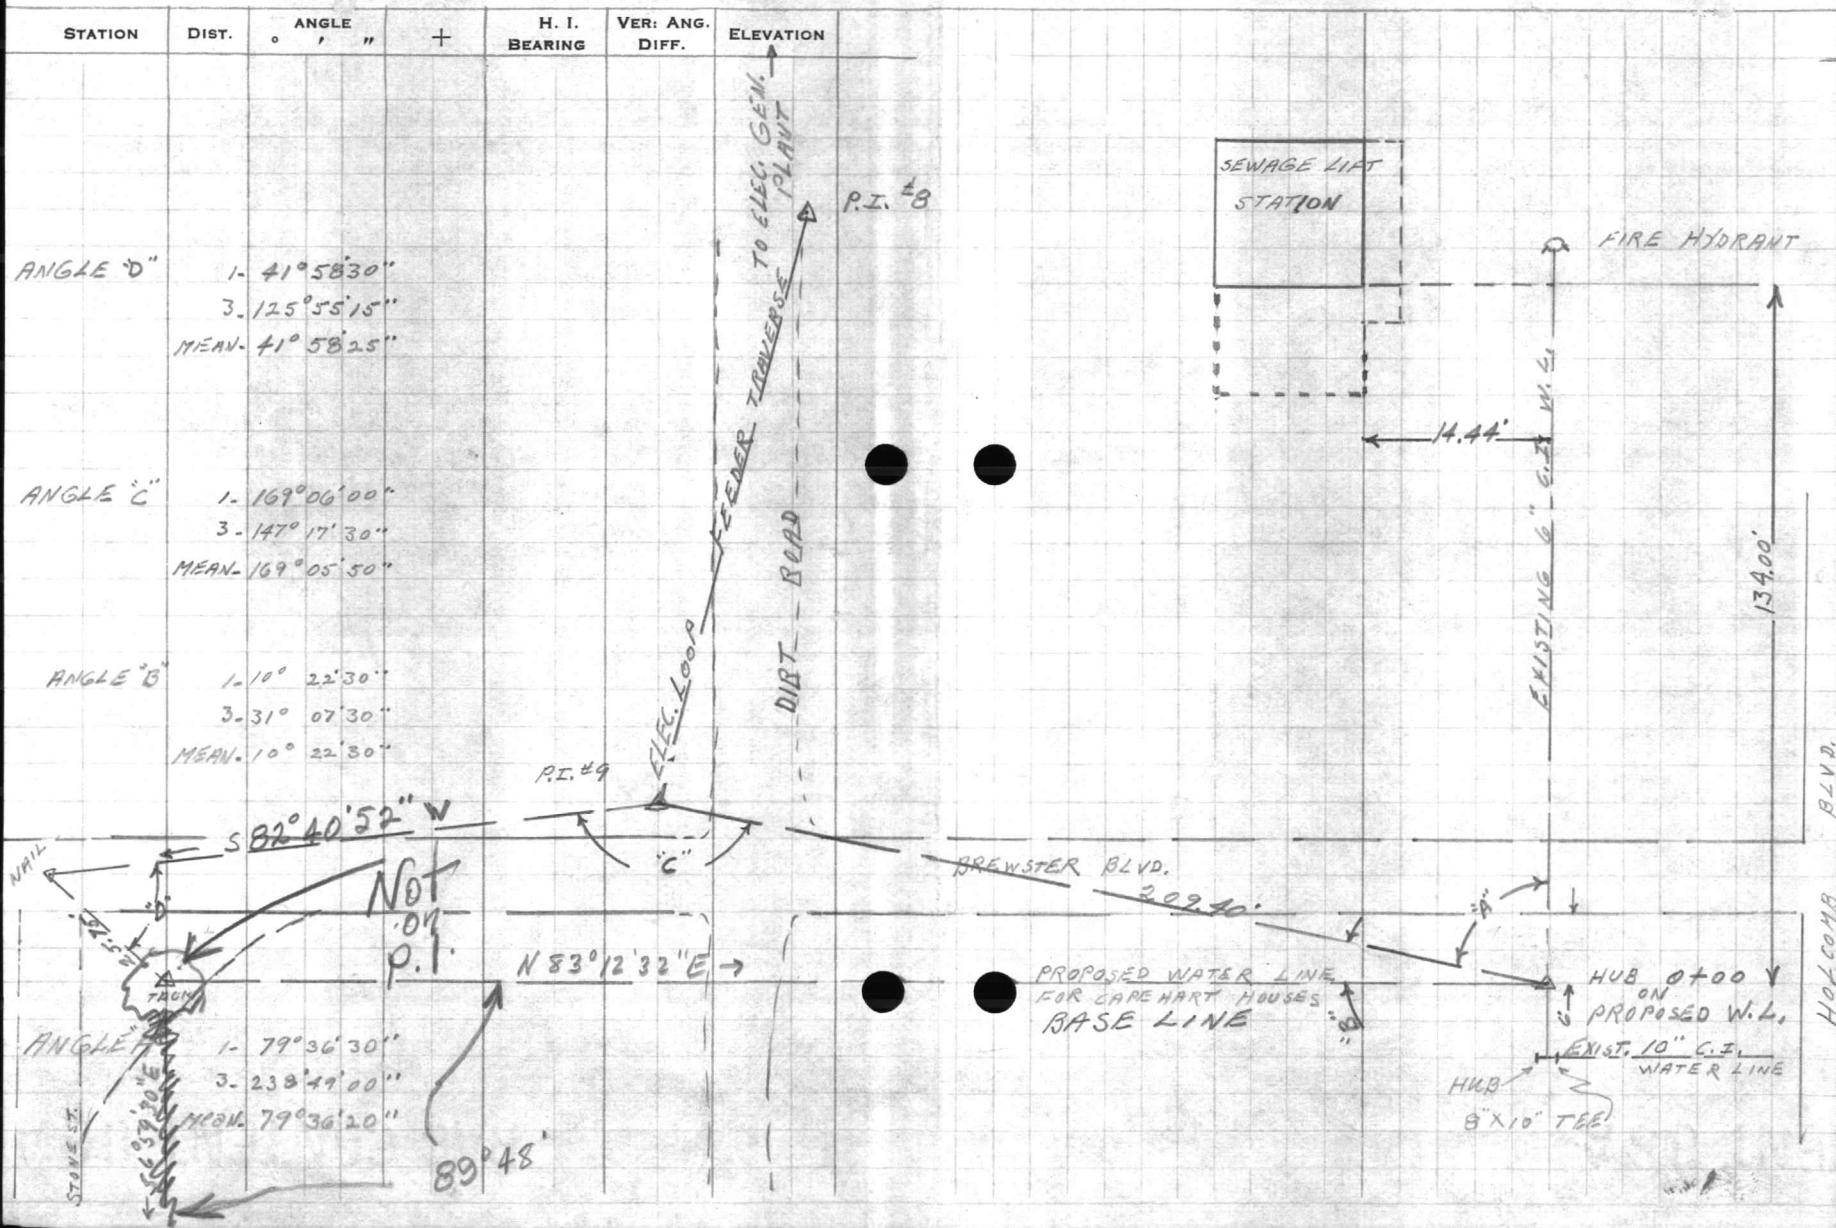



















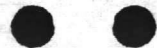

446

VALUABLE

SUBJECT WATER LINE
CAPE HART HOUSING

RETURN TO
PUBLIC WORKS
OFFICE
CAMP LEJEUNE
NORTH CAROLINA

FIELD PARTY

SNIPES IN CHARGE
SNIPES INSTRUMENT
SZABO NOTES
BAFFLEUR TAPE READ
ANDREWS TAPE OR ROD
TAPE OR ROD
STRUMENT No. _____
TAPE No. _____

WEATHER

CLEAR SNOW
CLOUDY HOT
WINDY MODERATE
RAIN COLD
FAIR FOG
FIGURED BY _____
NOTES CHECKED BY _____
PLOTTED BY _____

FILE No. _____
FLDR. No. _____
SHEET 2 of _____
DATE 26 AUG 1950

Quad. No. _____

STATION	DIST.	ANGLE			H. I. BEARING	VER. ANG. DIFF.	ELEVATION
		°	'	"			

16+00 □

PAGE 2

15+00 □

14+00 □

13+00 □

12+00 □

← 6' →

11+00 □

VSMC
← 4.46 →

10+43.75

10+00 □

GREENSTER BLVD
TO HOLG. BLVD









VALUABLE

SUBJECT WATER LINE
CAPE HART HOUSING

RETURN TO
PUBLIC WORKS
OFFICE
CAMP LEJEUNE
NORTH CAROLINA

FIELD PARTY

SNIPES IN CHARGE
SNIPES INSTRUMENT
SZABO NOTES
RUFFLEUR TAPE READ
ANDREW TAPE OR ROD
TAPE OR ROD
STRUMENT NO. _____
TAPE NO. _____

WEATHER

CLEAR
CLOUDY
WINDY
RAIN
FAIR
SNOW
HOT
MODERATE
COLD
FOG

FILE No. _____
FLDR. No. _____
FIGURED BY _____ SHEET 3 OF _____
NOTES CHECKED BY _____
PLOTTED BY _____ DATE 26 AUG 1958


Quad. No. _____

STATION	DIST.	ANGLE			H. I. BEARING	VER: ANG. DIFF.	ELEVATION
		°	'	"			

22+00 □

PAGE 3

21+00 □

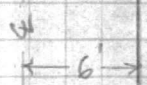

20+00 □


19+00 □

BREWSTER BLVD

18+00 □

17+00 □

16+76.4 △ ROT. #1

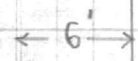


TO HOUC. BLVD

16+00 □



23.772.64

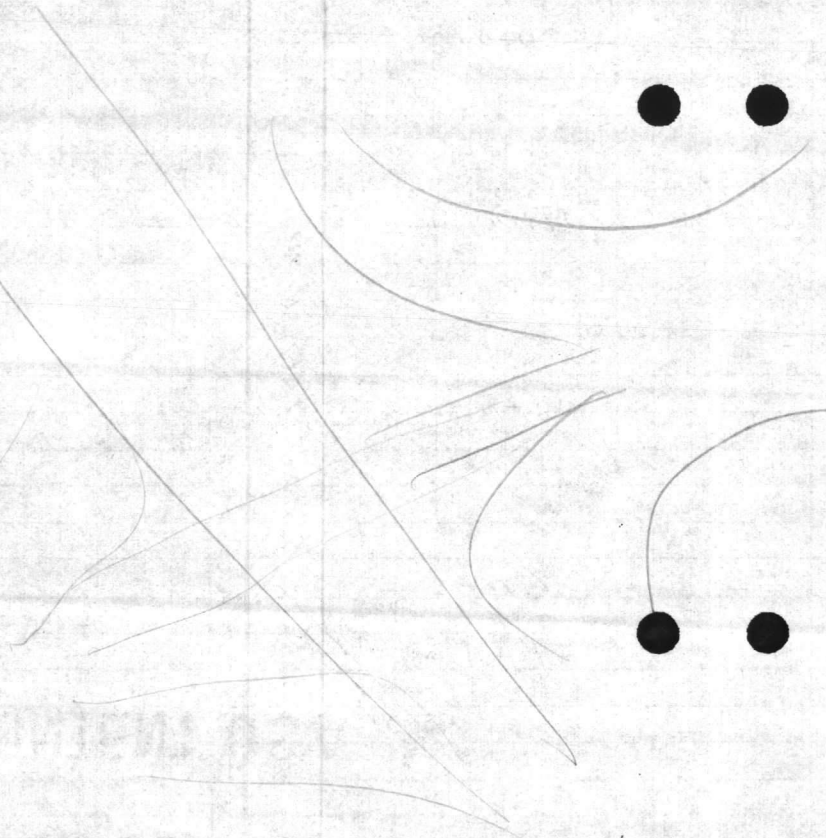

VALUABLE

RETURN TO
PUBLIC WORKS
OFFICE
CAMP LEJEUNE
NORTH CAROLINA

SUBJECT WATER LINE
CAPE HART HOUSING

FIELD PARTY

SNIPES IN CHARGE
SNIPES INSTRUMENT
SNIPES NOTES
RAVENS TAPE READ
AMIGONE TAPE OR ROD
ANDREWS TAPE OR ROD
INSTRUMENT No. _____
TAPE No. _____


WEATHER

CLEAR SNOW
CLOUDY HOT
WINDY MODERATE
RAIN COLD
FAIR FOG

FILE No. _____
FLDR. No. _____
SHEET 4 of _____
DATE 28 AUG 1952

FIGURED BY _____
NOTES CHECKED BY _____
PLOTTED BY _____
Quad. No. _____

STATION	DIST.	ANGLE ° ' "	+	H. I. BEARING	VER. ANG. DIFF.	ELEVATION
---------	-------	----------------	---	------------------	--------------------	-----------

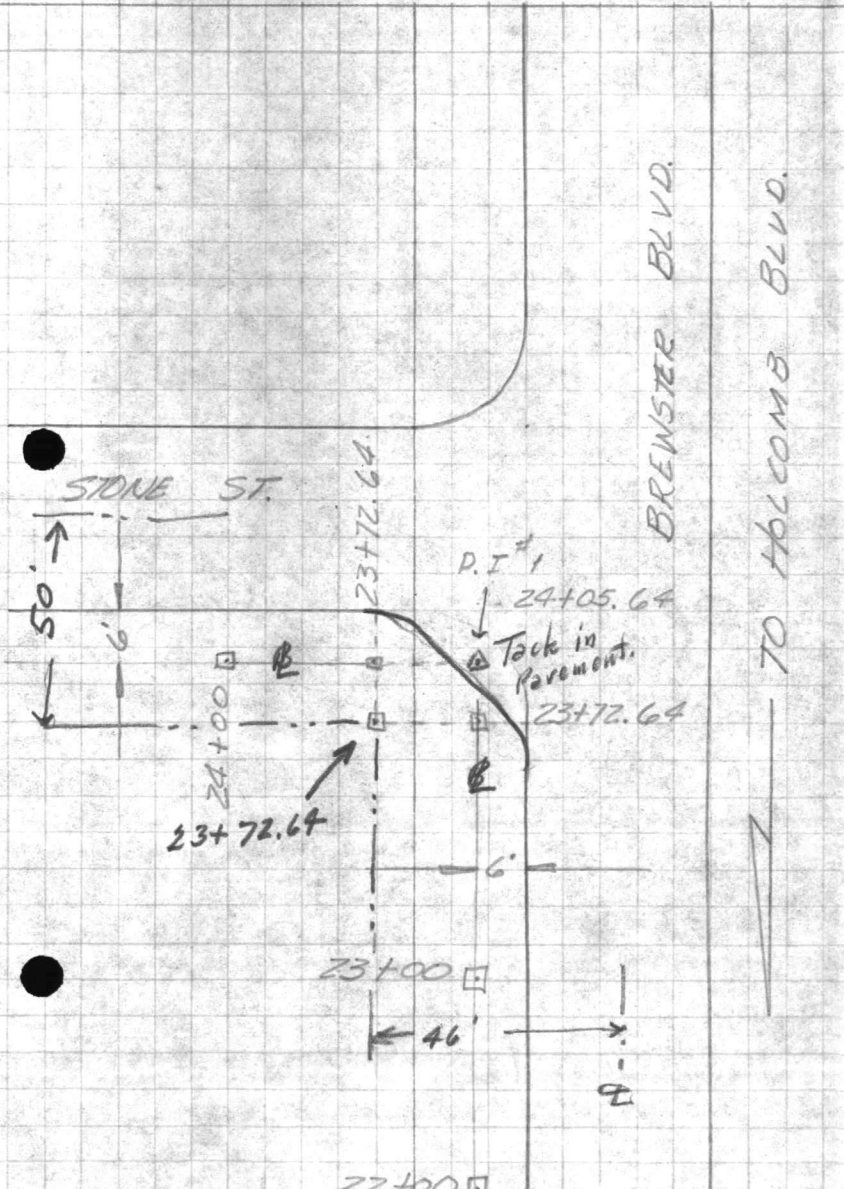












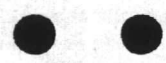

VALUABLE

RETURN TO
PUBLIC WORKS
OFFICE
CAMP LEJEUNE
NORTH CAROLINA

SUBJECT WATER LINE
CAPE HART HOUSING

FIELD PARTY

SNIPES IN CHARGE
SNIPES INSTRUMENT
SNIPES NOTES
RAFFNER TAPE READ
AMICALE TAPE OR ROD
ANDREWS TAPE OR ROD
STRUMENT NO. _____
TAPE NO. _____

WEATHER

CLEAR
CLOUDY
WINDY
RAIN
FAIR
SNOW
HOT
MODERATE
COLD
FOG

FILE No. _____
FLDR. No. _____
FIGURED BY _____ SHEET 6 OF
NOTES CHECKED BY _____
PLOTTED BY _____ DATE 28 AUG 1956

Quad. No. _____

STATION	DIST.	ANGLE ° ' "	+	H. I. BEARING	VER. ANG. DIFF.	ELEVATION	
						40100	□
						39100	□
						38100	□
						37100	□
						36100	□
						35100	□
						34190.47	△
						34100	□
						33100	□
						32100	□



STAKE ST
R.O.T. 2
17





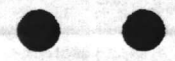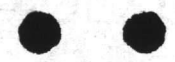







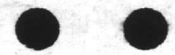

VALUABLE

RETURN TO
PUBLIC WORKS
OFFICE
CAMP LEJEUNE
NORTH CAROLINA

SUBJECT

Profile and Topography
Capehart Water Main
Brewster Blvd via Stone St.
to River Road

FIELD PARTY
Dennis IN CHARGE
INSTRUMENT
NOTES
TAPE READ
TAPE OR ROD
TAPE OR ROD
INSTRUMENT No.
TAPE No.

WEATHER
CLEAR
CLOUDY
WINDY
RAIN
FAIR
SNOW
HOT
MODERATE
COLD
FOG
FIGURED BY
NOTES CHECKED BY
PLOTTED BY

FILE No.
FLDR. No.
SHEET *102*
DATE *8-28* 19

Quad. No.

STATION	DIST.	ANGLE ° ' "	+	H. I. BEARING	VER. ANG. DIFF.	ELEVATION	
B.m.				4 73 33, 27		28.54	1 SPIKE IN P.P. # B-34 INT-BREWSTER BLVD. & DIRT RD. GEN. PLANT.
0+00					7.9	25.4	9' LT. WOOD LINE
0+40					7.7	25.6	
0+51							10.1' RT. GUY WIRE
0+76							10.1' RT. POWER POLE # AA-71
1+00					5.2	28.1	10' LT. WOOD LINE
1+83					3.0	30.3	
1+87					5.5	27.8	Edge of Earth Road
2+06					5.4	27.9	" " " "
2+10							10.1' RT. P.P. # B-35 31' LT. GUY POLE B-35S
2+20							10.1' RT. CONC. POST (TEL.)
2+25					3.2	30.1	9' LT. WOOD LINE
3+00					2.1	31.2	6' LT. WOOD LINE
3+43							10.1' RT. P.P. B-36
4+00					2.9	30.4	7' LT. WOOD LINE
5+00					2.7	30.6	7' LT. WOOD LINE
5+17.50							10.1' RT. P.P. B-37

VALUABLE

SUBJECT _____

RETURN TO
PUBLIC WORKS
OFFICE
CAMP LEJEUNE
NORTH CAROLINA

FIELD PARTY

IN CHARGE

INSTRUMENT

NOTES

TAPE READ

TAPE OR ROD

TAPE OR ROD

INSTRUMENT NO.

TAPE NO. _____

WEATHER

CLEAR

CLOUDY

WINDY

RAIN

FAIR

SNOW

HOT

MODERATE

COLD

FOG
FIGURED BY _____
NOTES CHECKED BY _____
PLOTTED BY _____

FILE No. _____

FLDR. No. _____

SHEET 207

DATE _____ 19__

Quad. No. _____

STATION	DIST.	ANGLE ° ' "	+	H. I. BEARING	VER. ANG. DIFF.	ELEVATION	
				33 27 ✓			
				✓ 33 87	3 73	29.54 ✓	
5+80				(33.9)	4.7	29.2	
6+00					5.9	28.0	3.40' LT. WOOD LINE
6+23					9.1	24.8	
6+78				PIPE	9.9	24.0	8.60' RT-END 18" R.C.P. → []
6+78					10.0	23.9	
6+92							10.1 RT. P.P. B-38
7+00					8.8	25.1	7' LT. WOOD LINE
7+72					4.4	29.3	
8+00					3.8	30.1	7' LT. WOOD LINE
8+68.				3.9			10.1' RT. P.P. # B-39
9+00					3.9	30.0	4' LT. WOOD LINE
10+00					3.8	30.1 ✓	4' LT. WOOD LINE
T.P.				✓ 35 43	2.24	31.61	
				382 34 8A		31.01	

VALUABLE

SUBJECT _____

RETURN TO
 PUBLIC WORKS
 OFFICE
 CAMP LEJEUNE
 NORTH CAROLINA

FIELD PARTY

 IN CHARGE

 INSTRUMENT

 NOTES

 TAPE READ

 TAPE OR ROD

 TAPE OR ROD

 INSTRUMENT NO. _____
 TAPE NO. _____

WEATHER

CLEAR
 CLOUDY
 WINDY
 RAIN
 FAIR

SNOW
 HOT
 MODERATE
 COLD
 FOG

FILE No. _____
 FLDR. No. _____
 SHEET 304
 DATE _____ 19__

FIGURED BY _____
 NOTES CHECKED BY _____
 PLOTTED BY _____
 Quad. No. _____

STATION	DIST.	ANGLE ° ' "	+	H. I. BEARING	VER: ANG. DIFF.	ELEVATION	
				3484 3543 ✓			
10+44				(35.5)			10.1 RT. P.P. B-40
11+00					54	30.1	4' LT. WOOD LINE
11+02							2.6 RT. CONC. POST. (TEL.)
12+00					47	30.8	5' LT. WOOD LINE
12+20							10.1' RT. P.P. B-41
13+00					37	31.8	3' LT. WOOD LINE
13+23							10.1' RT. GUY WIRE
13+94					42		10.1' RT. P.P. B-42 11' LT. GUY WIRE
14+00					42	31.3	7' LT. WOOD LINE
14+15							10.1' RT. GUY WIRE
15+00					39	31.6	3' LT. WOOD LINE
						32.58	
T.P.				3464 ✓	2.85	31.99	
				206 34.25			
15+45					7.1	27.6	
15+52				(34.7)	4.5	30.2	
15+59					35	31.2	
15+69							10.1' RT. P.P. B-43






VALUABLE

SUBJECT _____

RETURN TO
PUBLIC WORKS
OFFICE
CAMP LEJEUNE
NORTH CAROLINA

FIELD PARTY

IN CHARGE

INSTRUMENT

NOTES

TAPE READ

TAPE OR ROD

TAPE OR ROD

INSTRUMENT No. _____

TAPE No. _____

WEATHER

CLEAR

CLOUDY

WINDY

RAIN

FAIR

SNOW

HOT

MODERATE

COLD

FOG

FILE No. _____

FLDR. No. _____

SHEET 404

FIGURED BY _____

NOTES CHECKED BY _____

PLOTTED BY _____

DATE _____ 19__

Quad. No. _____

STATION	DIST.	ANGLE ° ' "	+	H. I. BEARING	VER: ANG. DIFF.	ELEVATION	
				3405 3464 ✓			
14+00				3466	3 0	31.7	34' LT. WOOD LINE
17+00					3 2	31.5	34' LT. WOOD LINE
17+44				(34.7)			10.1' RT- P.P.B- 44
18+00					3 2	31.5	3.4' LT- WOOD LINE
18+40					3 7	31.0	
19+00					4 7	30.0	4.4' LT- WOOD LINE
19+19							10.1' RT- P.P.# B. 45
19+34							9' LT- COR. WOODS
19+88					9 15	25.51	3.60' RT- SEWER M.H
19+92					5 3	29.4 ✓	TOP 15" SEWERLINE (T.C.) ON Q
20+00						30.28	31.4' LT- WOOD LINE
T.P.				✓ 3230 2 02 31 71	4 36	29.69	
20+93				(32.3)			10.1' RT. P.P. B- 46
21+00					3 8	28.5	11' LT- WOOD
22+00					3. 2	29.1	12' LT- WOOD LINE
22+70							10.1' RT. P.P. B- 47

VALUABLE

SUBJECT _____

RETURN TO
 PUBLIC WORKS
 OFFICE
 CAMP LEJEUNE
 NORTH CAROLINA

FIELD PARTY

 IN CHARGE

 INSTRUMENT

 NOTES

 TAPE READ

 TAPE OR ROD

 TAPE OR ROD

 INSTRUMENT NO. _____
 TAPE NO. _____

WEATHER

CLEAR _____
 CLOUDY _____
 WINDY _____
 RAIN _____
 FAIR _____
 SNOW _____
 HOT _____
 MODERATE _____
 COLD _____
 FOG _____
 FIGURED BY _____
 NOTES CHECKED BY _____
 PLOTTED BY _____

FILE No. _____
 FLDR. No. _____
 SHEET 50A
 DATE _____ 19__

Quad. No. _____

STATION	DIST.	ANGLE ° ' "	+	H. I. BEARING	VER. ANG. DIFF.	ELEVATION	
				32.30 31.7			
23+00					3.9	28.4	12.4' LT-COR. WOODS
23+08				(32.3)	4.2	28.1	
23+15					5.2	27.1	
23+20					4.9	27.4 ✓	
B.M.				^{✓ 77} 33.72	4.75	27.55 (27.60) 26.96	STONE & BREWSTER
				617 33.13			
23+72	69				6.1	27.7	
24+00				(33.8)	6.2	27.6	
24+15					6.3	27.5	
24+21					6.8	27.0	DITCH
24+33					5.5	28.3	
24+51							1.00' RT-COR. WOODS
25+00					4.0	29.8	7' RT. WOOD LINE
25+93							4' RT. COR. WOODS
26+00					3.9	29.9	
26+36							8' LT. COR. WOODS
27+00					6.0	27.8	6' RT. WOOD LINE
27+10					6.6	27.2	

33' OFF SET.

26+09.5 Top 15' T.C. Sewer Elev. 25.14

VALUABLE

SUBJECT _____

 RETURN TO
 PUBLIC WORKS
 OFFICE
 CAMP LEJEUNE
 NORTH CAROLINA

FIELD PARTY

IN CHARGE _____
 INSTRUMENT _____
 NOTES _____
 TAPE READ _____
 TAPE OR ROD _____
 TAPE OR ROD _____
 INSTRUMENT NO. _____
 TAPE NO. _____

WEATHER

CLEAR _____
 CLOUDY _____
 WINDY _____
 RAIN _____
 FAIR _____
 SNOW _____
 HOT _____
 MODERATE _____
 COLD _____
 FOG _____

FILE No. _____
 FLDR. No. _____
 SHEET Lot
 DATE _____ 19__

Quad. No. _____

STATION	DIST.	ANGLE ° ' "	+	H. I. BEARING	VER. ANG. DIFF.	ELEVATION	
27+21				33.22 33.75 33.8	8.6	25.2	DITCH
27+31					10.5	23.3	19' RT. 24" C. M. PIPE →
27+33					6.5	27.3	BANK
T.P.				32.79 32.84 7.50 32.20	8.43	29.70 25.34	
28+00				32.8			HI 32.84 33.00 26+09.50 ON C 7.70 24.55 25.14 TOP SEWER LINE
29+00					3.6	29.2	5' RT. WOOD LINE
30+00					3.3	29.5	5' RT. WOOD LINE
30+24.50					2.9	29.9	8' RT. WOOD LINE
31+00					2.4	30.4	29' RT. TEL. CABLE SPICE MARKER
T.P.				34.38 34.43 4.35 33.89	2.76	29.44 30.08	10' RT. WOOD LINE
32+00				34.4			5' RT. WOOD LINE
33+00					3.6	30.8	8' RT. WOOD LINE
34+00					2.9	31.5	9' RT. WOOD LINE
35+00					3.1	31.3	8' RT. WOOD LINE


























VALUABLE

SUBJECT _____

RETURN TO
 PUBLIC WORKS
 OFFICE
 CAMP LEJEUNE
 NORTH CAROLINA

FIELD PARTY

 IN CHARGE

 INSTRUMENT

 NOTES

 TAPE READ

 TAPE OR ROD

 TAPE OR ROD

 INSTRUMENT NO. _____
 TAPE NO. _____

WEATHER

CLEAR _____
 CLOUDY _____
 WINDY _____
 RAIN _____
 FAIR _____
 SNOW _____
 HOT _____
 MODERATE _____
 COLD _____
 FOG _____
 FIGURED BY _____
 NOTES CHECKED BY _____
 PLOTTED BY _____

FILE No. _____
 FLDR. No. _____
 SHEET 7 of _____
 DATE _____ 19__

Quad. No. _____

STATION	DIST.	ANGLE ° ' "	+	H. I. BEARING	VER. ANG. DIFF.	ELEVATION	
36+00				34.58 33.87	3 0	31.4	7' RT. WOOD LINE
T.P.				⁷⁸ 35.73 4.67 35.24	3.32	31.06 30.57	
37+00				(35.8)	4 4	31.4	6' RT. WOOD LINE
38+00					4 4	31.4	3' RT. WOOD LINE
39+00					4 9	30.9	3' LT. WOOD LINE
40+00					4 4	31.4	5' LT. WOOD LINE
40+63							4' LT. CONC. POST. (TEL.) Spliced Marker
41+00					4 8	31.0	5' LT. WOOD LINE
T.P.				⁰⁶ 34.07 3.99 35.52	3.71	32.02 31.53	
42+00				(36.1)	4 2	31.9	3' RT. WOOD LINE
43+00					4 5	31.6	5' RT. WOOD LINE
44+00					4 0	32.1	8' RT. WOOD LINE
45+00					4 3	31.8	10' RT. WOOD LINE
45+18 ²⁰							32' RT. TEL. M.H.
46+00					4 3	31.8	11' RT. WOOD LINE

RECEIVED
FEDERAL BUREAU OF INVESTIGATION
WASHINGTON, D.C.

48-129

48-129

VALUABLE

SUBJECT _____

 RETURN TO
 PUBLIC WORKS
 OFFICE
 CAMP LEJEUNE
 NORTH CAROLINA

FIELD PARTY

IN CHARGE _____
 INSTRUMENT _____
 NOTES _____
 TAPE READ _____
 TAPE OR ROD _____
 TAPE OR ROD _____
 INSTRUMENT NO. _____
 TAPE NO. _____

WEATHER

CLEAR _____ SNOW _____
 CLOUDY _____ HOT _____
 WINDY _____ MODERATE _____
 RAIN _____ COLD _____
 FAIR _____ FOG _____
 FIGURED BY _____
 NOTES CHECKED BY _____
 PLOTTED BY _____

FILE No. _____

FLDR. No. _____

SHEET 86A

DATE _____ 19__

Quad. No. _____

STATION	DIST.	ANGLE ° ' "	+	H. I. BEARING	VER. ANG. DIFF.	ELEVATION	
T.P.				36.24 35.52 35.88 35.34	✓ ✓	32.26 32.11	TOPSTAKE 46+00
47+00					3.95	31.57	11' RT. WOOD LINE
47+88				(35.9)	4.7	31.2	105' LT- P.P. # AB-25
47+94							11' RT- COR. WOODS
48+00					5.0	30.9	
48+07							104' RT- P.P.# AB-26
48+20							24.50' RT. END. 15" R.C.P.
48+27				Est later		?	WATER LINE ON #
48+44							24.50' RT. END 15" R.C.P.
48+48							13' RT. COR. WOODS
49+00					4.8	31.1	13' RT. WOOD LINE
T.P.				35.26 35.21	✓	29.89 31.38 32.11	
B.m.				3.15		31.57 30.55	TOP STAKE 46+00
B.P.				13		30.01	
B.m.				3.58		33.59 32.75	(32.18)
					1.93	31.66	SPIKE IN 12' PINE STA 90+28 60' RT. STONE STAKE




VALUABLE

SUBJECT _____

RETURN TO
PUBLIC WORKS
OFFICE
CAMP LEJEUNE
NORTH CAROLINA

FIELD PARTY

IN CHARGE

INSTRUMENT

NOTES

TAPE READ

TAPE OR ROD

TAPE OR ROD

INSTRUMENT NO.

TAPE NO.

WEATHER

CLEAR
CLOUDY
WINDY
RAIN
FAIR
SNOW
HOT
MODERATE
COLD
FOG

FILE No. _____

FLDR. No. _____

SHEET 96

FIGURED BY _____

NOTES CHECKED BY _____

PLOTTED BY _____

DATE _____ 19__

Quad. No. _____

STATION	DIST.	ANGLE ° ' "	+	H. I. BEARING	VER. ANG. DIFF.	ELEVATION	
B.m.				236 34 ⁵⁴ ✓		32 ¹⁵ ✓	SPIKE IN 12" PINE STA. 90+ STONEST. EXT.
50+00					3.2	31.3	16' RT. WOOD LINE
51+00					3.5	31.0	16' RT-WOOD LINE
52+00					3.6	30.9	14' RT-WOOD LINE
53+00					4.0	30.5	13' RT-WOOD LINE
54+00					4.3	30.2	14' RT-WOOD LINE
T.P.				402 34 ²⁸ ✓	4.28	30 ²⁶ ₂₃	
55+00					4.1	30.4	14' RT-WOOD LINE
55+29							25' RT. END 18" R.C.P.
56+00					4.2	30.3	16' RT. WOOD LINE
57+00					4.2	30.3	15' RT. WOOD LINE
T.P.					4.79	29 ⁴⁹ ₄₅	

VALUABLE

RETURN TO
PUBLIC WORKS
OFFICE
CAMP LEJEUNE
NORTH CAROLINA

SUBJECT

Profile -
Capehart Water Main
State Street

FIELD PARTY

Pennis IN CHARGE
INSTRUMENT
NOTES
TAPE READ
TAPE OR ROD
TAPE OR ROD
INSTRUMENT NO.
TAPE NO.

WEATHER

CLEAR
CLOUDY
WINDY
RAIN
FAIR
SNOW
HOT
MODERATE
COLD
FOG

FILE No. _____

FLDR. No. _____

SHEET

10 of

DATE

19

FIGURED BY _____

NOTES CHECKED BY _____

PLOTTED BY _____

Quad. No. _____

STATION	DIST.	ANGLE ° ' "	+	H. I. BEARING	VER: ANG. DIFF.	ELEVATION	
B.M.			2.39	34 57		32.18	SPIKE IN 12" PINE 90+23 60' RT. STONEST.
T.P.			2.46	33 63	3 40	31.17	
T.P.			3.18	33 65	3 16	30.47	
58+00					3 6	30.65	¹⁷ / ₃₄ w. 16' RT. WOOD
59+00					3 8	29.85	¹⁷ / ₃₃ w. 13' RT. WOOD.
60+00					3 8	29.95	¹⁷ / ₃₈ 12' RT. WOOD
B.M.			3.12	34.53	2.24	31.41	SPIKE IN PINE 60+50 ±
61+00					4 5	30.03	¹⁸ / ₅₃ 15' RT. WOOD
62+00					5 0	29.53	17 13' RT. WOOD.
63+00					4 3	30.23	¹⁷ / ₃₈ 12' RT. WOOD
64+00					4 6	29.93	17 13' RT. WOOD
T.P.			4.25	34.63	4 15	30.38	
65+00					4.2	30.43	12' RT. WOOD
66+00					4.4	30.23	13' RT. WOOD






VALUABLE

SUBJECT _____

RETURN TO
PUBLIC WORKS
OFFICE
CAMP LEJEUNE
NORTH CAROLINA

FIELD PARTY

IN CHARGE

INSTRUMENT

NOTES

TAPE READ

TAPE OR ROD

TAPE OR ROD

INSTRUMENT NO.

TAPE NO. _____

WEATHER

CLEAR
CLOUDY
WINDY
RAIN
FAIR
SNOW
HOT
MODERATE
COLD
FOG

FILE No. _____

FLDR. No. _____

SHEET 11 of

FIGURED BY _____
NOTES CHECKED BY _____

PLOTTED BY _____ DATE _____ 19__

Quad. No. _____

STATION	DIST.	ANGLE ° ' "	+	H. I. BEARING	VER: ANG. DIFF.	ELEVATION		
67+00				34.63	4 8	29 83	17	13' RT. WOOD.
68+00					4.8	29 83	$\frac{18}{17}$ 35	15' RT. WOOD.
T.P.				✓ 4.89	29.74			
				1.80 31.54				
69+00					2 3	29 24		12' RT. WOOD.
69+50					3.3	24 24		
70+00					4 7	26 84	$\frac{13}{5}$	18 RT. WOOD.
70+16							$\frac{11}{12}$ 28	22' RT. END 10" R.C.D.
70+25					5.6	25 94		
70+60					4 5	27 04	✓ 17	15.5' RT. CONC. POST. (TEL)
71+00					4 5	27 04	$\frac{12}{54}$	14' RT. WOOD.
72+00					2 6	28 94	17	16' RT. WOOD.
T.P.				34.03	3.01	28 53		
				5.50 33.03				
73+00					4 1	29 93	$\frac{12}{84}$	16' RT. WOOD.
74+00					4 4	29 63	17	14. RT. WOOD.
75+00					4 0	30 03	17	13' RT. WOOD.
























VALUABLE

SUBJECT _____

RETURN TO
 PUBLIC WORKS
 OFFICE
 CAMP LEJEUNE
 NORTH CAROLINA

FIELD PARTY

 IN CHARGE

 INSTRUMENT

 NOTES

 TAPE READ

 TAPE OR ROD

 TAPE OR ROD

 INSTRUMENT No. _____
 TAPE No. _____

WEATHER

CLEAR SNOW
 CLOUDY HOT
 WINDY MODERATE
 RAIN COLD
 FAIR FOG

FILE No. _____
 FLDR. No. _____
 SHEET 120+
 DATE _____ 19__

FIGURED BY _____
 NOTES CHECKED BY _____
 PLOTTED BY _____
 Quad. No. _____

STATION	DIST.	ANGLE " "	+	H. I. BEARING	VER. ANG. DIFF.	ELEVATION		
76+00				33 03 34 03	3 6	30 43	$\frac{27}{38}$	12' RT. WOOD.
T.P.				35	4 23	28 29 80		
			567	34.47				
77+00					4 7	30 77	17	13' RT. WOOD.
78+00					4 6	30 87	$\frac{12}{12}$	12' RT. WOOD.
79+00					4 5	30 97	17	13' RT. WOOD.
80+00					4 6	30 87		13' RT. WOOD.
T.P.				3A 397 33 58	4 86	29.61 30		
81+00					3 8	30 98	$\frac{19}{56}$	14' RT. WOODS
82+00					4 0	30 58	$\frac{17}{21}$	13' RT. WOOD.
82+56					5 1	29 48		
83+00					6 8	27 78		14' RT. WOOD
83+50					7 7	26 88		
83+85							10'	EARTH RD. ON E
T.P.				34 513 33 55	5 16	28 29 42		










VALUABLE

SUBJECT _____

RETURN TO
PUBLIC WORKS
OFFICE
CAMP LEJEUNE
NORTH CAROLINA

FIELD PARTY

IN CHARGE

INSTRUMENT

NOTES

TAPE READ

TAPE OR ROD

TAPE OR ROD

INSTRUMENT NO.

TAPE NO.

WEATHER

CLEAR
CLOUDY
WINDY
RAIN
FAIR
SNOW
HOT
MODERATE
COLD
FOG

FILE No. _____

FLDR. No. _____

SHEET

DATE

13 of

19

FIGURED BY _____
NOTES CHECKED BY _____
PLOTTED BY _____
Quad. No. _____


STATION	DIST.	ANGLE ° ' "	+	H. I. BEARING	VER: ANG. DIFF.	ELEVATION	
84+00				33 55 34 55	5 9	29 45	
84+14							39' RT. & 10' EARTH RD. EDGESTONE ST.
84+45					7 6	26 95	
85+00					5 6	28 95	15' RT. WOOD
85+50					6 2	28 35	
86+00					8.0	26 55	13' RT. WOOD
T. P.				33 4 02 32 66	1 91	28.64 29	
86+50					5 6	28 00	
87+00					5 3	28 36	15' RT. WOOD
87+50					6 8	26 86	
87+75					7 3	26 36	
88+00					6 8	26 86	12' RT. WOOD
T. P.				35 7.88 34.51	6.03	26 63 27	TOP HUB. 84+80 ³⁰ ON ELEC. FEEDER
89+00					8 7	26 81	15' RT. WOODS





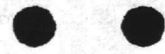

VALUABLE

SUBJECT _____

RETURN TO
 PUBLIC WORKS
 OFFICE
 CAMP LEJEUNE
 NORTH CAROLINA

FIELD PARTY

 IN CHARGE

 INSTRUMENT

 NOTES

 TAPE READ

 TAPE OR ROD

 TAPE OR ROD

 INSTRUMENT NO. _____
 TAPE NO. _____

WEATHER

CLEAR _____ SNOW _____
 CLOUDY _____ HOT _____
 WINDY _____ MODERATE _____
 RAIN _____ COLD _____
 FAIR _____ FOG _____

FILE No. _____
 FLDR. No. _____
 SHEET 17 of
 FIGURED BY _____
 NOTES CHECKED BY _____
 PLOTTED BY _____ DATE _____ 19__

Quad. No. _____

STATION	DIST.	ANGLE ° ' "	+	H. I. BEARING	VER: ANG. DIFF.	ELEVATION	
90+00				3003 3551	5 8	29 71	15' RT. WOOD
91+00					5 4	30 11	12' RT. WOOD
92+00					5 7	29 81	8' RT. WOOD.
93+00					5 5	30 01	10' RT. WOOD
93+56							WOOD LINE
94+					6 0	29 51	
						31 47	
T.P.				33 21	4.04	28 99	
			174	3073			
94+22							Φ WOOD RD
94+42							12' RT. 14' PINE
94+80							WOOD LINE ON Φ
95+00					3 4	29 81	10' RT. WOOD LINE 25' RT. Φ WOODS RD.
96+00					3 5	29 71	18' RT. WOOD.
97+00					3 5	29 61	17' RT. WOOD S
98+00					4.1	29 11	13' RT. WOOD
99+					5 1	28 11	13' RT. WOOD LINE
						28 88	
T.P.				32 68	4.33	26 40	
			380	3020			
















VALUABLE

SUBJECT _____

RETURN TO
 PUBLIC WORKS
 OFFICE
 CAMP LEJEUNE
 NORTH CAROLINA

FIELD PARTY

 IN CHARGE

 INSTRUMENT

 NOTES

 TAPE READ

 TAPE OR ROD

 TAPE OR ROD

 INSTRUMENT NO. _____
 TAPE NO. _____

WEATHER

CLEAR SNOW
 CLOUDY HOT
 WINDY MODERATE
 RAIN COLD
 FAIR FOG
 FIGURED BY _____
 NOTES CHECKED BY _____
 PLOTTED BY _____

FILE No. _____
 FLDR. No. _____
 SHEET 14 of
 DATE _____ 19__

Quad. No. _____

STATION	DIST.	ANGLE ° ' "	+	H. I. BEARING	VER: ANG. DIFF.	ELEVATION
B.M. on Hub P.C. Sta 106+78.80						
	3.98			32.56	✓	28.58
				(32.9)		
107+0				4.4		28.2
+88						
108				4.6		28.0
+68						
109				4.1		28.5
+19						
+58						
110				4.8		27.8
111				3.9		28.7
T.P.				✓		5.68 24.98 ✓
	3.33			30 21		
112				(30.2)		2.0 28.2
113				4.7		25.5
+19				4.0		24.2
+29				6.9		23.3
+33				6.8		23.4
114				8.1		22.1
+25						
115				10.3		19.9
T.P.				✓		7.06 23.15 ✓
	3.62			24 77		
+09				(24.8)		8.8 18.0
+24				10.6		16.2

Edge Woods
 10' Rt. Edge Woods of 23' Lt. Edge Woods

Edge Woods
 11' Lt. Edge Woods
 & Rd.

Edge Woods on &
 210' Earth Rd.

16' Lt & 15' Marl Rd.

& Ditch
 Edge Marl Rd.
 Edge " " 24' Rt End N' R.C.P.
 22' " " " "


Cluster of 12" Gums ONE





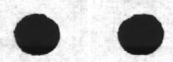

VALUABLE

SUBJECT _____

RETURN TO
 PUBLIC WORKS
 OFFICE
 CAMP LEJEUNE
 NORTH CAROLINA

FIELD PARTY

 IN CHARGE

 INSTRUMENT

 NOTES

 TAPE READ

 TAPE OR ROD

 TAPE OR ROD

 INSTRUMENT NO. _____
 TAPE NO. _____

WEATHER

CLEAR
 CLOUDY
 WINDY
 RAIN
 FAIR

SNOW
 HOT
 MODERATE
 COLD
 FOG

FILE No. _____

FLDR. No. _____

SHEET 17 of

FIGURED BY _____
 NOTES CHECKED BY _____
 PLOTTED BY _____
 DATE _____ 19__

Quad. No. _____

STATION	DIST.	ANGLE ° ' "	+	H. I. BEARING	VER: ANG. DIFF.	ELEVATION	
+26 MON.				26 77 ✓		3.37 23.40 ✓	MON. 164 (23.42) ✓ 2 2 10A 13.5 11.7
B.M.				3 06 26 48 ✓ (24.5)		23.42	MON. (164)
115+45 115+46					14 4	12.1	2' RT. END H.W.
115+50					11 3	15.2	BANK
115+58 115+61					16 9	9.6	DITCH 14.7' RT. END H.W.
115+67					16 9	9.6	DITCH
115+71 115+78 116+00					11 5 11 2	15 0 15 3	BANK WOOD LINE DN E
116+35					8 5	18.0	13' RT. COR. WOODS
116+51					7 6	18.9	
116+71					4 7	21.8	8' RT. WOOD LINE
117+00					3 5	23.0	
117+20					1 8	24.7	
































VALUABLE

SUBJECT _____

RETURN TO
 PUBLIC WORKS
 OFFICE
 CAMP LEJEUNE
 NORTH CAROLINA

FIELD PARTY

 IN CHARGE

 INSTRUMENT

 NOTES

 TAPE READ

 TAPE OR ROD

 TAPE OR ROD

 INSTRUMENT NO. _____
 TAPE NO. _____

WEATHER

CLEAR
 CLOUDY
 WINDY
 RAIN
 FAIR
 SNOW
 HOT
 MODERATE
 COLD
 FOG
 FIGURED BY _____
 NOTES CHECKED BY _____
 PLOTTED BY _____

FILE No. _____
 FLDR. No. _____
 SHEET 18 of
 DATE _____ 19__

Quad. No. _____

STATION	DIST.	ANGLE ° ' "	+	H. I. BEARING	VER: ANG. DIFF.	ELEVATION	
T.P.				26 48	✓		
				2 12	✓	24.36	
117+20			5 84	30 20			
117+31				(30.2)			4' RT. WOOD LINE
117+42				4 3		25 9	
117+62				3 1		27 1	
118+00				4 0		26 2	9' RT. WOOD LINE 12' RT. WOOD LINE
118+43				6 0		24.2	12' RT. COR. WOOD. ✓
118+50							WOOD LINE ON E.
118+55							47' LT. COR. WOOD.
118+62				5 8		24 4	
119+00				4 8		25 4	35' LT. COR. WOOD.
119+33							
119+45				4 4		25 8	
119+54				5 4		24.8	E R.D. (10')
119+66				4 8		25.4	
120+00				5 3		24 9	E R.D. (10')
120+28				4 7		25 5	
121+00				4 2		26 0	65' LT. E 10' R.D.
+50				4 3		25 9	
122+00				4 5		25 7	15' LT. COR. SMALL PINE FIELD.
T.P.				3 54	✓	26 60	

3,60 30, 26













































































VALUABLE

SUBJECT _____

 RETURN TO
 PUBLIC WORKS
 OFFICE
 CAMP LEJEUNE
 NORTH CAROLINA

FIELD PARTY

 _____ IN CHARGE
 _____ INSTRUMENT
 _____ NOTES
 _____ TAPE READ
 _____ TAPE OR ROD
 _____ TAPE OR ROD
 _____ INSTRUMENT NO.
 _____ TAPE NO.

WEATHER

 CLEAR SNOW
 CLOUDY HOT
 WINDY MODERATE
 RAIN COLD
 FAIR FOG

FILE No. _____

FLDR. No. _____

SHEET 19 of

DATE _____ 19__

 FIGURED BY _____
 NOTES CHECKED BY _____
 PLOTTED BY _____

Quad. No. _____

STATION	DIST.	ANGLE		+	H. I. BEARING	VER: ANG. DIFF.	ELEVATION		
		°	' "						
					30 26 ✓				
123+00					(30.3)	5 0	25 3	9'	LT. WOOD
124+00						4 5	25 8	7'	LT. WOOD
125+00						4.8	25 5	5'	LT. WOOD
126+00						5 5	24 8	4'	LT. WOOD
126+69						6 4	23.9	4'	LT. GUY WIRE
126+93 ⁵⁰								1'	RT. B-156
127+00						7 1	23 2	E (10')	RD. 90° TO LINE
127+29						6 9	23 4	4'	LT. WOOD.
127+63						6 7	23 6		BANK
+73						8 9	21.4		DITCH
127+78 ⁸⁰						7 0	23.3		BANK & P.T.
T.P.						7 05	23 21 ✓		TOP HUB P.T. 127+78 ⁸⁰
					4.87	28.08 ✓			
						(28.1)			
127+91						5 1		20'	RT. END 18" R.C.P.
128+00						5 1	23 0	15'	LT. WOOD.
129+00						5.3	22.8		

























VALUABLE

 SUBJECT _____

 RETURN TO
 PUBLIC WORKS
 OFFICE
 CAMP LEJEUNE
 NORTH CAROLINA

FIELD PARTY

 _____ IN CHARGE
 _____ INSTRUMENT
 _____ NOTES
 _____ TAPE READ
 _____ TAPE OR ROD
 _____ TAPE OR ROD
 _____ INSTRUMENT NO.
 _____ TAPE NO.

WEATHER

 CLEAR SNOW
 CLOUDY HOT
 WINDY MODERATE
 RAIN COLD
 FAIR FOG
 FIGURED BY _____
 NOTES CHECKED BY _____
 PLOTTED BY _____

FILE No. _____

FLDR. No. _____

 SHEET 20 of

DATE _____

19____

Quad. No. _____

STATION	DIST.	ANGLE ° ' "	+	H. I. BEARING	VER: ANG. DIFF.	ELEVATION	
129+22				28 08 (28.1)	✓		WOOD LINE
130+00					4 6	23.5	4' RT- WOOD
+05					4 4	23.7	
+09					5 6	22.5	
+12					4 9	23.2	
130+89							12' RT- CONG. POST
130+92							7' RT. COR. WOODS.
131+00					3 8	24.3	
131+50					3 7	24.4	
131+90							9' LT. COR. WOOD
132+00					4 4	23.7	
132+32							2.50' PJA.4 92' RT. PJA-3
132+69					4 6	23.5	BANK
T-P.					3 35	24.73	
				4 31	✓		
				29 04 (29.0)			
132+78					6 8	22.2	14' RT. END. 18" R.C.P.
132+83							10' RT. END WING WALL
132+87					4 9	24.1	BANK
132+89 ³⁰					4 7	24.3	GROUND.
132+89 ₃₀					6 75	22.29	TOP TEL. CABLE

$$\begin{array}{r} 475 \\ 200 \\ \hline 5.75 \end{array}$$







VALUABLE

 SUBJECT _____

 RETURN TO
 PUBLIC WORKS
 OFFICE
 CAMP LEJEUNE
 NORTH CAROLINA

FIELD PARTY

 _____ IN CHARGE
 _____ INSTRUMENT
 _____ NOTES
 _____ TAPE READ
 _____ TAPE OR ROD
 _____ TAPE OR ROD
 _____ INSTRUMENT NO.
 _____ TAPE NO.

WEATHER

 CLEAR
 CLOUDY
 WINDY
 RAIN
 FAIR
 SNOW
 HOT
 MODERATE
 COLD
 FOG

FILE No. _____

FLDR. No. _____

 SHEET 21 of

DATE _____ 19____

 FIGURED BY _____
 NOTES CHECKED BY _____
 PLOTTED BY _____
 Quad. No. _____

STATION	DIST.	ANGLE			H. I. BEARING	VER: ANG. DIFF.	ELEVATION	
		°	'	"				
132+93 ³⁰					29.04 ✓ (29.0)	4 84	24.20	EDGE BEVINS
133+00						4 64	24.40	
133+06						4 63	24.41	Φ BEVINS
133+17 ⁵⁰						4 75	24.29	EDGE BEVINS
133+24						4 9	24.1	BANK
133+29								16' RT. END WINGWALL
133+34						7.1	21.9	13' RT. END 18" R.C.P.
133+39						4 0	23.0	
133+48						4.8	24.2	
133+50 ²⁵						9 55	19.49	TOP 8" C.I. WATER
133+52 ⁵⁰						4.6	24.4	P.I. 133+52 ⁵⁰
B.m.						4.25	24.79	(29.72) NAIL INT. BEVIN & STONE
B.m.				4.55	29.27 ✓ (29.3)		24.72	NAIL INT. BEVIN & STONE.
133+66								2' LT. 4" OAK
134+00						4 9	24.4	
134+09								12' LT. 2' CONC. WALK
134+15								7.5' LT. 2' CONC. WALK

STANDARD

NO. 1

NO. 2

VALUABLE

SUBJECT _____

RETURN TO
 PUBLIC WORKS
 OFFICE
 CAMP LEJEUNE
 NORTH CAROLINA

FIELD PARTY

 IN CHARGE

 INSTRUMENT

 NOTES

 TAPE READ

 TAPE OR ROD

 TAPE OR ROD

 INSTRUMENT NO. _____
 TAPE NO. _____

WEATHER

 CLEAR

 CLOUDY

 WINDY

 RAIN

 FAIR

 SNOW

 HOT

 MODERATE

 COLD

 FOG

 FIGURED BY _____
 NOTES CHECKED BY _____
 PLOTTED BY _____

FILE No. _____
 FLDR. No. _____
 SHEET 22 of _____
 DATE _____ 19__

Quad. No. _____

STATION	DIST.	ANGLE ° ' "	+	H. I. BEARING	VER: ANG. DIFF.	ELEVATION	
P.I. 134+24 ²³				29 27 ✓ (29.3)	4 7	24.6	24' LT. 2' CONC. WALK
134+40 ⁷³							2' LT. 3' OAK
134+50 ⁰⁰							3.50 RT. END H.W.
134+57					4 5	24.8	EDGE MARL DR. 9.2' LT. END 2' CONC. WALK
134+70					4 5	24.7	" " "
134+74 ⁵⁰							4' RT. END H.W.
134+85							13.5' LT. 6" C. MORE
135+00					4.9	24.4	
135+00 ⁵⁰							3.70' RT. END H.W.
135+06							0.80' RT. 3" TREE ?
135+13 ⁰⁰					4 66	24.61	EDGE SER. DR. ASP
135+22 ⁶⁰					4 60	24.67	
135+29 ⁵⁰							.05' RT. 2" TREE CHERRY.
135+33 ⁸⁰							3.50' LT. P.J.B. - 1
135+34 ¹⁵					4 30	22.97	TOP TEL. CABLE
135+37 ⁵⁰							3.80' RT. END H.W.
135+79							4' LT. 3" TREE ?
136+00					4 2	25.1	
136+13 ⁵⁰							8' LT. END 2' CONC. DR.
136+55 ⁵⁰							2' LT. 2" OAK
136+83 ²⁰					8 22	21.05	8" C.I. WATER.
136+94							12.50' LT. END 2' CONC. DR. + END ASPHALT

4.90
 1.5
 5.30

3.32
 4.90
 8.22

VALUABLE

RETURN TO
PUBLIC WORKS
OFFICE
CAMP LEONIA
NORTH CAROLINA

SUBJECT


























VALUABLE

SUBJECT _____

RETURN TO
 PUBLIC WORKS
 OFFICE
 CAMP LEJEUNE
 NORTH CAROLINA

FIELD PARTY

 IN CHARGE

 INSTRUMENT

 NOTES

 TAPE READ

 TAPE OR ROD

 TAPE OR ROD

 INSTRUMENT No. _____
 TAPE No. _____

WEATHER

 CLEAR

 CLOUDY

 WINDY

 RAIN

 FAIR

 SNOW

 HOT

 MODERATE

 COLD

 FOG

 FIGURED BY _____
 NOTES CHECKED BY _____
 PLOTTED BY _____

FILE No. _____
 FLDR. No. _____
 SHEET 23 of _____
 DATE _____ 19__

Quad. No. _____

STATION	DIST.	ANGLE ° ' "	+	H. I. BEARING	VER: ANG. DIFF.	ELEVATION	
137+00				29 27 ✓ (29.3)	3 0	26 3	
T.P.				30 77 ✓ (30.8)	2 99	26.28 ✓	
137+09 50			4.49				
+29					4 22	26.55	EDGE EDGE DR.
+44 40					3 75	27.02	♀ EDGE N
					3 92	26.85	EDGE E DR.
137+64 50					4 7	26 1	14' LT. END ASPHALT + 2' CONC DR.
138+00					4.6	26 2	
138+07							5.50' LT. 2" OAK
138+42							6.20' LT. 2" DOGWOOD.
138+44							20.20' LT. END 2' CONC. DR.
138+73 50							6.30' LT. 3" TREE ?
139+00					4 7	26 1	
139+21 50			4.00		5 50	25 27	TOP TEL. CABLE
139+22							4' RT. END H.W.
139+24 20							4' LT. P.P. P.J.C - 1
139+34 60					3 98	26.79	EDGE SER. DR.
























VALUABLE

SUBJECT _____

RETURN TO
PUBLIC WORKS
OFFICE
CAMP LEJEUNE
NORTH CAROLINA

FIELD PARTY

IN CHARGE

INSTRUMENT

NOTES

TAPE READ

TAPE OR ROD

TAPE OR ROD

INSTRUMENT NO.

TAPE NO.

WEATHER

CLEAR

CLOUDY

WINDY

RAIN

FAIR

SNOW

HOT

MODERATE

COLD

FOG

FIGURED BY

NOTES CHECKED BY

PLOTTED BY

FILE No. _____

FLDR. No. _____

SHEET 24 of 24

DATE _____ 19__

Quad. No. _____

STATION	DIST.	ANGLE " "	+	H. I. BEARING	VER: ANG. DIFF.	ELEVATION	
139+45				30.77 <u>30.8</u>	✓	389 24.88	EDGE SER. DR.
139+59							370 RT. 370 H. W.
139+62							9' LT. 2" DOGWOOD
139+94							9.50' LT. 6" TREE ?
140+00						51 25 7	
140+34 ⁵⁰							21' LT- END 2' CONC. DR.
140+41 ²⁰							10' LT. 2" DOGWOOD.
140+70 ⁵⁰						57 25 1	10.50' LT. 2" OAK
140+88						44 24 2	
141+00						74 23 4	
141+06 ⁴⁵						821 22.56	ON TOP EXISTING 12" C.I.
B.m.						679 23.98 <u>23.97</u>	MAIL INZ. RIVER & STONE
















VALUABLE

SUBJECT _____

 RETURN TO
 PUBLIC WORKS
 OFFICE
 CAMP LEJEUNE
 NORTH CAROLINA

FIELD PARTY

 IN CHARGE

 INSTRUMENT

 NOTES

 TAPE READ

 TAPE OR ROD

 TAPE OR ROD

 INSTRUMENT No. _____
 TAPE No. _____

WEATHER

 CLEAR

 CLOUDY

 WINDY

 RAIN

 FAIR

 SNOW

 HOT

 MODERATE

 COLD

 FOG

 FIGURED BY _____
 NOTES CHECKED BY _____
 PLOTTED BY _____


FILE No. _____
 FLDR. No. _____
 SHEET _____
 DATE _____ 19____

Quad. No. _____

STATION	DIST.	ANGLE ° ' "	+	H. I. BEARING	VER. ANG. DIFF.	ELEVATION
						1+47.6 □
						1+30.7 □
						1+12.7 □
						0+94.6 □
						0+76.3 □
						0+58.1 □
						0+39.7 □
						0+21.7 □
						0+00 ○

Brewster Blvd
 Sewer (Face Man)
 from school

Measurements are
 from center Man hole
 to center of
 each pier

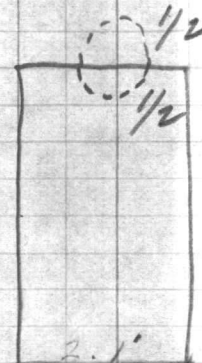

Brick Piers 2.1' X 1.1'

4.4' Above ground

Brick Piers

4.9' Above ground

6.5' from
 BOTTOM of Ditch to
 BOTTOM of water
 line

18" R.C.P. under Rd. with end wall

No. 4 Pier 1.5' from
 Ditch Bank

No. 3 Pier 3.0' Rth. from
 Ditch Bank

3.5' Ditch

M.H.






VALUABLE

RETURN TO
PUBLIC WORKS
OFFICE
CAMP LEJEUNE
NORTH CAROLINA

SUBJECT

END WALL DIMENSIONS
ON CULVERT AT STONE ST.
& Brewster Blvd.
Capelart Housing

FIELD PARTY

Kellum
IN CHARGE
INSTRUMENT
NOTES
TAPE READ
TAPE OR ROD
TAPE OR ROD
INSTRUMENT No.
TAPE No.

WEATHER

CLEAR
CLOUDY
WINDY
RAIN
FAIR
SNOW
HOT
MODERATE
COLD
FOG

FILE No. _____

FLDR. No. _____

FIGURED BY _____

SHEET

NOTES CHECKED BY _____

DATE



PLOTTED BY _____

8-18


1958

Quad. No. _____

STATION	DIST.	ANGLE		+	H. I. BEARING	VER. ANG. DIFF.	ELEVATION
		°	' "				

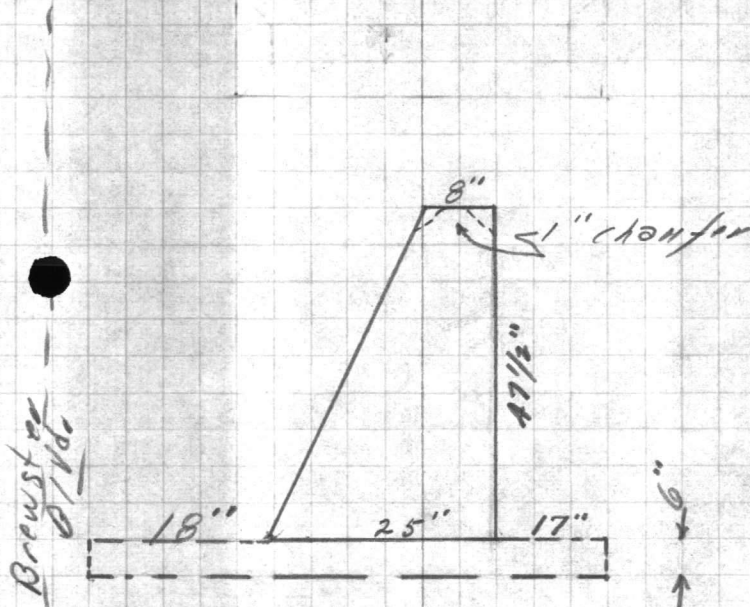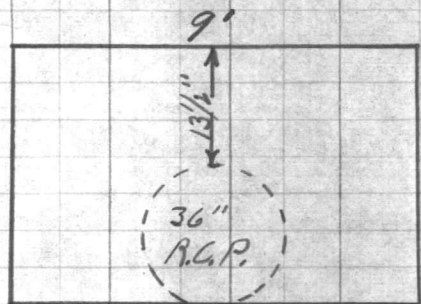

Brewster Blvd.

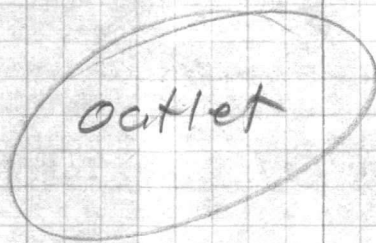

































VALUABLE

RETURN TO
PUBLIC WORKS
OFFICE
CAMP LEJEUNE
NORTH CAROLINA

SUBJECT Ditch Profile from
End of 36" culvert under
Brewster Blvd. at stone
St. to Natural Fall.

FIELD PARTY

K. S. H. W. H. IN CHARGE
____ INSTRUMENT
____ NOTES
____ TAPE READ
____ TAPE OR ROD
____ TAPE OR ROD
____ INSTRUMENT NO.
____ TAPE NO.

WEATHER

CLEAR _____ SNOW _____
CLOUDY _____ HOT _____
WINDY _____ MODERATE _____
RAIN _____ COLD _____
FAIR _____ FOG _____
FIGURED BY _____
NOTES CHECKED BY _____
PLOTTED BY _____


FILE No. _____
FLDR. No. _____
SHEET 2-04
DATE 8-18 1958

Quad. No. _____

STATION	DIST.	ANGLE ° ' "	+	H. I. BEARING	VER: ANG. DIFF.	ELEVATION
B.M.	0+00					19.2
			9.25	28.45		
0+36					8.4	20.0
0+50					8.3	20.1
1+0					8.5	19.9
1+50					8.8	19.6
2+0					9.1	19.3
2+50					9.4	19.0
3+0					10.2	18.4

inv. 36" RCP under Brewster
Blvd. outlet END

Bend in ditch

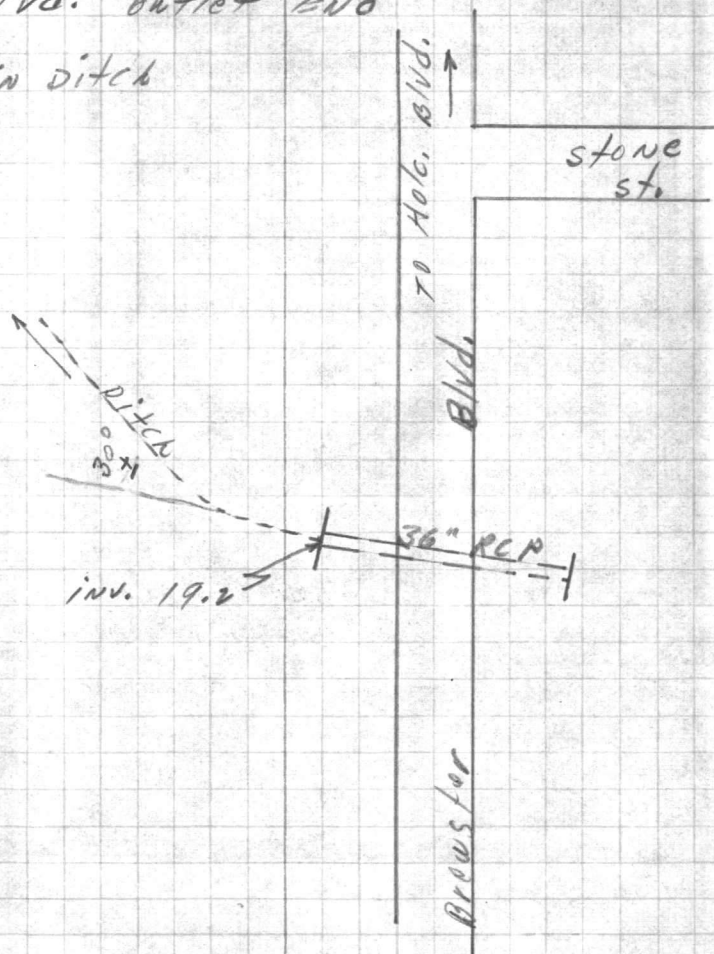

VALUABLE

RETURN TO
PUBLIC WORKS
OFFICE
CAMP LEJEUNE
NORTH CAROLINA

SUBJECT PROFILE
FROM SEWER M.H. # 270
across Drainage Ditch from
24" Metal Pipe under Stone St.

FIELD PARTY
Dennis IN CHARGE
Morton INSTRUMENT
Morton NOTES
Morton TAPE READ
____ TAPE OR ROD
____ TAPE OR ROD
____ INSTRUMENT NO.
____ TAPE NO.

WEATHER
CLEAR _____
CLOUDY _____
WINDY _____
RAIN _____
FAIR _____
SNOW _____
HOT _____
MODERATE _____
COLD _____
FOG _____
FIGURED BY _____
NOTES CHECKED BY _____
PLOTTED BY _____

FILE No. _____
FLDR. No. _____
SHEET _____
DATE 8-12-1958

Quad. No. _____

STATION	DIST.	ANGLE " "	+	H. I. BEARING	VER: ANG. DIFF.	ELEVATION
B.M.				5.48	33.18	27.70
0+00	M.H. #270			(33.2)		
0+22					7.0	26.2
0+33					8.1	25.1
0+37.7	1 st Bell on Pipe Joint					
0+43					9.1	24.1
0+53	Top of Pipe				8.4	24.8
0+54					10.5	22.7
0+56	2 nd Bell on Pipe Joint				10.5	22.7
0+58					7.8	25.4
0+65					9.6	23.6
0+72					7.4	25.8
0+74	3 rd Bell on Pipe Joint					
0+87					8.0	25.2
B.M.					5.48	27.70
1+30	M.H. #269					

Int. Stone St. & Brewster Blvd
Sewer M.H. #270 Inv. 23.63

ditch bank
Exposed Pipe
Bottom ditch


ditch bank

0+37.7
18.0
0+55.7
0+73.7

23.63
- 0.6
23.57
23.63
23.49
.14

24.93
- 24.88
23.63
1.25
24.88

Inv. 23.49

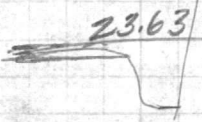

VALUABLERETURN TO
PUBLIC WORKS
OFFICE
CAMP LEJEUNE
NORTH CAROLINA

SUBJECT

Profile Across Bender's
Branch on Capehart
Water Line.

FIELD PARTY

IN CHARGE _____
INSTRUMENT _____
NOTES _____
TAPE READ _____
TAPE OR ROD _____
TAPE OR ROD _____
INSTRUMENT NO. _____
TAPE NO. _____

WEATHER

CLEAR _____ SNOW _____
CLOUDY _____ HOT _____
WINDY _____ MODERATE _____
RAIN _____ COLD _____
FAIR _____ FOG _____
FIGURED BY _____
NOTES CHECKED BY _____
PLOTTED BY _____

FILE No. _____

FLDR. No. _____

SHEET

1-07

DATE 6-19 1958

Quad. No. _____

STATION	DIST.	ANGLE ° ' "	+	H. I. BEARING	VER: ANG. DIFF.	ELEVATION
B.M.						23.42
		3.27		26.69		
0+0					8.6	18.1
0+14					10.4	16.3
0+24					14.5	12.2
0+36					14.0	12.7
0+41					11.0	15.7
0+48					16.5	9.2
0+53					17.7	9.0
0+58					17.2	9.5
0+63					11.7	15.0
0+82					10.7	16.0
1+0					10.7	16.0
1+35					8.1	18.6

NON. #164


BANK

Ditch Edge

E Ditch

Edge ditch

BANK

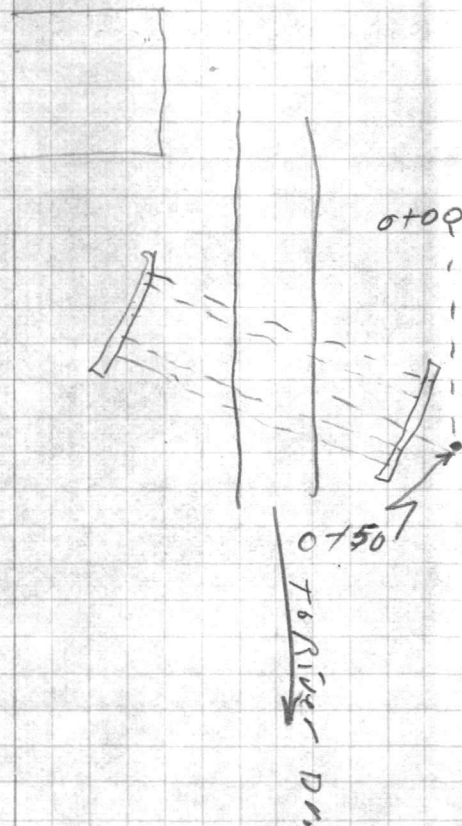






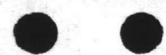

VALUABLE

RETURN TO
PUBLIC WORKS
OFFICE
CAMP LEJEUNE
NORTH CAROLINA

SUBJECT Water Line Location
AT Sewer Lift Sta.
Wallace Creek


FIELD PARTY
Morton IN CHARGE
INSTRUMENT _____
NOTES _____
TAPES READ _____
TAPE OR ROD _____
TAPE OR ROD _____
INSTRUMENT NO. _____
TAPE NO. _____

WEATHER
CLEAR _____
CLOUDY _____
WINDY _____
RAIN _____
FAIR _____
SNOW _____
HOT _____
MODERATE _____
COLD _____
FOG _____
FIGURED BY _____
NOTES CHECKED BY _____
PLOTTED BY _____

FILE No. _____
FLDR. No. _____
SHEET 1-0/1
DATE 6-10-58

Quad. No. _____

STATION	DIST.	ANGLE ° ' "	+	H. I. BEARING	VER. ANG. DIFF.	ELEVATION
BM.				2.79 11. 22		8.43
①	Top	12" Water		7.65	3.57	
②	"	"	Ball	7.52	3.70	
③	"	"	"	7.02	4.20	
④	"	"	Water	7.15	4.07	

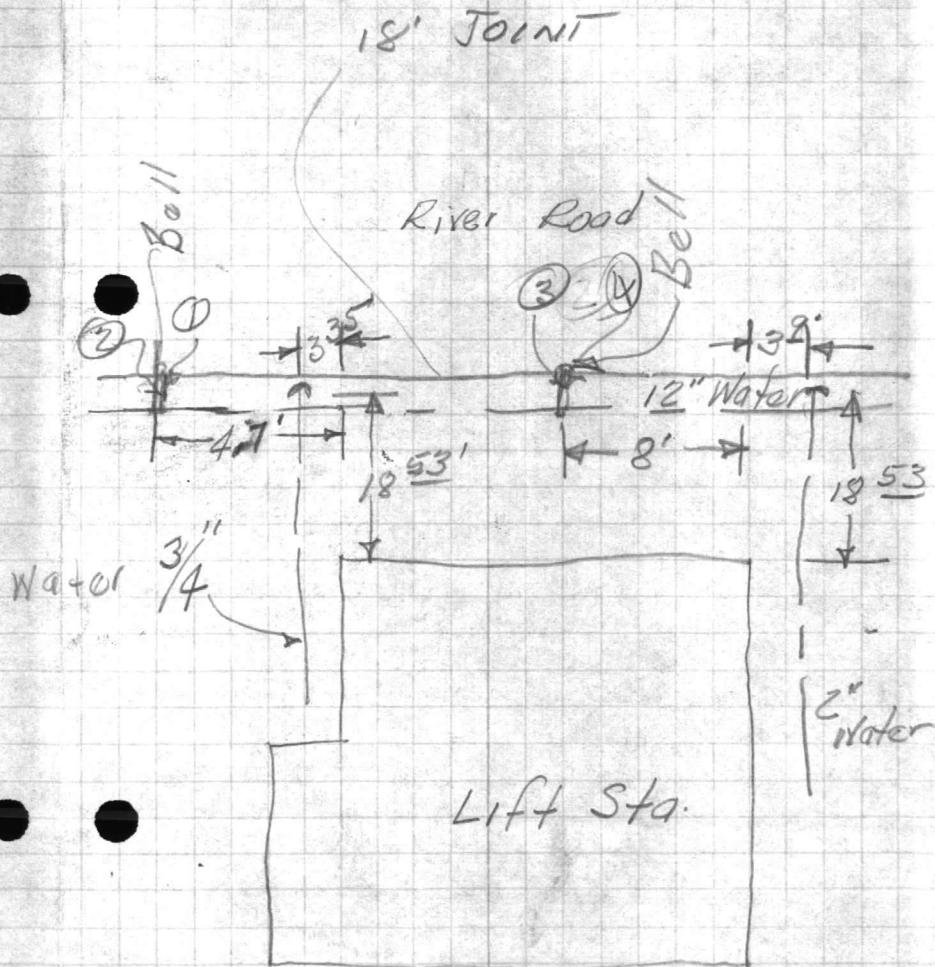









VALUABLE

RETURN TO
PUBLIC WORKS
OFFICE
CAMP LEJEUNE
NORTH CAROLINA

SUBJECT LOCATION GAS TANK
8 C" T.C. DRAIN BLDG.
47 LIFT STA.


FIELD PARTY
DENNIS IN CHARGE
____ INSTRUMENT
____ NOTES
____ TAPE READ
____ TAPE OR ROD
____ TAPE OR ROD
____ INSTRUMENT NO.
____ TAPE NO.

WEATHER
CLEAR _____ SNOW _____
CLOUDY _____ HOT _____
WINDY _____ MODERATE _____
RAIN _____ COLD _____
FAIR _____ FOG _____
FIGURED BY _____
NOTES CHECKED BY _____
PLOTTED BY _____

FILE No. _____
FLDR. No. _____
SHEET 1 of 2
DATE 6-2-58

Quad. No. _____

STATION	DIST.	ANGLE ° ' "	+	H. I. BEARING	VER. ANG. DIFF.	ELEVATION
B-M				290 11 33		8 43
A" TOP TANK					11 06	0.3
B TOP TANK					11 19	0.1
C" TOP C" T.C.					6 65	
D TOP C" T.C.					6 55	
E TOP C" T.C.					6 58	
F TOP C" T.C.					7 05	

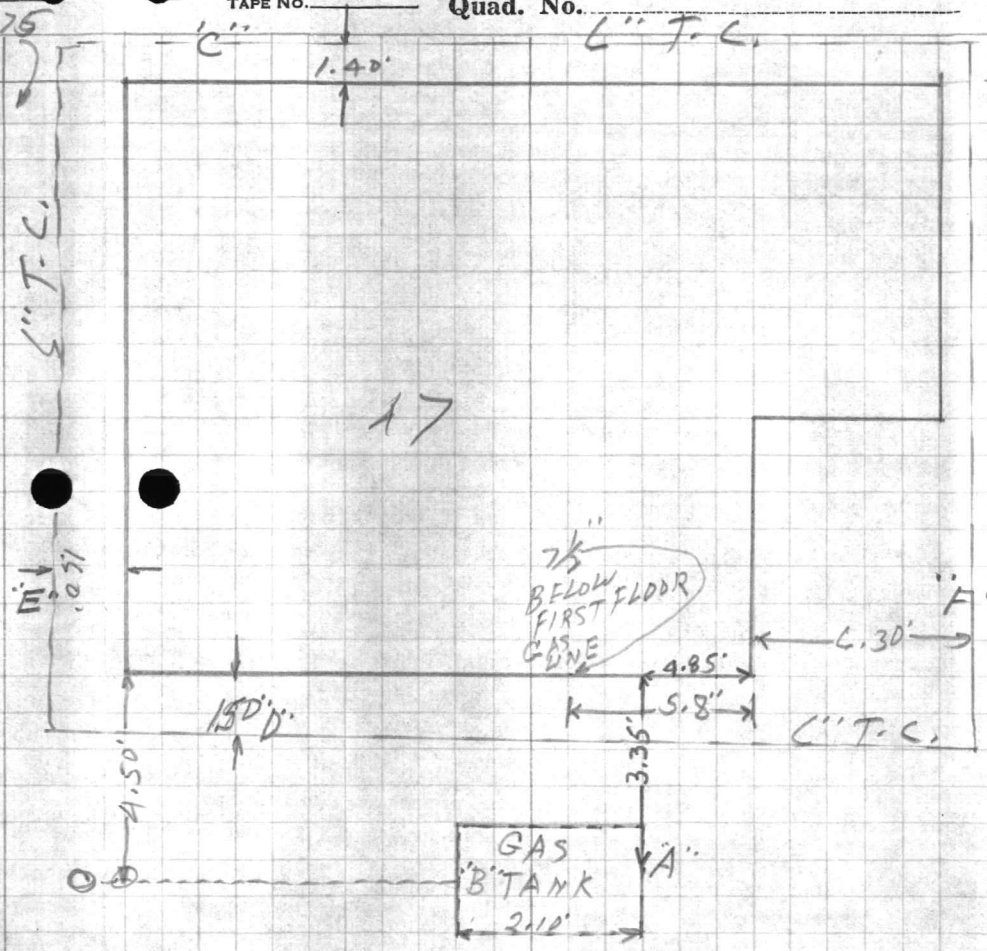

55
57
58
55
55
55


VALUABLE

RETURN TO
PUBLIC WORKS
OFFICE
CAMP LEJEUNE
NORTH CAROLINA

SUBJECT LOCATION 12" SEWER
LINE

FIELD PARTY
DENNIS IN CHARGE
INSTRUMENT
NOTES
TAPE READ
TAPE OR ROD
TAPE OR ROD
INSTRUMENT NO.
TAPE NO.


WEATHER
CLEAR
CLOUDY
WINDY
RAIN
FAIR
SNOW
HOT
MODERATE
COLD
FOG
FIGURED BY
NOTES CHECKED BY
PLOTTED BY

FILE No.
FLDR. No.
SHEET 1 of 1
DATE 5-30-58

Quad. No.

STATION	DIST.	ANGLE ° ' "	+	H. I. BEARING	VER: ANG. DIFF.	ELEVATION
B.m				3 22 11 65		8 43
"A"					10 65	
B.					13 92	

SPIKE IN P.D. # B175

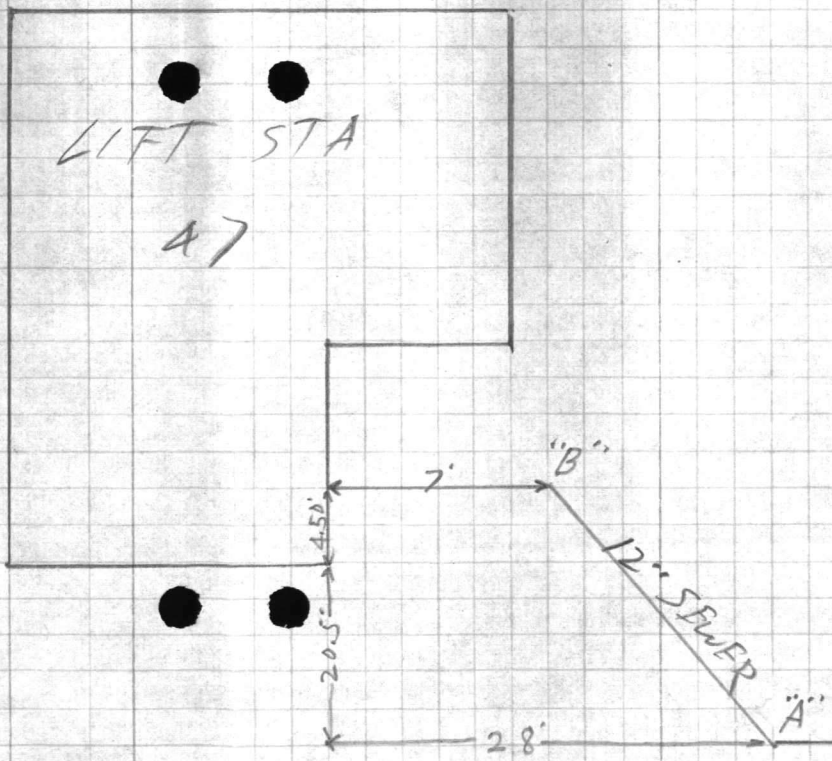

P.D. # B176




VALUABLE

RETURN TO
PUBLIC WORKS
OFFICE
CAMP LEJEUNE
NORTH CAROLINA

SUBJECT

water valve location
AT sewage lift sta.
AT wallace creek

FIELD PARTY

____ IN CHARGE
____ INSTRUMENT
____ NOTES
____ TAPE READ
____ TAPE OR ROD
____ TAPE OR ROD
____ INSTRUMENT No.
____ TAPE No.

WEATHER

CLEAR
CLOUDY
WINDY
RAIN
FAIR
SNOW
HOT
MODERATE
COLD
FOG

FILE No. _____

FLDR. No. _____

FIGURED BY _____

NOTES CHECKED BY _____

PLOTTED BY _____


SHEET 1-07
DATE 6-10 1958

Quad. No. _____

STATION	DIST.	ANGLE			H. I. BEARING	VER. ANG. DIFF.	ELEVATION
		°	'	"			

____ River Drive TO Paradise

valve on
12" W.L.
59'

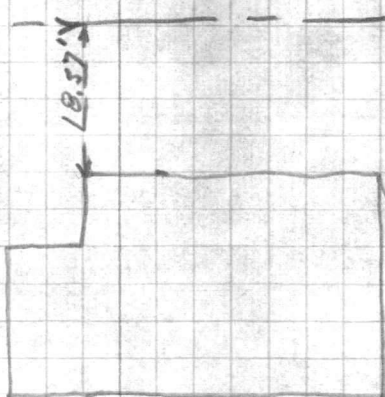

VALUABLE

SUBJECT _____

RETURN TO
PUBLIC WORKS
OFFICE
CAMP LEJEUNE
NORTH CAROLINA

FIELD PARTY

IN CHARGE

INSTRUMENT

NOTES

TAPE READ

TAPE OR ROD

TAPE OR ROD

INSTRUMENT NO.

TAPE NO.

WEATHER

CLEAR

CLOUDY

WINDY

RAIN

FAIR

SNOW

HOT

MODERATE

COLD

FOG

FILE No. _____

FLDR. No. _____


FIGURED BY _____ SHEET _____

NOTES CHECKED BY _____

PLOTTED BY _____ DATE _____ 19__

Quad. No. _____

STATION	DIST.	ANGLE		+	H. I. BEARING	VER. ANG. DIFF.	ELEVATION
		°	"				

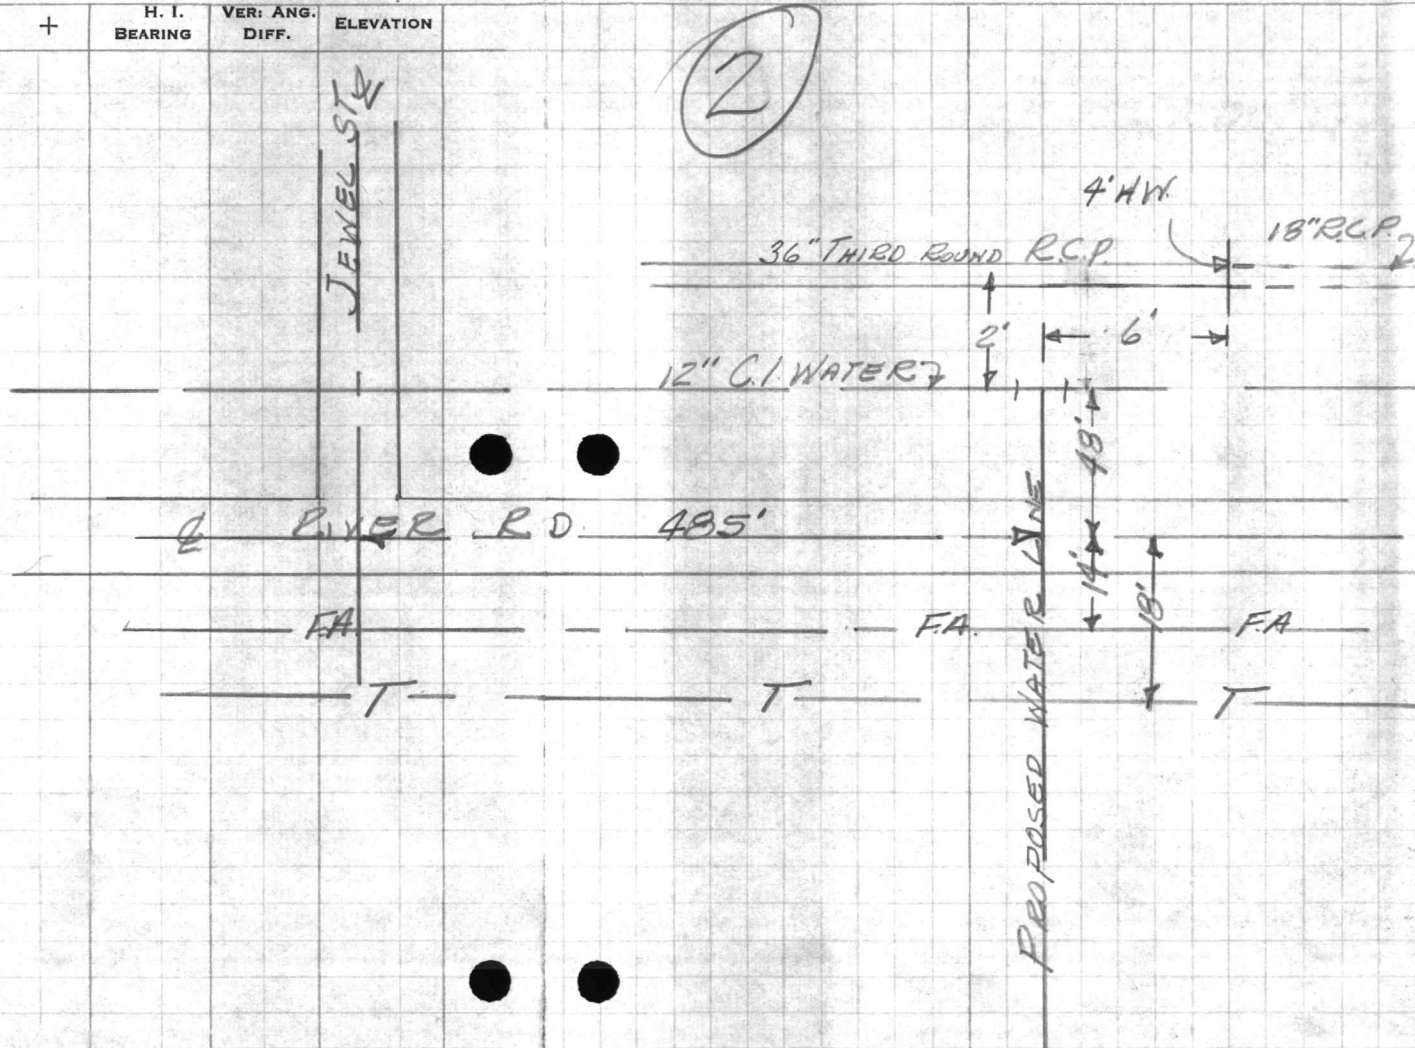

VALUABLE

SUBJECT Under ground utilities
 LOC. Paradise Point
 Area.

RETURN TO
 PUBLIC WORKS
 OFFICE
 CAMP LEJEUNE
 NORTH CAROLINA

FIELD PARTY

____ IN CHARGE
 ____ INSTRUMENT
 ____ NOTES
 ____ TAPE READ
 ____ TAPE OR ROD
 ____ TAPE OR ROD
 ____ INSTRUMENT NO.
 ____ TAPE NO.

WEATHER

CLEAR
 CLOUDY
 WINDY
 RAIN
 FAIR

SNOW
 HOT
 MODERATE
 COLD
 FOG

FILE No. _____


FLDR. No. _____

SHEET 4 of 5

DATE 8-1-58

Quad. No. _____

STATION	DIST.	ANGLE		+	H. I. BEARING	VER. ANG. DIFF.	ELEVATION
		°	' "				
							(1)

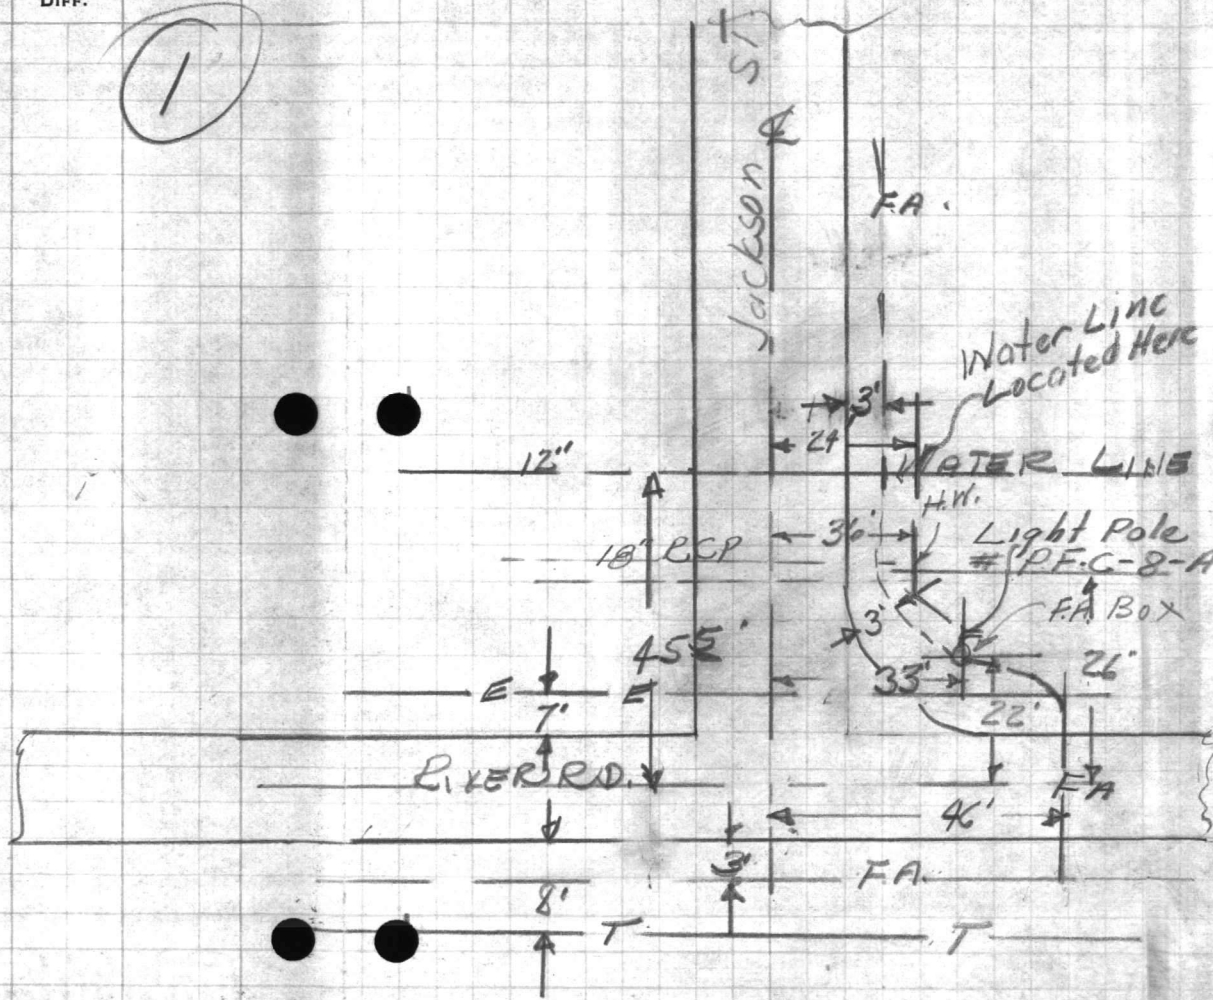




















VALUABLE

SUBJECT _____

RETURN TO
PUBLIC WORKS
OFFICE
CAMP LEJEUNE
NORTH CAROLINA

FIELD PARTY

IN CHARGE

INSTRUMENT

NOTES

TAPE READ

TAPE OR ROD

TAPE OR ROD

INSTRUMENT NO.

TAPE NO.

WEATHER


CLEAR
CLOUDY
WINDY
RAIN
FAIR
SNOW
HOT
MODERATE
COLD
FOG

FILE No. _____
FLDR. No. _____
FIGURED BY _____
NOTES CHECKED BY _____
PLOTTED BY _____
SHEET 3-07
DATE 8-1-58

Quad. No. _____

STATION	DIST.	ANGLE ° ' "	+	H. I. BEARING	VER. ANG. DIFF.	ELEVATION
---------	-------	----------------	---	------------------	--------------------	-----------

(3) 100 HOUSES

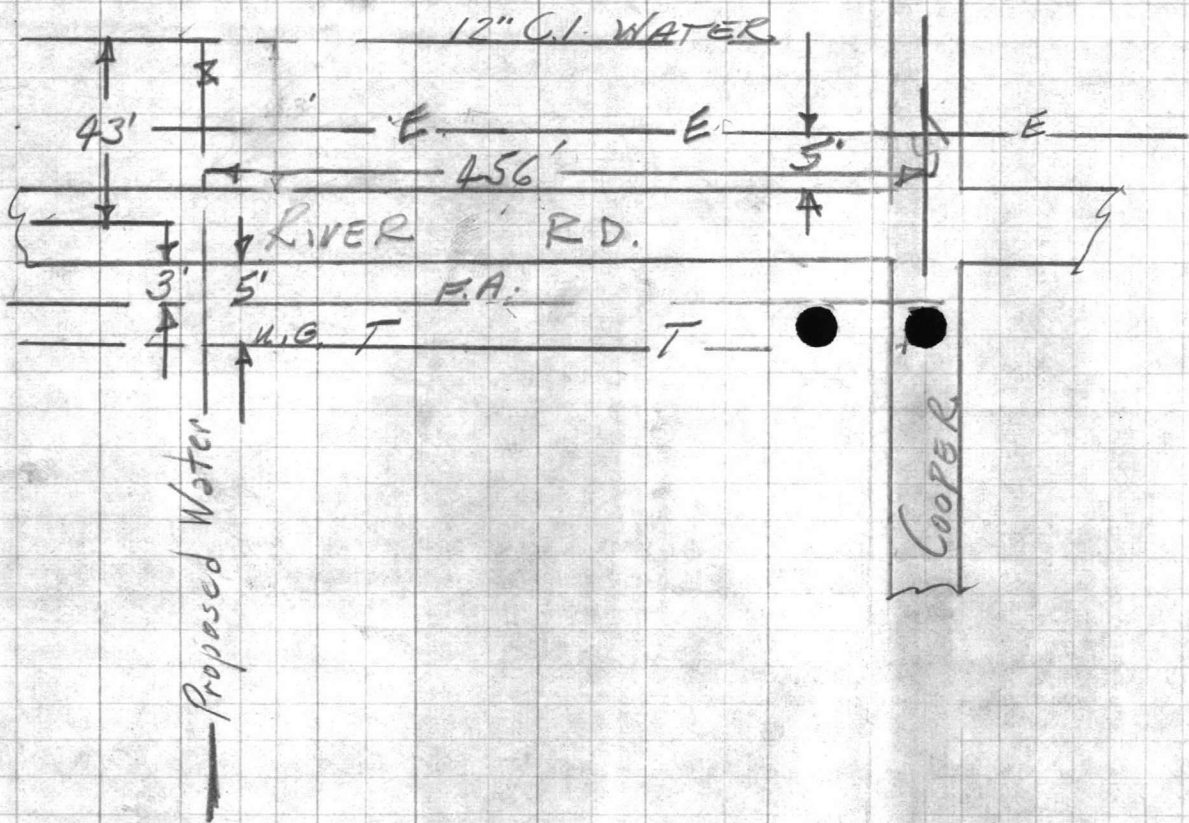

Wallace
Creek →

VALUABLE


























VALUABLE

SUBJECT _____

RETURN TO
PUBLIC WORKS
OFFICE
CAMP LEJEUNE
NORTH CAROLINA

FIELD PARTY

IN CHARGE

INSTRUMENT

NOTES

TAPE READ

TAPE OR ROD

TAPE OR ROD

INSTRUMENT NO.

TAPE NO. _____

WEATHER

CLEAR SNOW
CLOUDY HOT
WINDY MODERATE
RAIN COLD
FAIR FOG

FILE No. _____

FLDR. No. _____

FIGURED BY _____ SHEET 4-07


NOTES CHECKED BY _____ DATE 8-1 1958

PLOTTED BY _____

Quad. No. _____

STATION	DIST.	ANGLE ° ' "	+	H. I. BEARING	VER. ANG. DIFF.	ELEVATION
---------	-------	----------------	---	------------------	--------------------	-----------

(4)

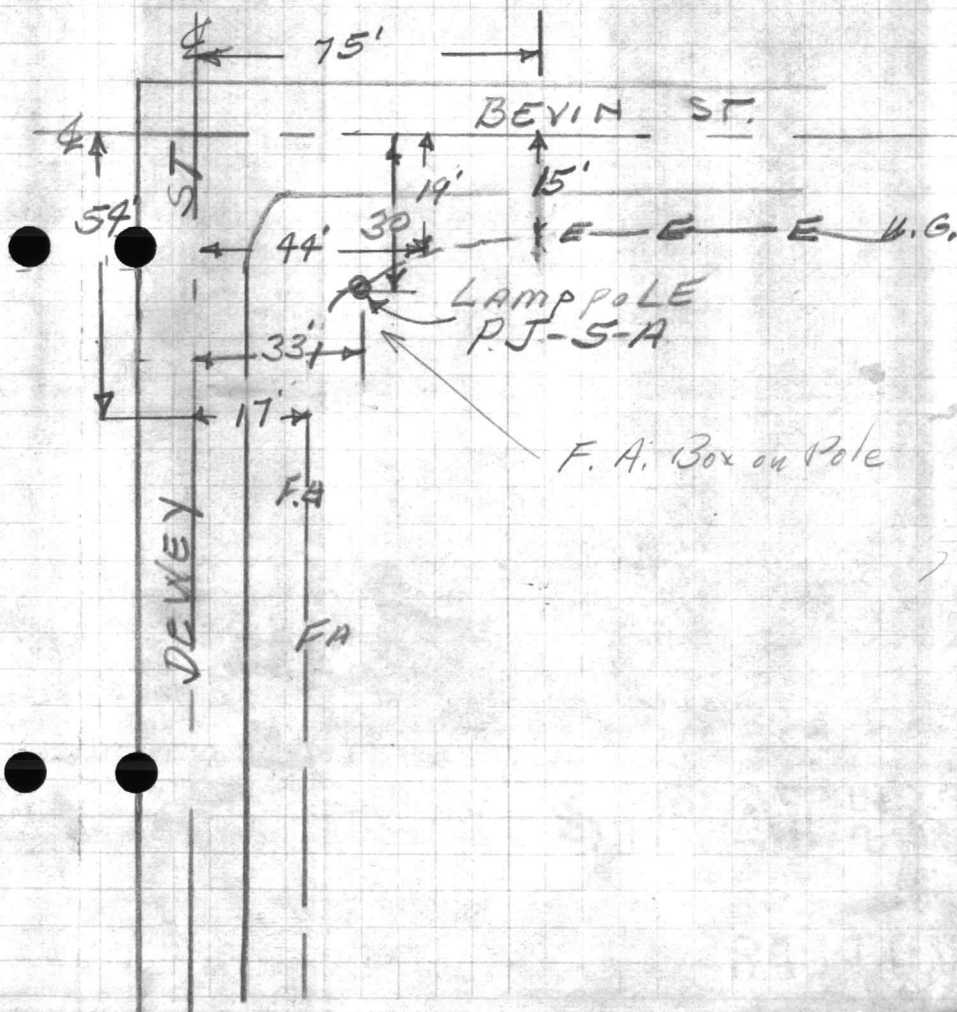

VALUABLE





























VALUABLE

SUBJECT _____

RETURN TO
PUBLIC WORKS
OFFICE
CAMP LEJEUNE
NORTH CAROLINA

FIELD PARTY

IN CHARGE

INSTRUMENT

NOTES

TAPE READ

TAPE OR ROD

TAPE OR ROD

INSTRUMENT No.

TAPE No.

WEATHER

CLEAR
CLOUDY
WINDY
RAIN
FAIR
SNOW
HOT
MODERATE
COLD
FOG

FILE No. _____

FLDR. No. _____

FIGURED BY _____ SHEET 5-of

NOTES CHECKED BY _____ DATE 8-1-58

PLOTTED BY _____

Quad. No. _____

STATION DIST. ANGLE
 ° ' " +
 H. I. VER. ANG. ELEVATION
 BEARING DIFF.

(5)


67 Houses

TELEP. M.H.

TELEP. M.H.


← TO WALLACE CR.

RIVER

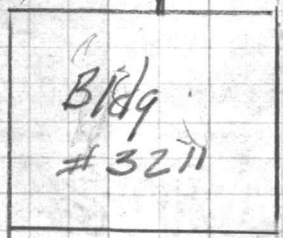

6001 Houses

STONE

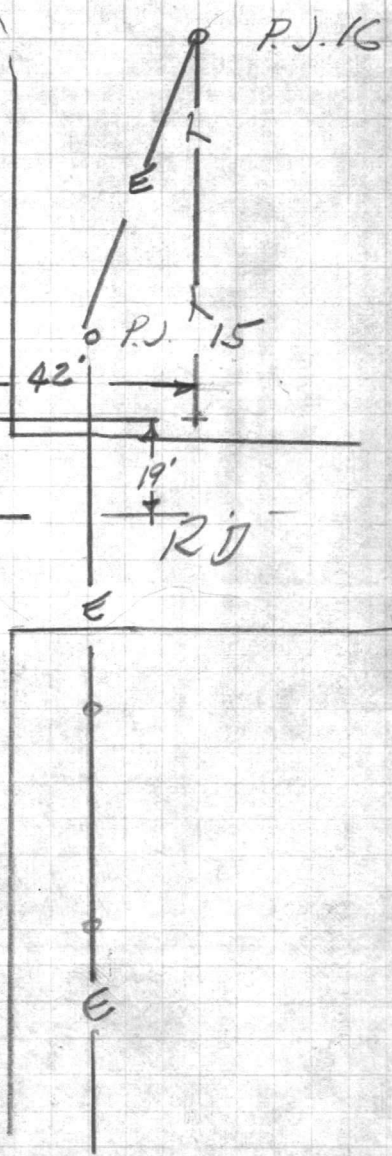

VALUABLE

























VALUABLE

RETURN TO
PUBLIC WORKS
OFFICE
CAMP LEJEUNE
NORTH CAROLINA

SUBJECT Existing water Line
Loc. of Elev. Near Camp
School.
offsite utilities for
Copeland Housing

FIELD PARTY

Kolury IN CHARGE
____ INSTRUMENT
____ NOTES
____ TAPE READ
____ TAPE OR ROD
____ TAPE OR ROD
____ INSTRUMENT NO.
____ TAPE NO.


WEATHER

CLEAR _____ SNOW _____
CLOUDY _____ HOT _____
WINDY _____ MODERATE _____
RAIN _____ COLD _____
FAIR _____ FOG _____
FIGURED BY _____
NOTES CHECKED BY _____
PLOTTED BY _____

FILE No. _____
FLDR. No. _____
SHEET 1-07 1
DATE 8-24-56

Quad. No. _____

STATION	DIST.	ANGLE ° ' "	+	H. I. BEARING	VER. ANG. DIFF.	ELEVATION
B.M.			2.57	31.11		28.54
Top of 10" X 8" Tee			9.00	24.11		
Top of 4" C.I. Pipe in Rd. Ditch			9.20	21.91		

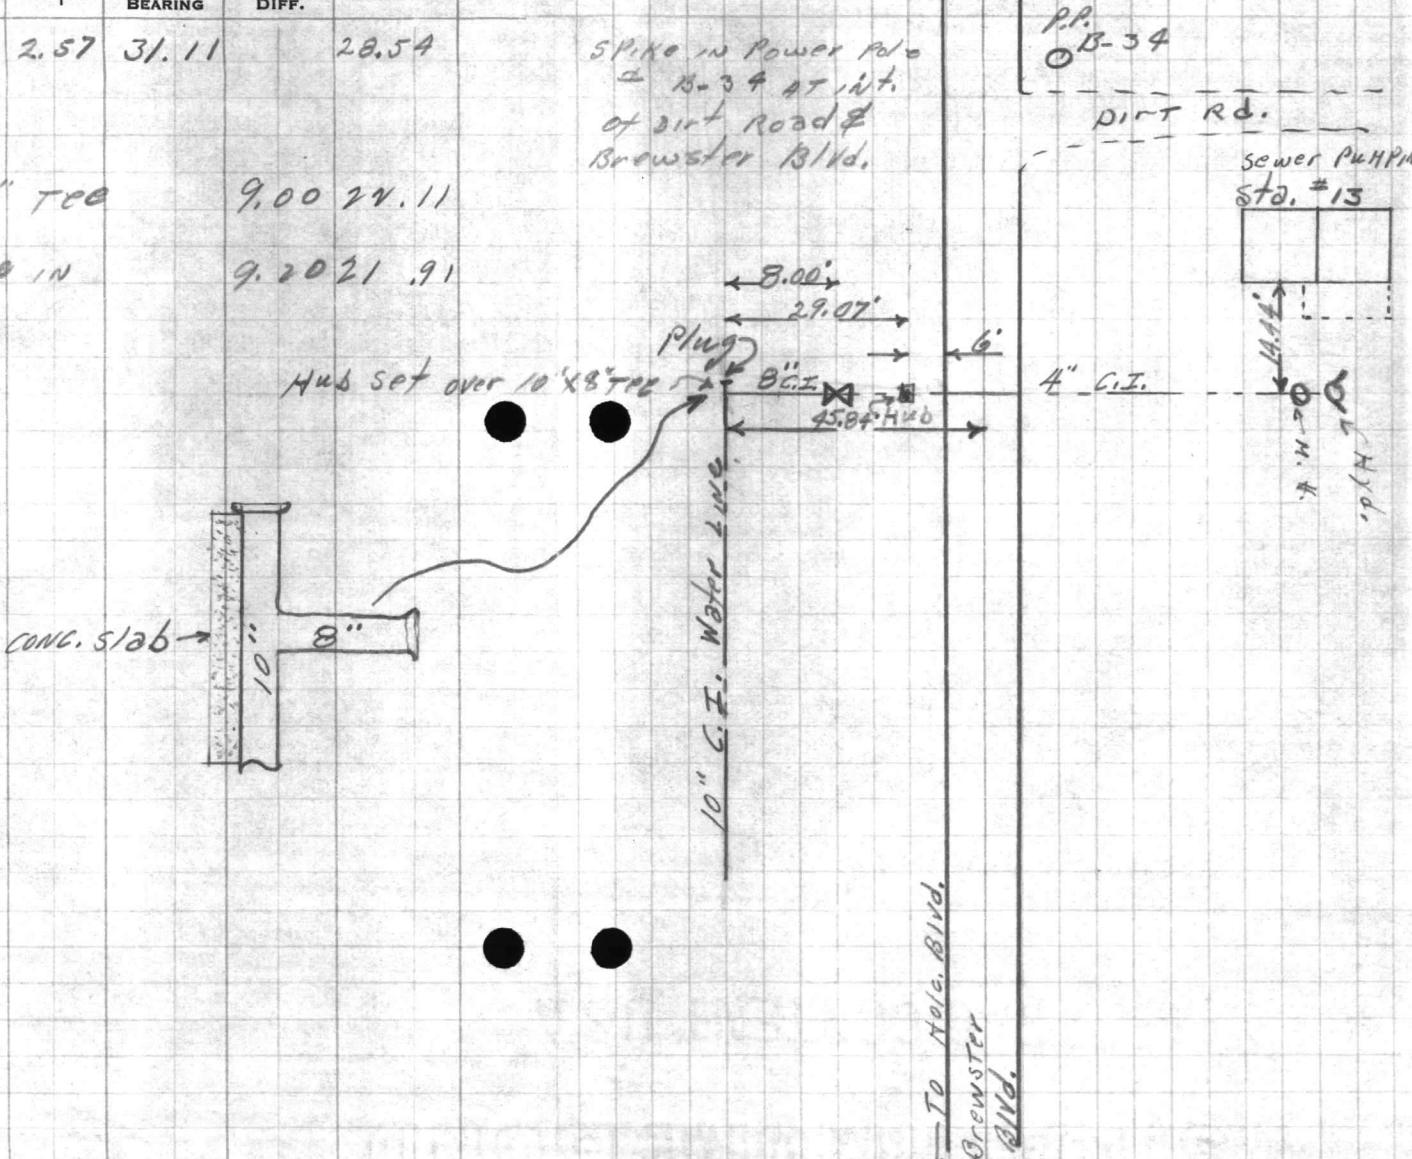

VALUABLE

SUBJECT BENCH LEVELS
TO AREA OF 0+0 ON
CAPEHART HOUSING WATER
LINE

RETURN TO
 PUBLIC WORKS
 OFFICE
 CAMP LEJEUNE
 NORTH CAROLINA

FIELD PARTY

____ IN CHARGE
 ____ INSTRUMENT
 ____ NOTES
 ____ TAPE READ
 ____ TAPE OR ROD
 ____ TAPE OR ROD
 ____ INSTRUMENT NO.
 ____ TAPE NO.

WEATHER

CLEAR
 CLOUDY
 WINDY
 RAIN
 FAIR
 SNOW
 HOT
 MODERATE
 COLD
 FOG

FILE No. _____
 FLDR. No. _____
 SHEET 1 of 1
 DATE 8-28 1976

FIGURED BY _____
 NOTES CHECKED BY _____
 PLOTTED BY _____
 Quad. No. _____

STATION	DIST.	ANGLE ° ' "	+	H. I. BEARING	VER. ANG. DIFF.	ELEVATION
B.m.			3 37	34 .65 33		30 28
T.P.			2.44	30 34 .31	5.78	28.87 ✓
B.m.			1.80	30 34 .34	1.77	28 29.54
T.P.			5 72	33 34 .64	2.42	27 28.92
B.m.					3 36	30 28

MON.

SPIKE IN POWER PILE B-34 INTER-
 SECTION BREWSTER BLDG. Y DIRT
 ROAD TO CAMP GEN. PLANT

30.28 MON.



100.00
 52.05

 48.95

35 + 52.05
 61.58

 3490.47