

Measurements -

Set 5' Lt. of Water Line from  
Midway Park to Holcomb Blvd.

Stations shown are on Original Stakeout for

Construction

|    |    |    |    |    |    |    |
|----|----|----|----|----|----|----|
| 50 | 50 | 50 | 50 | 50 | 50 | 50 |
| x  | x  | x  | x  | x  | x  | x  |
| 7  | 7  | 12 | 17 | 22 | 27 | 32 |

McMahon

f. Day

VALUABLE

SUBJECT water line location  
AND Profile


Return To  
 Public Works  
 Office  
 Camp Lejeune  
 North Carolina

FIELD PARTY  
Holloway In Charge  
 Instrument \_\_\_\_\_  
 Notes \_\_\_\_\_  
 Tape Read \_\_\_\_\_  
 Tape or Rod \_\_\_\_\_  
 Tape or Rod \_\_\_\_\_  
 Instrument No. \_\_\_\_\_  
 Tape No. \_\_\_\_\_

WEATHER  
 Clear \_\_\_\_\_  
 Cloudy \_\_\_\_\_  
 Windy \_\_\_\_\_  
 Rain \_\_\_\_\_  
 Fair \_\_\_\_\_  
 Snow \_\_\_\_\_  
 Hot \_\_\_\_\_  
 Moderate \_\_\_\_\_  
 Cold \_\_\_\_\_  
 Fog \_\_\_\_\_

FILE No. 120-H  
 Flidr. No. \_\_\_\_\_  
 Sheet 1-07-  
 Date 8-22-1950  
 Plotted By \_\_\_\_\_  
 Quad. No. 120

| Station     | Dist.                | Angle " | H. I. Bearing | Ver: Ang. Diff. | Elevation |
|-------------|----------------------|---------|---------------|-----------------|-----------|
| B.M. #733-A |                      |         |               |                 | 33.17     |
| 0+00        | oil 10" pipe         | 5.44    | 38.61         | ✓               | 29.40     |
| 0+22        | BEND                 |         |               | 9.21            | 29.28     |
| 0+44        |                      |         |               | 9.33            | 28.85     |
| 0+98        | R Holcomb d/vd.      |         |               | 9.76            | 28.03     |
| 1+65        |                      |         |               | 10.58           | 28.02     |
| 1+73        | Midway Park 14" line |         |               | 10.59           | 30.06     |
| 2+00        |                      |         |               | 8.55            | 29.44     |
| 2+50        |                      |         |               | 9.17            | 29.70     |
| 3+00        |                      |         |               | 8.91            | 29.80     |
| 3+50        | BEND                 |         |               | 8.81            | 29.42     |
| 4+00        |                      |         |               | 9.19            | 29.37     |
| 4+50.6      | R.R.                 |         |               | 9.24            | 29.78     |
| T.P.        |                      |         |               | 4.83            | 33.78     |

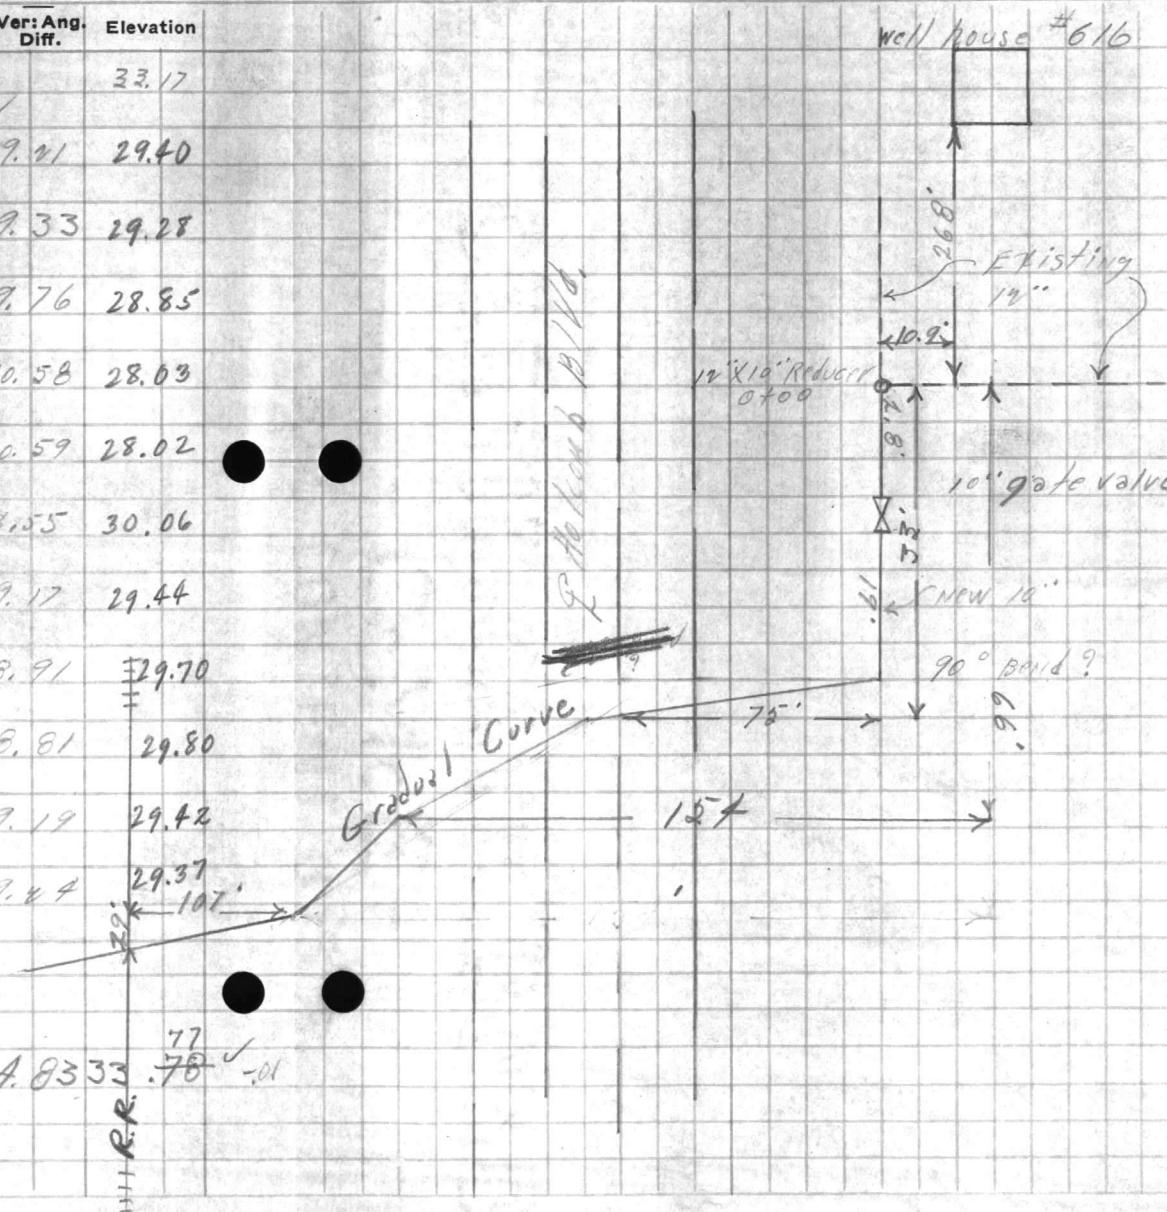

3.98 37.76

RR







**VALUABLE**

SUBJECT Water pipe location  
and profile south

Return To  
 Public Works  
 Office  
 Camp Lejeune  
 North Carolina

FIELD PARTY  
 \_\_\_\_\_ In Charge  
 \_\_\_\_\_ Instrument  
 \_\_\_\_\_ Notes  
 \_\_\_\_\_ Tape Read  
 \_\_\_\_\_ Tape or Rod  
 \_\_\_\_\_ Tape or Rod  
 \_\_\_\_\_ Instrument No.  
 \_\_\_\_\_ Tape No.

WEATHER  
 Clear \_\_\_\_\_  
 Cloudy \_\_\_\_\_  
 Windy \_\_\_\_\_  
 Rain \_\_\_\_\_  
 Fair \_\_\_\_\_  
 Snow \_\_\_\_\_  
 Hot \_\_\_\_\_  
 Moderate \_\_\_\_\_  
 Cold \_\_\_\_\_  
 Fog \_\_\_\_\_  
 Figured By \_\_\_\_\_  
 Notes Checked By \_\_\_\_\_  
 Plotted By \_\_\_\_\_

FILE No. \_\_\_\_\_  
 Fldr. No. \_\_\_\_\_  
 Sheet 2-07  
 Date 8-22-1950

Quad. No. \_\_\_\_\_

| Station | Dist. | Angle " | + | H. I. Bearing | Ver: Ang Diff. | Elevation |
|---------|-------|---------|---|---------------|----------------|-----------|
|         |       |         |   | 37.76         | ✓              |           |
| 5400    |       |         |   |               | 7.85           | 29.90     |
| 5750    |       |         |   |               | 8.07           | 29.68     |
| 6400    |       |         |   |               | 7.45           | 30.30     |
| 6750    |       |         |   |               | 7.45           | 30.30     |
| 7400    |       |         |   |               | 7.51           | 30.24     |
| 7750    |       |         |   |               | 7.74           | 30.51     |
| 8400    |       |         |   |               | 7.84           | 29.93     |
| 8750    |       |         |   |               | 7.84           | 29.93     |
| 9400    |       |         |   |               | 7.81           | 29.94     |
| 9750    |       |         |   |               | 8.47           | 29.28     |
| 10400   |       |         |   |               | 8.60           | 29.15     |
| T.P.    |       |         |   | 41            | 8.49           | 29.47     |
|         |       |         |   | 6.47          | 35.74          |           |
| 10750   |       |         |   |               | 6.07           | 29.64     |
| 11400   |       |         |   |               | 6.14           | 29.27     |
| 11750   |       |         |   |               | 6.60           | 29.11     |





























**VALUABLE**

SUBJECT water line profile  
cont'd.

Return To  
 Public Works  
 Office  
 Camp Lejeune  
 North Carolina

**FIELD PARTY**

In Charge \_\_\_\_\_  
 Instrument \_\_\_\_\_  
 Notes \_\_\_\_\_  
 Tape Read \_\_\_\_\_  
 Tape or Rod \_\_\_\_\_  
 Tape or Rod \_\_\_\_\_  
 Instrument No. \_\_\_\_\_  
 Tape No. \_\_\_\_\_

**WEATHER**

Clear \_\_\_\_\_  
 Cloudy \_\_\_\_\_  
 Windy \_\_\_\_\_  
 Rain \_\_\_\_\_  
 Fair \_\_\_\_\_  
 Snow \_\_\_\_\_  
 Hot \_\_\_\_\_  
 Moderate \_\_\_\_\_  
 Cold \_\_\_\_\_  
 Fog \_\_\_\_\_

FILE No. \_\_\_\_\_

Fldr. No. \_\_\_\_\_

Figured By \_\_\_\_\_ Sheet 3 of

Notes Checked By \_\_\_\_\_

Plotted By \_\_\_\_\_ Date 8-22-1950

Quad. No. \_\_\_\_\_

| Station | Dist. | Angle<br>' " | + | H. I.<br>Bearing | Ver: Ang.<br>Diff. | Elevation |
|---------|-------|--------------|---|------------------|--------------------|-----------|
|         |       |              |   | 35.71            | ✓                  |           |
| 12+00   |       |              |   |                  | 6.47               | 29.24     |
| 12+50   |       |              |   |                  | 6.94               | 28.77     |
| 13+00   |       |              |   |                  | 7.47               | 28.24     |
| 13+50   |       |              |   |                  | 7.39               | 28.32     |
| 14+00   |       |              |   |                  | 6.99               | 28.72     |
| 14+50   |       |              |   |                  | 7.20               | 28.51     |
| 15+00   |       |              |   |                  | 7.15               | 28.56     |
| 15+50   |       |              |   |                  | 7.65               | 28.06     |
| 16+00   |       |              |   |                  | 8.16               | 27.25     |
| 16+50   |       |              |   |                  | 9.46               | 26.25     |
| 17+00   |       |              |   |                  | 8.68               | 27.03     |
| 17+50   |       |              |   |                  | 8.65               | 27.06     |
| T.P.    |       |              |   |                  | 8.45               | 27.29     |
|         |       |              |   | 22               |                    |           |
|         |       |              |   | 7.97             | 35.26              |           |
| 18+00   |       |              |   |                  | 8.41               | 26.81     |
















**VALUABLE**

SUBJECT

*Profile on water line*  
*cont'd*

Return To  
Public Works  
Office  
Camp Lejeune  
North Carolina

**FIELD PARTY**

In Charge \_\_\_\_\_  
Instrument \_\_\_\_\_  
Notes \_\_\_\_\_  
Tape Read \_\_\_\_\_  
Tape or Rod \_\_\_\_\_  
Tape or Rod \_\_\_\_\_  
Instrument No. \_\_\_\_\_  
Tape No. \_\_\_\_\_

**WEATHER**

Clear \_\_\_\_\_  
Cloudy \_\_\_\_\_  
Windy \_\_\_\_\_  
Rain \_\_\_\_\_  
Fair \_\_\_\_\_  
Snow \_\_\_\_\_  
Hot \_\_\_\_\_  
Moderate \_\_\_\_\_  
Cold \_\_\_\_\_  
Fog \_\_\_\_\_

FILE No. \_\_\_\_\_

Fldr. No. \_\_\_\_\_

Sheet *407*

Date *8-22-1950*

Figured By \_\_\_\_\_

Notes Checked By \_\_\_\_\_

Plotted By \_\_\_\_\_

Quad. No. \_\_\_\_\_

| Station        | Dist. | Angle       | + | H. I. Bearing                      | Ver: Ang. Diff.               | Elevation            |
|----------------|-------|-------------|---|------------------------------------|-------------------------------|----------------------|
|                |       |             |   | <i>35.22</i><br><del>35.26</del> ✓ |                               |                      |
| <i>18+50</i>   |       |             |   |                                    | <i>9.23</i>                   | <i>25.99</i>         |
| <i>19+00</i>   |       |             |   |                                    | <i>9.66</i>                   | <i>25.56</i>         |
| <i>19+50</i>   |       |             |   |                                    | <i>8.89</i>                   | <i>26.33</i>         |
| <i>20+00</i>   |       |             |   |                                    | <i>8.40</i>                   | <i>26.82</i>         |
| <i>20+50</i>   |       |             |   |                                    | <i>8.25</i>                   | <i>26.97</i>         |
| <i>21+00</i>   |       |             |   |                                    | <i>7.90</i>                   | <i>27.32</i>         |
| <i>21+50</i>   |       |             |   |                                    | <i>7.32</i>                   | <i>27.90</i>         |
| <i>22+00</i>   |       |             |   |                                    | <i>7.66</i>                   | <i>27.56</i>         |
| <i>22+50</i>   |       |             |   |                                    | <i>7.96</i>                   | <i>27.26</i>         |
| <i>23+00</i>   |       |             |   |                                    | <i>6.84</i>                   | <i>28.38</i>         |
| <i>23+50</i>   |       |             |   |                                    | <i>5.30</i>                   | <i>29.92</i>         |
| <i>T.P.</i>    |       |             |   |                                    | <i>29.98</i><br>✓ <i>5.23</i> | <i>30.03</i>         |
|                |       | <i>7.79</i> |   | <i>37.82</i>                       |                               |                      |
| <i>T.P.</i>    |       |             |   |                                    | <i>2.52</i>                   | <i>35.30</i>         |
|                |       | <i>3.99</i> |   | <i>39.29</i>                       |                               |                      |
| <i>B.M. #5</i> |       |             |   |                                    | <i>3.66</i>                   | <i>35.63 (35.55)</i> |

*6.050*  
*.013*  
*.026*  
*.039*  
*.052*  
*.065*  
*.078*














VALUABLE

SUBJECT

Profile on water

Line - Midway Park contd.

Return To  
Public Works  
Office  
Camp Lejeune  
North Carolina

## FIELD PARTY

\_\_\_\_\_ In Charge  
 \_\_\_\_\_ Instrument  
 \_\_\_\_\_ Notes  
 \_\_\_\_\_ Tape Read  
 \_\_\_\_\_ Tape or Rod  
 \_\_\_\_\_ Tape or Rod  
 \_\_\_\_\_ Instrument No.  
 \_\_\_\_\_ Tape No.

## WEATHER

Clear \_\_\_\_\_  
 Cloudy \_\_\_\_\_  
 Windy \_\_\_\_\_  
 Rain \_\_\_\_\_  
 Fair \_\_\_\_\_

Snow \_\_\_\_\_  
 Hot \_\_\_\_\_  
 Moderate \_\_\_\_\_  
 Cold \_\_\_\_\_  
 Fog \_\_\_\_\_

FILE No. \_\_\_\_\_

Fldr. No. \_\_\_\_\_

Figured By \_\_\_\_\_ Sheet \_\_\_\_\_

Notes Checked By \_\_\_\_\_

Plotted By \_\_\_\_\_ Date 8-28-1950

Quad. No. \_\_\_\_\_

| Station | Dist. | Angle<br>" " | + | H. I.<br>Bearing      | Ver: Ang.<br>Diff. | Elevation |
|---------|-------|--------------|---|-----------------------|--------------------|-----------|
| R.M.    |       |              |   | 3.75 39.30            |                    | 33.55     |
|         |       |              |   | <del>3.79 39.34</del> |                    |           |
| 24+00   |       |              |   |                       | 9.39               | 29.91     |
| 24+50   |       |              |   |                       | 10.13              | 29.17     |
| 25+00   |       |              |   |                       | 9.86               | 29.44     |
| 25+50   |       |              |   |                       | 9.47               | 29.83     |
| 26+00   |       |              |   |                       | 9.46               | 30.14     |
| 26+50   |       |              |   |                       | 8.91               | 30.39     |
| 27+00   |       |              |   |                       | 8.73               | 30.57     |
| 27+50   |       |              |   |                       | 9.58               | 29.74     |
| 28+00   |       |              |   |                       | 9.47               | 30.03     |
| 28+50   |       |              |   |                       | 9.03               | 30.27     |
| 29+00   |       |              |   |                       | 8.53               | 30.77     |
| 29+50   |       |              |   |                       | 8.84               | 30.48     |
| 30+00   |       |              |   |                       | 7.84               | 31.46     |
| 30+50   |       |              |   |                       | 7.67               | 31.63     |
| 31+00   |       |              |   |                       | 7.99               | 31.31     |

Nail in power pole north side of Rt. 116. v. 4














**VALUABLE**

SUBJECT Water Line Profile contd.

Return To  
Public Works  
Office  
Camp Lejeune  
North Carolina

**FIELD PARTY**

In Charge \_\_\_\_\_  
Instrument \_\_\_\_\_  
Notes \_\_\_\_\_  
Tape Read \_\_\_\_\_  
Tape or Rod \_\_\_\_\_  
Tape or Rod \_\_\_\_\_  
Instrument No. \_\_\_\_\_  
Tape No. \_\_\_\_\_

**WEATHER**

Clear \_\_\_\_\_  
Cloudy \_\_\_\_\_  
Windy \_\_\_\_\_  
Rain \_\_\_\_\_  
Fair \_\_\_\_\_  
Snow \_\_\_\_\_  
Hot \_\_\_\_\_  
Moderate \_\_\_\_\_  
Cold \_\_\_\_\_  
Fog \_\_\_\_\_

FILE No. \_\_\_\_\_

Fldr. No. \_\_\_\_\_

Sheet \_\_\_\_\_

Figured By \_\_\_\_\_

Notes Checked By \_\_\_\_\_

Plotted By \_\_\_\_\_

Date 8-28-1950

Quad. No. \_\_\_\_\_

| Station      | Dist. | Angle " | + | H. I. Bearing             | Ver: Ang. Diff.         | Elevation                 |
|--------------|-------|---------|---|---------------------------|-------------------------|---------------------------|
| 31+50        |       |         |   | <del>29.34</del><br>39.30 | 7.82                    | 31.48                     |
| 32+00        |       |         |   |                           | 8.22                    | 31.08                     |
| 32+50        |       |         |   |                           | 8.82                    | 30.48                     |
| 33+00        |       |         |   |                           | 9.52                    | 29.78                     |
| 33+50        |       |         |   |                           | 9.20                    | 30.10                     |
| 33+62        |       |         |   |                           |                         |                           |
| 33+80        |       |         |   |                           | 8.95                    | 30.35                     |
| 34+00        |       |         |   |                           | 7.60                    | 31.70                     |
| 34+50        |       |         |   |                           | 6.52                    | 31.78                     |
| 34+86 = 0+00 |       |         |   |                           | <del>6.54</del><br>6.30 | <del>32.76</del><br>31.82 |
| T.P.         |       |         |   |                           |                         |                           |
| 0+00         |       |         |   |                           |                         |                           |
| 0+50         |       |         |   |                           | 6.84                    | 31.80                     |
| 1+00         |       |         |   |                           | 7.30                    | 31.84                     |
| 1+50         |       |         |   |                           | 7.31                    | 31.83                     |

Edge of Highway 24

10" x 10" fee

34+86  
33+85  
1.01

Line going west from 10" x 10" x 10" fee











**VALUABLE**

SUBJECT Water line profile  
cont'd.

Return To  
 Public Works  
 Office  
 Camp Lejeune  
 North Carolina

**FIELD PARTY**

\_\_\_\_\_ In Charge  
 \_\_\_\_\_ Instrument  
 \_\_\_\_\_ Notes  
 \_\_\_\_\_ Tape Read  
 \_\_\_\_\_ Tape or Rod  
 \_\_\_\_\_ Instrument No.  
 \_\_\_\_\_ Tape No.

**WEATHER**

Clear  
 Cloudy  
 Windy  
 Rain  
 Fair

Snow  
 Hot  
 Moderate  
 Cold  
 Fog

FILE No. \_\_\_\_\_  
 Fldr. No. \_\_\_\_\_  
 Sheet \_\_\_\_\_  
 Date 8-28- 19 50

Figured By \_\_\_\_\_  
 Notes Checked By \_\_\_\_\_  
 Plotted By \_\_\_\_\_  
 Quad. No. \_\_\_\_\_

| Station | Dist: | ° Angle " | + | H. I. Bearing             | Ver: Ang. Diff. | Elevation |
|---------|-------|-----------|---|---------------------------|-----------------|-----------|
| 2+00    |       |           |   | <del>39.74</del><br>39.74 | 7.69            | 31.45     |
| 2+50    |       |           |   |                           | 8.08            | 31.06     |
| 3+00    |       |           |   |                           | 8.15            | 30.99     |
| 3+50    |       |           |   |                           | 8.05            | 31.09     |
| 4+00    |       |           |   |                           | 8.09            | 31.05     |
| 4+50    |       |           |   |                           | 8.35            | 30.79     |
| 5+00    |       |           |   |                           | 7.90            | 31.24     |
| 5+50    |       |           |   |                           | 7.74            | 31.40     |
| 6+00    |       |           |   |                           | 8.07            | 31.07     |
| 6+50    |       |           |   |                           | 9.00            | 30.14     |
| 7+00    |       |           |   |                           | 9.30            | 29.84     |
| 7+50    |       |           |   |                           | 8.96            | 30.18     |
| 8+00    |       |           |   |                           | 9.83            | 30.31     |
| 8+50    |       |           |   |                           | 8.65            | 30.49     |
| 9+00    |       |           |   |                           | 9.05            | 30.09     |













**VALUABLE**

SUBJECT water line profile cont'd

Return To  
Public Works  
Office  
Camp Lejeune  
North Carolina

**FIELD PARTY**

\_\_\_\_ In Charge  
\_\_\_\_ Instrument  
\_\_\_\_ Notes  
\_\_\_\_ Tape Read  
\_\_\_\_ Tape or Rod  
\_\_\_\_ Tape or Rod  
\_\_\_\_ Instrument No.  
\_\_\_\_ Tape No.

**WEATHER**

Clear \_\_\_\_\_  
Cloudy \_\_\_\_\_  
Windy \_\_\_\_\_  
Rain \_\_\_\_\_  
Fair \_\_\_\_\_  
Snow \_\_\_\_\_  
Hot \_\_\_\_\_  
Moderate \_\_\_\_\_  
Cold \_\_\_\_\_  
Fog \_\_\_\_\_

FILE No. \_\_\_\_\_

Fldr. No. \_\_\_\_\_

Figured By \_\_\_\_\_ Sheet \_\_\_\_\_

Notes Checked By \_\_\_\_\_

Plotted By \_\_\_\_\_ Date 8-28-19 50

Quad. No. \_\_\_\_\_

| Station | Dist. | ° Angle " | + | H. I. Bearing             | Ver: Ang. Diff.         | Elevation |
|---------|-------|-----------|---|---------------------------|-------------------------|-----------|
| 9+50    |       |           |   | <del>39.84</del><br>39.14 | 9.35                    | 29.79     |
| 10+00   |       |           |   |                           | 9.80                    | 29.34     |
| 10+50   |       |           |   |                           | 9.80                    | 29.34     |
| 11+00   |       |           |   |                           | 10.24                   | 28.94     |
| B.M.    |       |           |   |                           | <del>3.54</del><br>3.60 | 35.54     |
|         |       |           |   |                           | (35.54)                 |           |



















**VALUABLE**

SUBJECT water line profile  
Midway park

Return To  
 Public Works  
 Office  
 Camp Lejeune  
 North Carolina

FIELD PARTY  
Kellom In Charge  
 \_\_\_\_\_ Instrument  
 \_\_\_\_\_ Notes  
 \_\_\_\_\_ Tape Read  
 \_\_\_\_\_ Tape or Rod  
 \_\_\_\_\_ Instrument No.  
 \_\_\_\_\_ Tape No.

WEATHER  
 Clear \_\_\_\_\_  
 Cloudy \_\_\_\_\_  
 Windy \_\_\_\_\_  
 Rain \_\_\_\_\_  
 Fair \_\_\_\_\_  
 Snow \_\_\_\_\_  
 Hot \_\_\_\_\_  
 Moderate \_\_\_\_\_  
 Cold \_\_\_\_\_  
 Fog \_\_\_\_\_  
 Figured By \_\_\_\_\_  
 Notes Checked By \_\_\_\_\_  
 Plotted By \_\_\_\_\_

FILE No. \_\_\_\_\_  
 Fldr. No. \_\_\_\_\_  
 Sheet \_\_\_\_\_  
 Date 8-30-1950

Quad. No. \_\_\_\_\_

| Station | Dist. | Angle " | +    | H. I. Bearing | Ver: Ang. Diff. | Elevation |   |
|---------|-------|---------|------|---------------|-----------------|-----------|---|
| B.M.    |       |         |      |               |                 | 33.84     | nail in pine tree near well house (west line) |
|         |       |         | 4.30 | 38.14         |                 |           |   |
| 11+50   |       |         |      |               | 11.27           | 27.87     |   |
| 12+00   |       |         |      |               | 11.50           | 26.64     |   |
| 12+50   |       |         |      |               | 9.78            | 28.36     |   |
| 13+00   |       |         |      |               | 8.23            | 29.91     |   |
| 13+50   |       |         |      |               | 7.70            | 30.44     |   |
| 14+00   |       |         |      |               | 8.00            | 30.14     |   |
| 14+50   |       |         |      |               | 8.86            | 29.28     |   |
|         |       |         |      |               | 9.04            | 29.10     | on existing line at well house                |
| 14+82   |       |         |      |               |                 |           | Edge of well house                            |
| B.M.    |       |         | 4.30 |               |                 | 33.84     |   |












**VALUABLE**

SUBJECT Water Line profile  
contd.  
"East line"

Return To  
 Public Works  
 Office  
 Camp Lejeune  
 North Carolina

**FIELD PARTY**

\_\_\_\_\_ In Charge  
 \_\_\_\_\_ Instrument  
 \_\_\_\_\_ Notes  
 \_\_\_\_\_ Tape Read  
 \_\_\_\_\_ Tape or Rod  
 \_\_\_\_\_ Tape or Rod  
 \_\_\_\_\_ Instrument No.  
 \_\_\_\_\_ Tape No.

**WEATHER**

Clear \_\_\_\_\_  
 Cloudy \_\_\_\_\_  
 Windy \_\_\_\_\_  
 Rain \_\_\_\_\_  
 Fair \_\_\_\_\_

Snow \_\_\_\_\_  
 Hot \_\_\_\_\_  
 Moderate \_\_\_\_\_  
 Cold \_\_\_\_\_  
 Fog \_\_\_\_\_

FILE No. \_\_\_\_\_  
 Fldr. No. \_\_\_\_\_  
 Sheet \_\_\_\_\_  
 Date 8-30 1950

Figured By \_\_\_\_\_  
 Notes Checked By \_\_\_\_\_  
 Plotted By \_\_\_\_\_  
 Quad. No. \_\_\_\_\_

| Station | Dist.           | Angle<br>" " | + | H. I.<br>Bearing | Ver: Ang.<br>Diff. | Elevation |  |
|---------|-----------------|--------------|---|------------------|--------------------|-----------|--|
| B.M.    |                 |              |   |                  |                    | 35.55     | nail in power pole near intersection of 8" + 10" lines |
| 0+00    | 10" X 10" X 10" | 8.28         |   | 43.93            |                    |           | tee going into 8" line                                 |
| 0+50    |                 |              |   |                  | 11.70              | 34.13     |  |
| 1+00    |                 |              |   |                  | 12.40              | 31.43     |  |
| 1+50    |                 |              |   |                  | 12.03              | 31.80     |  |
| 2+00    |                 |              |   |                  | 10.95              | 34.88     |  |
| 2+50    |                 |              |   |                  | 9.66               | 34.17     |  |
| 3+00    |                 |              |   |                  | 9.47               | 34.56     |  |
| 3+50    |                 |              |   |                  | 7.41               | 36.42     |  |
| 4+00    |                 |              |   |                  | 7.00               | 36.83     |  |
| 4+50    |                 |              |   |                  | 6.22               | 37.60     |  |
| 5+00    |                 |              |   |                  | 5.78               | 38.05     |  |
| 5+50    |                 |              |   |                  | 5.73               | 38.10     |  |
| 6+00    |                 |              |   |                  | 5.72               | 38.11     |  |
| T.P.    |                 |              |   |                  | 5.59               | 38.44     |  |
|         |                 |              |   |                  | 7.06               | 45.30     |  |

VILLAGE

SUBJECT

Return To  
Public Works  
Office  
Commissioner  
New York

Station Date Area Vol. Base Mt. Elevation  
Out. 000

FIELD PART

In Class  
Instrument  
Notes  
Type of Rod  
Remarks  
Tape No.

WEATHER

Clear  
Cloud  
Wind  
Temp  
Precip  
Humid  
Bar

FILE NO.

DATE

TIME

BY

NO.

0000

**VALUABLE**

SUBJECT water line profile  
cont'd.

Return To  
 Public Works  
 Office  
 Camp Lejeune  
 North Carolina

**FIELD PARTY**

\_\_\_\_\_ In Charge  
 \_\_\_\_\_ Instrument  
 \_\_\_\_\_ Notes  
 \_\_\_\_\_ Tape Read  
 \_\_\_\_\_ Tape or Rod  
 \_\_\_\_\_ Instrument No.  
 \_\_\_\_\_ Tape No.

**WEATHER**

Clear \_\_\_\_\_  
 Cloudy \_\_\_\_\_  
 Windy \_\_\_\_\_  
 Rain \_\_\_\_\_  
 Fair \_\_\_\_\_  
 Snow \_\_\_\_\_  
 Hot \_\_\_\_\_  
 Moderate \_\_\_\_\_  
 Cold \_\_\_\_\_  
 Fog \_\_\_\_\_  
 Figured By \_\_\_\_\_  
 Notes Checked By \_\_\_\_\_  
 Plotted By \_\_\_\_\_

FILE No. \_\_\_\_\_  
 Fldr. No. \_\_\_\_\_  
 Sheet \_\_\_\_\_  
 Date 8-30 1950

Quad. No. \_\_\_\_\_

| Station | Dist. | Angle | + | H. I. Bearing | Ver: Ang. Diff. | Elevation |   |
|---------|-------|-------|---|---------------|-----------------|-----------|---|
|         |       |       |   | 15.30         |                 |           |   |
| 6+50    |       |       |   |               | 7.21            | 38.09     |   |
| 7+00    |       |       |   |               | 7.54            | 37.76     |   |
| 7+50    |       |       |   |               | 8.24            | 37.06     |   |
| 8+00    |       |       |   |               | 9.53            | 35.77     |   |
| 8+48    |       |       |   |               |                 |           | Edge of street                          |
| 8+50    |       |       |   |               | 10.55           | 34.75     |   |
| 8+70    |       |       |   |               |                 |           | Edge of St.                             |
| 9+00    |       |       |   |               | 7.66            | 37.64     | Existing line                           |
| 9+15    |       |       |   |               |                 |           | Edge of well house                      |
| B.M.    |       |       |   |               | 3.92            | 41.37     | mark in power pole near East well house |
|         |       |       |   |               | <u>41.35</u>    |           |   |

VALUABLE

Return To  
Public Works  
Office  
Camp Lejeune  
North Carolina

SUBJECT

Station

Disc

Angle

Bearing

Vertical Elevation  
Dist

FIELD PARTY

In Charge  
Instrument  
Notes  
\* Tape Lead  
Tape on Rod  
Tape on Rod  
Station No.  
Tape No.

WEATHER

Clear  
Cloudy  
Mist  
Moderate  
Rain  
Cold  
Fog  
Foggy  
Notes  
Checked By  
Plotted By  
Grid No.

FIELD NO.

Plot No.

Sheet

Date



120-H

PUBLIC WORKS DEPARTMENT  
Building No. 1005  
Marine Corps Base, Camp Lejeune, North Carolina

TD:isb  
25 September 1957

Mr. George V. MacKain  
Navigation Systems Department  
Air Armament Division  
Sperry Gyroscope Company  
Mail Station E-5  
Great Neck, N. Y.

Dear Sir:

Geographic positions requested for observation sites at Camp Lejeune, North Carolina, follow:

1. U. S. N. Marker No. 40 at Onslow Beach  
Lat.  $34^{\circ}33'53.567''$  Long.  $77^{\circ}16'42.166''$   
Bearing to Water Tank on Onslow Beach  $N45^{\circ}39'43''$  E True
2. Brad Marker in center line of Mock-up Road near Water Treatment Plant.  
Lat.  $34^{\circ}34'28.756''$  Long.  $77^{\circ}16'50.817''$   
Bearing on Road toward Water-way  $S26^{\circ}14'18''$  E True
3. Brad Marker at center line intersection of Sneads Ferry and Onslow Beach Roads.  
Lat.  $34^{\circ}35'27.757''$  Long.  $77^{\circ}17'01.632''$   
Bearing on Sneads Ferry Road  $S31^{\circ}07'46''$  W
4. Forest Fire Observation Tower on Sneads Ferry Road.  
Lat.  $34^{\circ}36'38.764''$  Long.  $77^{\circ}17'23.470''$   
Bearing on Sneads Ferry Road  $N16^{\circ}58'51''$  W
5. U.S.M.C. Marker No. 122 on Sneads Ferry Road.  
Lat.  $34^{\circ}37'24.628''$  Long.  $77^{\circ}17'42.703''$   
Bearing on Sneads Ferry Road  $N16^{\circ}59'02''$  W
6. U.S.M.C. Marker No. 105 near intersection of Sneads Ferry and Marines Roads.  
Lat.  $34^{\circ}37'49.248''$  Long.  $77^{\circ}17'51.891''$   
Bearing on Sneads Ferry Road  $S16^{\circ}59'07''$  E
7. Brad Marker at center line intersection of Sneads Ferry and Main Service Roads.  
Lat.  $34^{\circ}39'04.997''$  Long.  $77^{\circ}18'40.047''$   
Bearing on Sneads Ferry Road  $N28^{\circ}46'06''$  W

PUBLIC WORKS DEPARTMENT  
 Building No. 1005  
 Marine Corps Base, Camp Lejeune, North Carolina

ED:fab  
 25 September 1957

Mr. George V. Mackain  
 Navigation Systems Department  
 Air Armament Division  




TD:isb  
25 September 1957

8. Brad Marker at center line intersection of Sneads Ferry and Michael Roads.  
Lat.  $34^{\circ}40'24.716''$  Long.  $77^{\circ}19'32.997''$   
Bearing on Sneads Ferry Road  $N28^{\circ}45'07''$  W
9. U.S.M.C. Marker No. 127 in center line of Holcomb Boulevard.  
Lat.  $34^{\circ}41'28.353''$  Long.  $77^{\circ}19'53.187''$   
Bearing on Holcomb Boulevard  $S3^{\circ}41'28''$  E
10. U.S.M.C. Marker No. 93 at intersection of Holcomb and Brewster Boulevards.  
Lat.  $34^{\circ}43'03.824''$  Long.  $77^{\circ}20'33.985''$   
Bearing on Holcomb Boulevard  $S20^{\circ}44'13''$  E

Yours very truly,

Thomas J. Dillon  
Cartographer  
Survey Section


- Your very truly,

Thomas A. Dillon  
Cartographer  
Survey Section

PUBLIC WORKS DEPARTMENT  
Building No. 1005  
Marine Corps Base, Camp Lejeune, North Carolina


TD:isb  
25 September 1957

Mr. George V. MacKain  
Navigation Systems Department  
Air Armament Division  
Sperry Gyroscope Company  
Mail Station E-5  
Great Neck, N. Y.

Dear Sir:

Geographic positions requested for observation sites at Camp Lejeune, North Carolina, follow:

1. U. S. N. Marker No. 40 at Onslow Beach  
Lat.  $34^{\circ}33'53.567''$  Long.  $77^{\circ}16'42.166''$   
Bearing to Water Tank on Onslow Beach  $N45^{\circ}39'43''$  E True
2. Brad Marker in center line of Mock-up Road near Water Treatment Plant.  
Lat.  $34^{\circ}34'28.756''$  Long.  $77^{\circ}16'50.817''$   
Bearing on Road toward Water-way  $S26^{\circ}14'18''$  E True
3. Brad Marker at center line intersection of Sneads Ferry and Onslow Beach Roads.  
Lat.  $34^{\circ}35'27.757''$  Long.  $77^{\circ}17'01.632''$   
Bearing on Sneads Ferry Road  $S31^{\circ}07'46''$  W
4. Forest Fire Observation Tower on Sneads Ferry Road.  
Lat.  $34^{\circ}36'38.764''$  Long.  $77^{\circ}17'23.470''$   
Bearing on Sneads Ferry Road  $N16^{\circ}58'51''$  W
5. U.S.M.C. Marker No. 122 on Sneads Ferry Road.  
Lat.  $34^{\circ}37'24.628''$  Long.  $77^{\circ}17'42.703''$   
Bearing on Sneads Ferry Road  $N16^{\circ}59'02''$  W
6. U.S.M.C. Marker No. 105 near intersection of Sneads Ferry and Marines Roads.  
Lat.  $34^{\circ}37'49.248''$  Long.  $77^{\circ}17'51.891''$   
Bearing on Sneads Ferry Road  $S16^{\circ}59'07''$  E
7. Brad Marker at center line intersection of Sneads Ferry and Main Service Roads.  
Lat.  $34^{\circ}39'04.997''$  Long.  $77^{\circ}18'40.047''$   
Bearing on Sneads Ferry Road  $N28^{\circ}46'06''$  W

 

TD:isb  
25 September 1957

8. Brad Marker at center line intersection of Sneads Ferry and Michael Roads.  
Lat.  $34^{\circ}40'24.716''$  Long.  $77^{\circ}19'32.997''$   
Bearing on Sneads Ferry Road  $N28^{\circ}45'07''$  W
9. U.S.M.C. Marker No. 127 in center line of Holcomb Boulevard.  
Lat.  $34^{\circ}41'28.353''$  Long.  $77^{\circ}19'53.187''$   
Bearing on Holcomb Boulevard  $S3^{\circ}41'28''$  E
10. U.S.M.C. Marker No. 93 at intersection of Holcomb and Brewster Boulevards.  
Lat.  $34^{\circ}43'03.824''$  Long.  $77^{\circ}20'33.985''$   
Bearing on Holcomb Boulevard  $S20^{\circ}44'13''$  E

Yours very truly,

Thomas J. Dillon  
Cartographer  
Survey Section















| Station   | N. C. State Grid |  | Lambert Plane Co-ordinates |                         | Latitude                   | Longitude  |
|---|------------------|--|----------------------------|-------------------------|----------------------------|--|
|   | Bearing          |  | North                      | East                    |                            |  |
| At Onslow Beach<br>U.S.N. #40 Concrete Marker   | 1                | To Water Tank, Onslow Beach<br>N 44° 40' 06" E<br>(N 45-39-43 E True)                    | 301,061.17                 | 2,518,298.99            | 34° 33' 53.567"            | (00° 59' 37.209")<br>77° 16' 42.166"                       |
| Center Line Road, Brad Marker   | 2                | On E Road toward Waterway<br>S 27° 13' 50" E<br>(S 26-14-18 E True)                      | 304,605.29                 | 2,517,514.10            | 34° 34' 28.756"            | (00° 59' 32.216")<br>77° 16' 50.817"                       |
| Brad Marker at Road Intersection<br>Sneads Ferry and Onslow Beach Rds.  | 3                | On E Road toward Southwest.<br>S 30° 08' 20" W<br>(S 31-07-46 W True)                    | 310,553.21                 | 2,516,506.79            | 34° 35' 27.757"            | (00° 59' 25.973")<br>77° 17' 01.632"                       |
| Center of Fire Observation Tower<br>Sneads Ferry Rd. at Engr. Stockade  | 4                | To Concrete Marker U.S.M.C. #122<br>N 20° 06' 28" W<br>(N 19-07-15 W True)               | 317,698.57                 | 2,514,557.64            | 34° 36' 38.764"            | (00° 59' 13.369")<br>77° 17' 23.470"                       |
| On Sneads Ferry Road<br>U.S.M.C. #122 Concrete Marker   | 5                | To Fire Obs. Tower, Engr. Stockade<br>S 20° 06' 28" E<br>(S 19-07-26 W True)             | 322,306.58                 | 2,512,870.62            | 34° 37' 24.628"            | (00° 59' 02.268")<br>77° 17' 42.703"                       |
| Near Intersection of Sneads Ferry<br>and Marines Road<br>U.S.M.C. #105 Concrete Marker                        | 6                | To Concrete Marker U.S.M.C. #122<br>S 18° 07' 51" E<br>(S 17-08-54 E True)               | 324,781.89                 | 2,512,060.11            | 34° 37' 49.248"            | (00° 58' 56.965")<br>77° 17' 51.891"                       |
| Center Line Intersection<br>Main Service and Snead Ferry Roads  | 7                | Toward Holcomb Blvd. on E Road.<br>N 29° 44' 35" W<br>(N 28° 46' 06" W True)             | 332,369.40                 | 2,507,906.49            | 34° 39' 04.997"            | (00° 58' 29.171")<br>77° 18' 40.047"                       |
| Center Line Intersection<br>Michael and Snead Ferry Roads   | 8                | Toward Onslow Beach on E Road.<br>S 29° 43' 06" E<br>(S 28° 45' 07" E True)              | 340,352.01                 | 2,503,347.62            | 34° 40' 24.716"            | (00° 57' 58.610")<br>77° 19' 32.997"                       |
| <del>In Median Strip, E Holcomb Blvd.<br/>Near Open Storage Area<br/>U.S.M.C. #126 Concrete Marker</del>      | <del></del>      | <del>To U.S.M.C. #127 Concrete Marker<br/>N 4° 39' 15" W</del>                           | <del>345,120.58</del>      | <del>2,501,686.51</del> | <del>34° 41' 03.824"</del> | <del>(00° 57' 23.410")</del>                               |
| <del>In Median Strip, E Holcomb Blvd.<br/>Near Rec. and Salvage Yard.<br/>U.S.M.C. #127 Concrete Marker</del> | <del>9</del>     | <del>To U.S.M.C. #126 Concrete Marker<br/>S 4° 39' 15" E<br/>(S 3° 41' 28" E True)</del> | <del>346,755.73</del>      | <del>2,501,553.39</del> | <del>34° 41' 28.353"</del> | <del>(00° 57' 46.957")</del><br><del>77° 19' 53.187"</del> |
| Near Intersection of E, Brewster<br>and Holcomb Boulevards.<br>U.S.M.C. #93 Concrete Marker                   | 10               | Toward Main Camp on E Holcomb<br>Boulevard.<br>S 21° 41' 36" E<br>(S 20° 44' 13" E True) | 356,365.59                 | 2,497,986.37            | 34° 43' 03.824"            | (00° 57' 23.410")<br>77° 20' 33.985"                       |

29-39-25  
4-36-47  

---

2502-48

~~11~~