






REVISIONS		
NO.	DESCRIPTION	DATE
1	ADD THE 1" BY 1/2" DIA.
2	ADD 1/2" DIA.

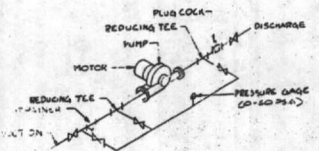


IN-LINE CIRCULATING PUMP DETAIL
SCALE: NONE
33
M7-47

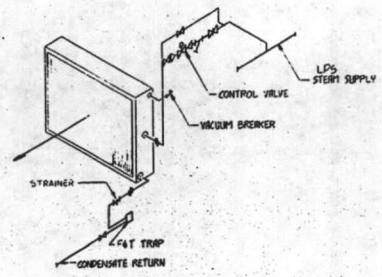


STEAM COIL PIPING DETAIL
SCALE: NONE
34
M7-47

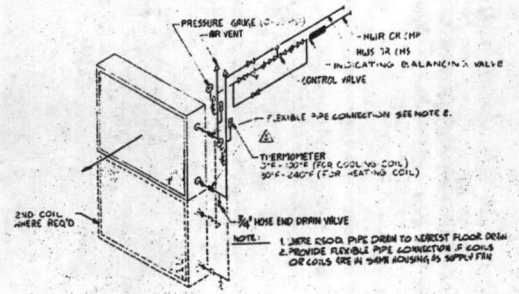


HEATING & COOLING COIL LATNER PIPING DETAIL
SCALE: NONE
35
M7-47

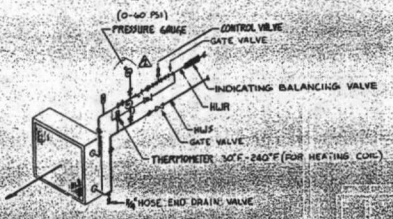


DUCT MOUNTED HOT LATNER COIL PIPING DETAIL
SCALE: NONE
36
M7-47

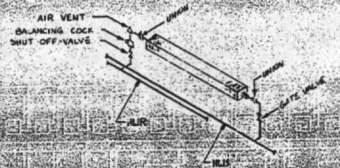


HOT LATNER BASEBOARD HEATER PIPING DETAIL
SCALE: NONE
37
M7-47

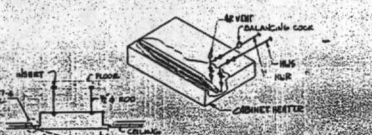


HOT LATNER CABINET HEATER PIPING DETAIL
SCALE: NONE
38
M7-47

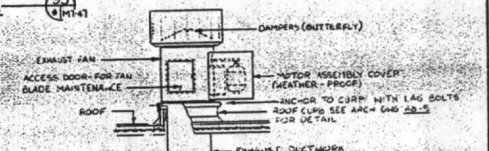


HIP-BLAST EXHAUST FAN DETAIL
SCALE: 1/8" = 1'-0"
39
M7-47

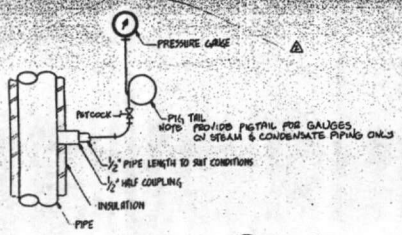


PRESSURE GAUGE INSTALLATION DETAIL
SCALE: NONE
41
M7-47

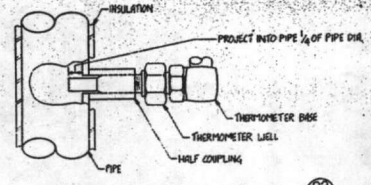


THERMOMETER INSTALLATION DETAIL
SCALE: NONE
42
M7-47

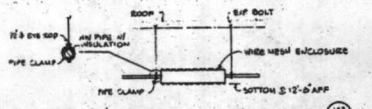


TYPE 'D' FINN-TUBE MOUNTING DETAIL
SCALE: NONE
43
M7-47

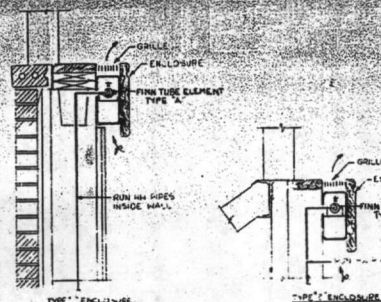

FINN-TUBE SILL DETAIL
SCALE: NONE
44
M7-47

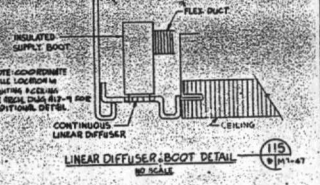

LINEAR DIFFUSER BOOT DETAIL
SCALE: NONE
45
M7-47

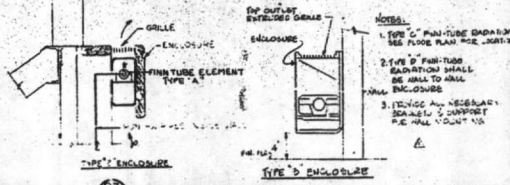

NOTES:

NOTES:
1. THESE DETAILS APPLY THROUGHOUT THE ENTIRE PROJECT.
2. SEE DRAWING M7-47 FOR GENERAL NOTES.

RECORD DRAWING		FEB 1 1953		M7-47	
LETTER DATED					
DEPARTMENT OF THE NAVY					
ATLANTIC DIVISION					
NAVAL HOSPITAL MEDICAL CENTER					
205-BED HOSPITAL					
DETAILS					

