




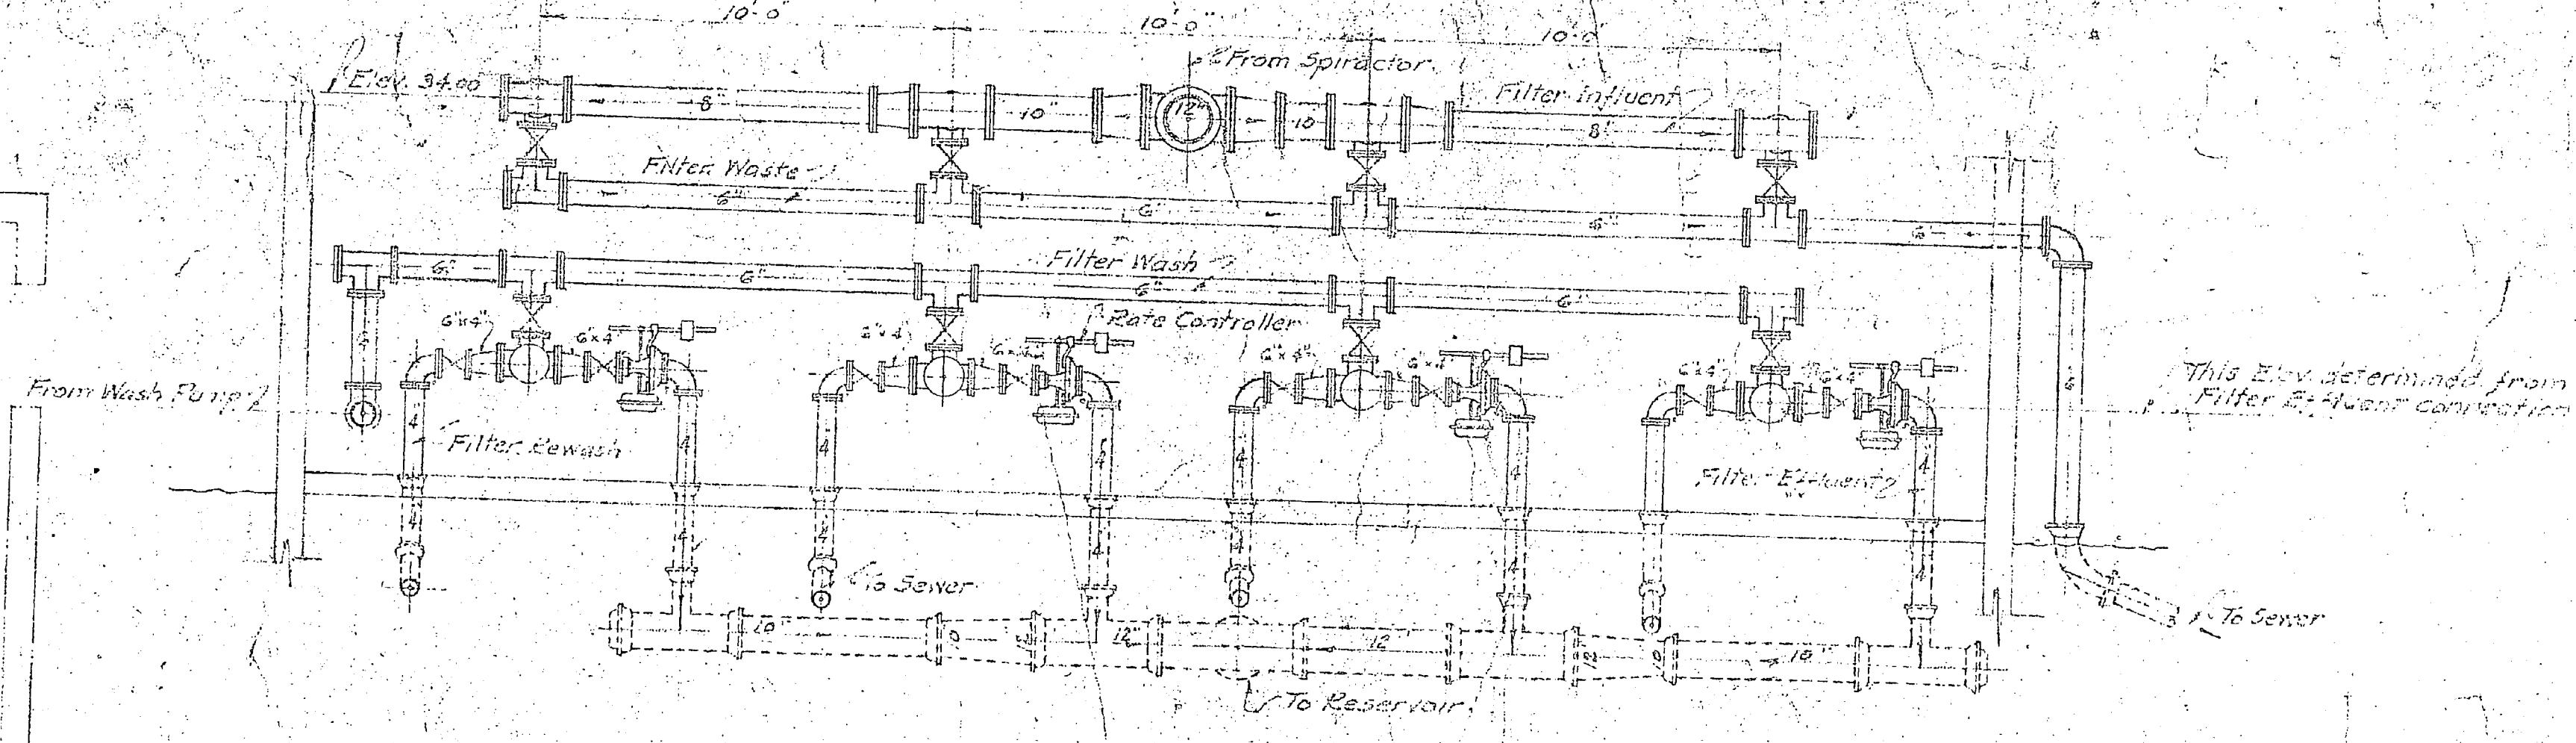

SECTION AT B-B
Scale: 1/4" = 1'-0"

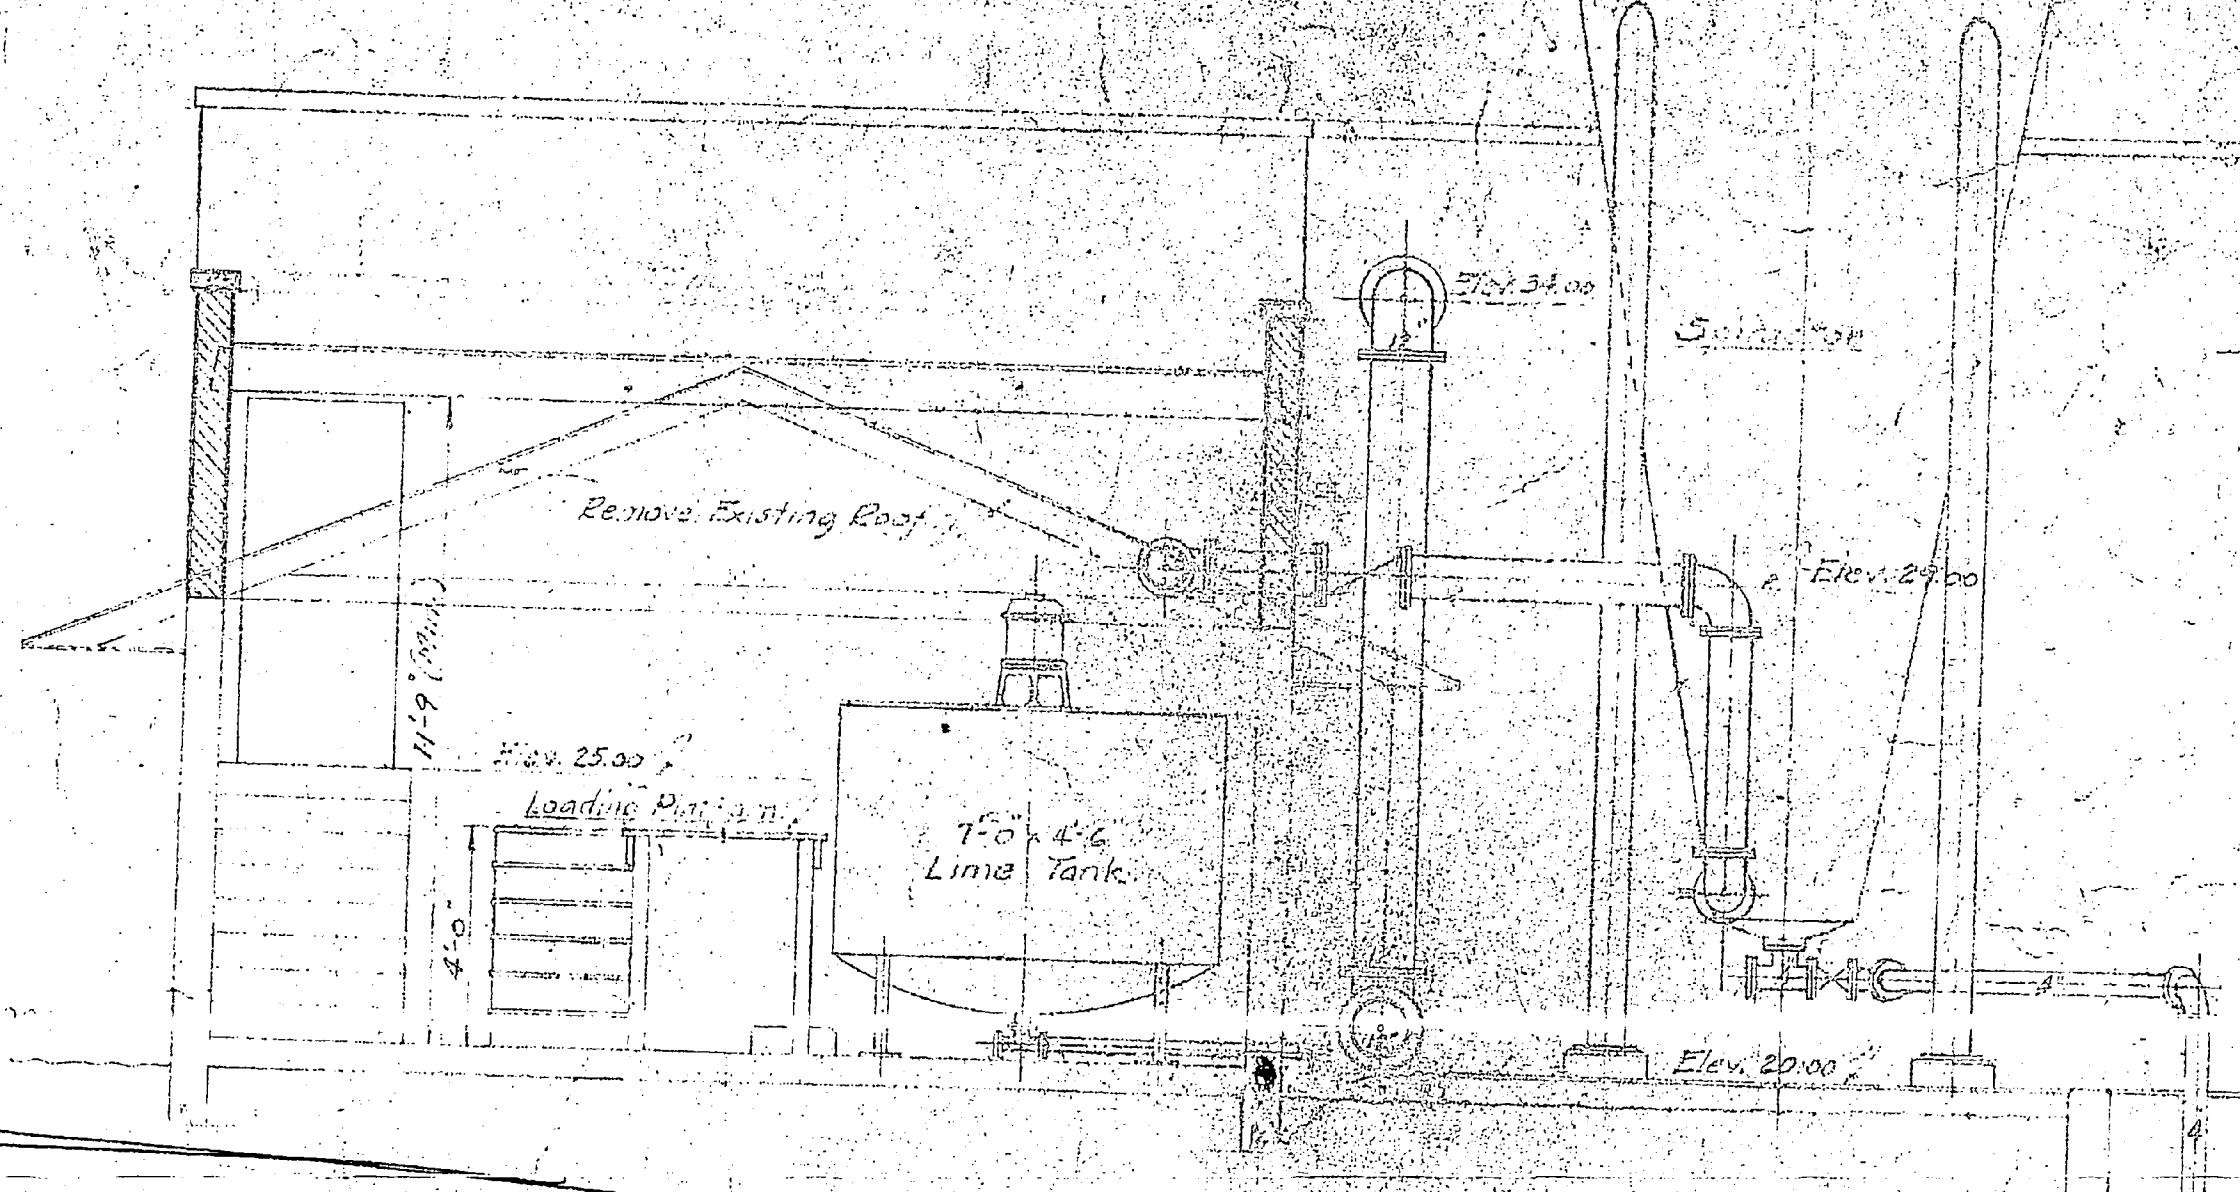


SECTION AT C-C
Scale: 1/4" = 1'-0"


TT-38
Demolished
8-1
8.7'-0" Roof

Lime Capped
Week 8-10.01 by Res. Contractor
M


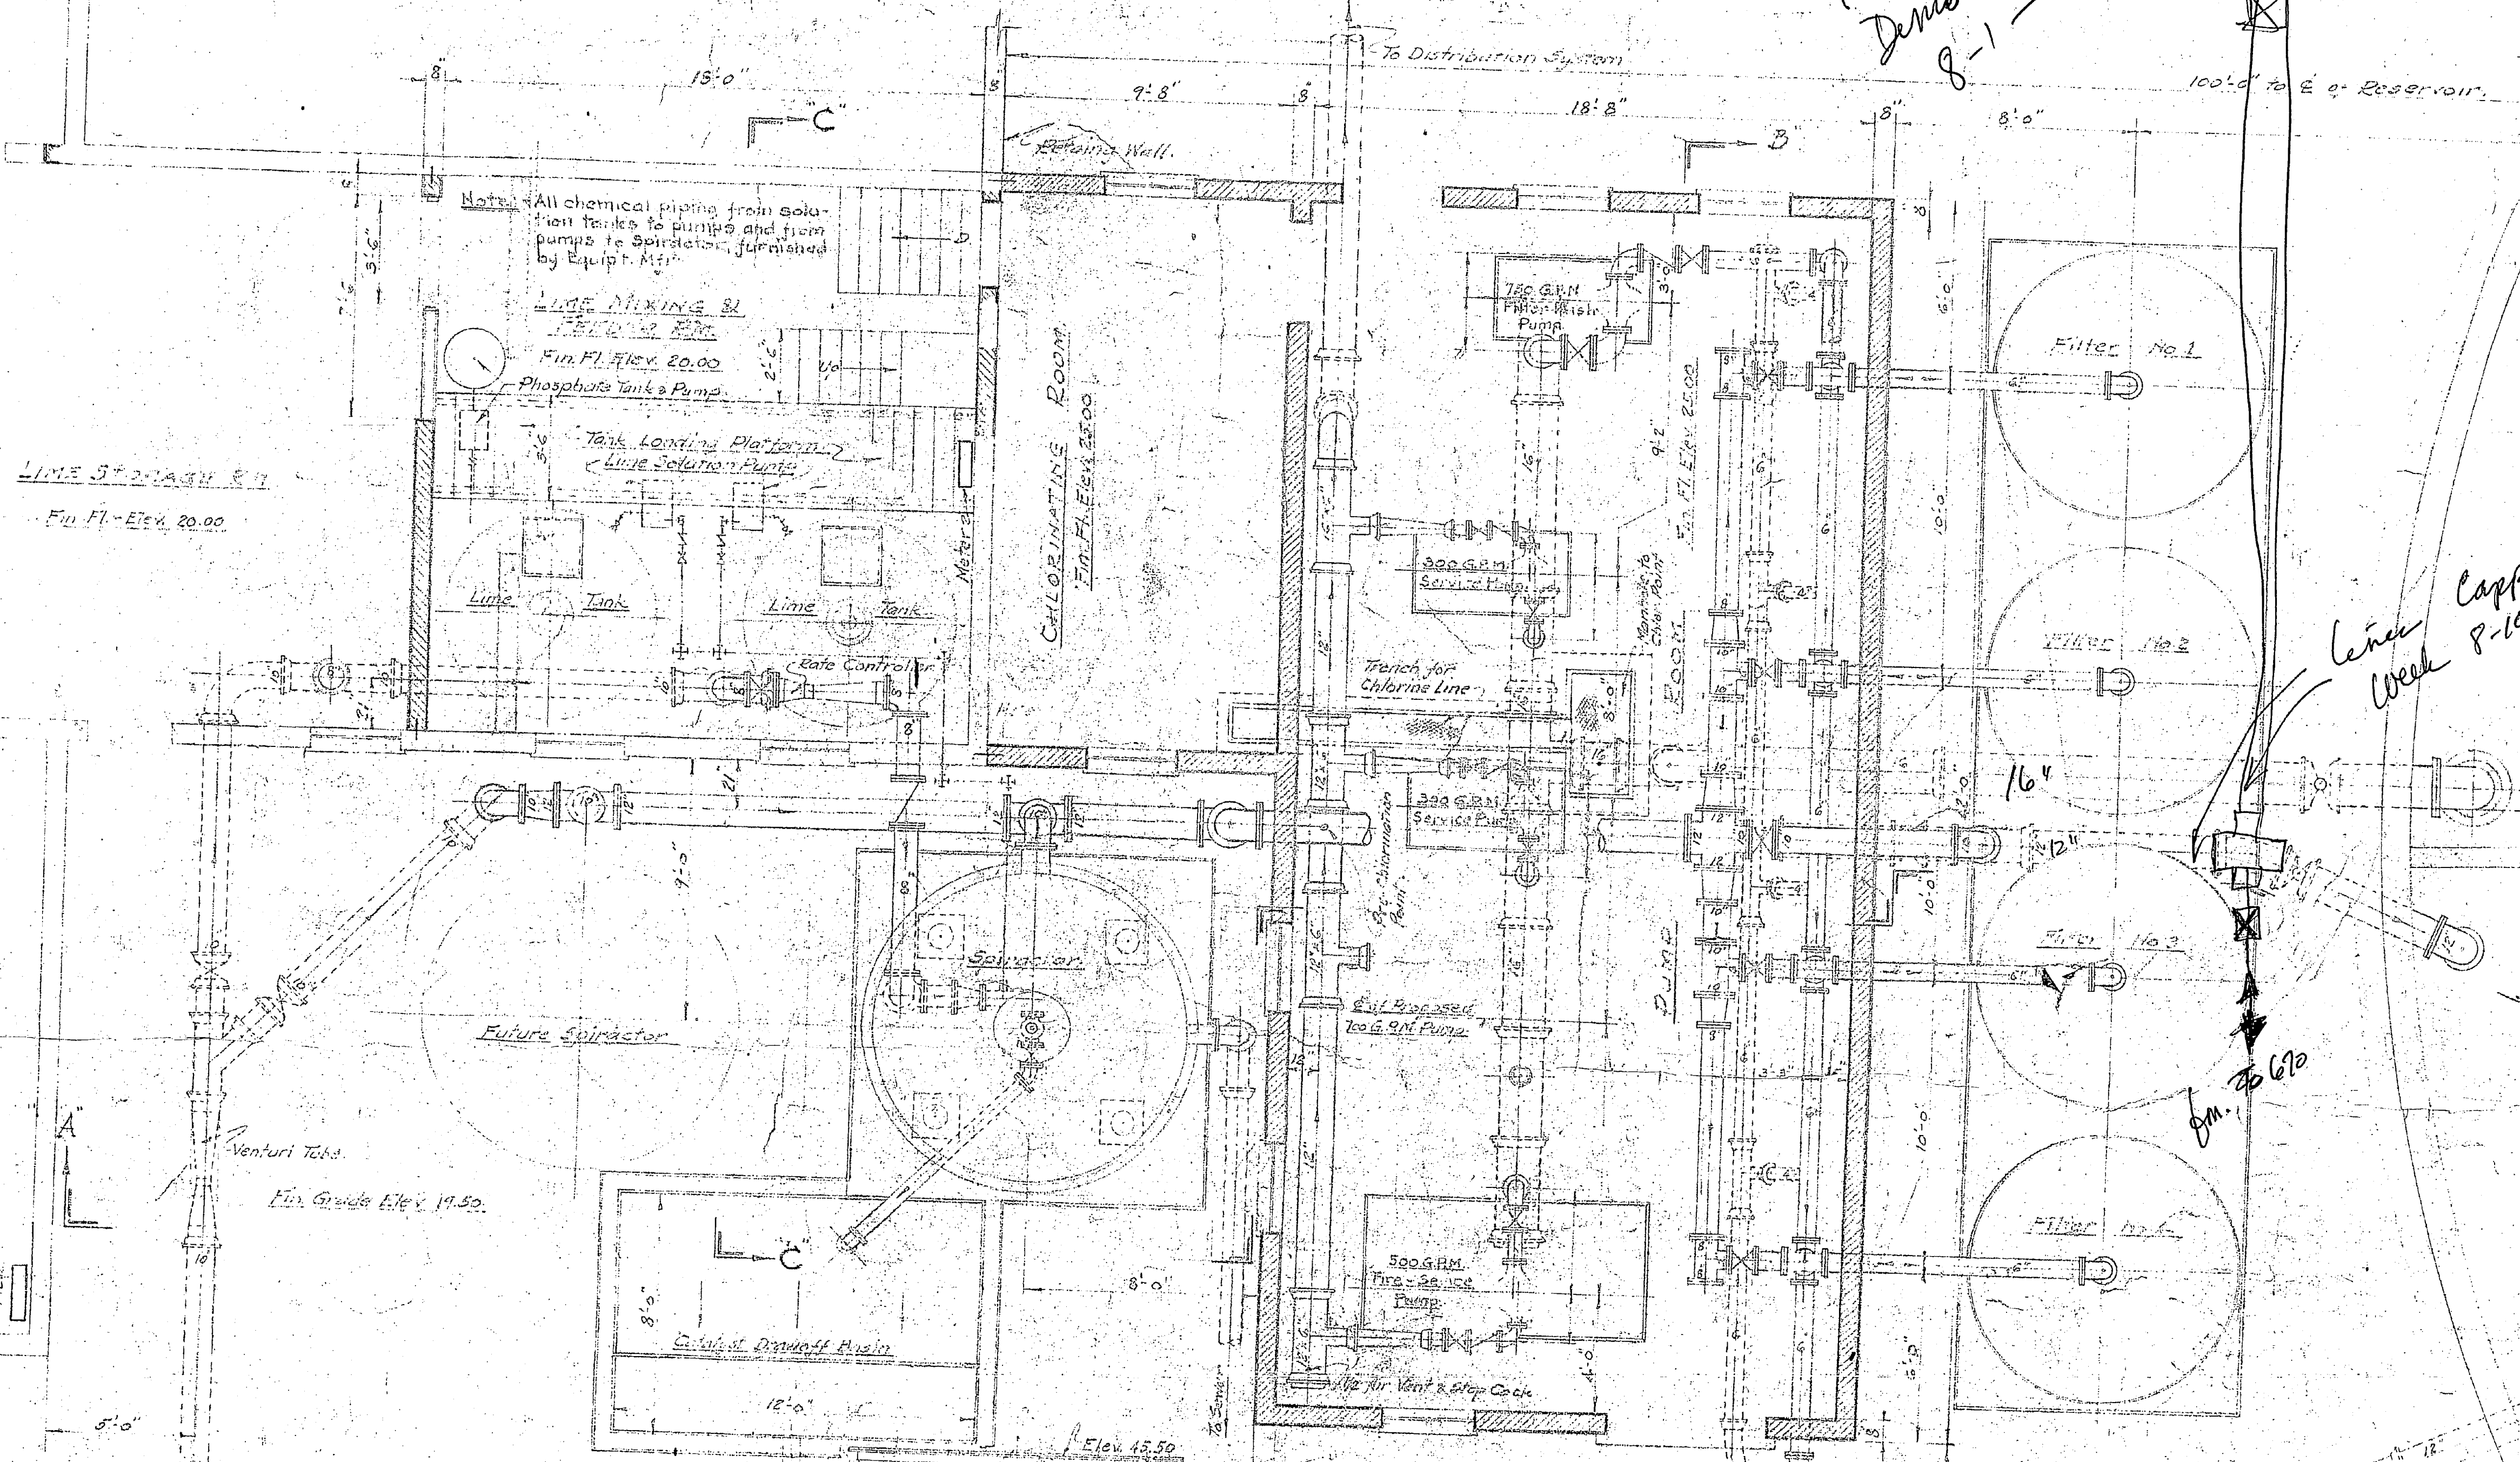

PLAN
SCALE: 1/4" = 1'-0"

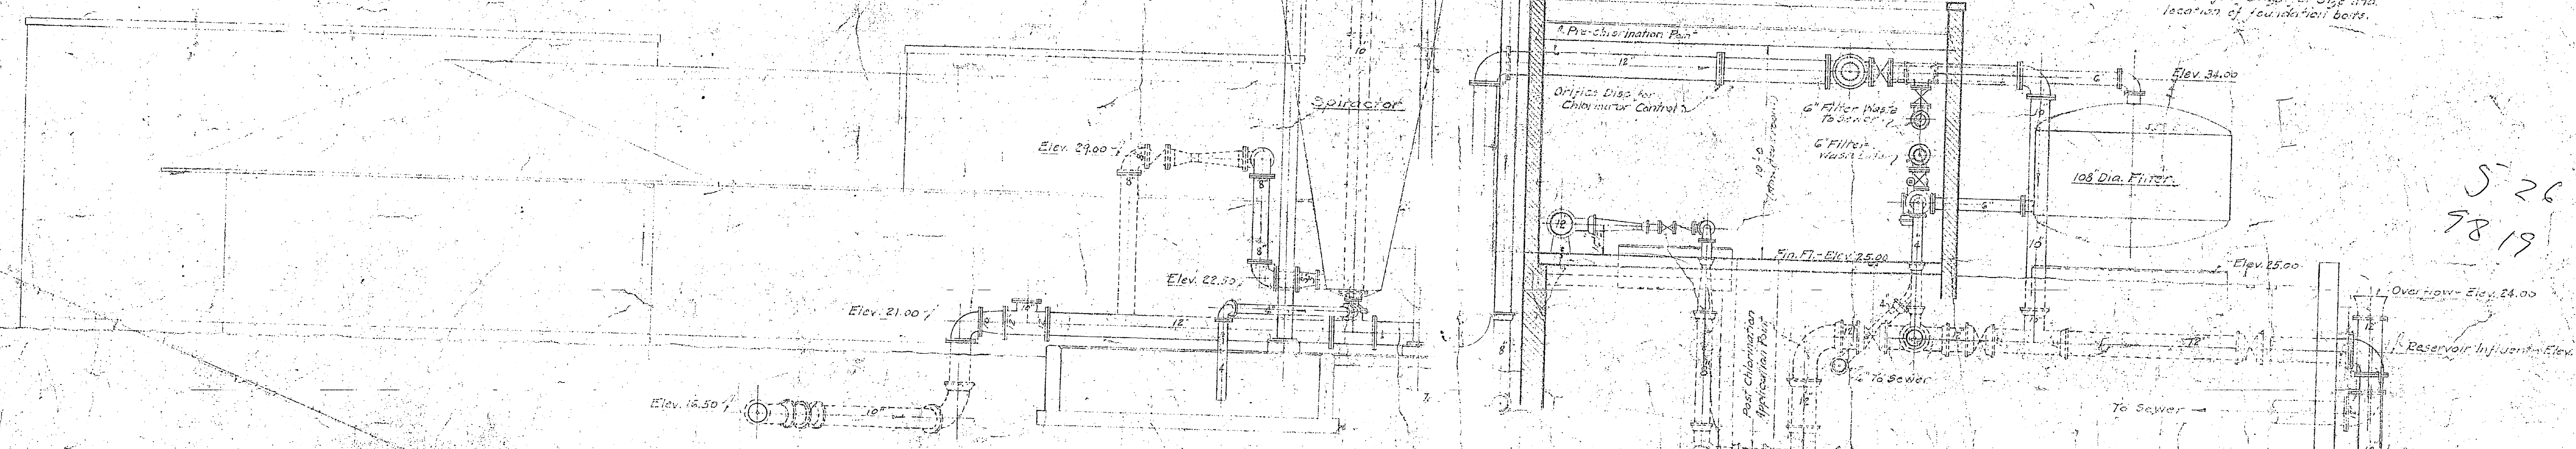

SECTION AT A-A
Scale: 1/4" = 1'-0"

526
7819

DPW 42680

WATER FACILITIES WATER TREATMENT	
NRS JOB NO. 51-10	PEARSON & WHITMAN CONSULTING ENGINEERS
NRS DWG NO. W-2	RALEIGH, N.C.

