


- LEGEND
- SAMPLING LINE
  - SANITARY SEWER
  - STORM DRAINAGE
  - NEW RAW WATER LINE
  - NEW TREATED WATER LINE
  - GATE VALVE
  - TEE
  - CROSS
  - 90° ELL
  - 45° ELL
  - CLEAN OUT
  - HOSE BIBB IN CAST IRON METER BOX
  - FIRE HYDRANT

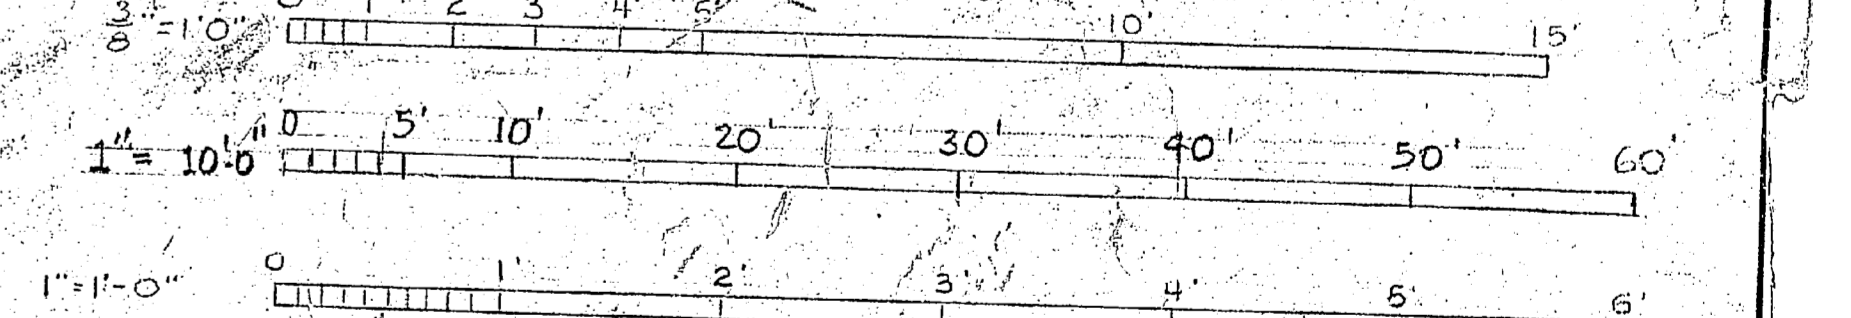

25' 11-15-58 14' 2-6-58 REVISION DATE APPD. DESCRIPTION BY 10506 LDES DRWN TR CHK SUPV IN CHARGE		ADD'D ONE 8\"/>
P.W. DRAWING NO. 10506 MARINE CORPS BASE CAMP LEJEUNE, N. C.		WATER TREATMENT FACILITIES MONTFORD POINT YARD PIPING
APPROVED THE QUARTERMASTER GENERAL OF THE MARINE CORPS DATE 21 Dec 53		APPROVED WORKS OFFICER SCALE GRAPHIC SPEC 47371 SHEET 15 OF 23 NOV. 91281 Y & D DRAWING NO. 646706

