




TANK S-PP-2323 PARADISE POINT
200,000 GAL.

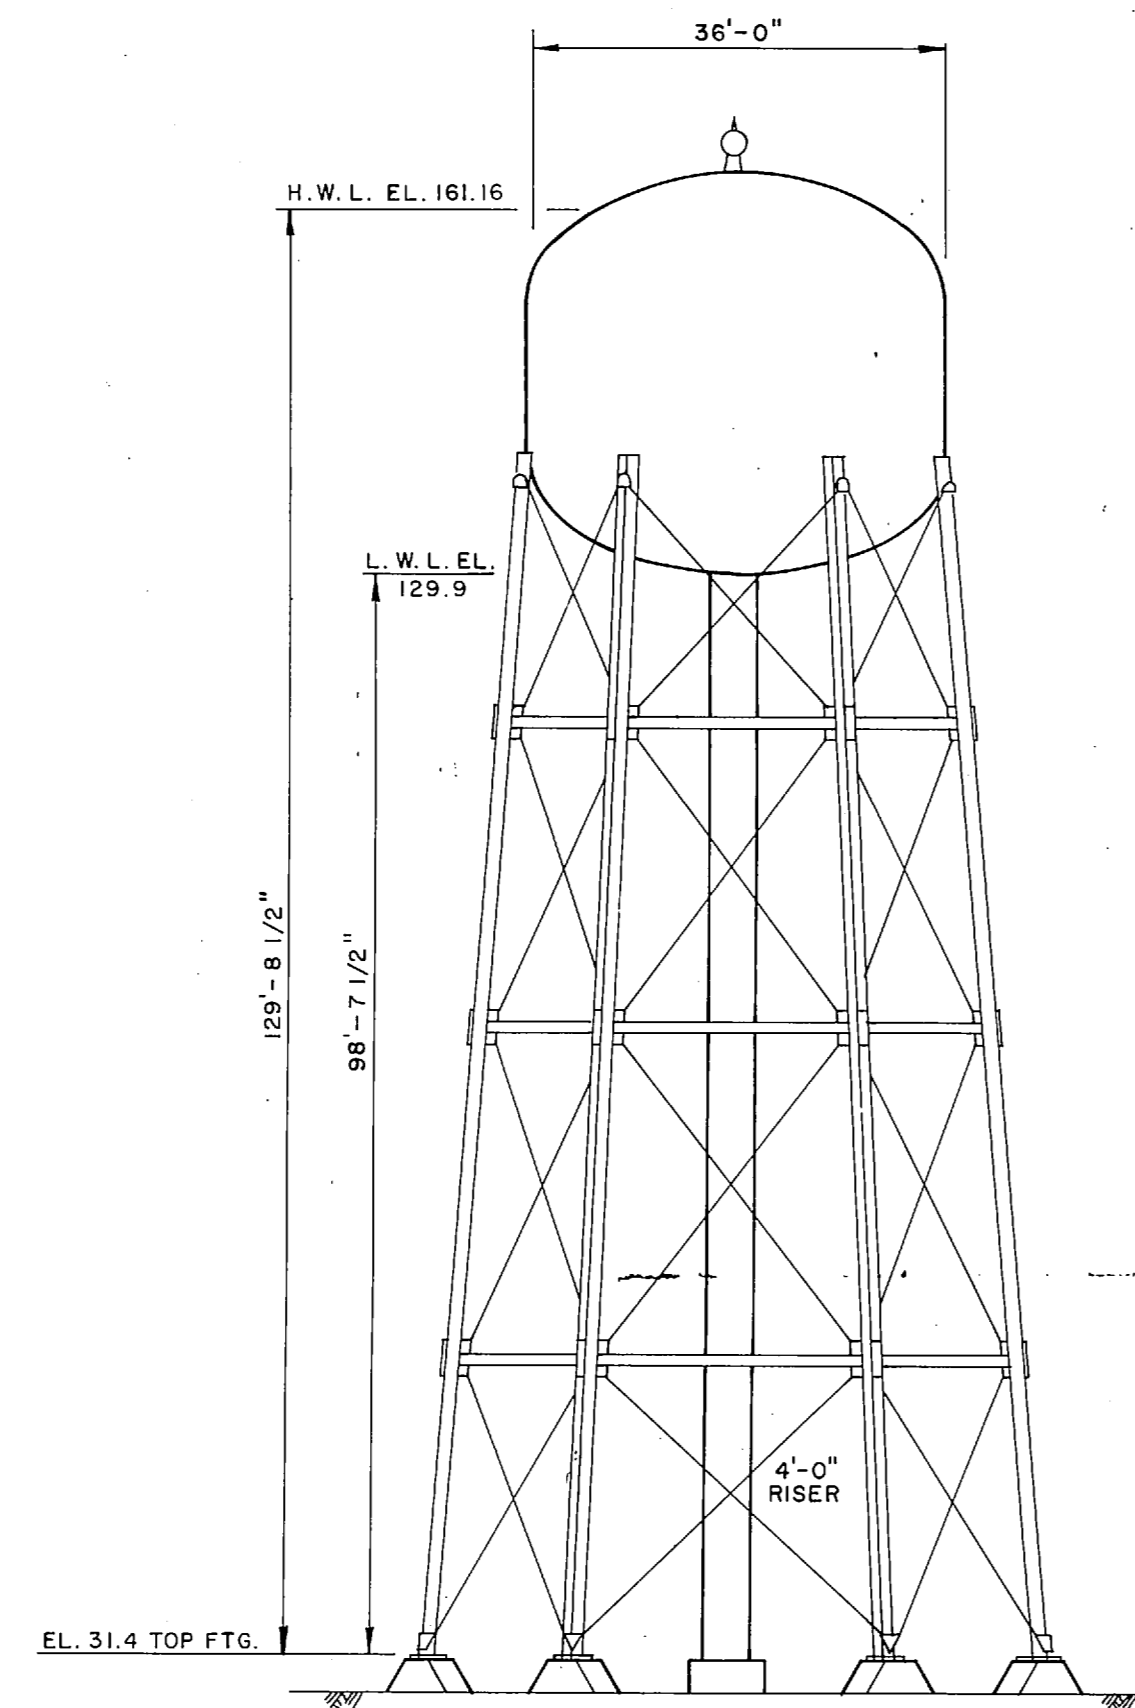


TANK LCH-4004 MIDWAY PARK
200,000 GAL.

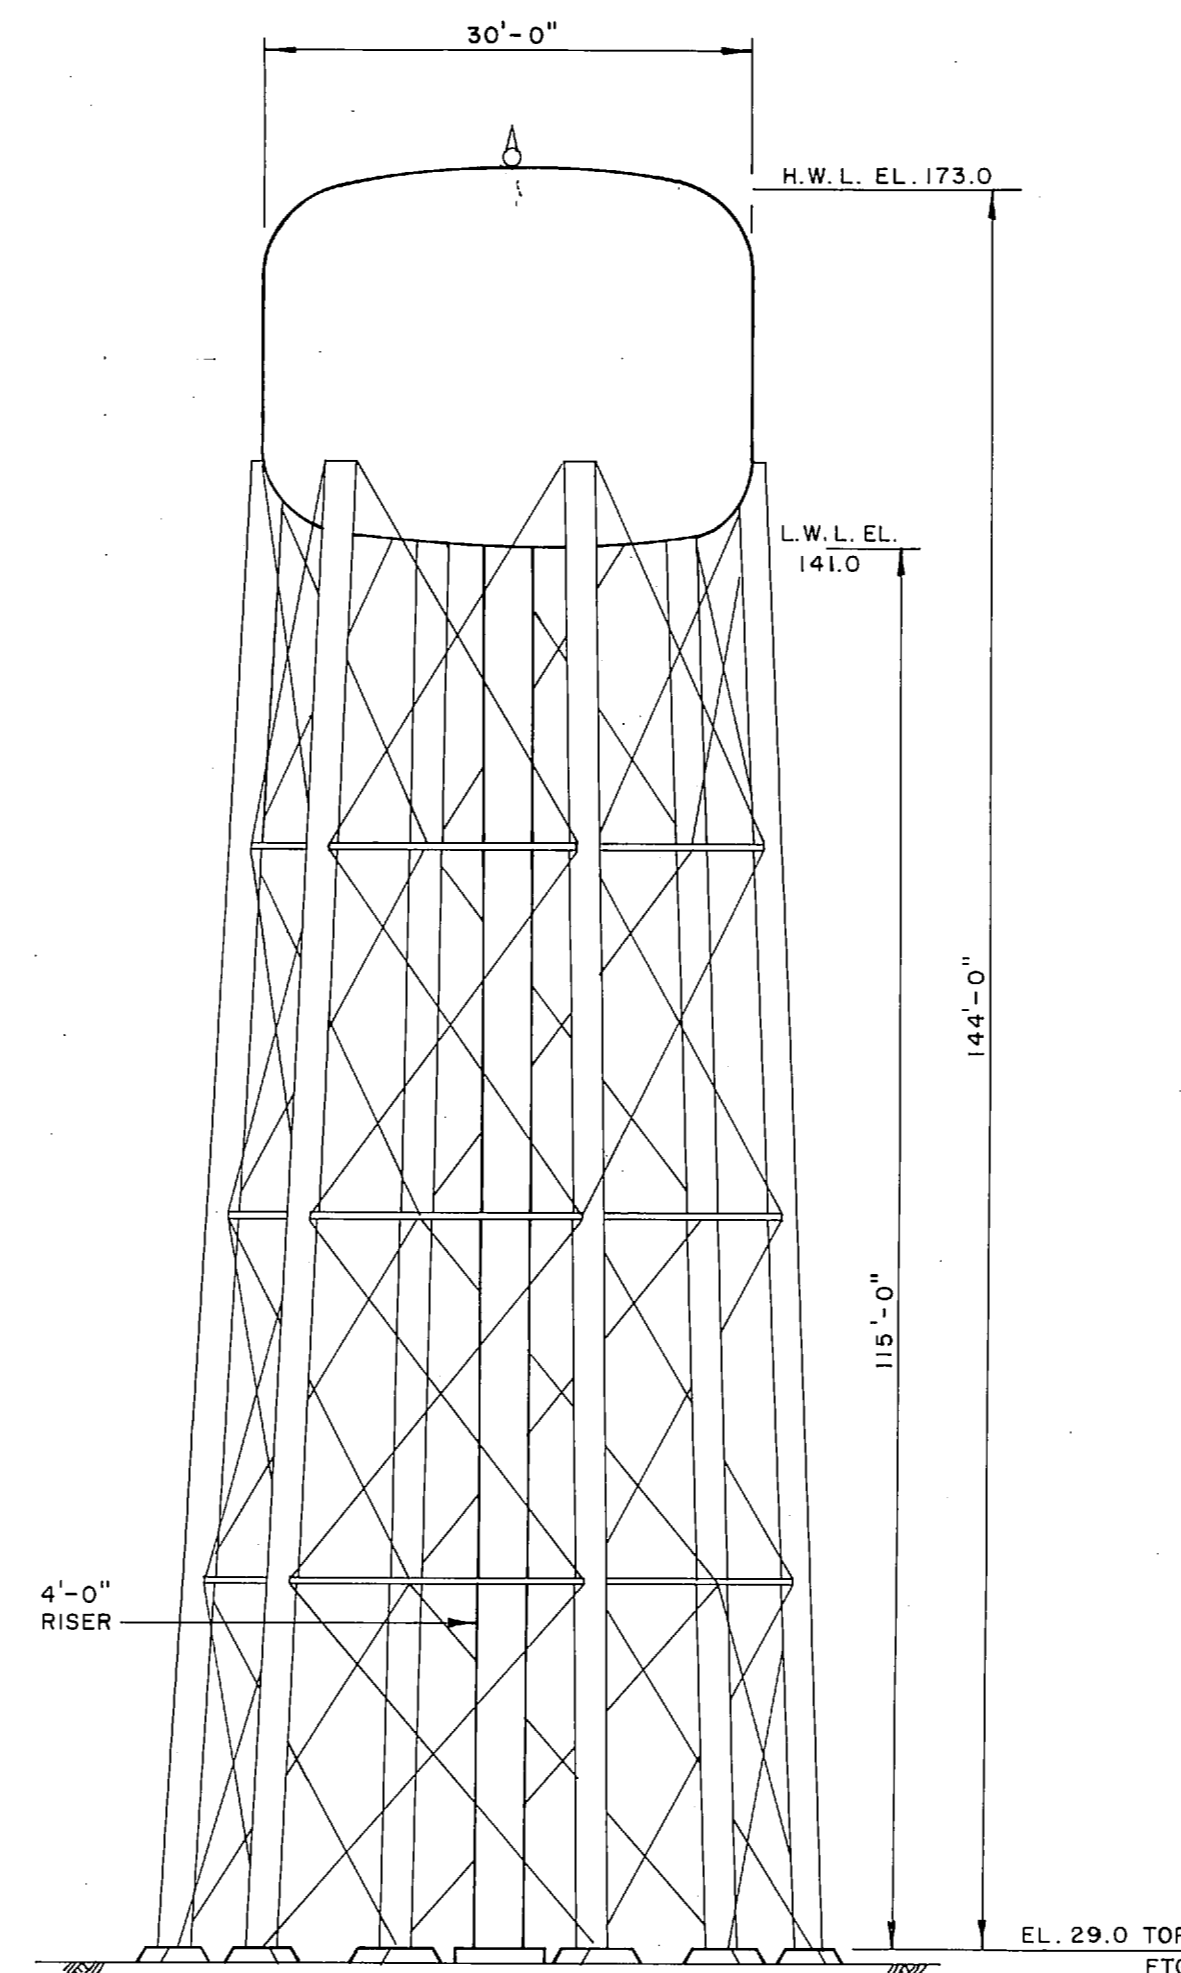


TANK S-TT-40 TARAWA TERRACE
250,000 GAL.

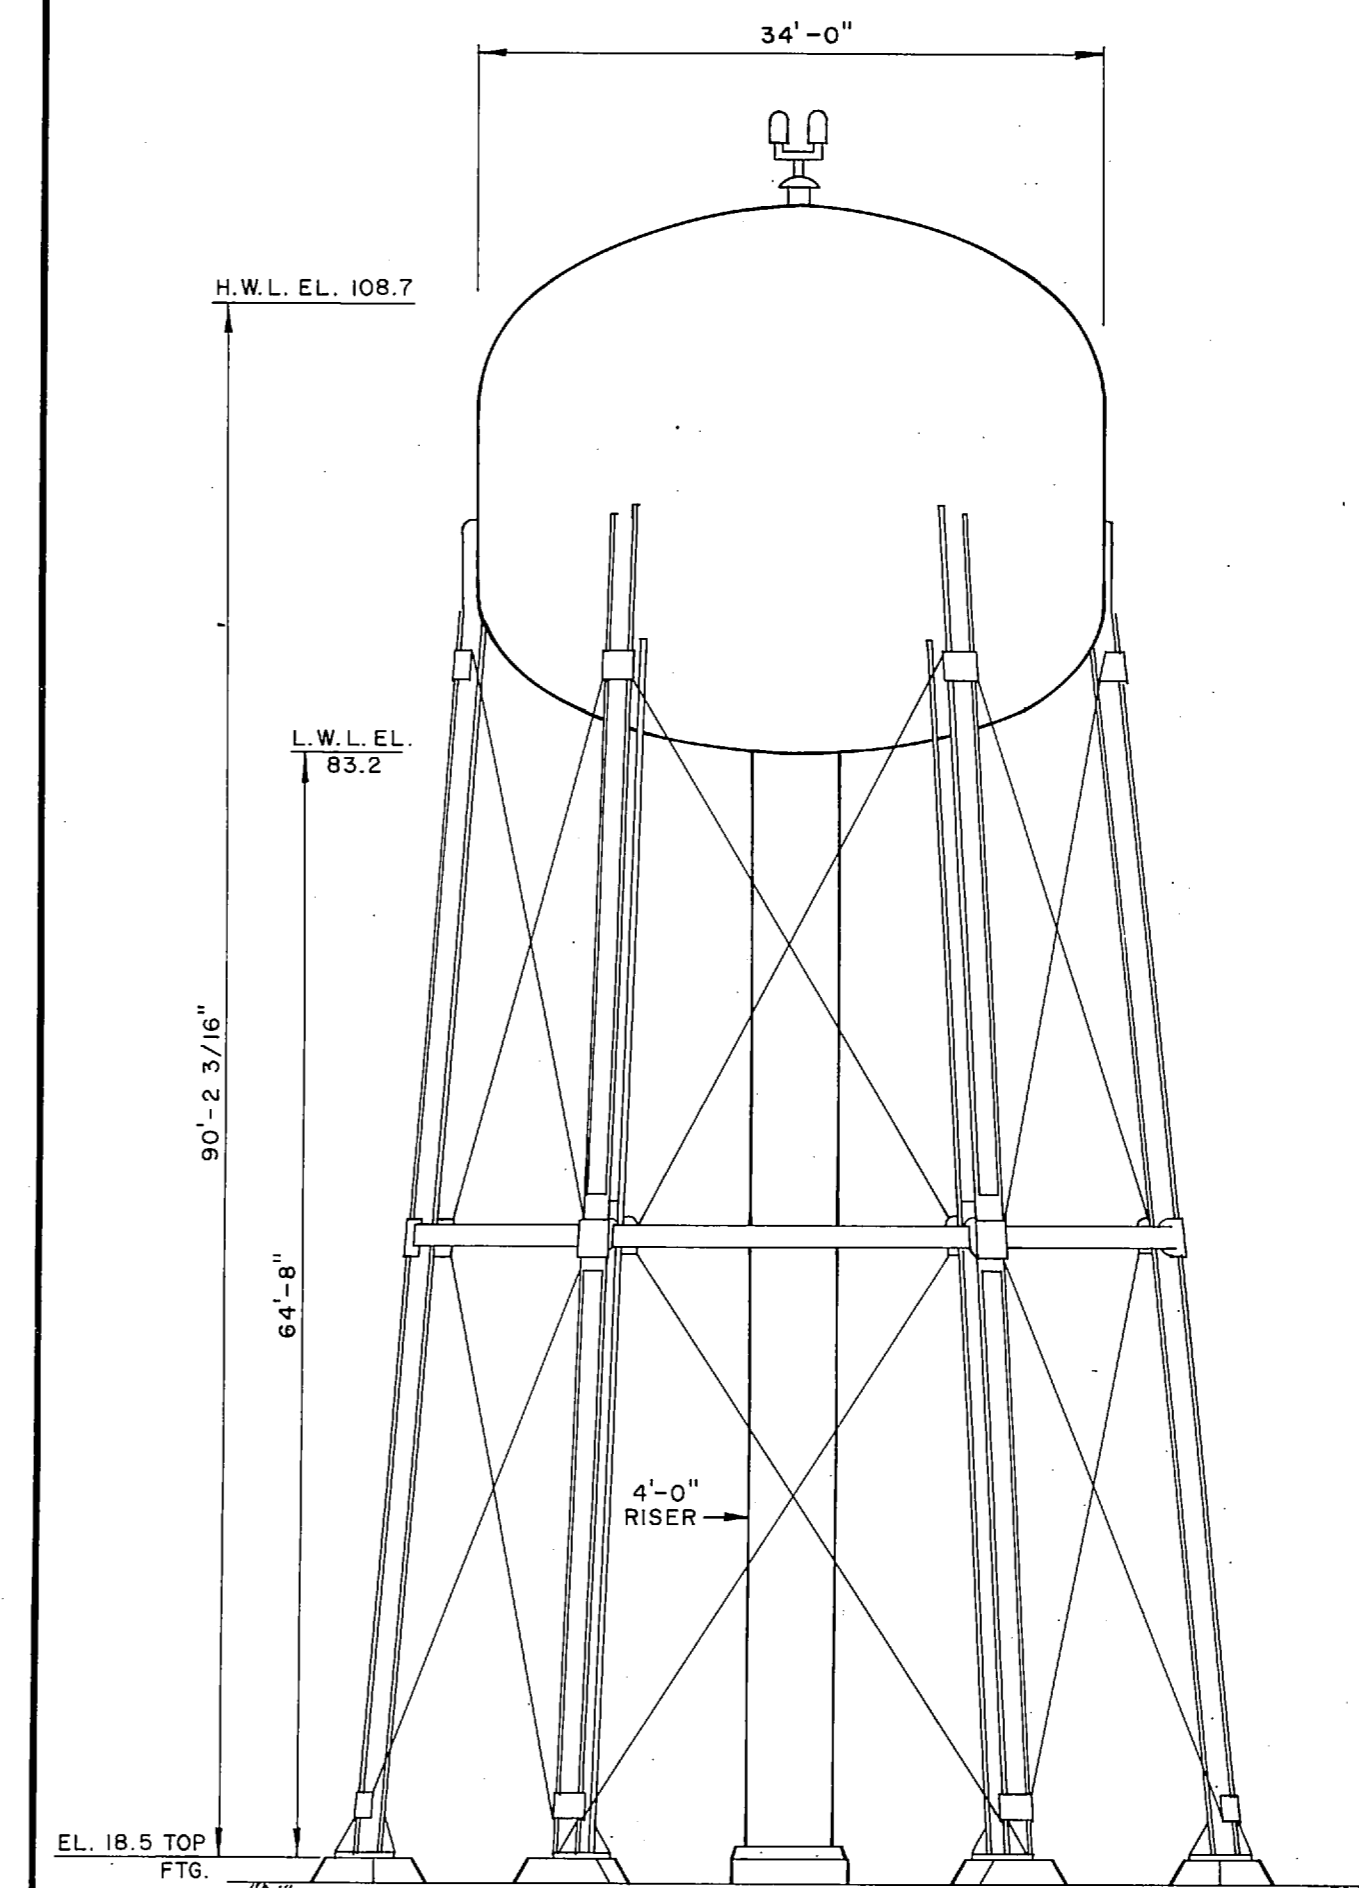


TANK S-M-624 MONTFORD POINT
150,000 GAL.

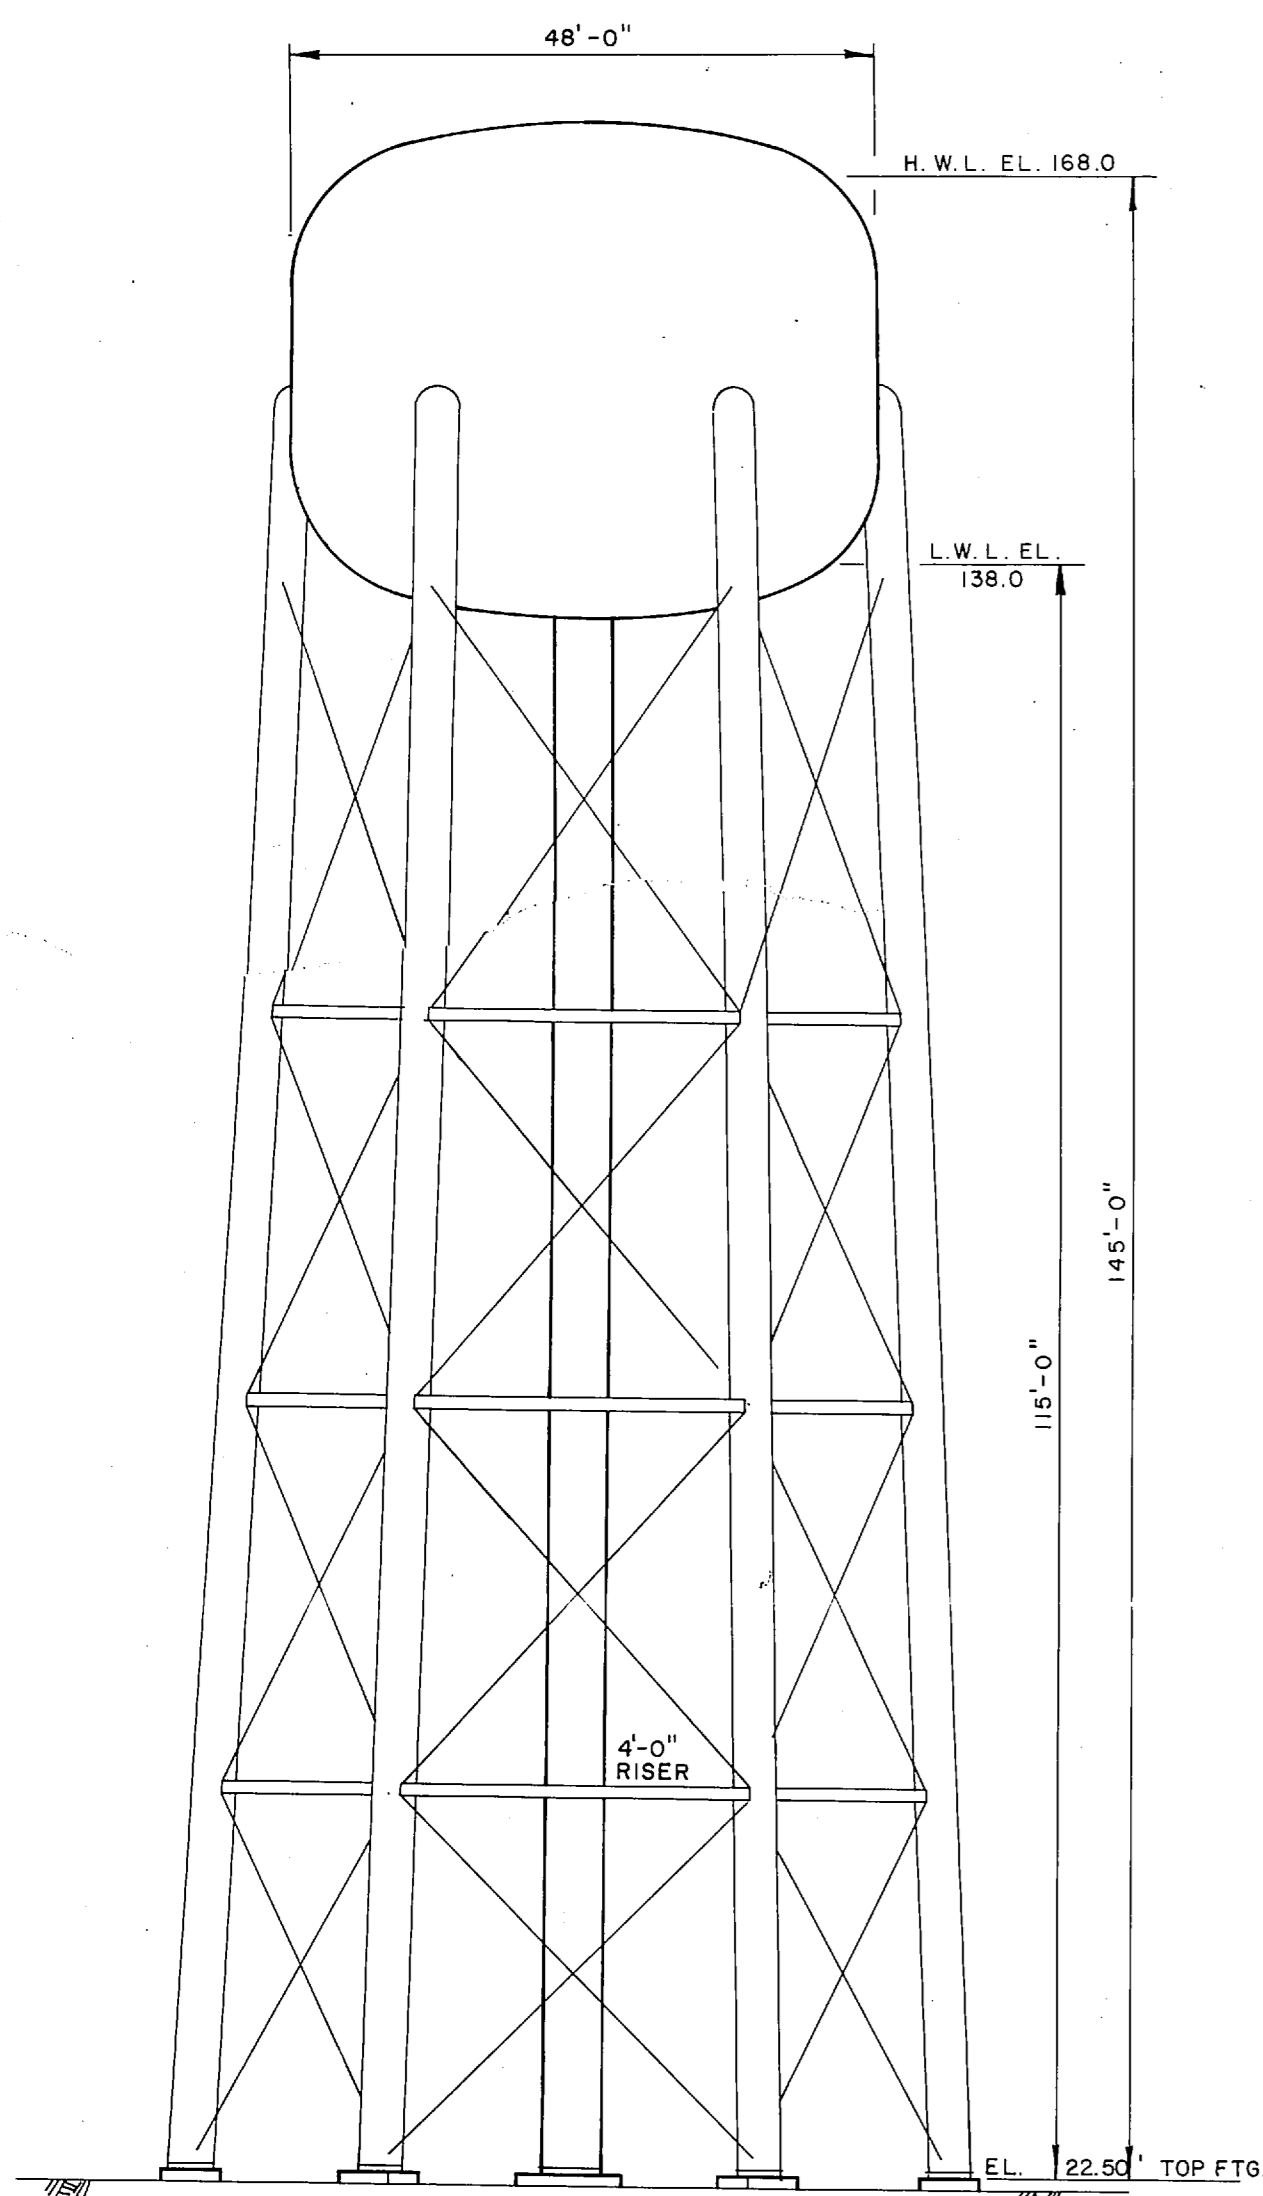


TANK AS-310 M. C. AIR STATION
350,000 GAL.

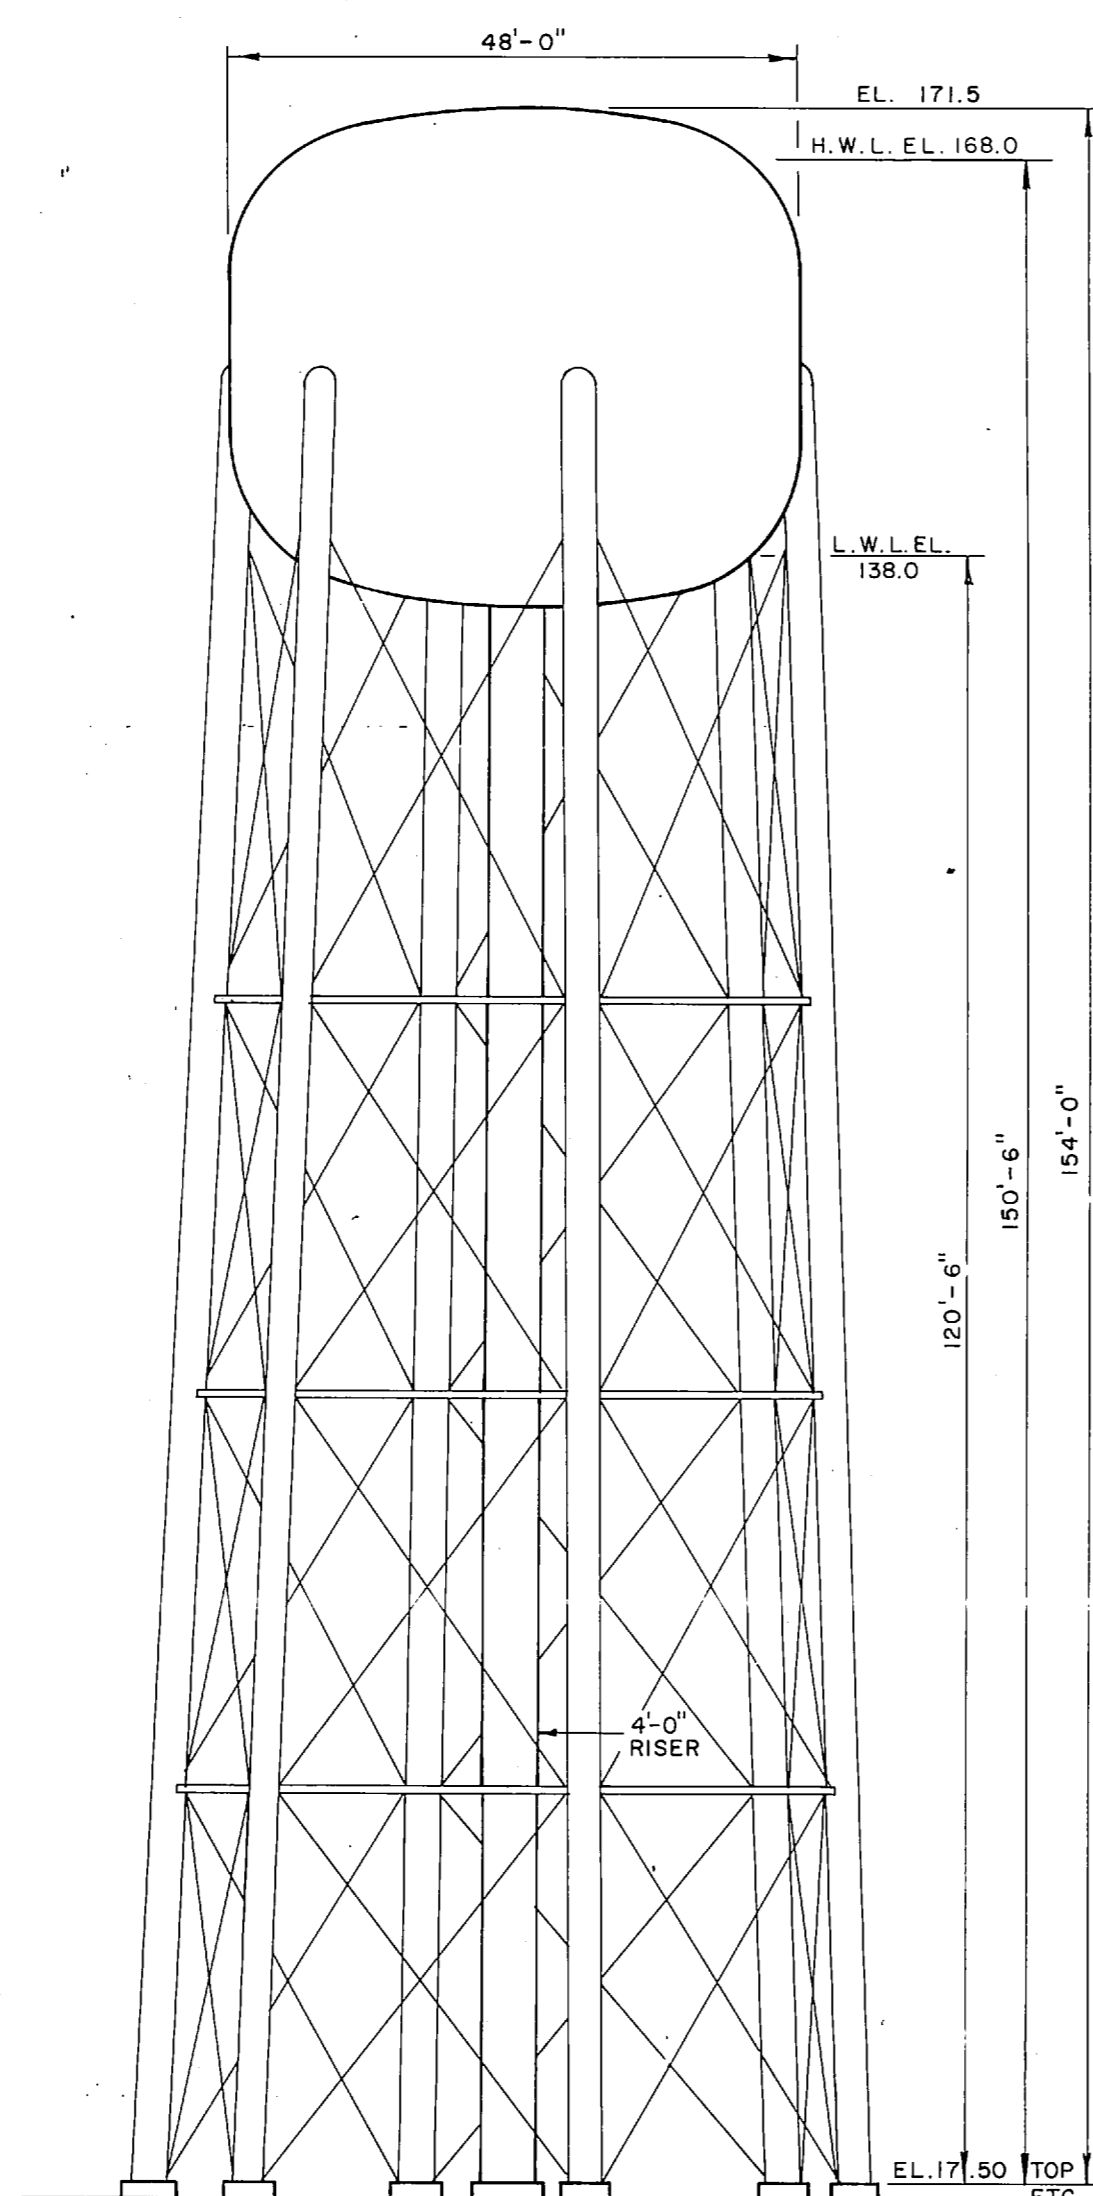

TANK AS-4130 M. C. AIR STATION
300,000 GAL.

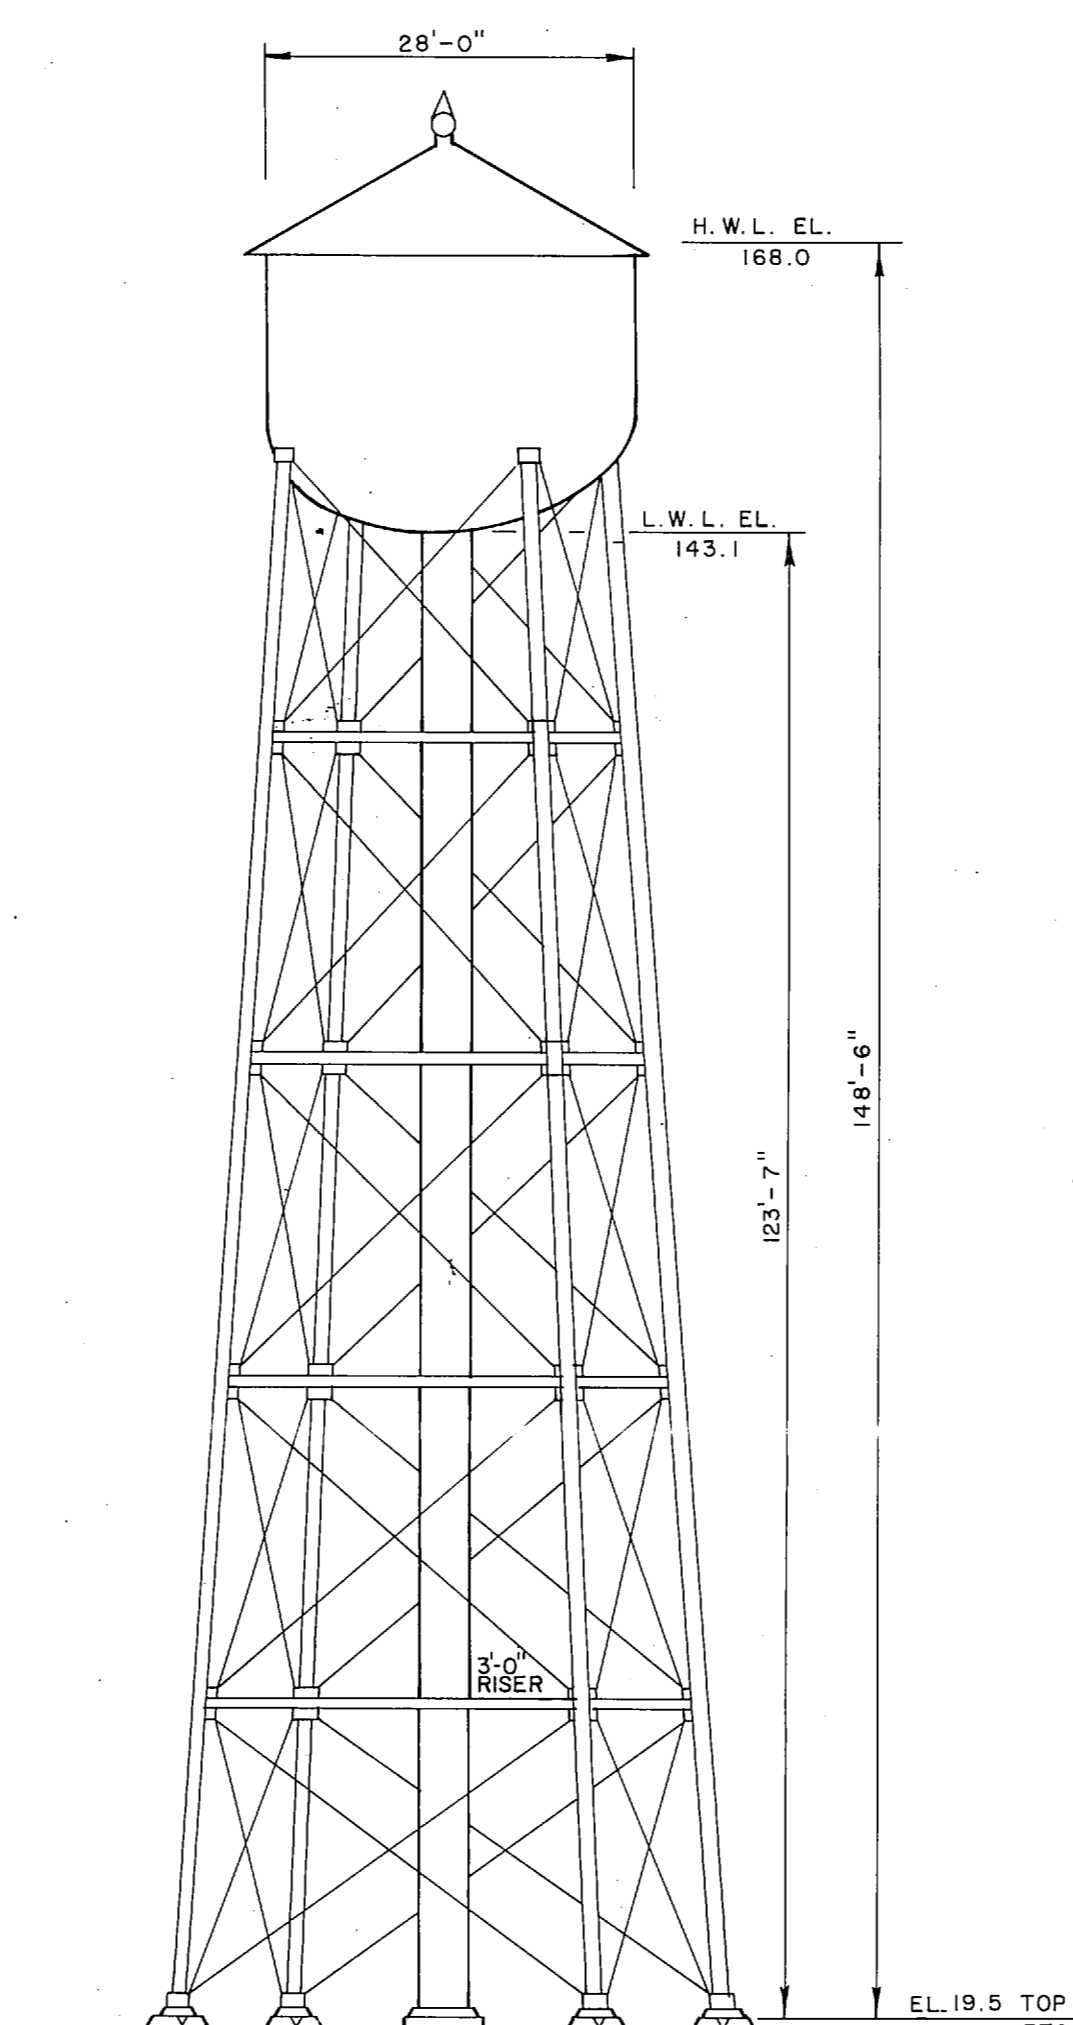


TANK S-TC-1070 CAMP GEIGER
100,000 GAL.

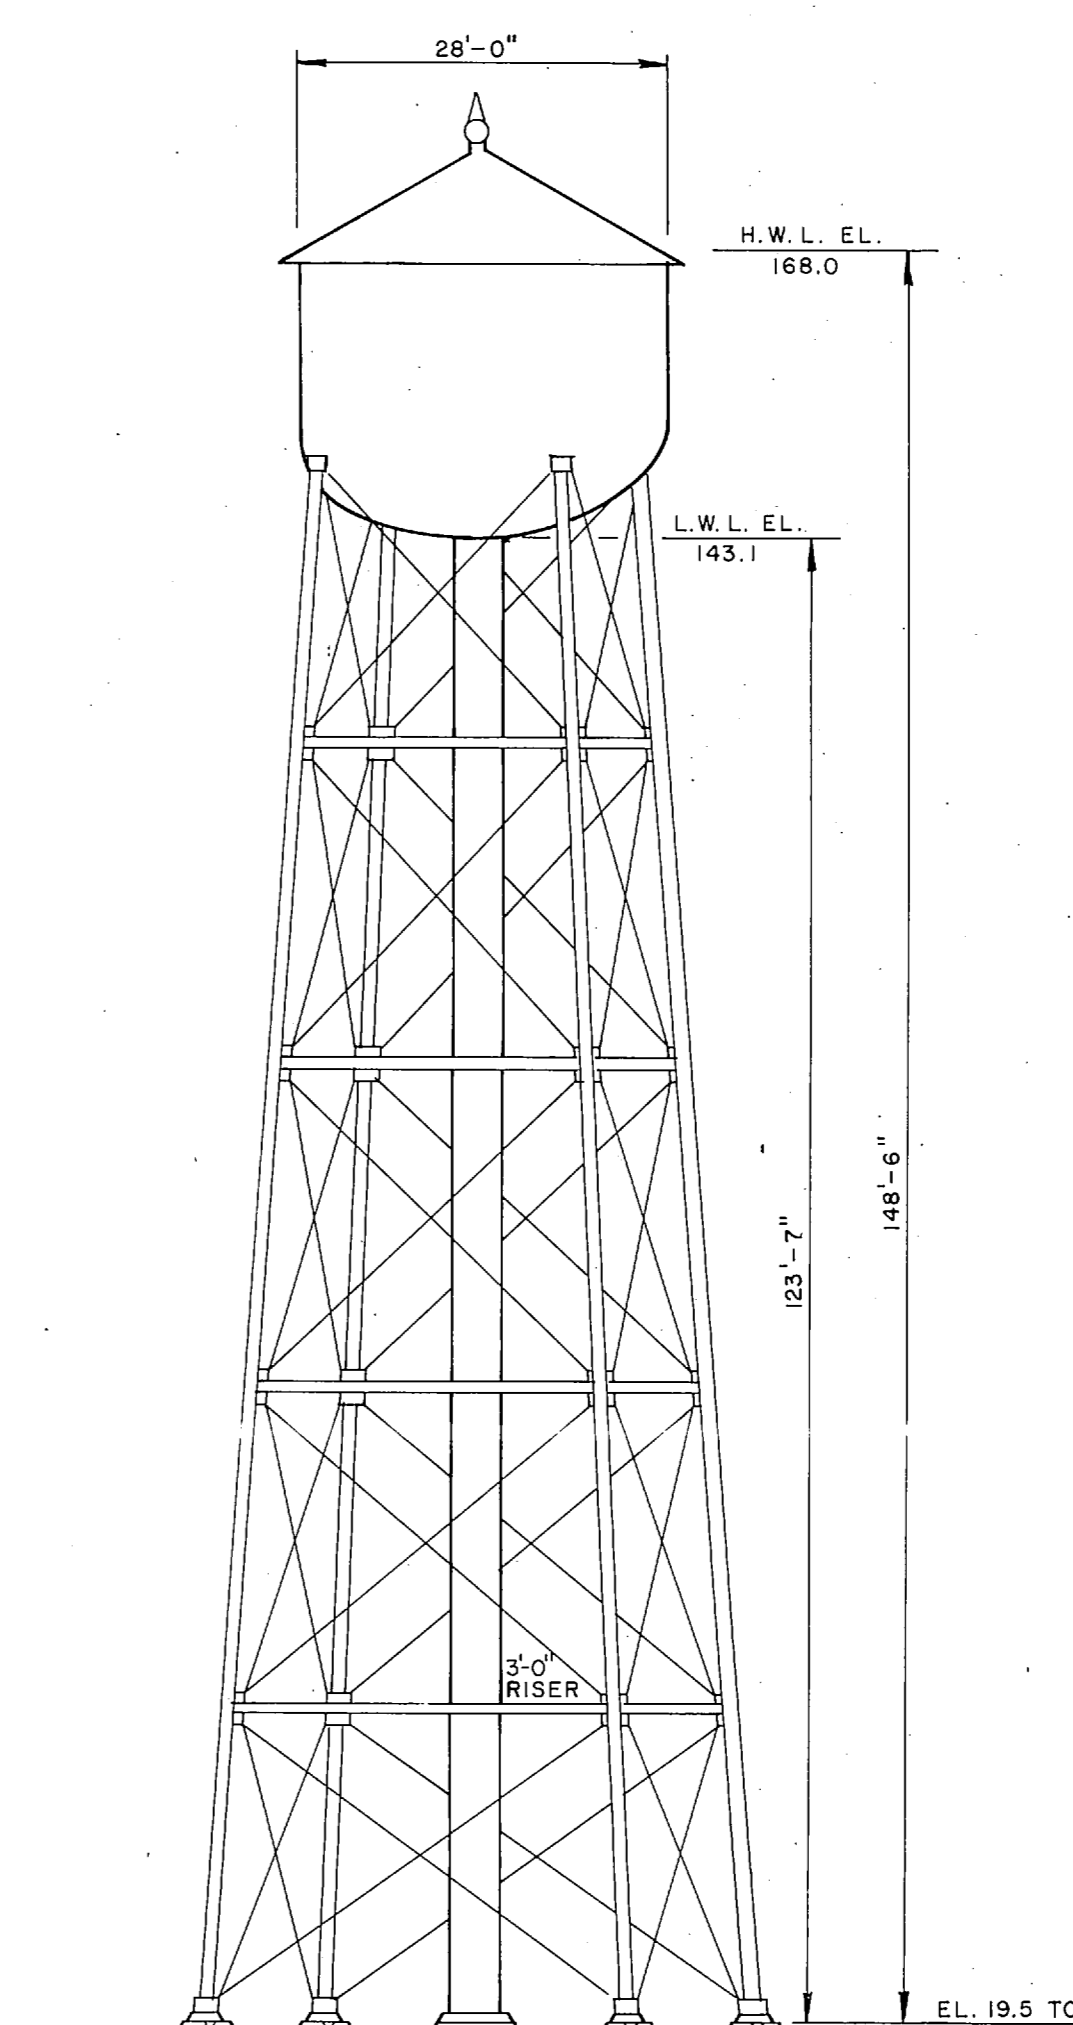


TANK S-TC-606 CAMP GEIGER
100,000 GAL.

NOTE: HWL IS EQUIVALENT TO OVERFLOW ELEVATION.


NO.	DESCRIPTION OF REVISION	DATE	INT.
DEPARTMENT OF THE NAVY MARINE CORPS BASE CAMP LEJEUNE, NORTH CAROLINA			
ELEVATED STORAGE TANKS WATER DISTRIBUTION SYSTEM EXISTING CONDITIONS			
DATE	31 JULY 1984	SCALE: NONE	SHEET 2 of 2
APPROVED / DATE			

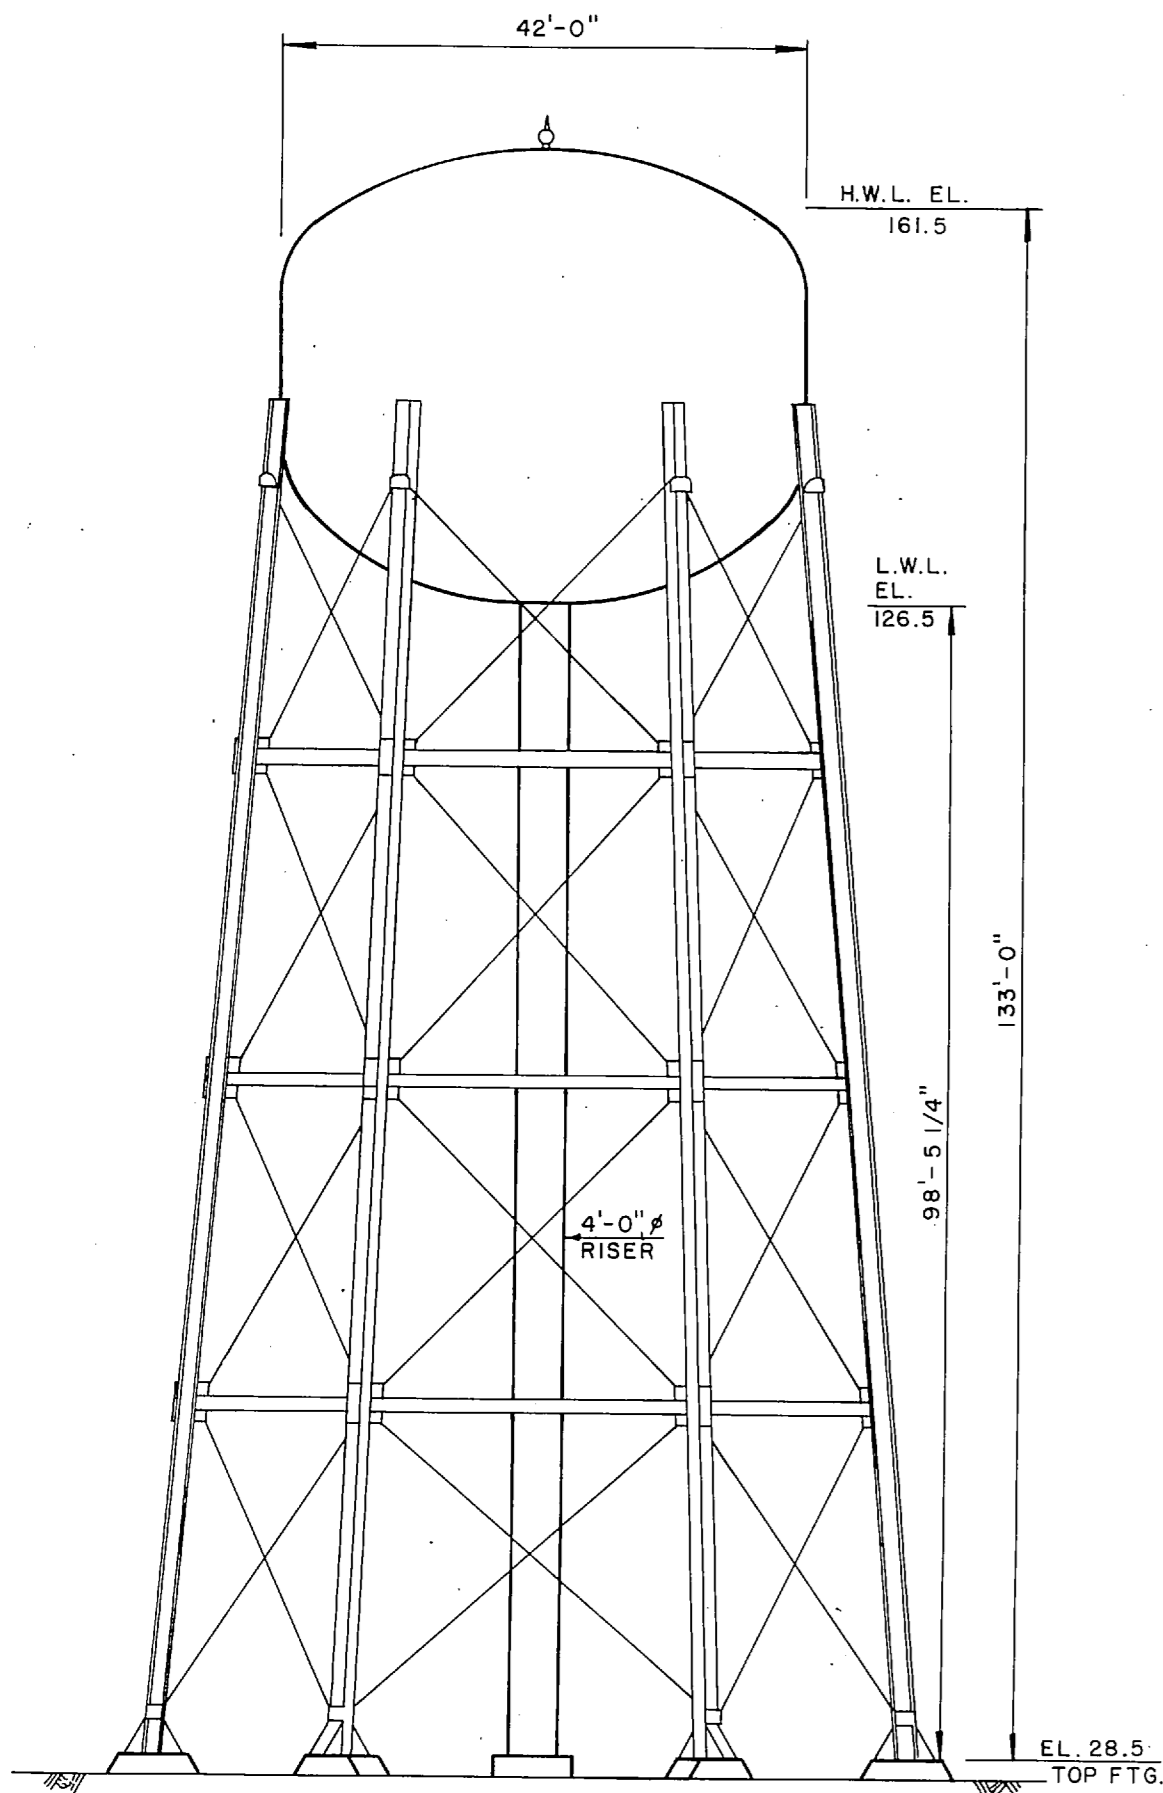


TANK S-1000 HADNOT POINT
300,000 GAL.

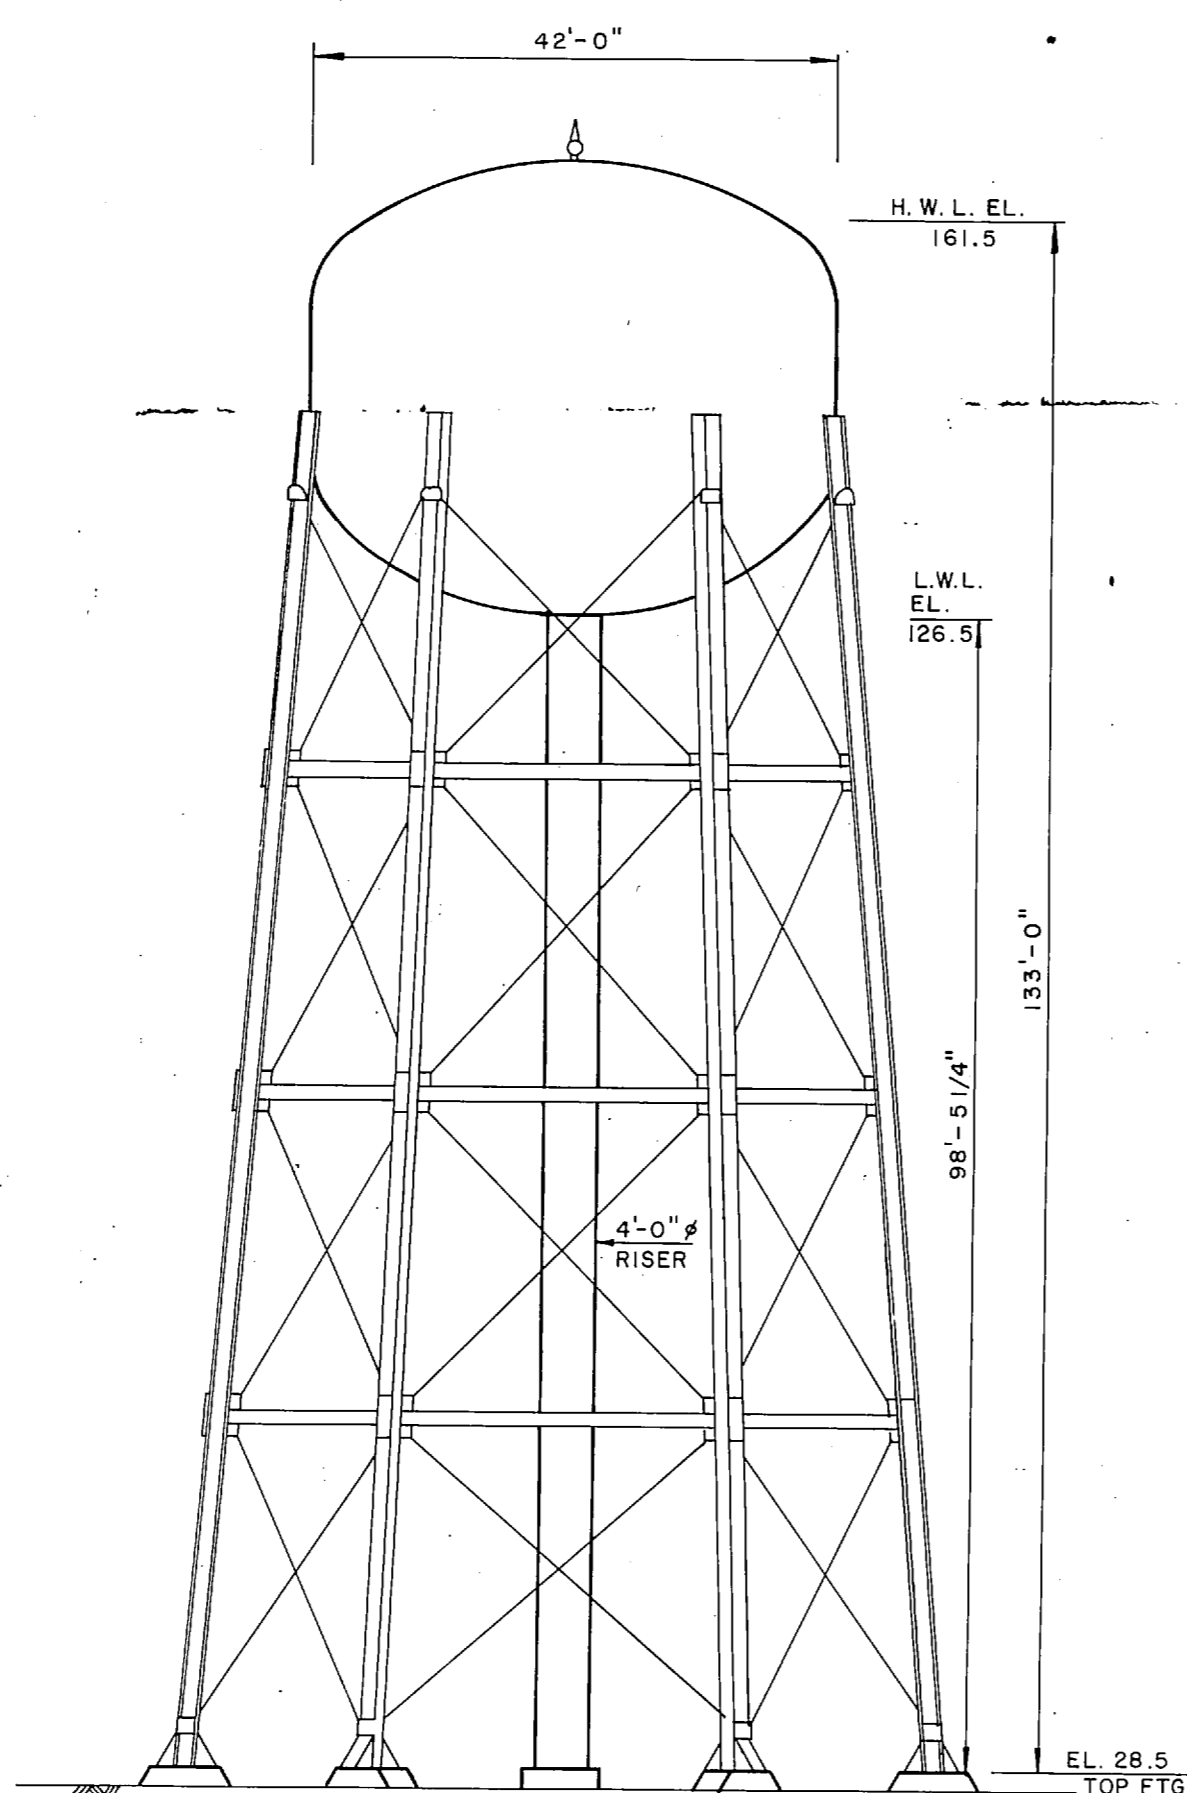


TANK S-29 HADNOT POINT
300,000 GAL.

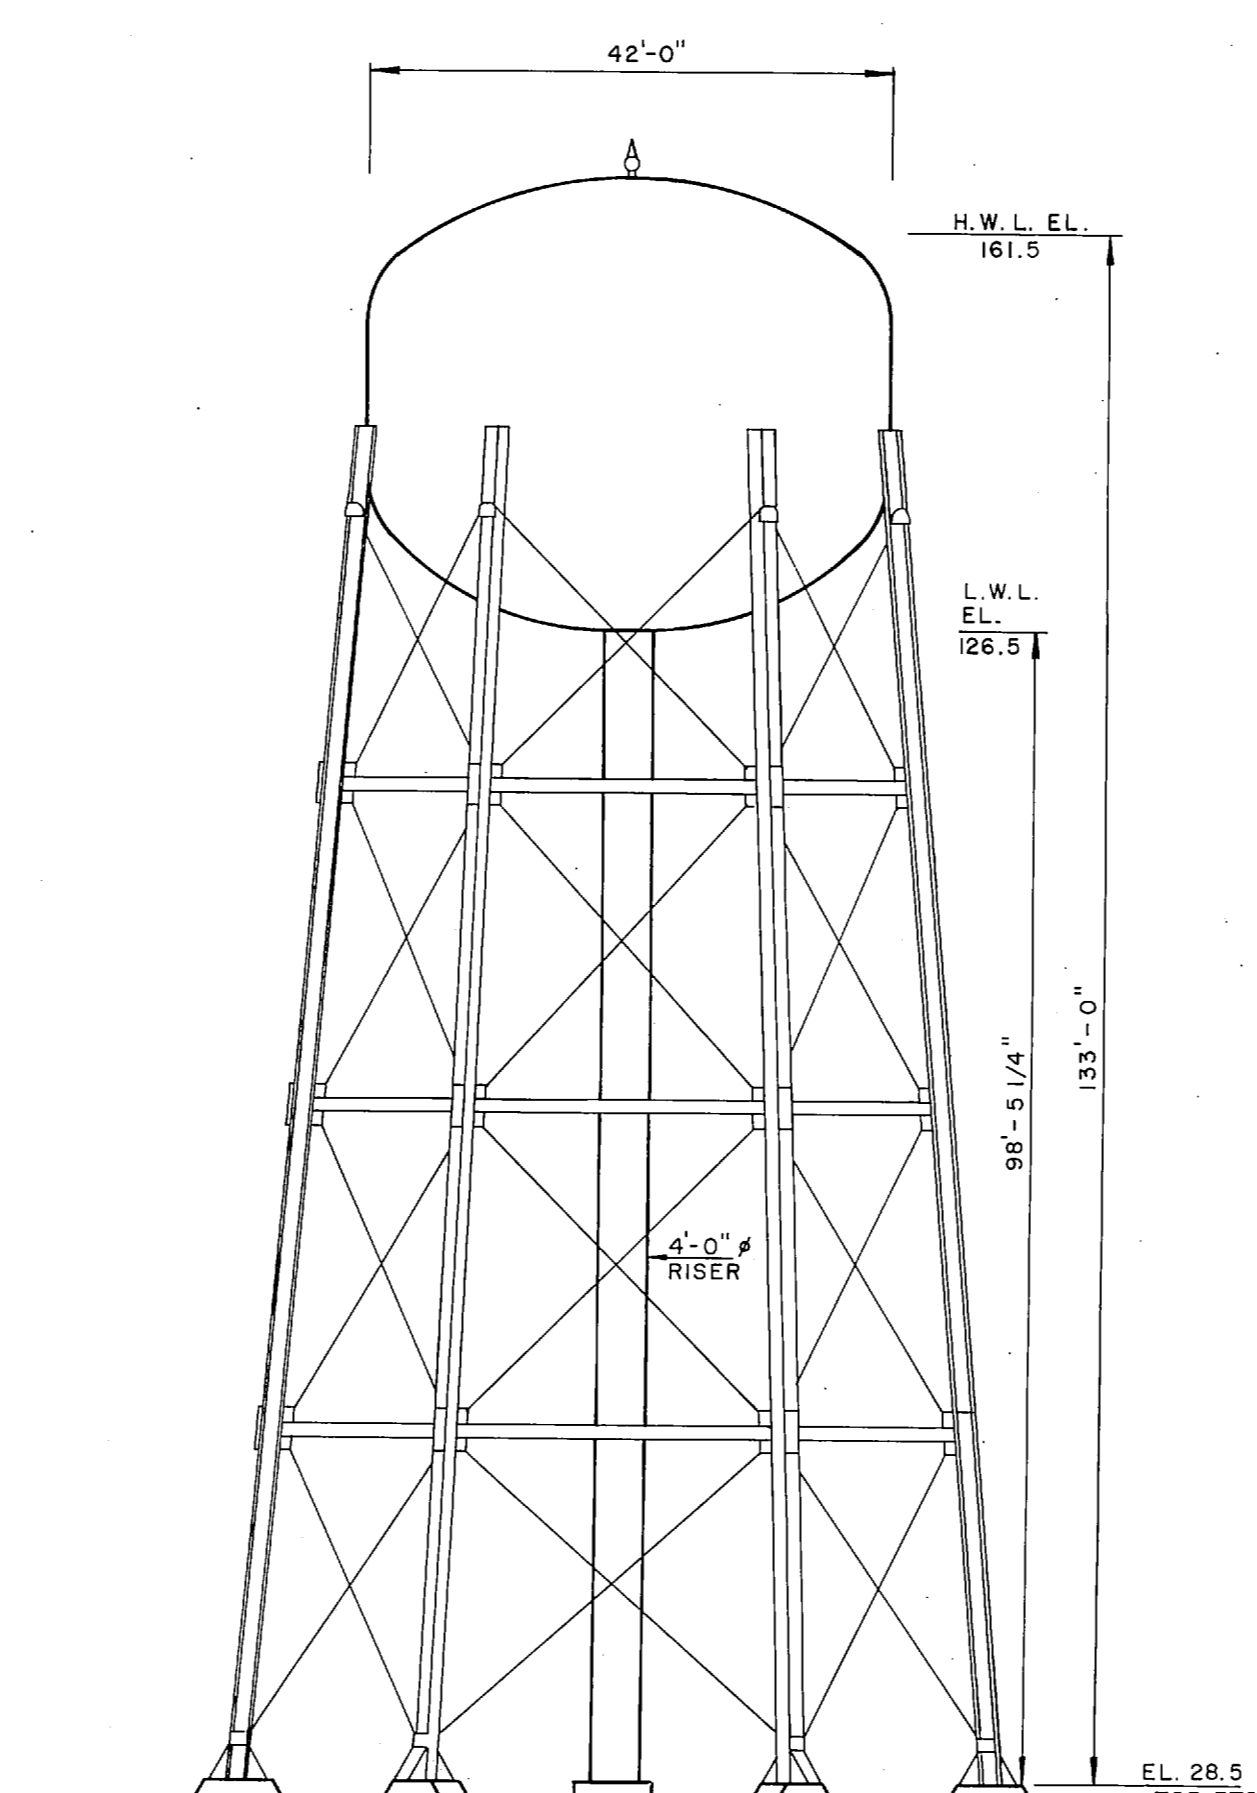


TANK S-5 HADNOT POINT
300,000 GAL.

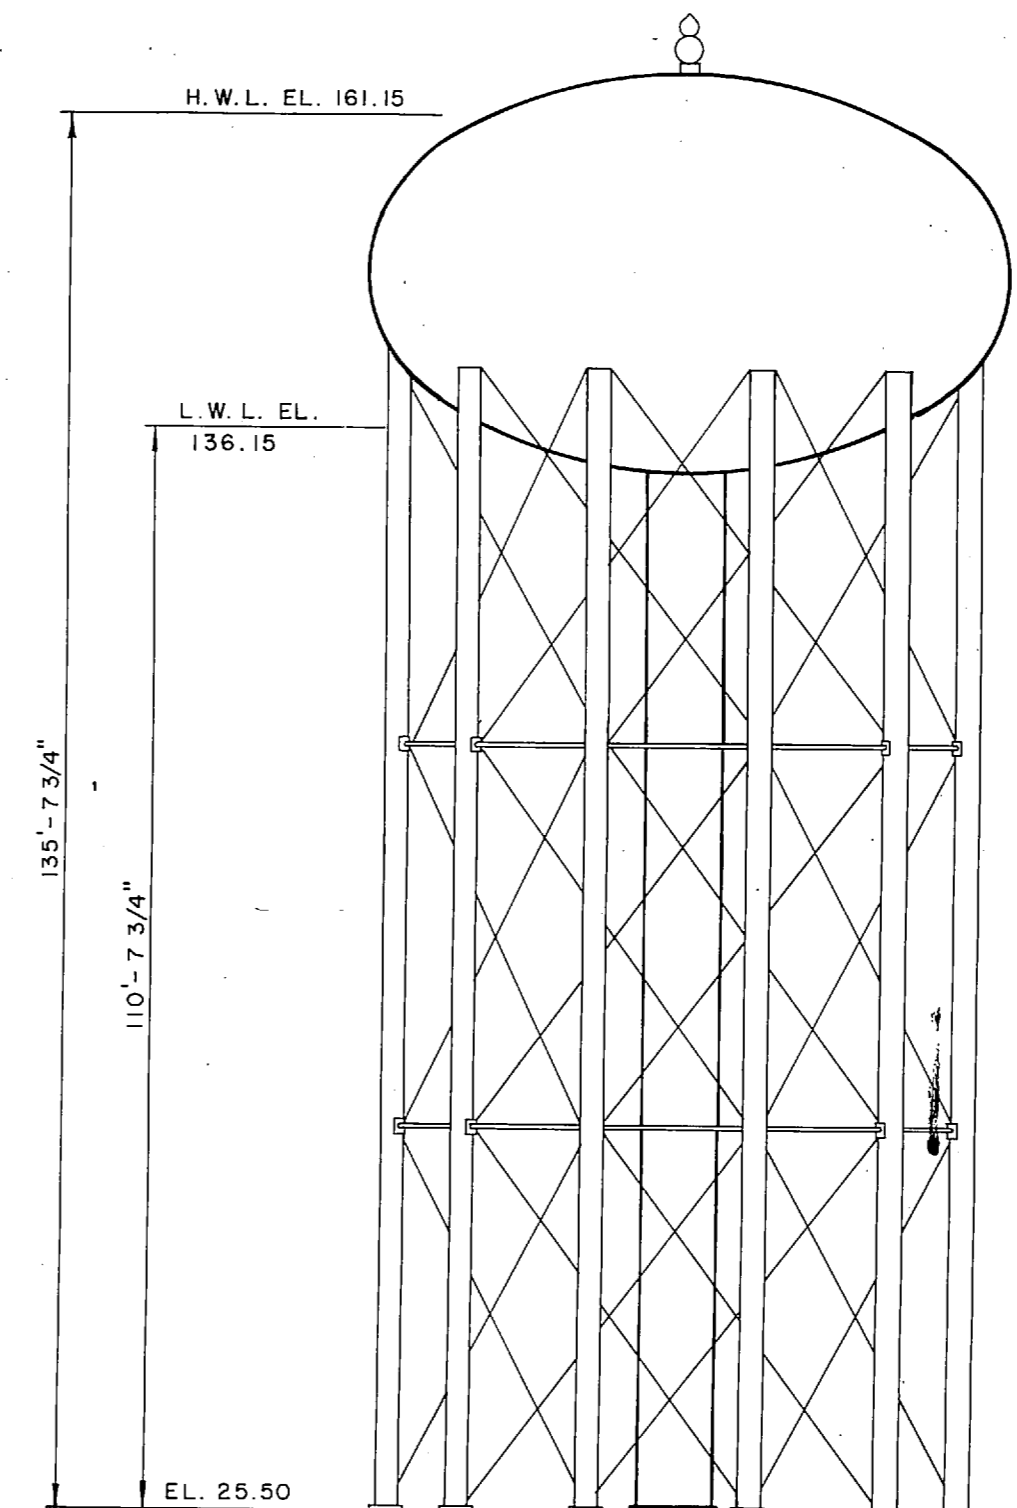


TANK SFC-314 FRENCH CREEK
300,000 GAL.

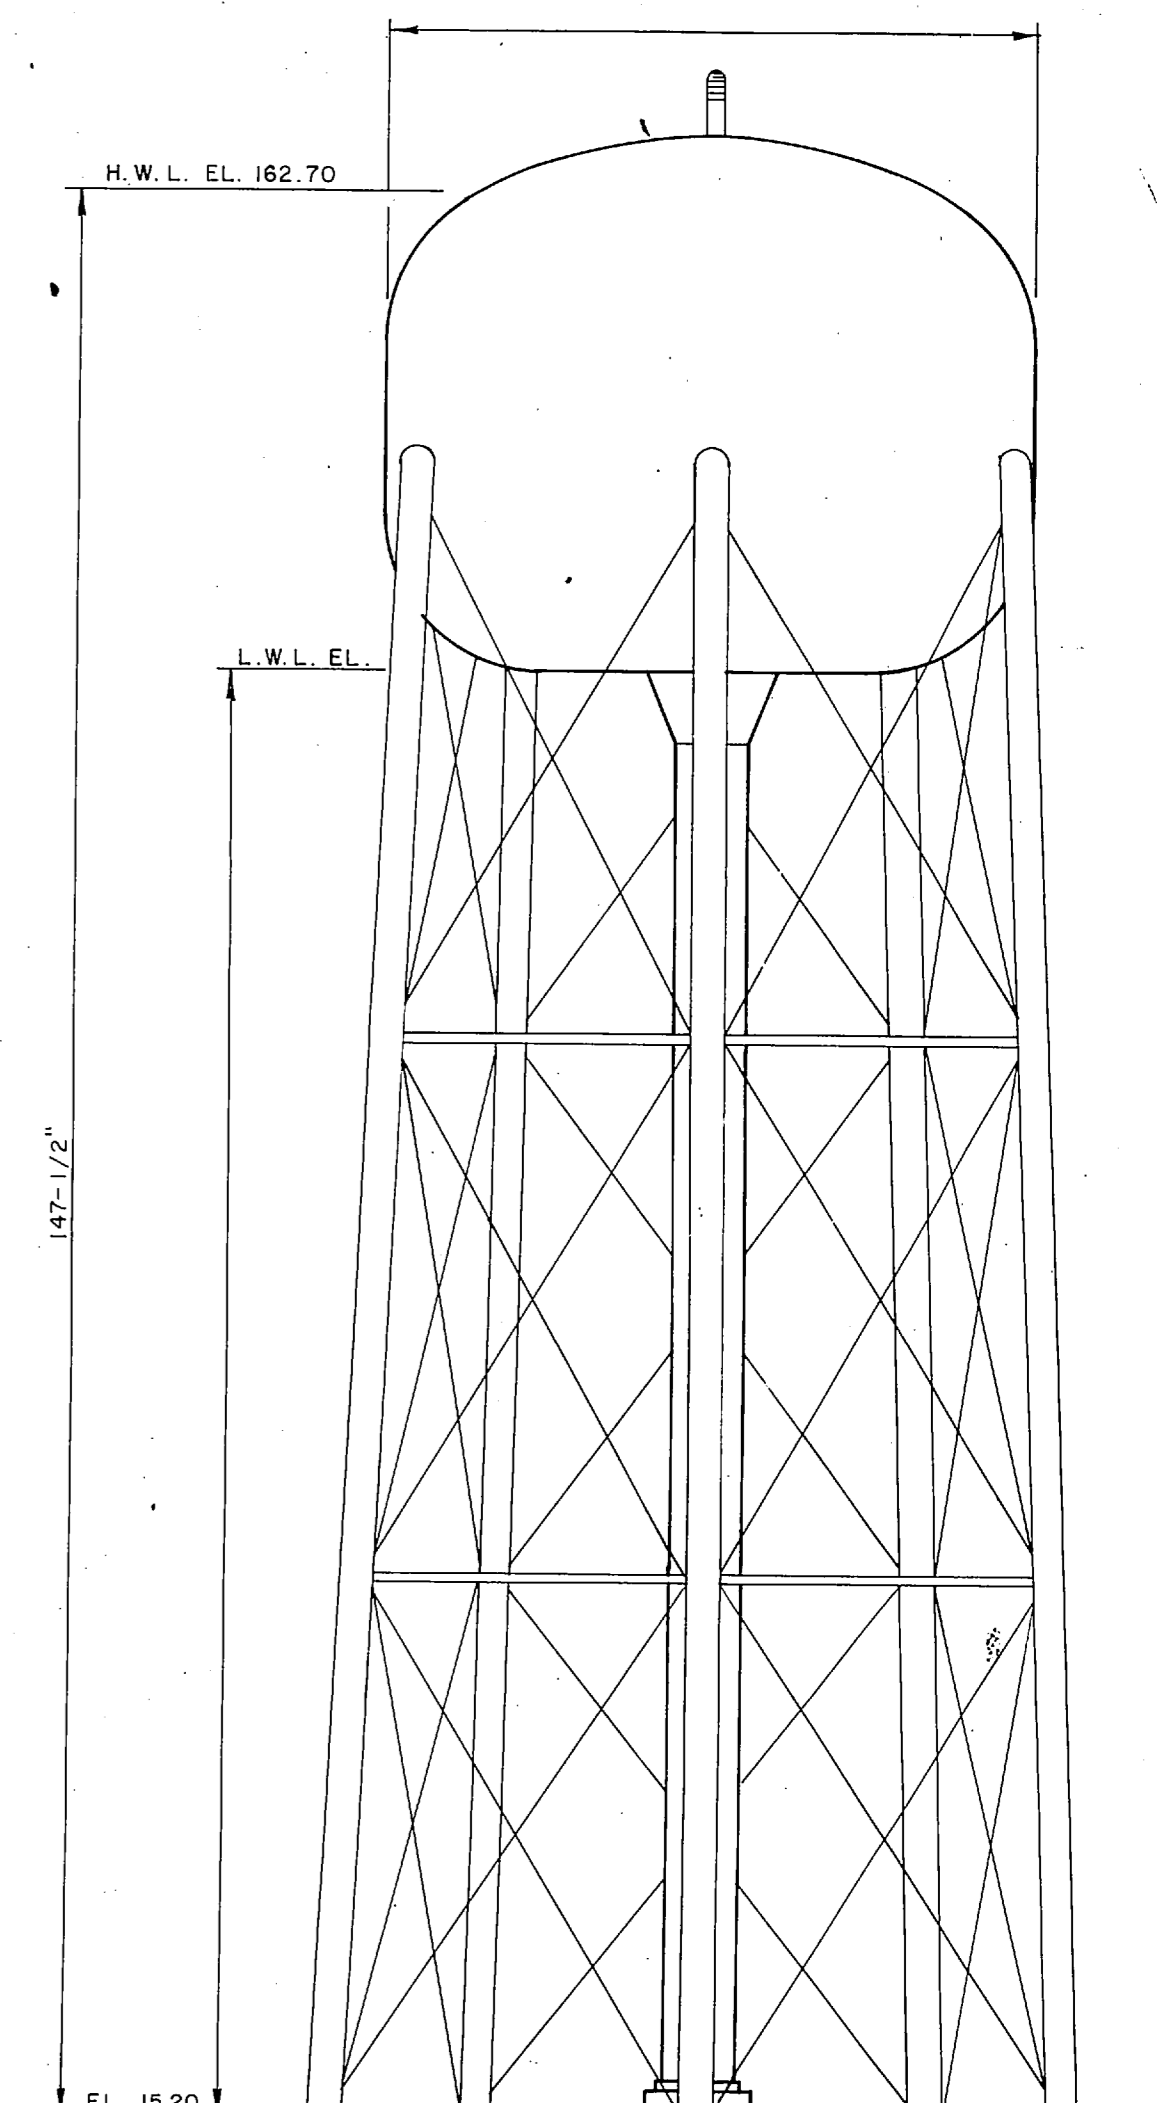


AMPHIBIAN TROOPS AREA
325,000 GAL.

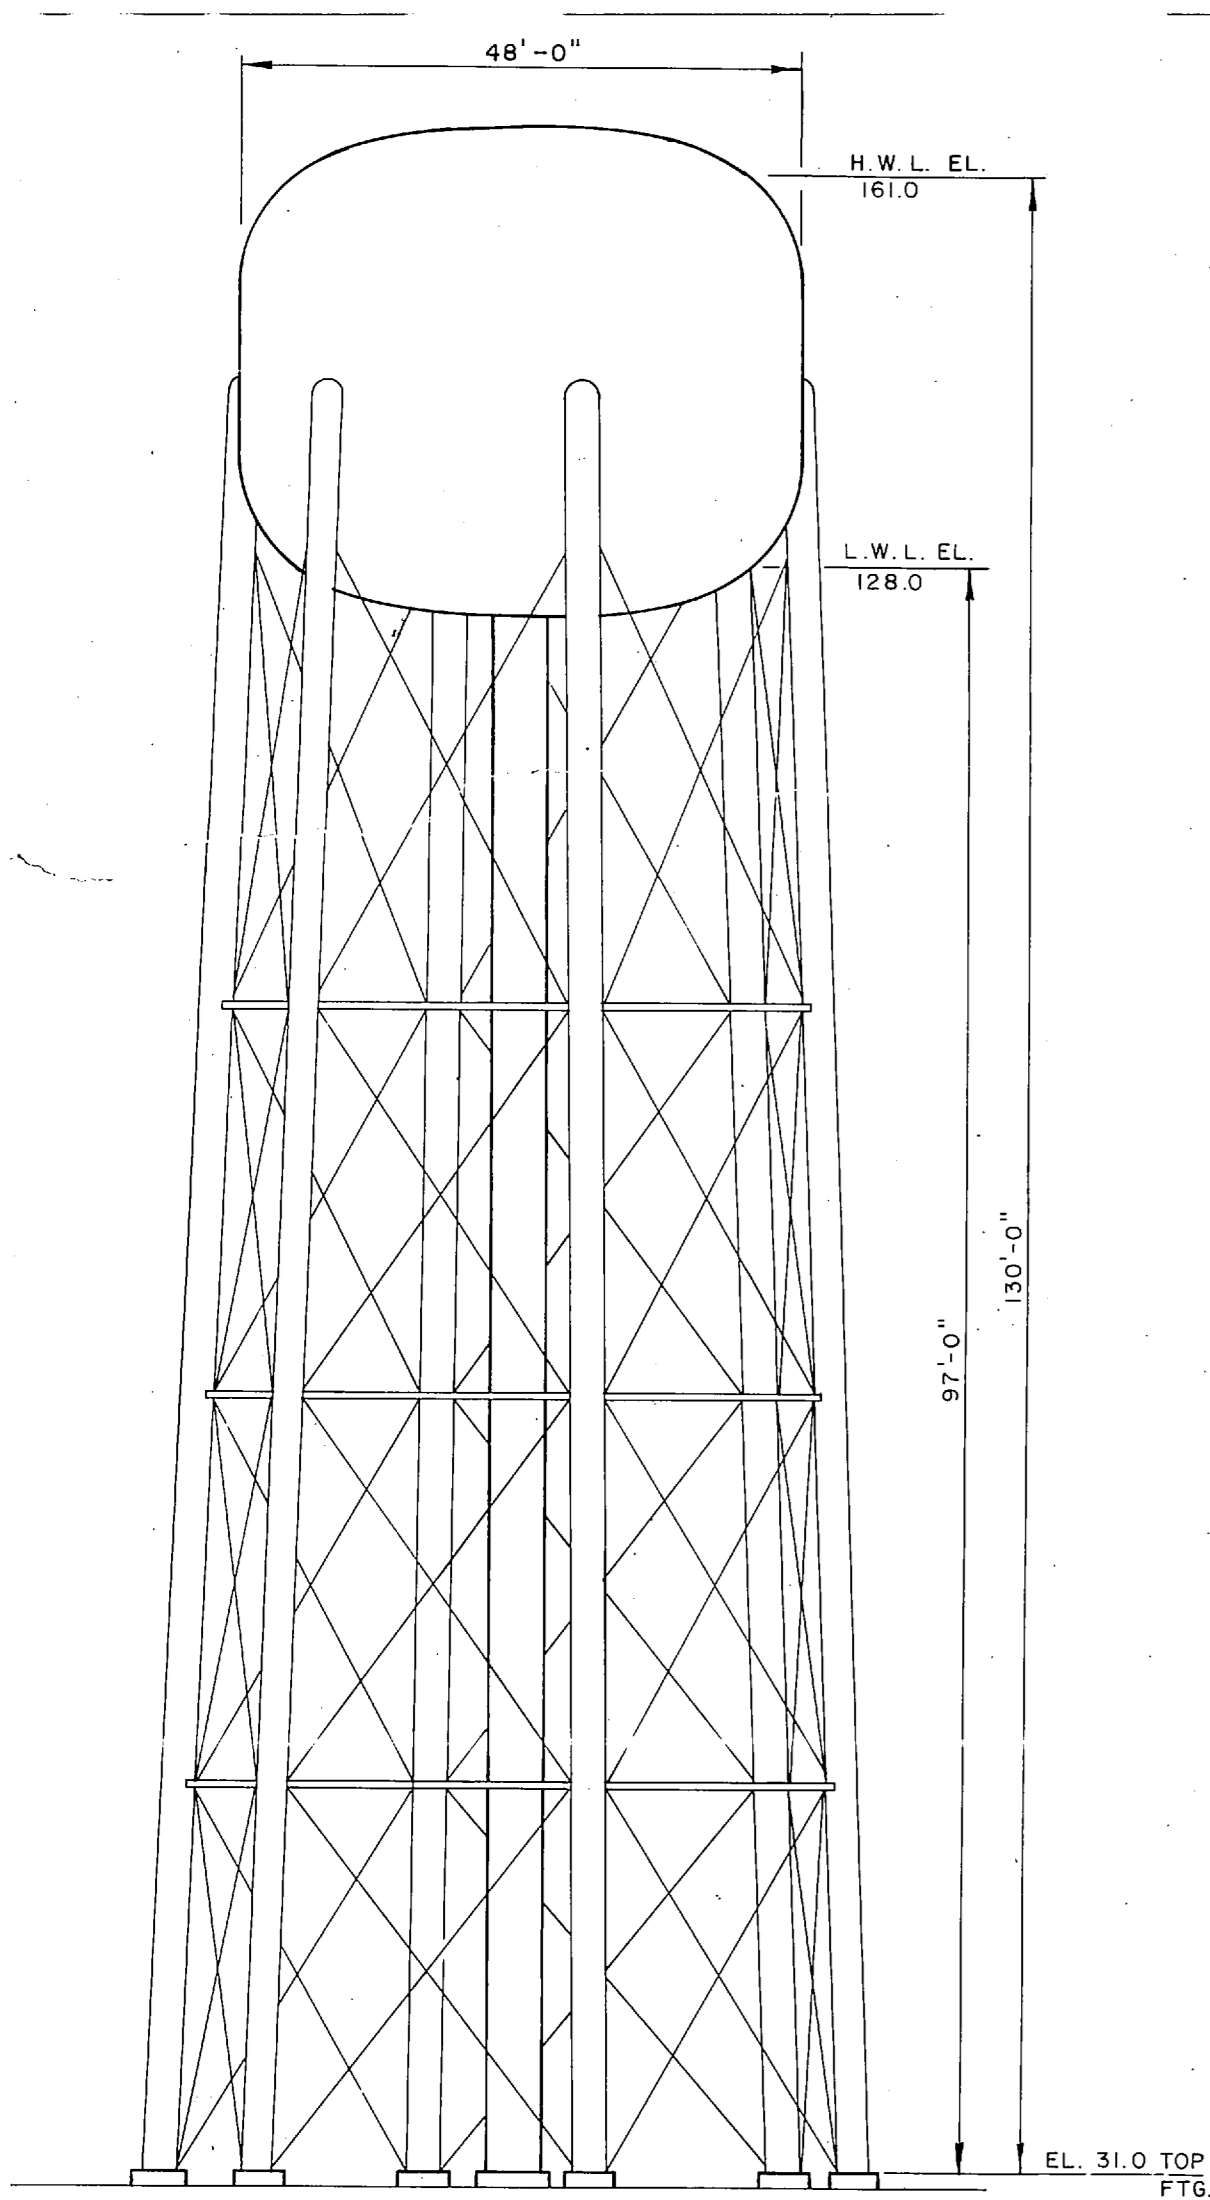


TANK S-830 BERKLEY MANOR
300,000 GAL.

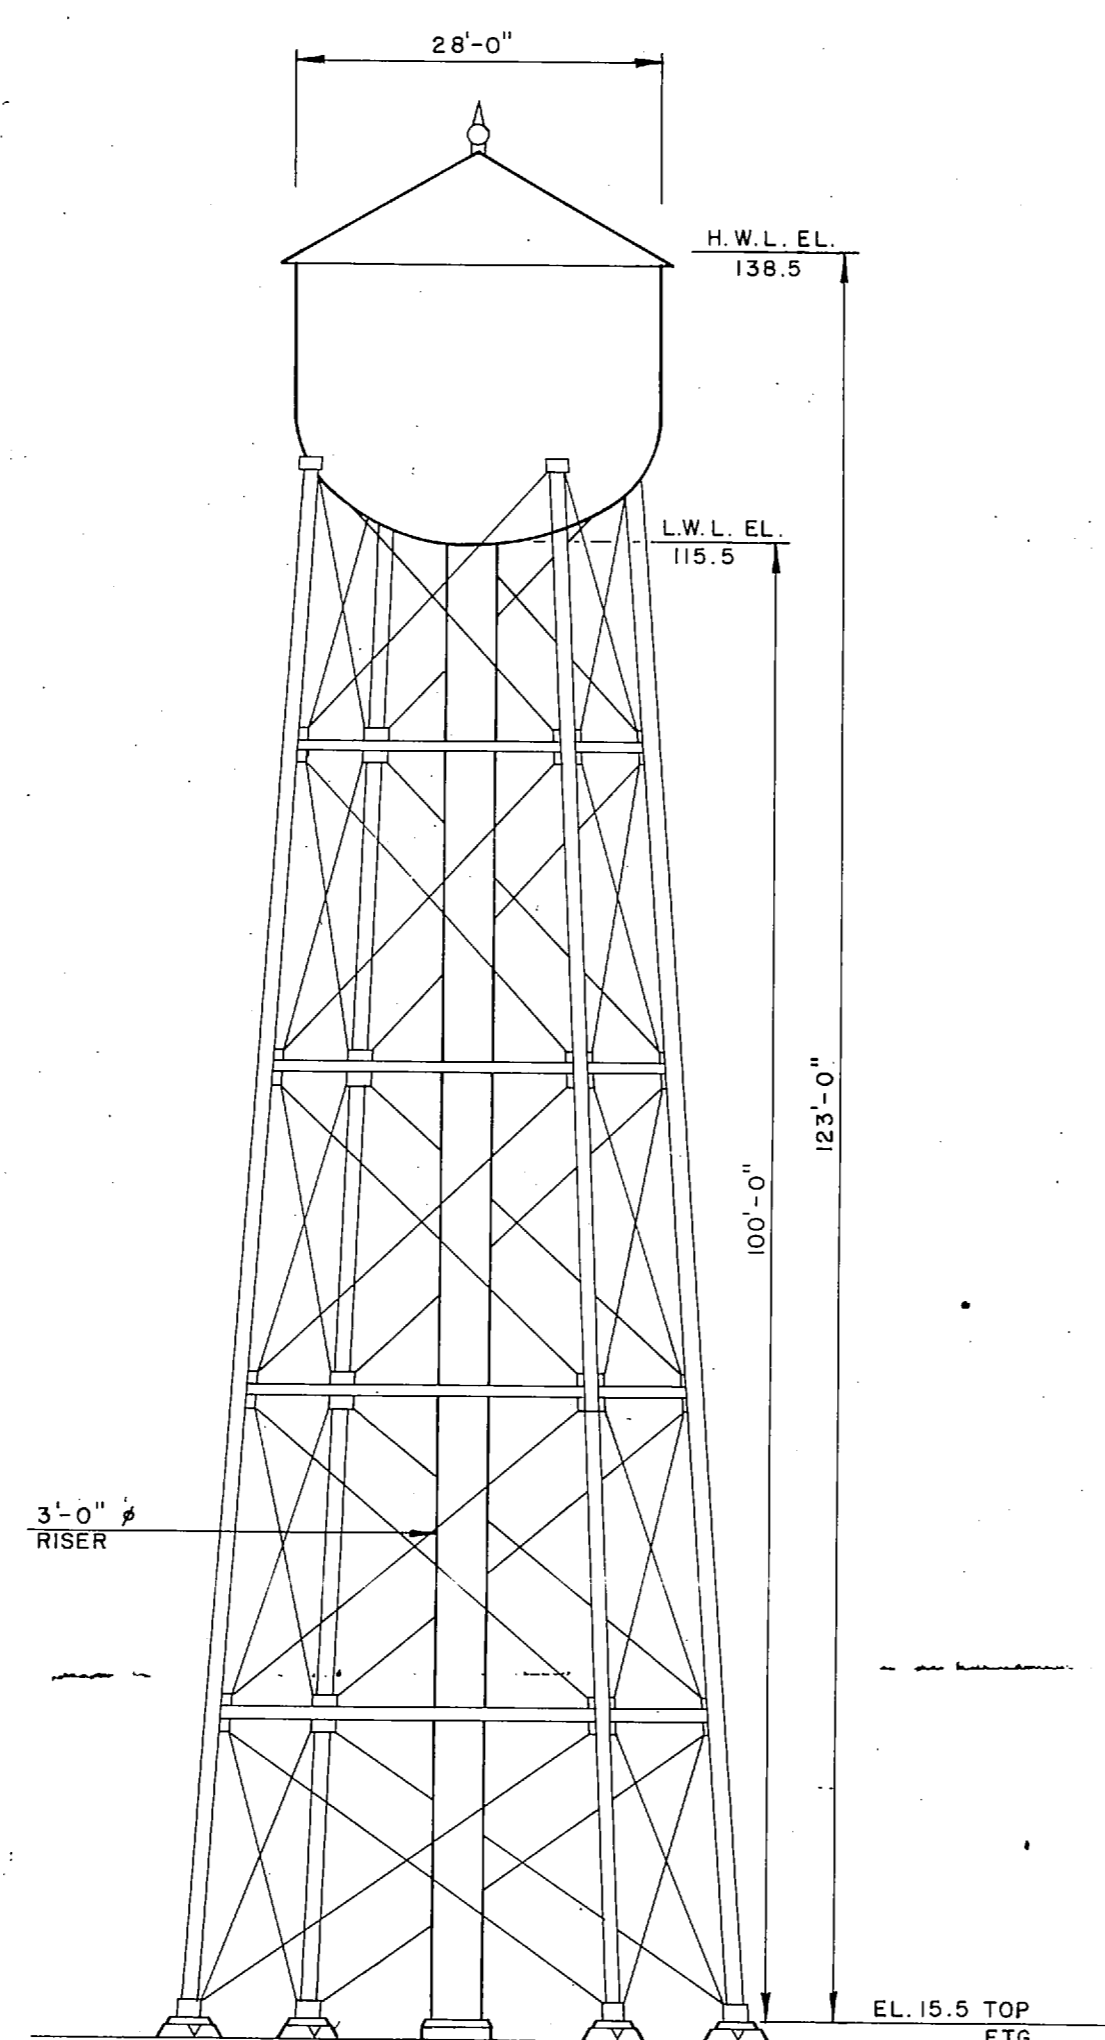

TANK S-BB-25 COURTHOUSE BAY
100,000 GAL.

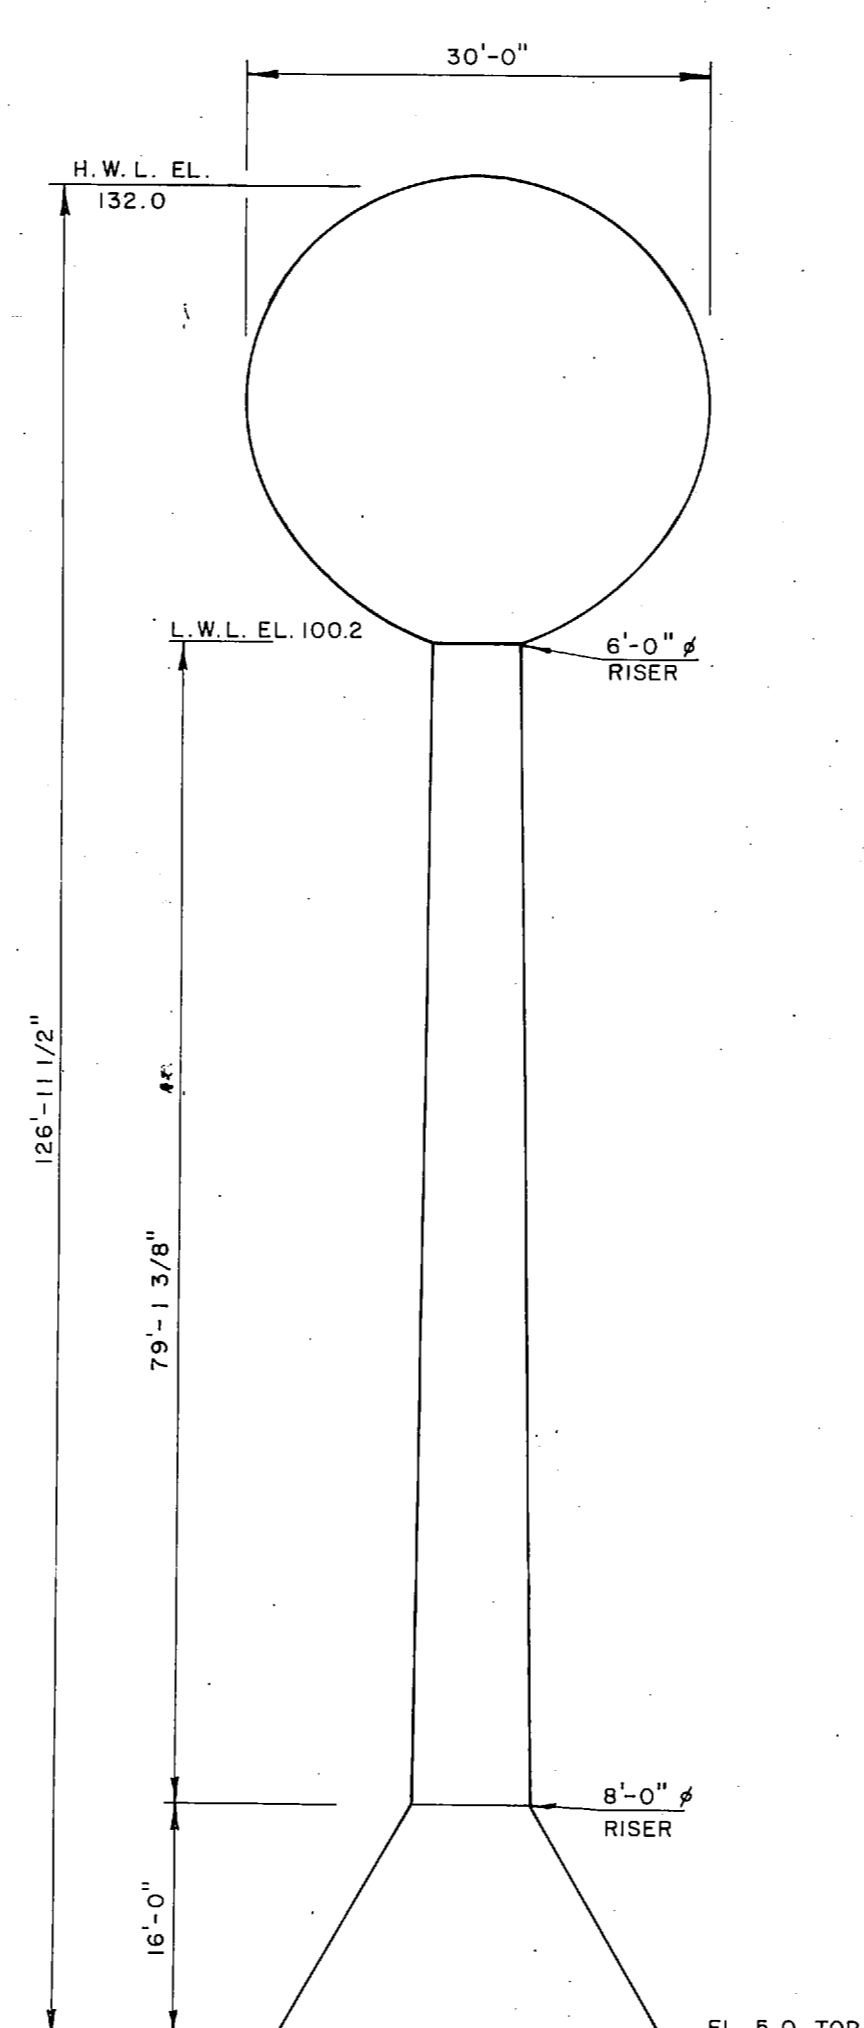

TANK S-BA-108 ONSLOW BEACH
100,000 GAL.

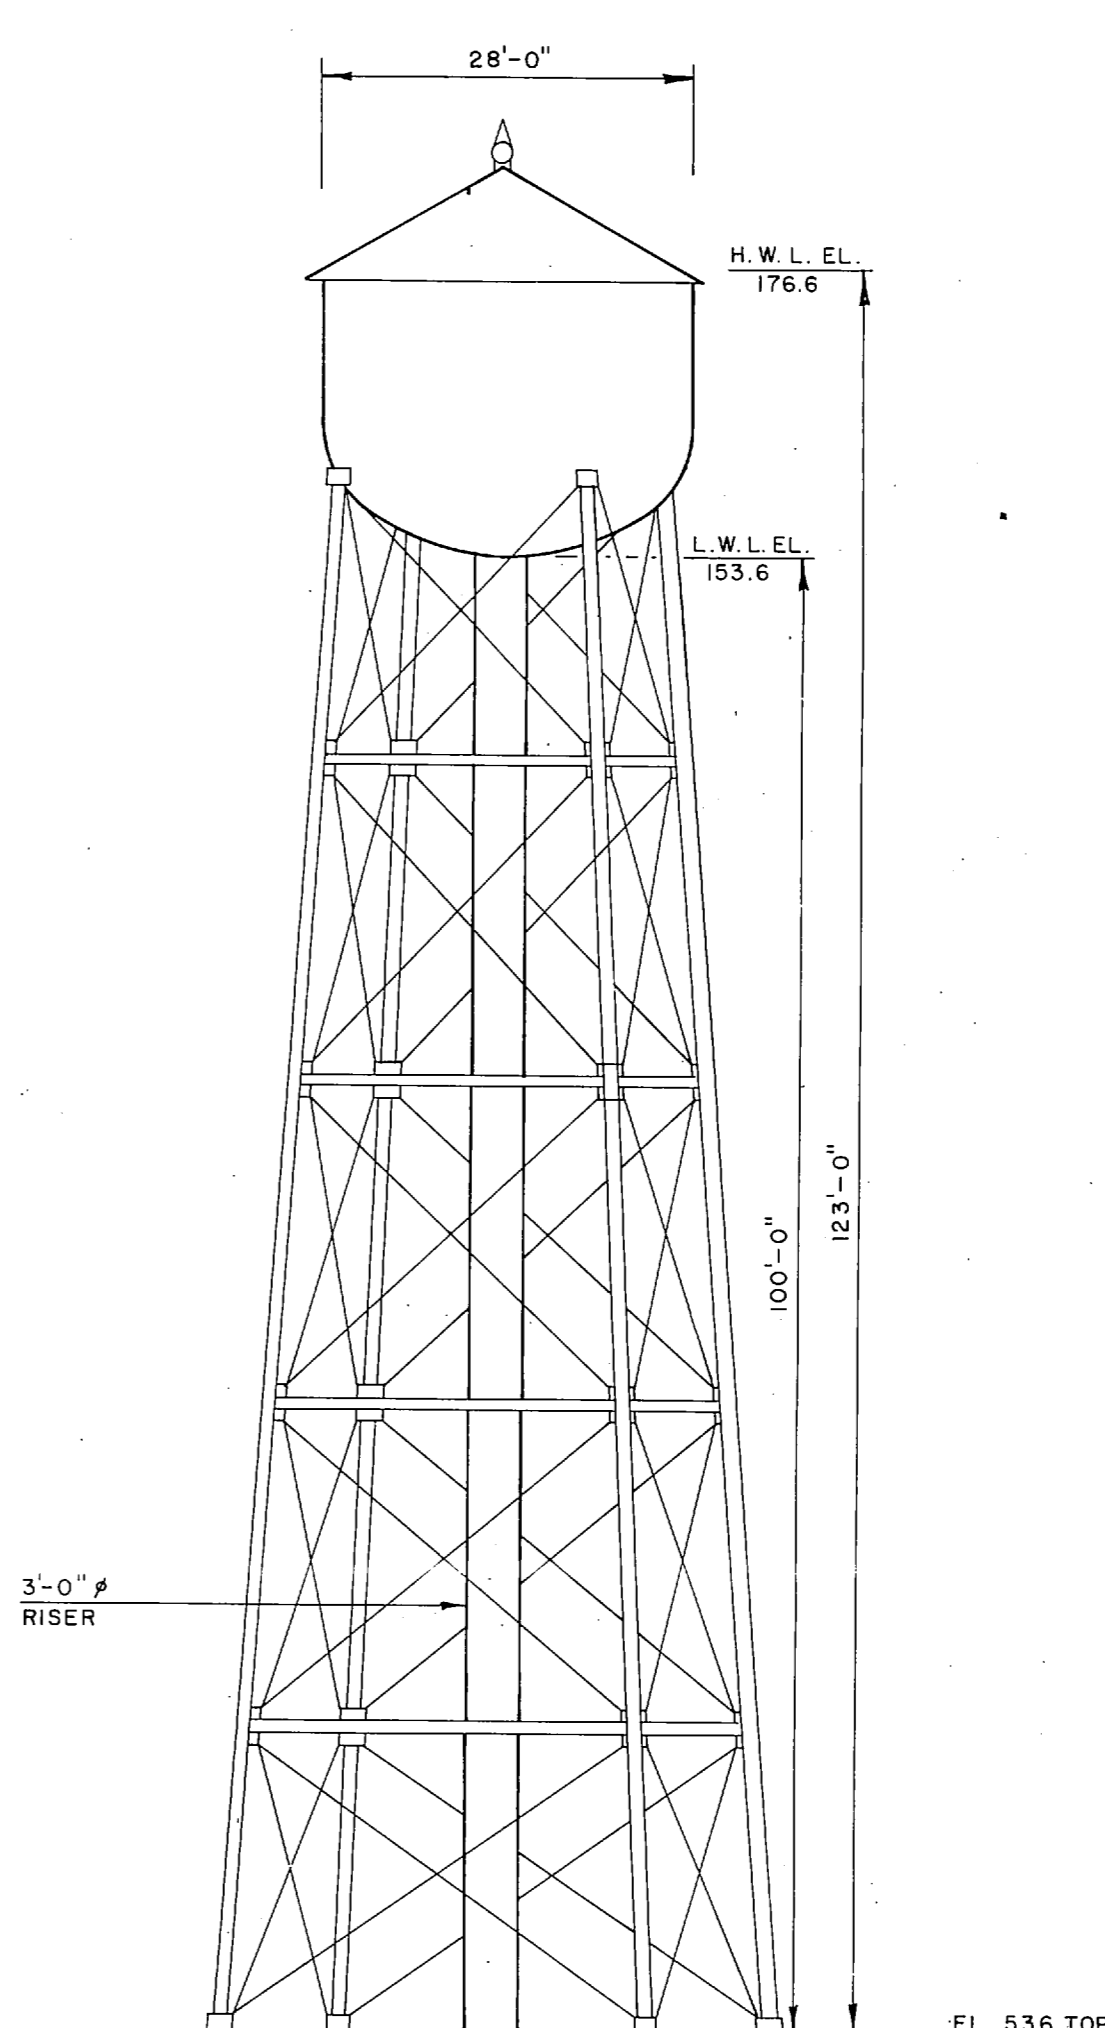

TANK S-RR-44 RIFLE RANGE
100,000 GAL.

NOTE: H.W.L IS EQUIVALENT TO OVERFLOW ELEVATION.

NO.	DESCRIPTION OF REVISION	DATE	INT.
DEPARTMENT OF THE NAVY MARINE CORPS BASE CAMP LEJEUNE, NORTH CAROLINA			
ELEVATED STORAGE TANKS WATER DISTRIBUTION SYSTEM EXISTING CONDITIONS			
DATE 31 JULY 84	SCALE: NONE	SHEET	1 of 2
APPROVED / DATE			

RAW
WATER