

**VALUABLE**

Return To  
Public Works  
Office  
Camp Lejeune  
North Carolina

SUBJECT Location Gas Storage  
Tanks Water Line and  
Elev on Tanks

**FIELD PARTY**

\_\_\_\_\_ In Charge  
\_\_\_\_\_ Instrument  
\_\_\_\_\_ Notes  
\_\_\_\_\_ Tape Read  
\_\_\_\_\_ Tape or Rod  
\_\_\_\_\_ Tape or Rod  
\_\_\_\_\_ Instrument No.  
\_\_\_\_\_ Tape No.

**WEATHER**

Clear \_\_\_\_\_  
Cloudy \_\_\_\_\_  
Windy \_\_\_\_\_  
Rain \_\_\_\_\_  
Fair \_\_\_\_\_  
Snow \_\_\_\_\_  
Hot \_\_\_\_\_  
Moderate \_\_\_\_\_  
Cold \_\_\_\_\_  
Fog \_\_\_\_\_  
Figured By \_\_\_\_\_  
Notes Checked By \_\_\_\_\_  
Plotted By \_\_\_\_\_


FILE No. 219-0

Fldr. No. \_\_\_\_\_

Sheet 1 of 1

Date 3-2 1950

Quad. No. \_\_\_\_\_

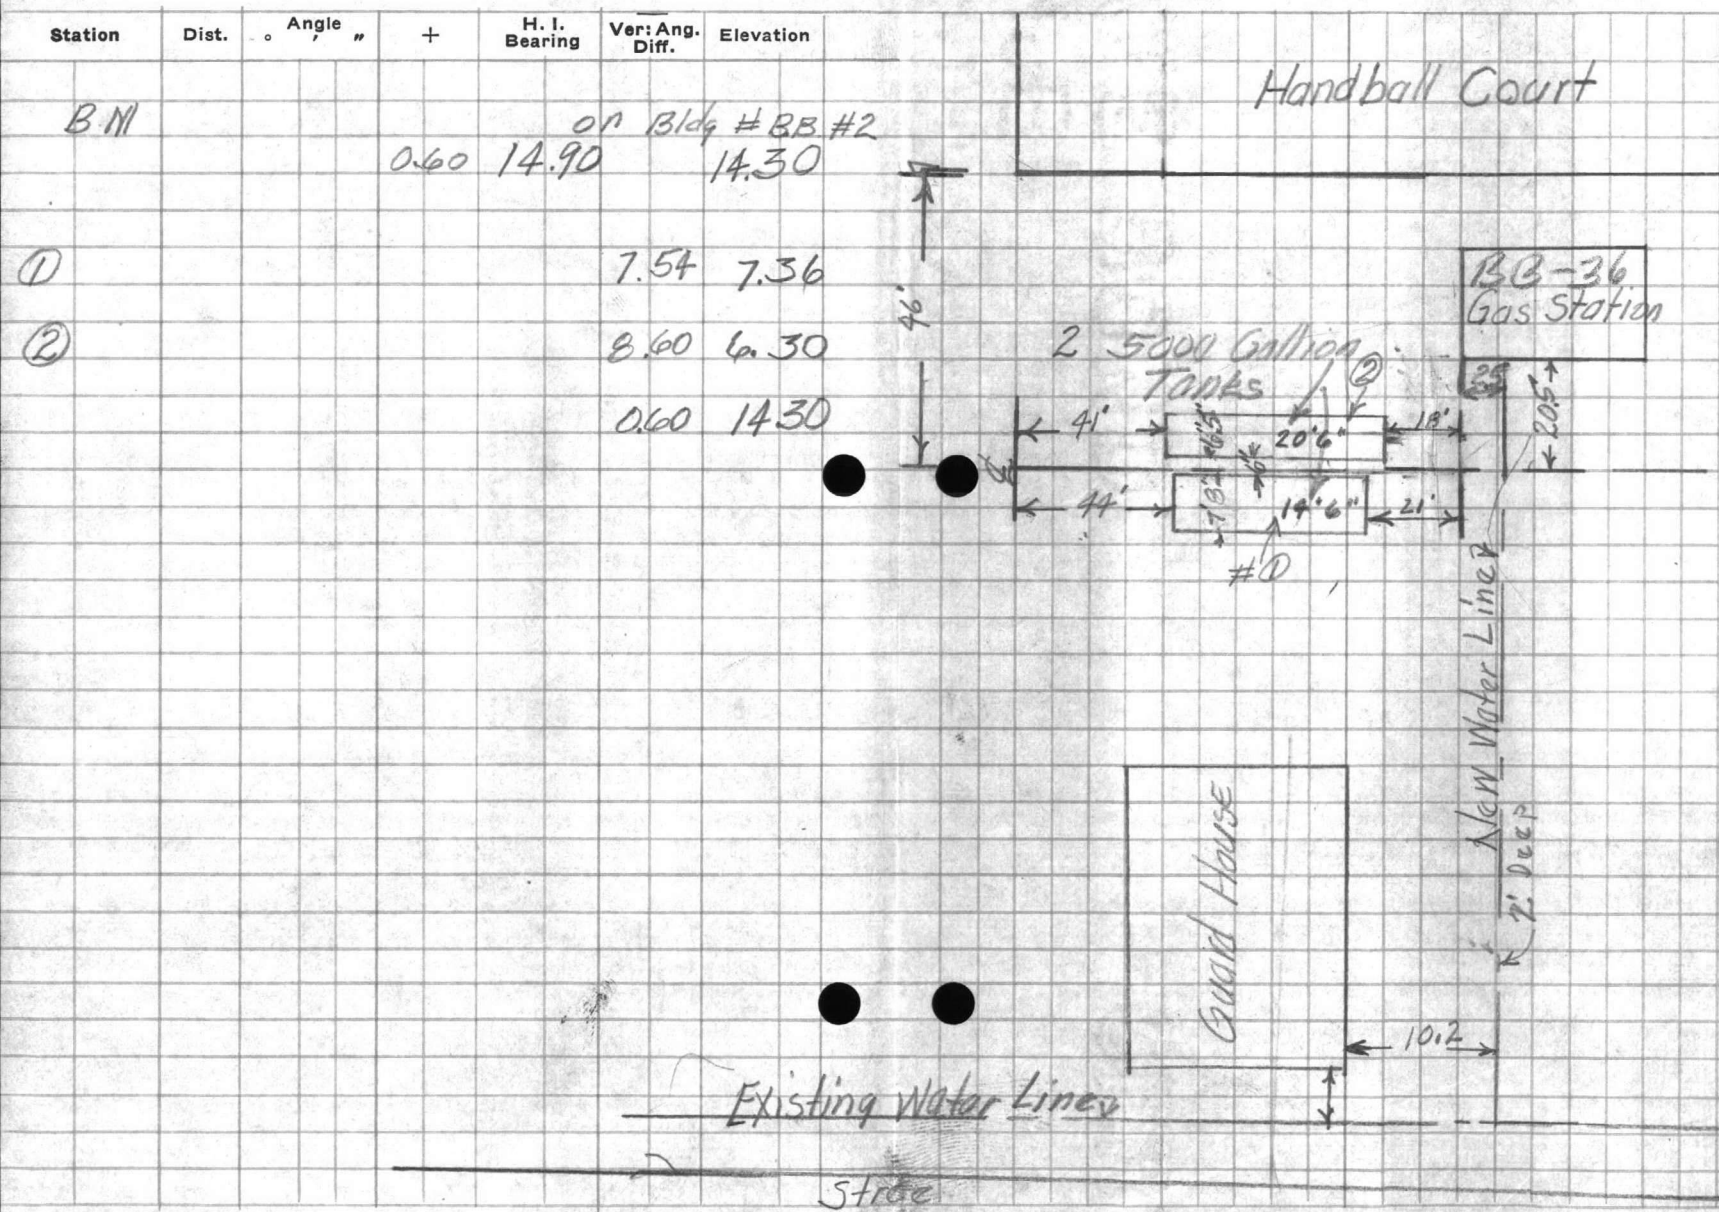

























VALUABLE

Return to  
Public Works  
Office  
North Carolina





























VALUABLE

SUBJECT Location For Supply  
Lines For Gas Station at  
Courthouse Bay

Return To  
Public Works  
Office  
Camp Lejeune  
North Carolina

FIELD PARTY

\_\_\_\_\_ In Charge  
\_\_\_\_\_ Instrument  
\_\_\_\_\_ Notes  
\_\_\_\_\_ Tape Read  
\_\_\_\_\_ Tape or Rod  
\_\_\_\_\_ Tape or Rod  
\_\_\_\_\_ Instrument No.  
\_\_\_\_\_ Tape No.

WEATHER

Clear \_\_\_\_\_  
Cloudy \_\_\_\_\_  
Windy \_\_\_\_\_  
Rain \_\_\_\_\_  
Fair \_\_\_\_\_  
Snow \_\_\_\_\_  
Hot \_\_\_\_\_  
Moderate \_\_\_\_\_  
Cold \_\_\_\_\_  
Fog \_\_\_\_\_

FILE No. 219-0

Fldr. No. \_\_\_\_\_


Figured By \_\_\_\_\_ Sheet \_\_\_\_\_

Notes Checked By \_\_\_\_\_

Plotted By \_\_\_\_\_ Date \_\_\_\_\_ 19\_\_

Quad. No. \_\_\_\_\_

Station	Dist.	Angle " "	+	H. I. Bearing	Ver: Ang. Diff.	Elevation
---------	-------	--------------	---	------------------	--------------------	-----------

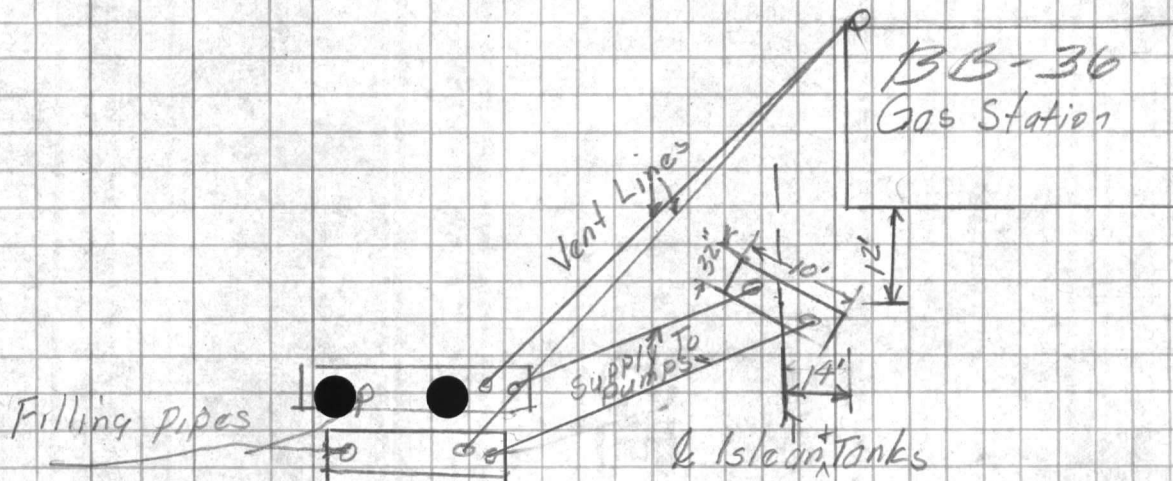











































**VALUABLE**

SUBJECT Water Line & Elec. cable Location AT Bldg. BB-16 - Court House Bay

RETURN TO  
PUBLIC WORKS  
OFFICE  
CAMP LEJEUNE  
NORTH CAROLINA



FIELD PARTY  
Kelly  
IN CHARGE  
INSTRUMENT  
NOTES  
TAPE READ  
TAPE OR ROD  
TAPE OR ROD  
INSTRUMENT NO.  
TAPE NO.

WEATHER  
CLEAR  
CLOUDY  
WINDY  
RAIN  
FAIR  
SNOW  
HOT  
MODERATE  
COLD  
FOG  
FIGURED BY  
NOTES CHECKED BY  
PLOTTED BY

FILE No. 219-0  
FLDR. No.  
SHEET 1-0 of 1  
DATE 1-21-59

Quad. No. \_\_\_\_\_

STATION	DIST.	ANGLE " "	+	H. I. BEARING	VER. ANG. DIFF.	ELEVATION	
B.M.						13.87	nail int. Peack & Middle str.
				2.07 16.94			
Finish Floor Elev. BB-16				3.73	13.21		
				8.24	8.70		top of Elec. cable AT pole SHC-4
				10.46	6.48 ✓		top 8" C.I. water Line AT "A" BB-16
				9.32	7.62 ✓		top of w. G. Elec. cable AT "B"
				8.43	6.51 ✓		top of w. G. Elec. cable AT "C" 19'
B.M.				3.07	13.87		

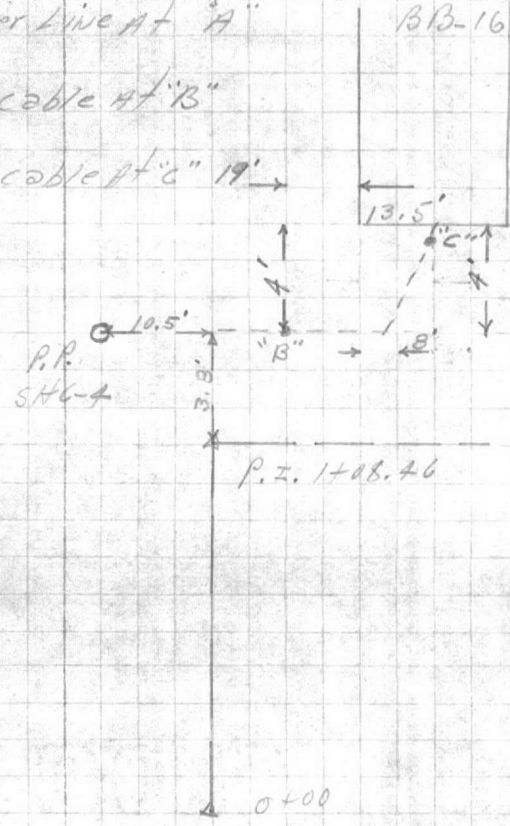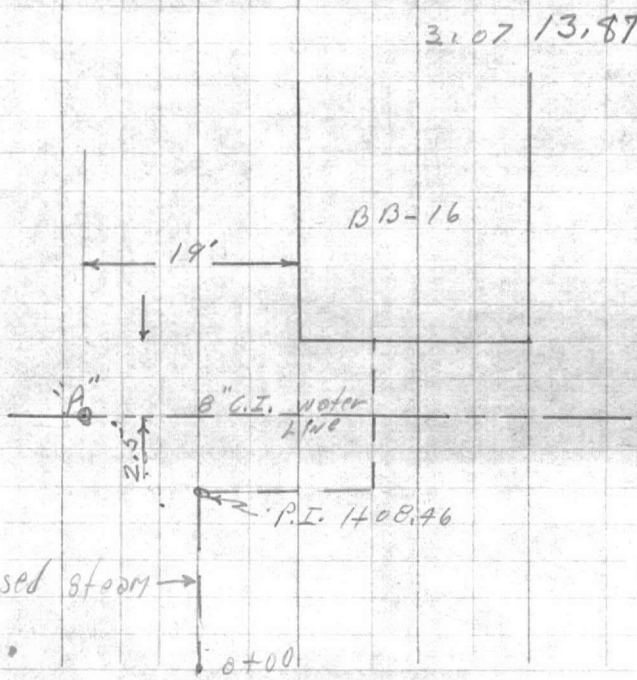









